


RECEIVED
OCT 04 2010
DEP Central Dist.

SURVEYOR'S NOTES:

- 1) North and coordinate basis is the East Zone of the Florida State Plane Coordinate System, and are based on NGS Control Station Numbers A17660(A196) and verified Pickett & Associates Targets 1 and 2 from Topographic Survey dated 12/13/01 as provided. The published values used for this survey are NAD 83 2007 adjustment. The Mapping data shown hereon is based on Pickett & Associates Survey as provided by client.
- 2) Underground improvements, encroachments, foundations and/or utilities were not located as a part of this survey.
- 3) Vertical information depicted on this report are GPS derived elevations based on the National Geodetic Vertical Datum of 1929 (NGVD29) utilizing site control as provided PK13 with an elevation of 92.92 and OC1406 with an elevation of 80.91.
- 4) Symbols shown hereon are not to scale.

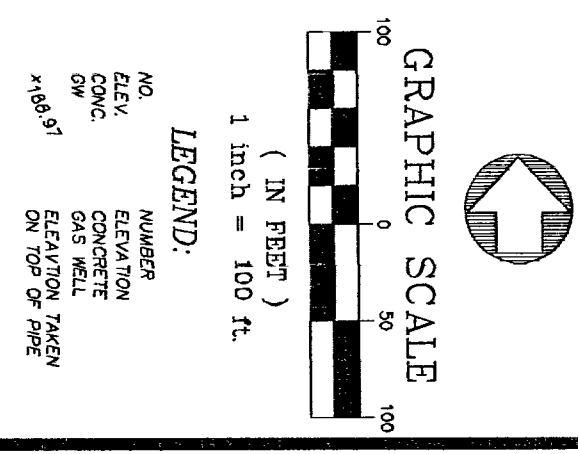

ASBUILT SURVEY - GCCS SEQUENCE 3A
J.E.D. SOLID WASTE MANGEMENT FACILITY
 1501 OMNI WAY ST. CLOUD, FL

CLIENT:
 Omni Waste of Osceola
 County, LLC
 Waste Services, Inc.
 1501 Omni Way
 St. Cloud, FL 34773

PEAVEY & ASSOCIATES
 SURVEYING AND MAPPING, PA
 890 ALICE PLACE
 BARTOW, FLORIDA 33830
 PHONE: (883) 738-4960
 FAX: (883) 633-6972

Drawn By: DLP
 Party Chief: DR
 Field Book:
 Page:
 THIS SURVEY IS NOT VALID WITHOUT THE SIGNATURE AND SEAL OF A FLORIDA LICENSED SURVEYOR AND MAPPER.
 FILE NAME: 612WSI-JED-GAS.dwg

NO.	DATE	REVISION