

July 24th, 2008

Lu Burson Environmental Manager, Solid and Hazardous Waste FDEP Central District 3319 Maguire Blvd, Suite 232 Orlando, FL 32803-3767

RE: June 24, 2008 Inspection Report, Perma-Fix of Orlando (FLD 980 559 728)

Dear Ms. Burson:

I received the report from the inspection performed June 24th, 2008 at the Perma-Fix of Orlando Rocket Blvd. and General Drive facilities.

In response to the first of the two items indentified in the report, I am attaching a corrected drawing of the sample locations for the General Drive closure. I regret that the original report was incorrect, but the corrected page identifies the locations that correspond to both the physical locations observed by the inspectors and the locations specified in the Used Oil Processing Facility permit (0152516-HO-003).

In response to the second item, the papers are being removed from the warehouse area. Perma-Fix of Orlando will also notify the Department ten days prior to commencing any consolidation or lab-packing activities.


If you have any questions regarding this information, please feel free to call me at (352) 395-1356 or e-mail me at kfogleman@perma-fix.com.

Sincerely,

Kurt Fogleman

Environmental, Health and Safety Compliance Manager

Perma-Fix Southeast Region

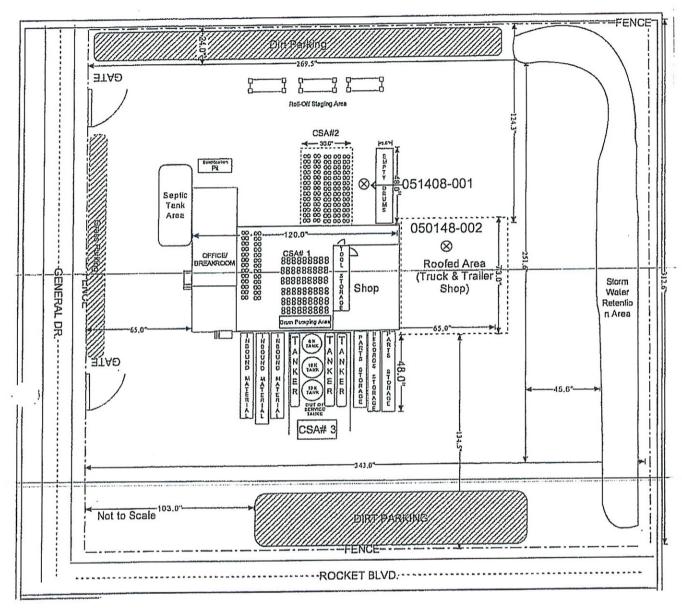



⊗ Sample Location

FIGURE 4 SAMPLE LOCATION DIAGRAM PERMA-FIX OF ORLANDO GENERAL DRIVE FACILITY

Drawn By: BAH

Checked By: DLA

Date: June 6, 2008

