



**TECHNICAL SOLUTIONS
NORTH AMERICA**

September 7, 2010

Mr. Aaron Mitchell
Florida Department of Environmental Protection
160 Governmental Center
Pensacola, FL 32502-5794

RE: Veolia ES Technical Solutions, L.L.C.
342 Marpan Lane
Tallahassee, FL 32305
EPA ID# : FL0000207449
Permit # ; 71455-HO-009

Dear Mr. Mitchell,

Veolia ES Technical Solutions, L.L.C. (Veolia) is submitting this letter and the enclosed documents to notify the Florida Department of Environmental Protection of its intent to move the battery and ballast storage from the main floor of the facility to the portion of the building immediately to our south that is currently used for the sorting and collection of storage of electronic waste destined for recycling. (This portion was added to the permit as a result of the Class 1 Modification in May of 2008). We have determined that the only impact of this move will be to allow for better storage and the ability to free space on the main floor of the facility for changes we intend to make at the time of permit renewal in 2011. We are not increasing our storage limits by volume, nor are we processing any of the material to be stored in this area.

Enclosed with this letter please find a site map with the proposed changes as they are planned. Please notify me if there are additional requirements with this proposed change in the site location of material.

If you have any questions or comments please feel free to contact me at 850-877-8299 or Wayne Bulsiewicz at 602-415-3023.

Regards,

Veolia ES Technical Solutions, L.L.C.

Linda Dunwoody
Operations Manager – Tallahassee

Encl : Site Map

Cc: Melissa Woehle – FL DEP
Phillip Ditter - Veolia
Wayne Bulsiewicz - Veolia

RECEIVED

SEP 08 2010

**NORTHWEST FLORIDA
DEP**

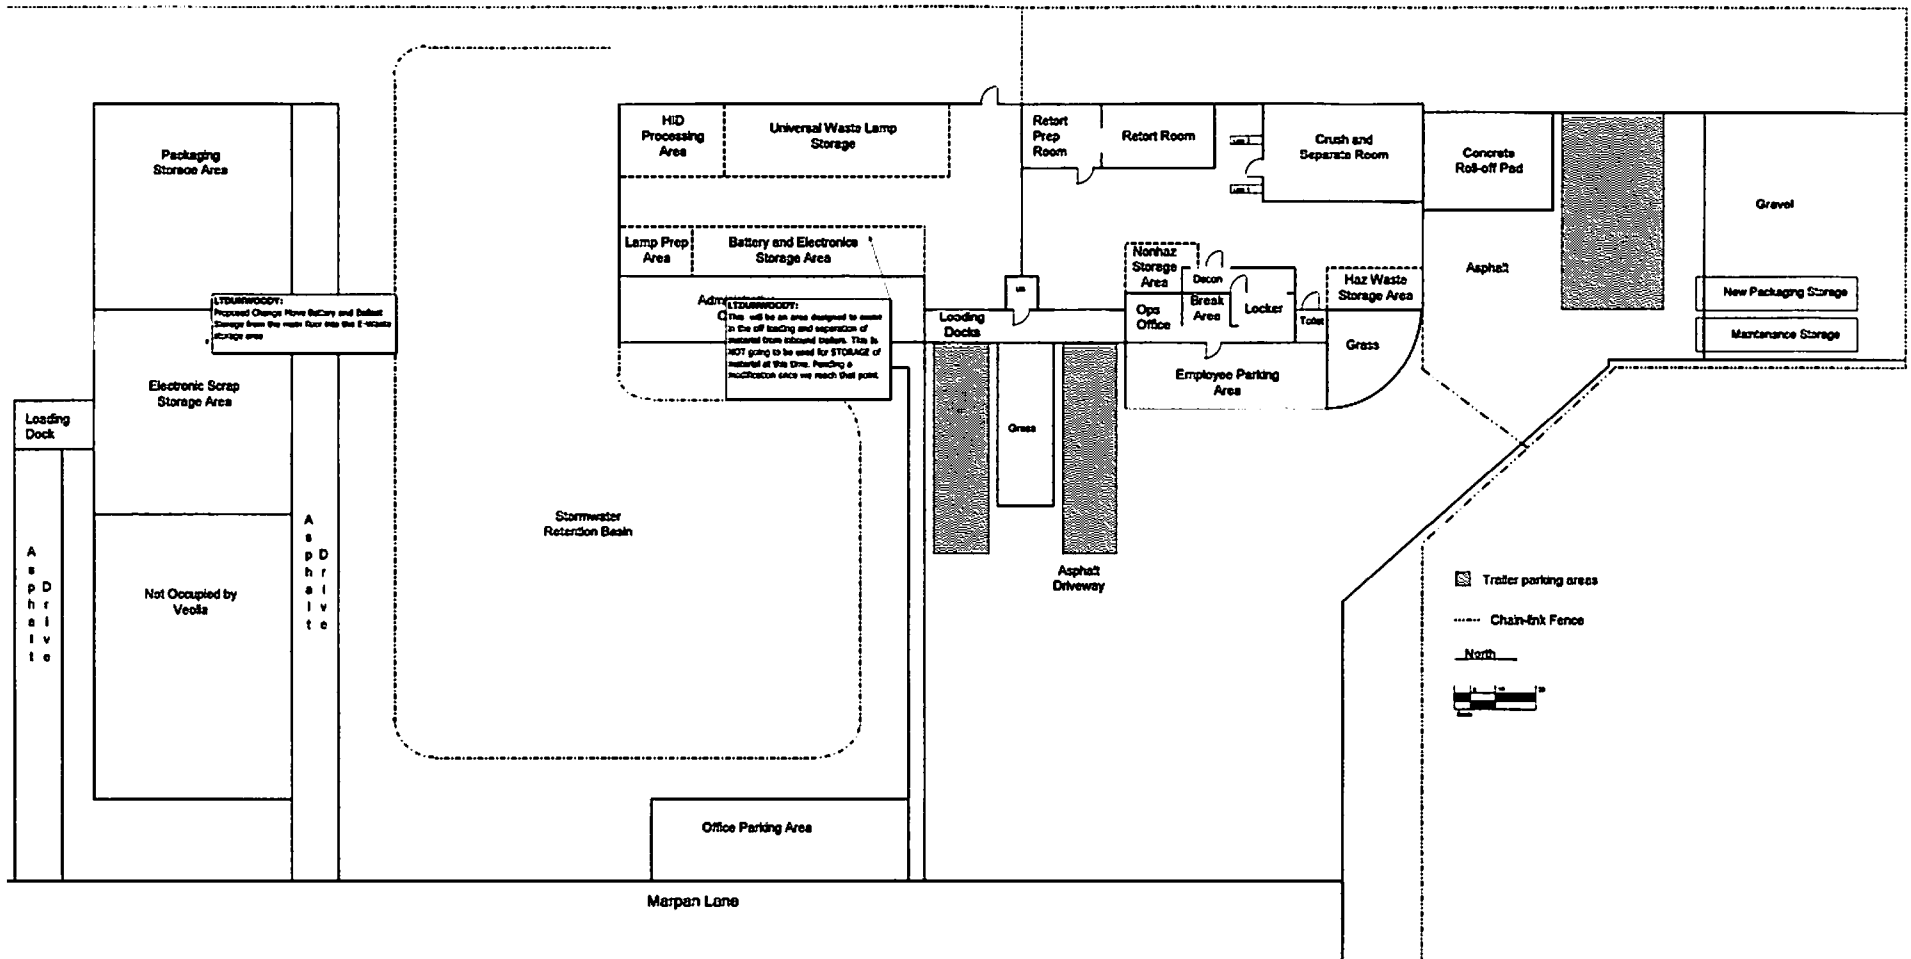


Figure 4
Site Plan

Veolia ES Technical Solutions, L.L.C.
342 Marpan Lane
Tallahassee, FL 32305

Revision Date: 9/7/2010