




LEGEND

-  90-DAY HAZARDOUS WASTE STORAGE AREA
-  SATELLITE ACCUMULATION AREAS
-  GENERALIZED EVACUATION ROUTES




NOT TO SCALE

BUILDING EVACUATION ROUTES

Source: ECT, 1994.

TECO
TAMPA ELECTRIC

LOCATION OF TANKS AT CENTRAL OPERATIONS CENTER

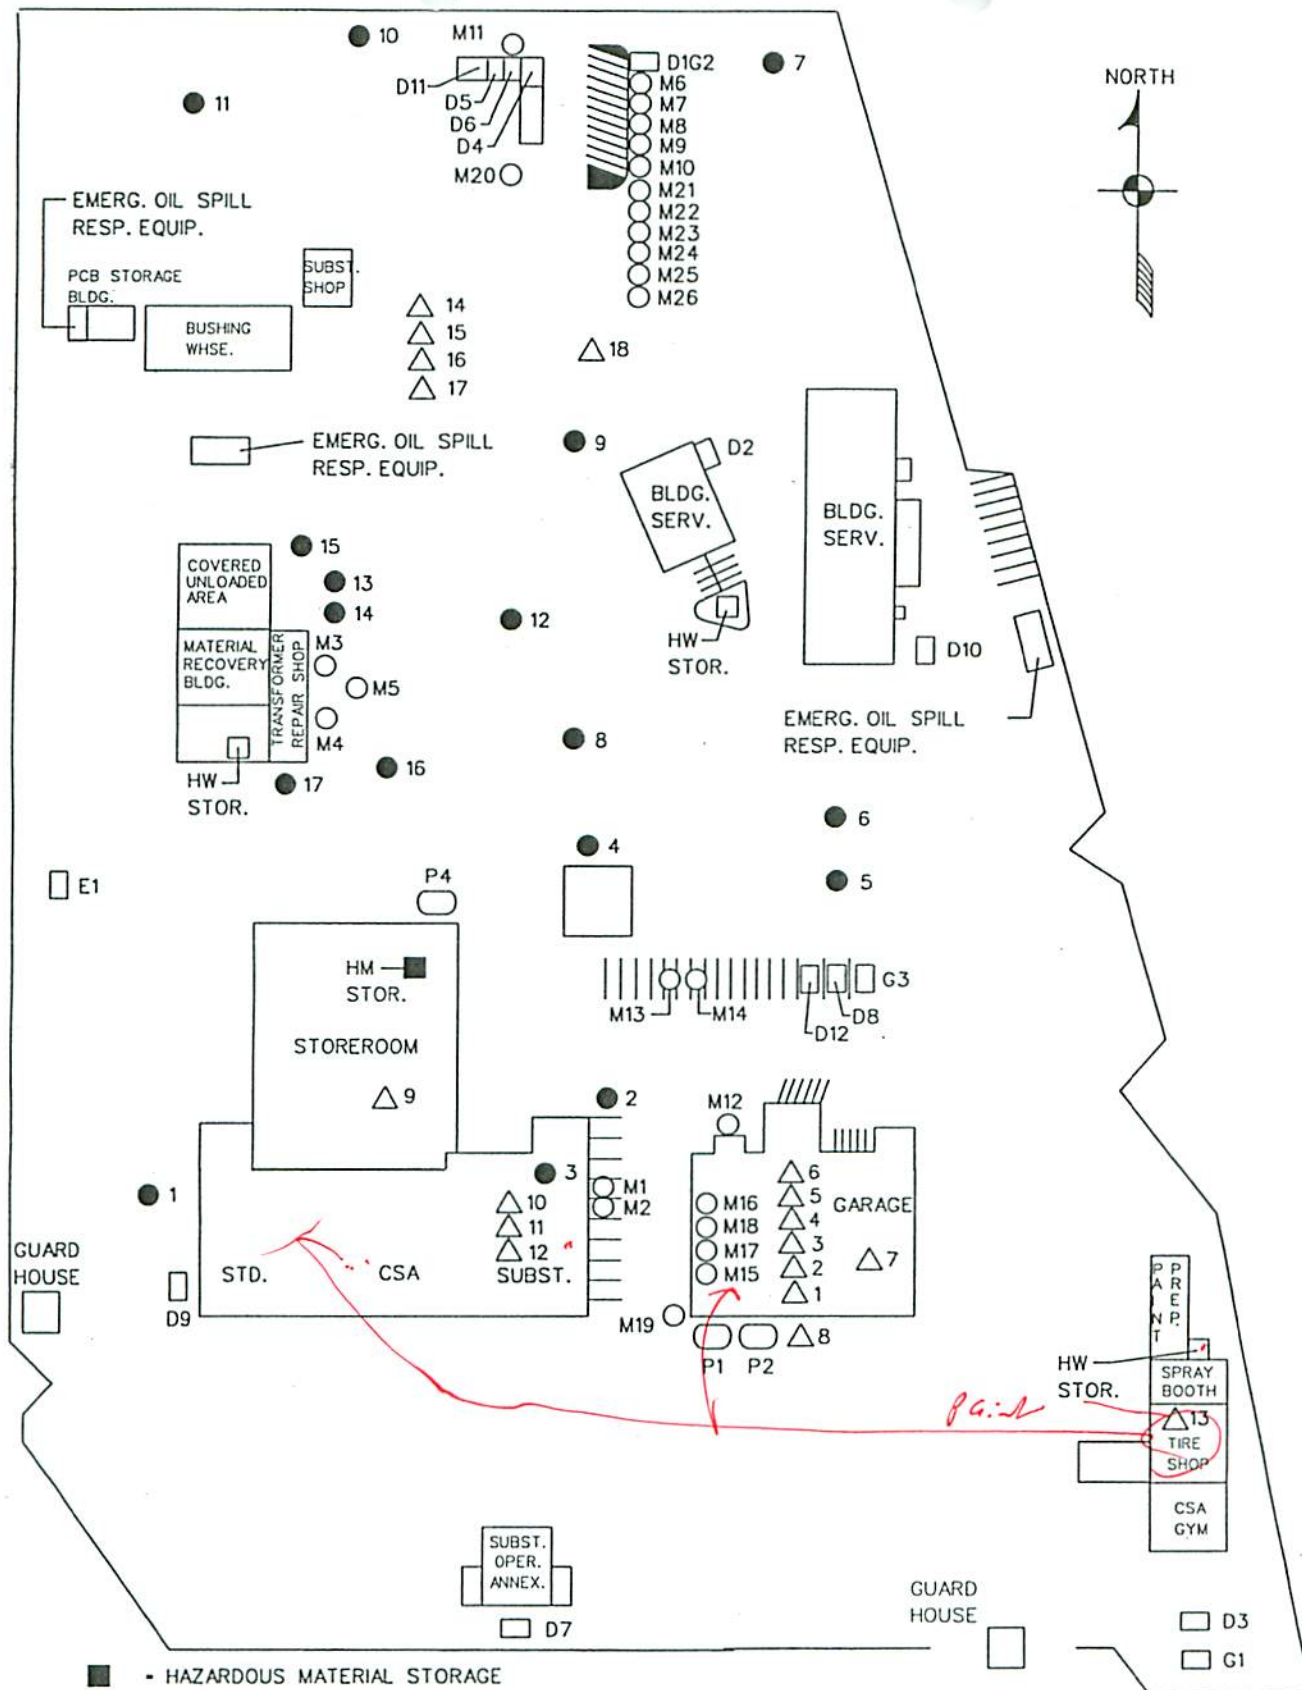

- - HAZARDOUS MATERIAL STORAGE
- - DIESEL OR GAS
- - EMERGENCY OIL SPILL RESP. EQUIPMENT
- - HAZARDOUS WASTE STORAGE
- - MINERAL OIL
- - PROPANE
- - OIL FILLED EQUIPMENT
- △ - MISCELLANEOUS

TAMPA ELECTRIC
A TECO ENERGY COMPANY

REV. 1-4-05

LOCATION OF TANKS AND CONTAINERS 55-GALLONS AND LARGER AT CENTRAL OPERATIONS CENTER

<u>TYPE</u>	<u>*MAX. GALLONS</u>	<u>DEPARTMENT/VEHICLE #</u>
P1	240/*192	Transportation/Wash Area
P2	240/*192	Transportation/Wash Area
M1	2,865	Substation/Used Oil
M2	2,865	Substation/New Oil
M3	10,000	Transformer Shop/Junk Oil
M4	1,000	Transformer Shop/Used Oil
M5	8,500	Transformer Shop/Tanker #8418 (fill line @ 6,700)
M6	7,025	Substation Tanker #8263
M7	6,625	Substation Tanker #8386
M8	7,050	Substation Tanker #8212
M9	6,425	Substation Tanker #8288
M10	6,350	Substation Tanker #8349
M11	25,782	Substation/North Yard
M12	400	Transportation/Used Oil
M13	600	Substation Portable Tank, PT #1, transported by flatbed #1438
M14	600	Substation Portable Tank, PT #2, transported by flatbed #2821
M15	275	Transportation/50 W-40
M16	275	Transportation/Dexron
M17	275	Transportation/Hydraulic Oil
M18	275	Transportation/Gear Oil
M19	100	Transportation/Oil Water Separator (underground)
M20	1,200	Substation Portable Tank, PT#3, square
M21	600	Substation Used Mineral Oil Mobile Filtration System - Trailer #8364
M22	6,650	Substation Used Mineral Oil Tanker #8426
M23	700	Substation Mineral Oil Mobile Tank #8807
M24	400	Substation Used Mineral Oil Filtration System in Trailer #8903
M25	1,700	Substation Mineral Oil Portable Substation – Trailer #8255
M26	2,973	Substation Mineral Oil Portable Substation – Trailer #8383
D1** (D1G2)	**1,200	Transportation/White Mobile #2841**
D2	1,000	Bldg. Service/Emergency Generator
D3	10,000	Transportation/Fueling East
D4	200	Substation/Emergency Generator #8287
D5	80	Substation/Emerg. Generator #8363 75 kW
D6	120	Substation/Emerg. Generator #8452 225 kW
D7	500	Substation Annex/Emerg. Generator, convault in yard
D8	280	Transportation/Mobile #8603
D9	1,000	Standards/Emerg. Generator #M045 (ConVault)
D10	500	Emergency Generator Facility Services
D11	100	Substation/Emerg. Generator #8241 (D12L15)
D12	275	Transportation/Mobile #8705
G1	10,000	Transportation/Fueling East
G2** (D1G2)	**600	Transportation/White Mobile #2841
G3	280	Transportation/Mobile #8704
E1	500	Ethanol Fuel for Meter Reader Vehicles

**1,800 gallon capacity Tank Truck (D1G2) = 1,200 gal. Diesel compartment (D1) & 600 gal. Gasoline compartment (G2).

CODE	DESCRIPTION	CODE	DESCRIPTION
C	55-Gal. Drums & Containers	M	Mineral/Vehicle Oil
D	Diesel Fuel 2	O	Oil-Filled Equipment
E	Ethanol	P	Propane, LPG*≈80% Capacity
G	Gasoline		