

Jones Ecosystem Management

Mr. Bheem Kothur
Florida Department of Environmental Protection
MS # 4560
2600 Blair Stone Road
Tallahassee, Florida 32399

November 8, 2011

RE: Raider Environmental Services As-build Drawings, *FLR 000 143 891*
Permit No: 284932-HO-001

Dear Mr. Kothur:

Thank you very much for the time and assistance you provided in our meeting of November 7, 2011. Enclosed please find the current (November, 2011) site diagrams and piping diagrams for the Raider Environmental Services facility. As we discussed, Raider will be preparing and submitting a Major Modification package within the next two weeks. Mr. Obst and I very much appreciate your understanding of the facility local permitting challenges and your clear explanation of what information is needed by the Department.

If you need any additional information at this time, please advise.
Sincerely,



John M. Jones, P.E.

cc: Mr. Steve Obst – Raider Environmental Services
Ms. Kathy Winston – FDEP Southeast District-w/o attachments

RECEIVED
RCRA

NOV 09 2011

Hazardous Waste Regulation

Received




NOV 09 2011

BSHW

10200 USA Today Way
Miramar, Florida 33025

Phone (479) 353-1368
e-mail: johnmjonespe@sbcglobal.net

ANTI FREEZE

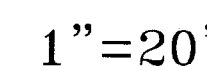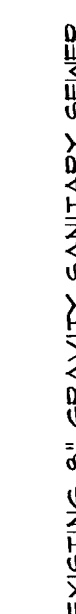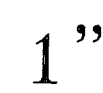

NOTE:

1. REFER TO SITE DEVELOPMENT PLAN BY ALBERTO A. DOMINGUEZ FOR SET BACKS, STORM WATER MANAGEMENT, SITE DETAILS, PARKING REQUIREMENTS AND ALL OTHER CONSTRUCTION OUTSIDE THE BUILDING.
2. PROPERTY WALLS AND FENCE UNDER A SEPARATE PERMIT, AND THEY ARE NOT PART OF THIS DOCUMENTS.
3. THIS IS ONLY AN EQUIPMENT LAYOUT, FATHI ARCHITECTS, INC. TAKES NO RESPONSIBILITY FOR THE INSTALLATIONS AND/OR INSPECTION OF THE EQUIPMENTS, OWNER TAKES FULL RESPONSIBILITY FOR THE SAME.
3. ALL TANK'S VENTS ARE OVER 12'-0" HEIGHTS.

AA 0003068
IB 0001031
**ARCHITECTS
INTERIORS
PLANNERS**
5397 ORANGE DRIVE
SUITE 203
DAYVE, FLORIDA 33314
TEL: (954) 792-8230
FAX: (954) 792-8260
www.fathiarchitects.com

SEAL:
ASGHAR J. FATHI, RA
AR0016049

CONSULTANT

PROJECT: PROPOSED WAREHOUSE FOR:
RAIDER ENVIRONMENTAL SERVICES, INC.
4103 N.W. 132nd ST.
OPA-LOCA, FLORIDA

OWNER:
Mr. STEVE OBST

ADDRESS:
4401 PETERS ROAD
PLANTATION, FLORIDA 33317

PHONE:
305 994 9949

REVISIONS	DATE	BY
△ BUILDING DEPARTMENT	12/11/07	AR
△ CLIENT	10/07/09	R.R.

COPYRIGHT 1987, FATH ARCHITECTS, INC.. ALL IDEAS, DESIGNS, ARRANGEMENTS AND PLANS INDICATED OR PRESENTED BY THIS DRAWING ARE OWNED BY, AND ARE THE PROPERTY OF, FATH ARCHITECTS, INC.. NO PART OF THIS DRAWING IS TO BE REPRODUCED, COPIED, USED OR IN CONNECTION WITH THIS SPECIFIED PROJECT. THESE IDEAS, DESIGNS, ARRANGEMENTS AND PLANS ARE NOT TO BE USED, DISCLOSED, REPRODUCED, ALTERED, COPIED, REPRODUCED, OR OTHERWISE USED IN ANY MANNER WHATSOEVER, WITHOUT THE WRITTEN PERMISSION OF FATH ARCHITECTS, INC..

WRITTEN DIMENSIONS ON THESE DRAWINGS SHALL HAVE PRECEDENCE OVER SCALED DIMENSIONS. CONTRACTOR SHALL VERIFY AND BE RESPONSIBLE FOR DIMENSIONS AND CONDITIONS ON THE JOB. FATH ARCHITECTS, INC. MUST BE NOTIFIED IMMEDIATELY IN WRITING OF ANY VARIATION FROM THE DIMENSIONS AND CONDITIONS SHOWN BY THESE DRAWINGS. FIELD VERIFY ALL CONDITIONS PRIOR TO LAYING OUT OR FABRICATING ANY PART OF THE PROJECT.

DATE:	12/02/05
SCALE:	AS SHOWN
DRAWN:	R.R.
CHECKED:	A.F.
COMMISSION NO.:	25005

SHEE

SHEET NO. OF

RECEIVED
RCRA

NOV 09 2011

Hazardous Waste Regulation



CONSULTANT:

PROJECT:
PROPOSED WAREHOUSE FOR:
RAIDER ENVIRONMENTAL SERVICES, INC.
4103 N.W. 132nd ST.
OPA-LOCA, FLORIDA

OWNER:
MR. STEVE OBST



ADDRESS:
4401 PETERS ROAD
PLANTATION, FLORIDA 33317

PHONE:
905 444 9444

REVISIONS	DATE	BY
△ BUILDING DEPARTMENT	12/11/01	A.R.O.
△ CLIENT	10/01/04	R.R.



DATE:	12/02/05
SCALE:	AS SHOWN
DRAWN:	R.R.
CHECKED:	A.F.
COMMISSION NO.:	25005
SHEET	
A-01	
SHEET NO.	OF

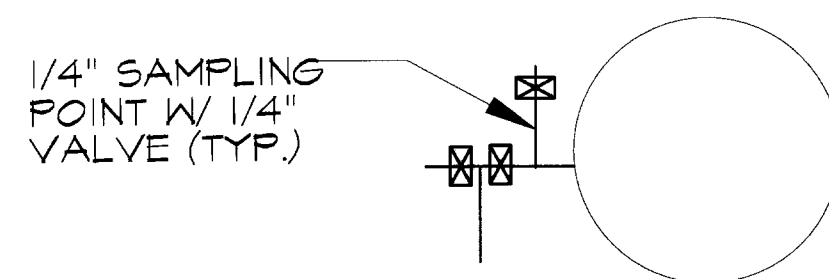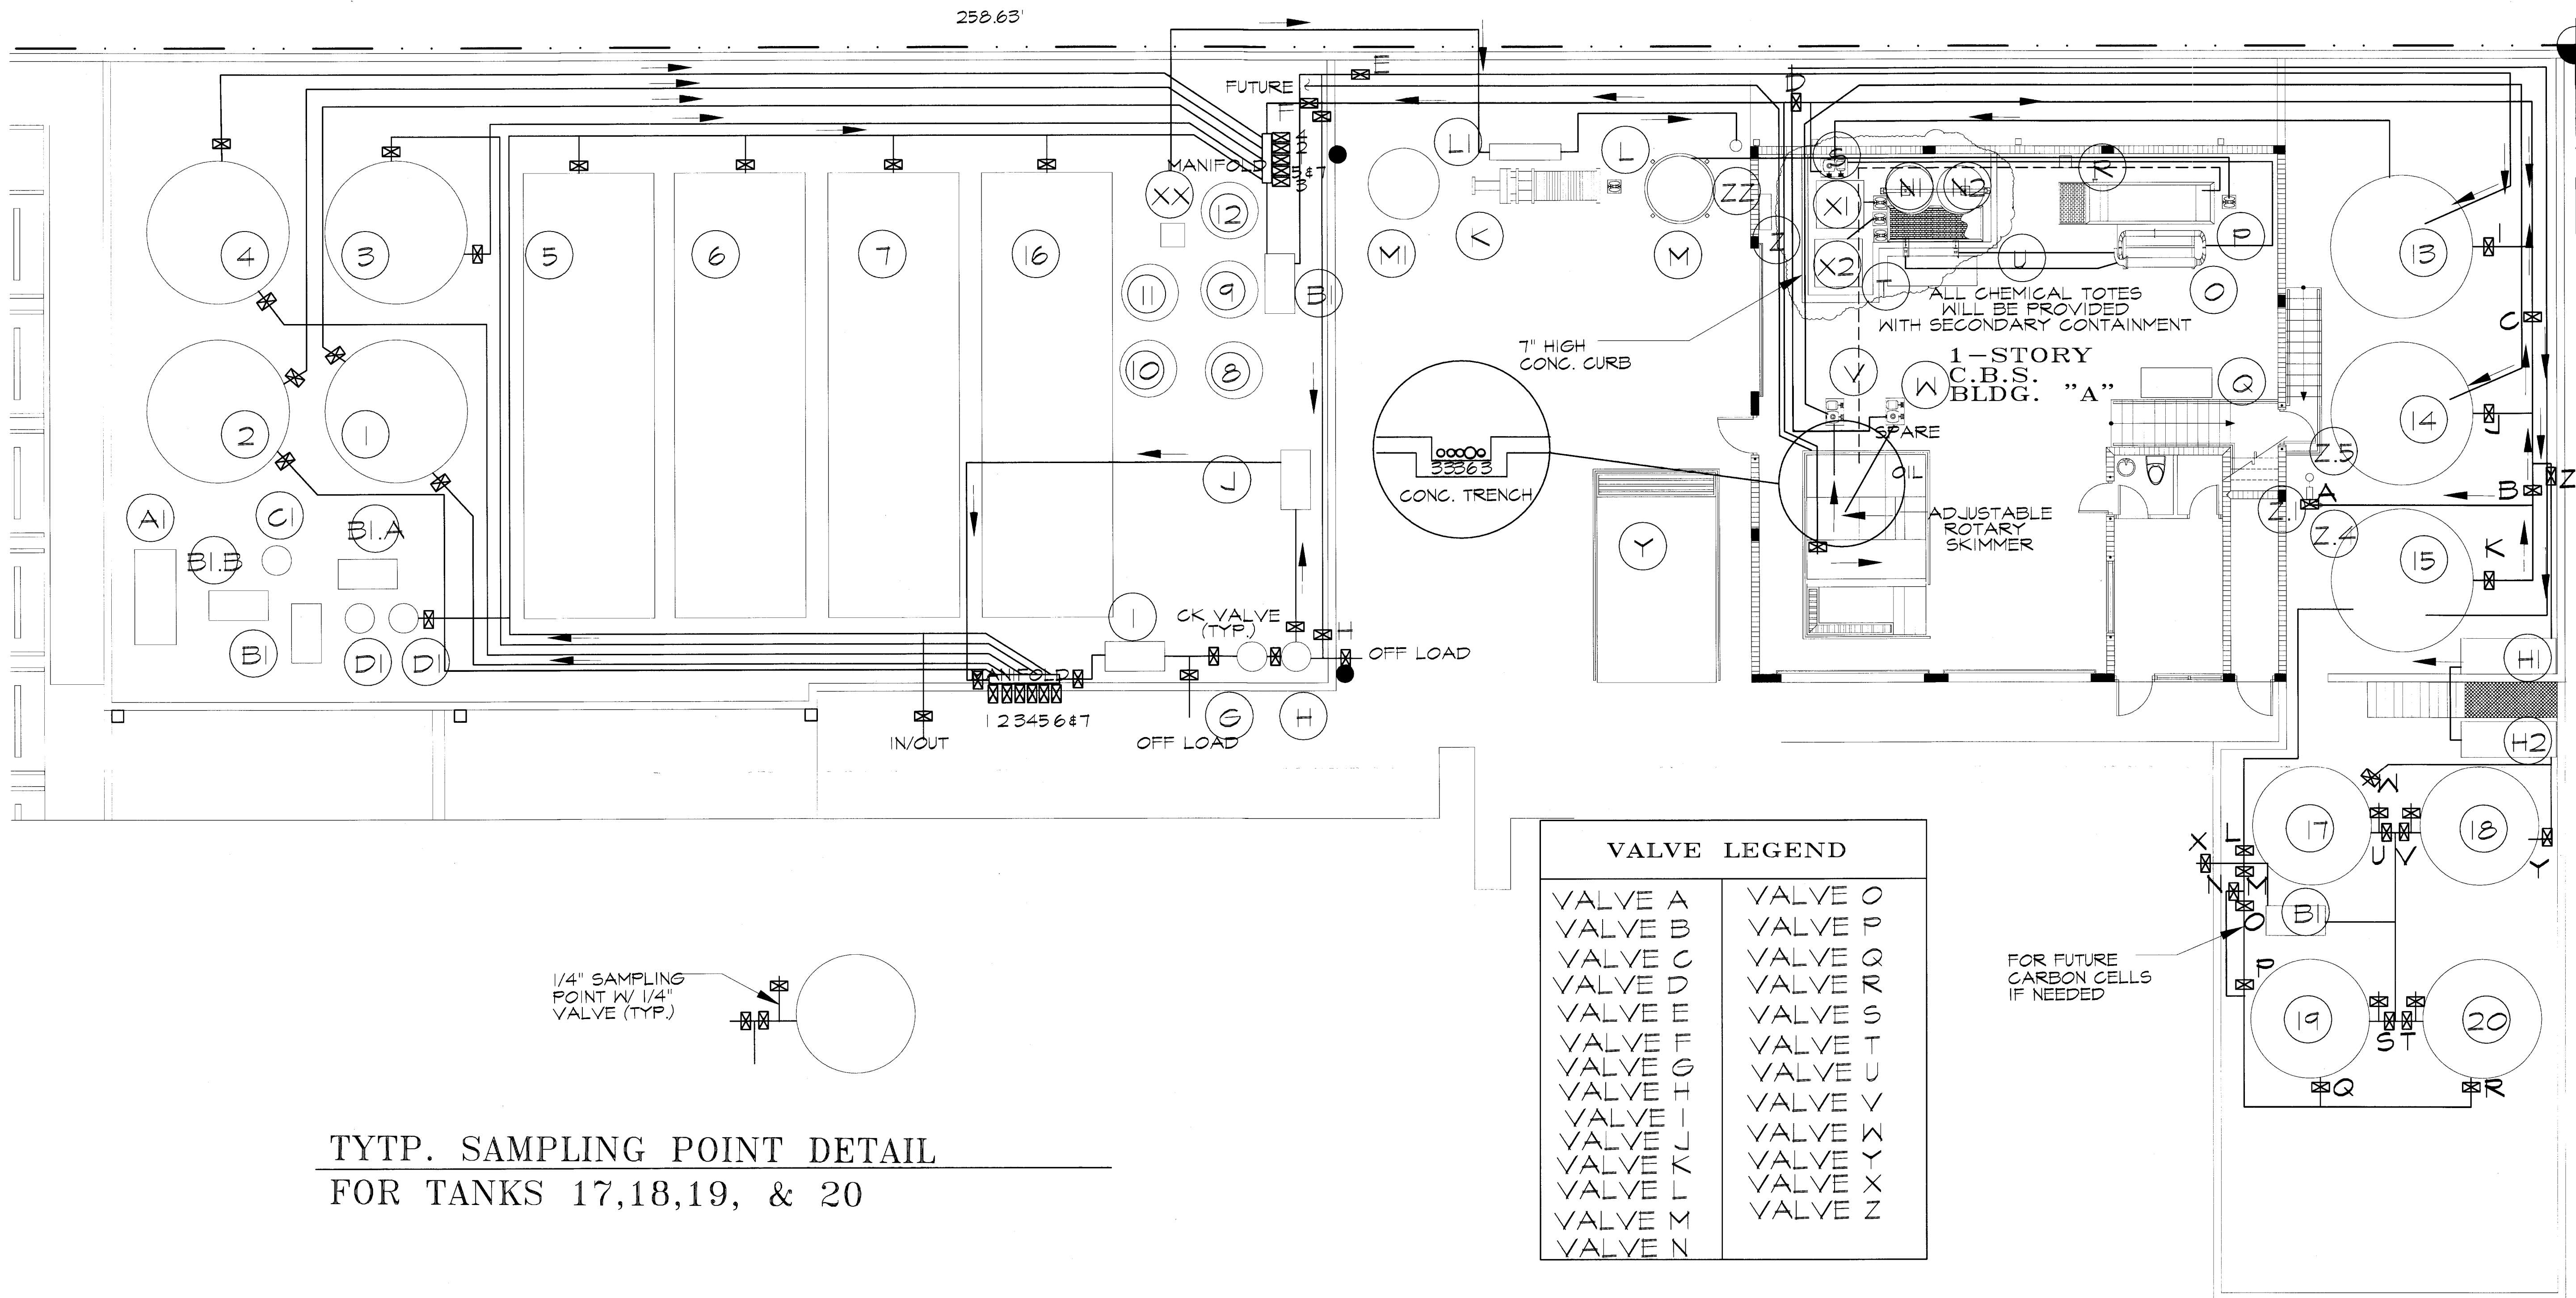


VALVE LEGEND	
VALVE A	VALVE O
VALVE B	VALVE P
VALVE C	VALVE Q
VALVE D	VALVE R
VALVE E	VALVE S
VALVE F	VALVE T
VALVE G	VALVE U
VALVE H	VALVE V
VALVE I	VALVE W
VALVE J	VALVE X
VALVE K	VALVE Y
VALVE L	VALVE Z
VALVE M	
VALVE N	


TYTP. SAMPLING POINT DETAIL
FOR TANKS 17,18,19, & 20

WATER PIPING DIAGRAM

NOTE:
ALL THE INFORMATION HAS BEEN PROVIDED BY THE OWNER, FATHI ARCHITECTS, INC. HAS ONLY DRAFTED THE PROVIDED INFORMATION AND TAKES NO RESPONSIBILITY FOR THE ACCURACY AND CONFORMANCE.

N.T.S.

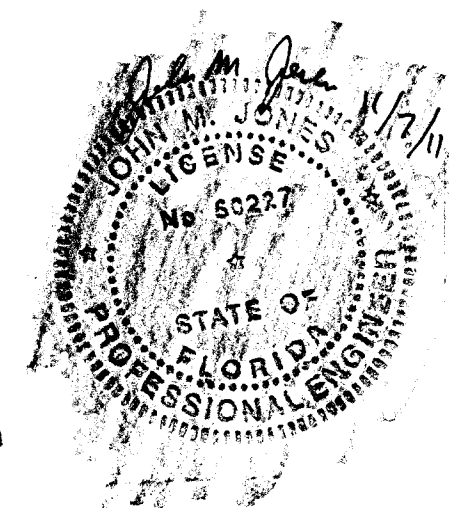

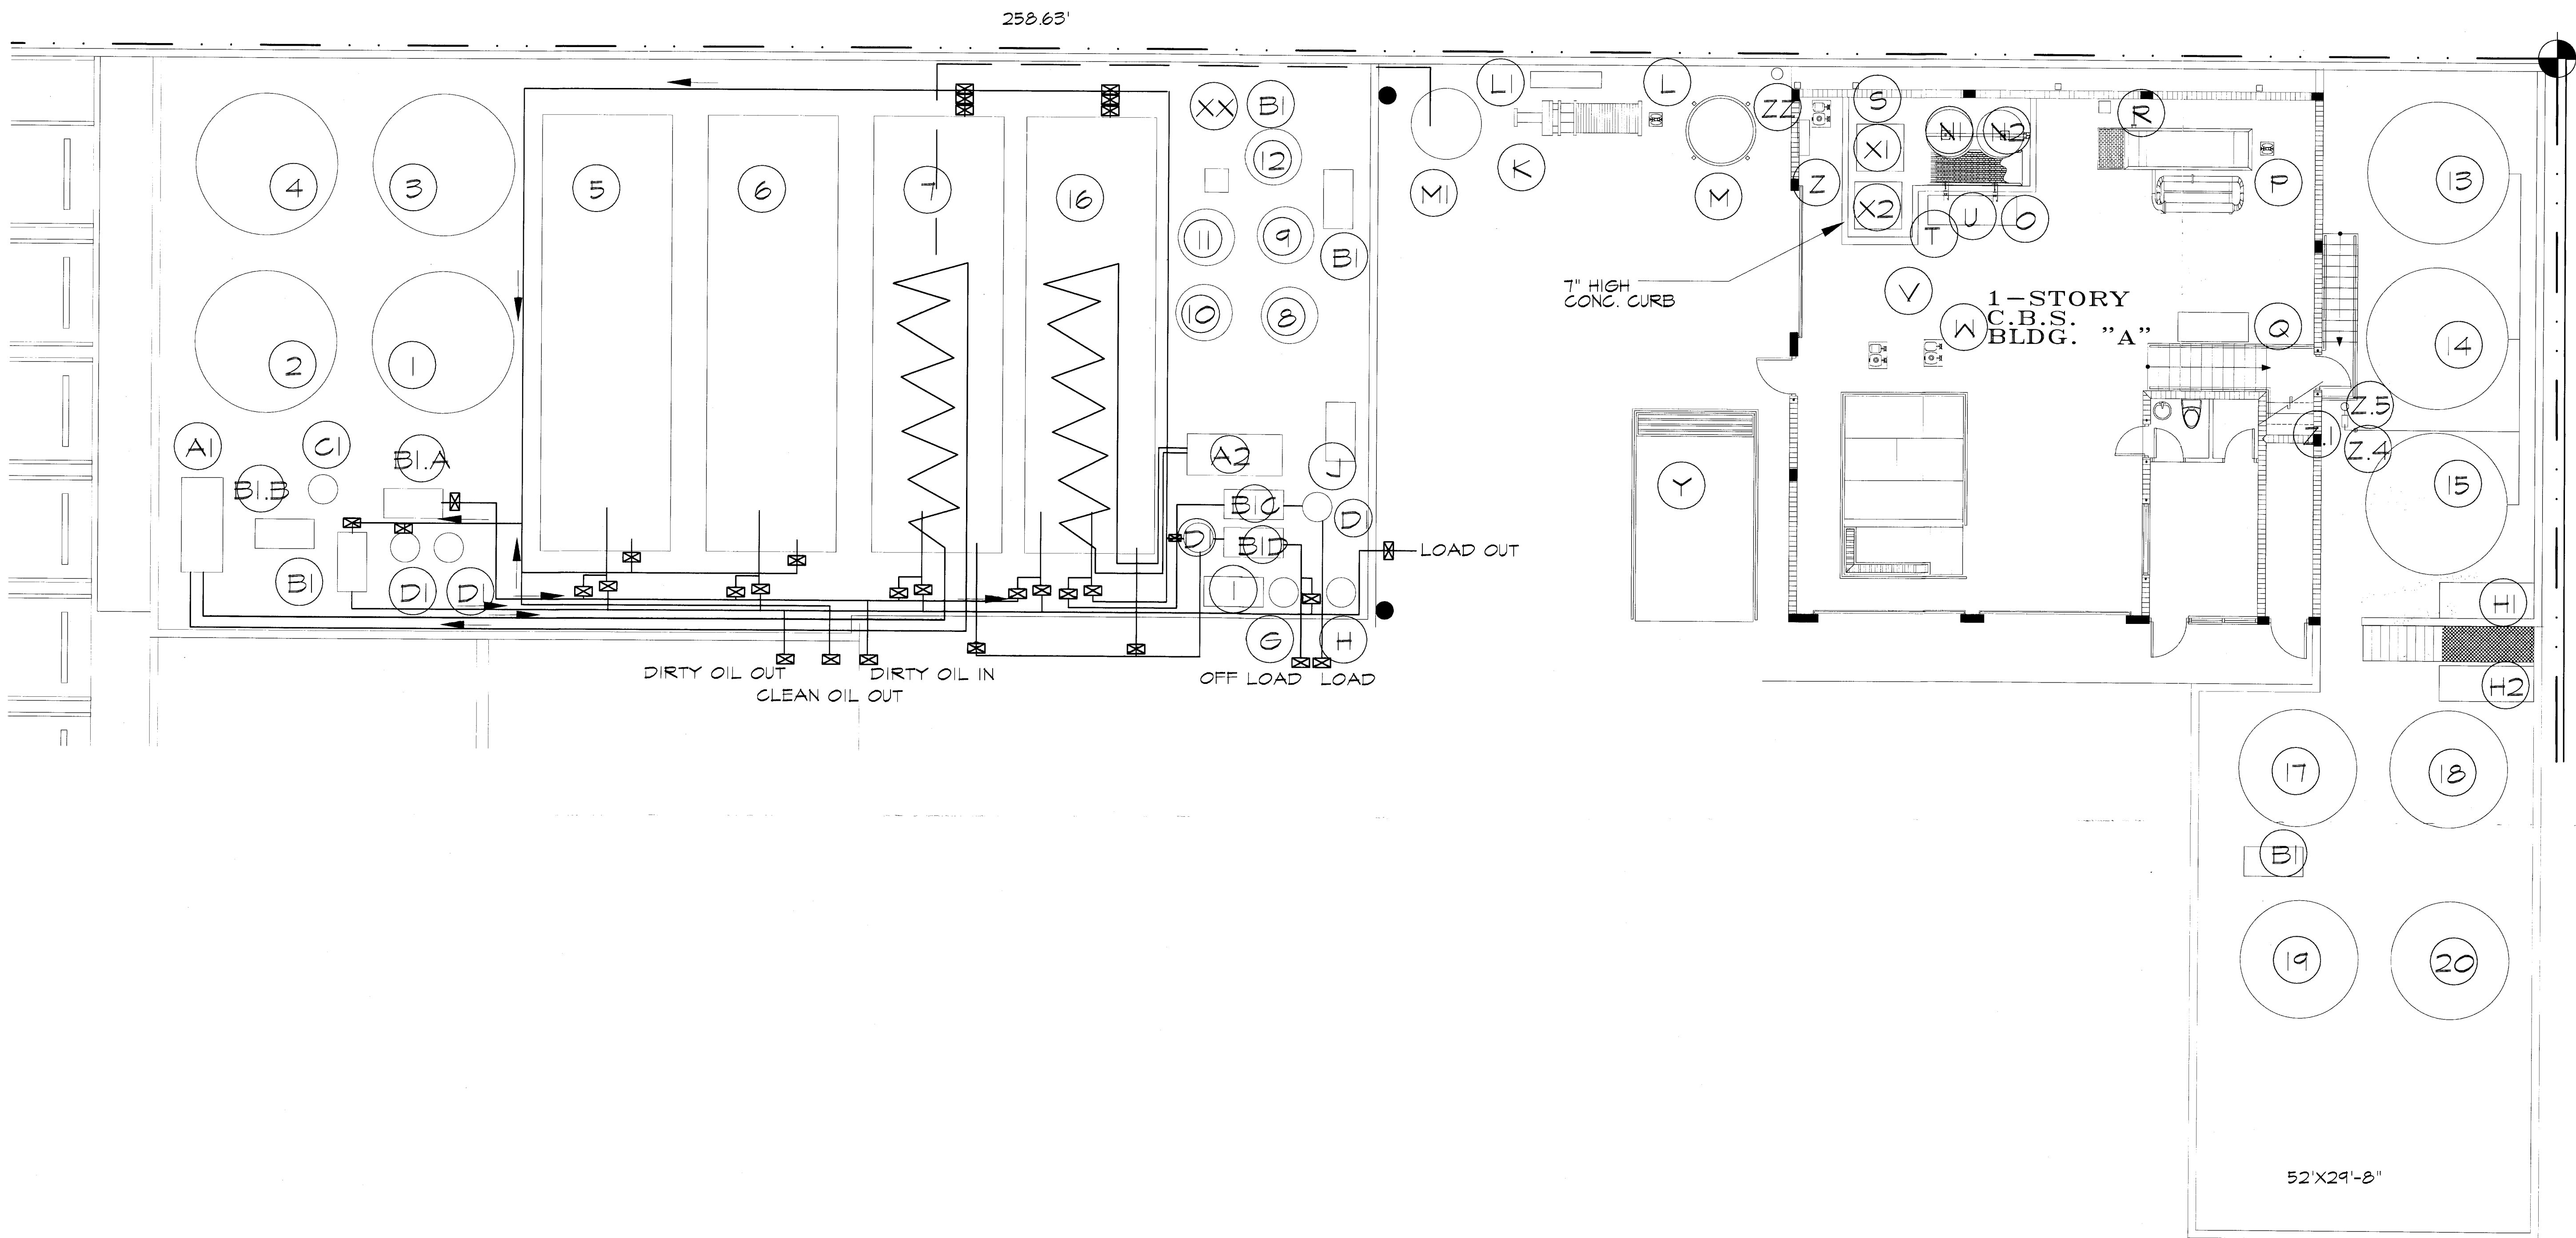

FATHI ARCHITECTS, INC.
 AA 0000068
 IB 0001091
 ARCHITECTS
 INTERIORS
 PLANNERS
 5387 ORANGE DRIVE
 SUITE 203
 DAVIE, FLORIDA 33314
 TEL: (954) 792-8230
 FAX: (954) 792-8230
 www.fathiarchitects.com

SEAL
 ASGHAR J. FATHI, R.A.
 ARO016044

CONSULTANT:

PROJECT:
PROPOSED WAREHOUSE FOR:
 RAIDER ENVIRONMENTAL SERVICES, INC.
 4103 N.W. 132nd ST.
 OPA-LOKA, FLORIDA

OWNER:
 Mr. STEVE OBST

ADDRESS:
 4401 PETERS ROAD
 PLANTATION, FLORIDA 33317

PHONE:
 305 494 9949

REVISIONS	DATE	BY
△ BUILDING DEPARTMENT	12/11/07	A.R.O.
△ CLIENT	10/07/09	R.R.




OIL PIPING DIAGRAM

NOTE:
 ALL THE INFORMATION HAS BEEN PROVIDED BY THE OWNER, FATHI ARCHITECTS, INC. HAS ONLY DRAFTED THE PROVIDED INFORMATION AND TAKES NO RESPONSIBILITY FOR THE ACCURACY AND CONFORMANCE.

N.T.S.

RECEIVED
 RCRA
 NOV 09 2011
 Hazardous Waste Regulation

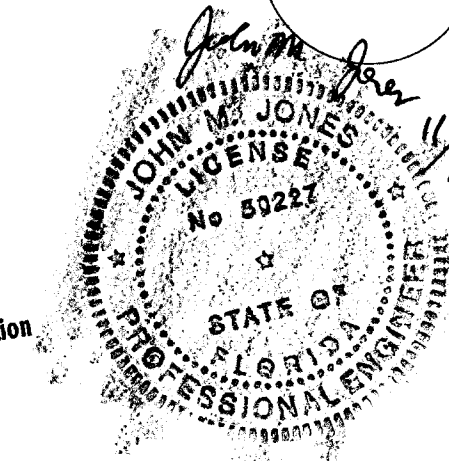

DATE:	12/02/05
SCALE:	AS SHOWN
DRAWN:	R.R.
CHECKED:	A.F.
COMMISSION NO.:	25005
SHEET	
A-02	
SHEET NO.	OF