SEP 1 3 1983

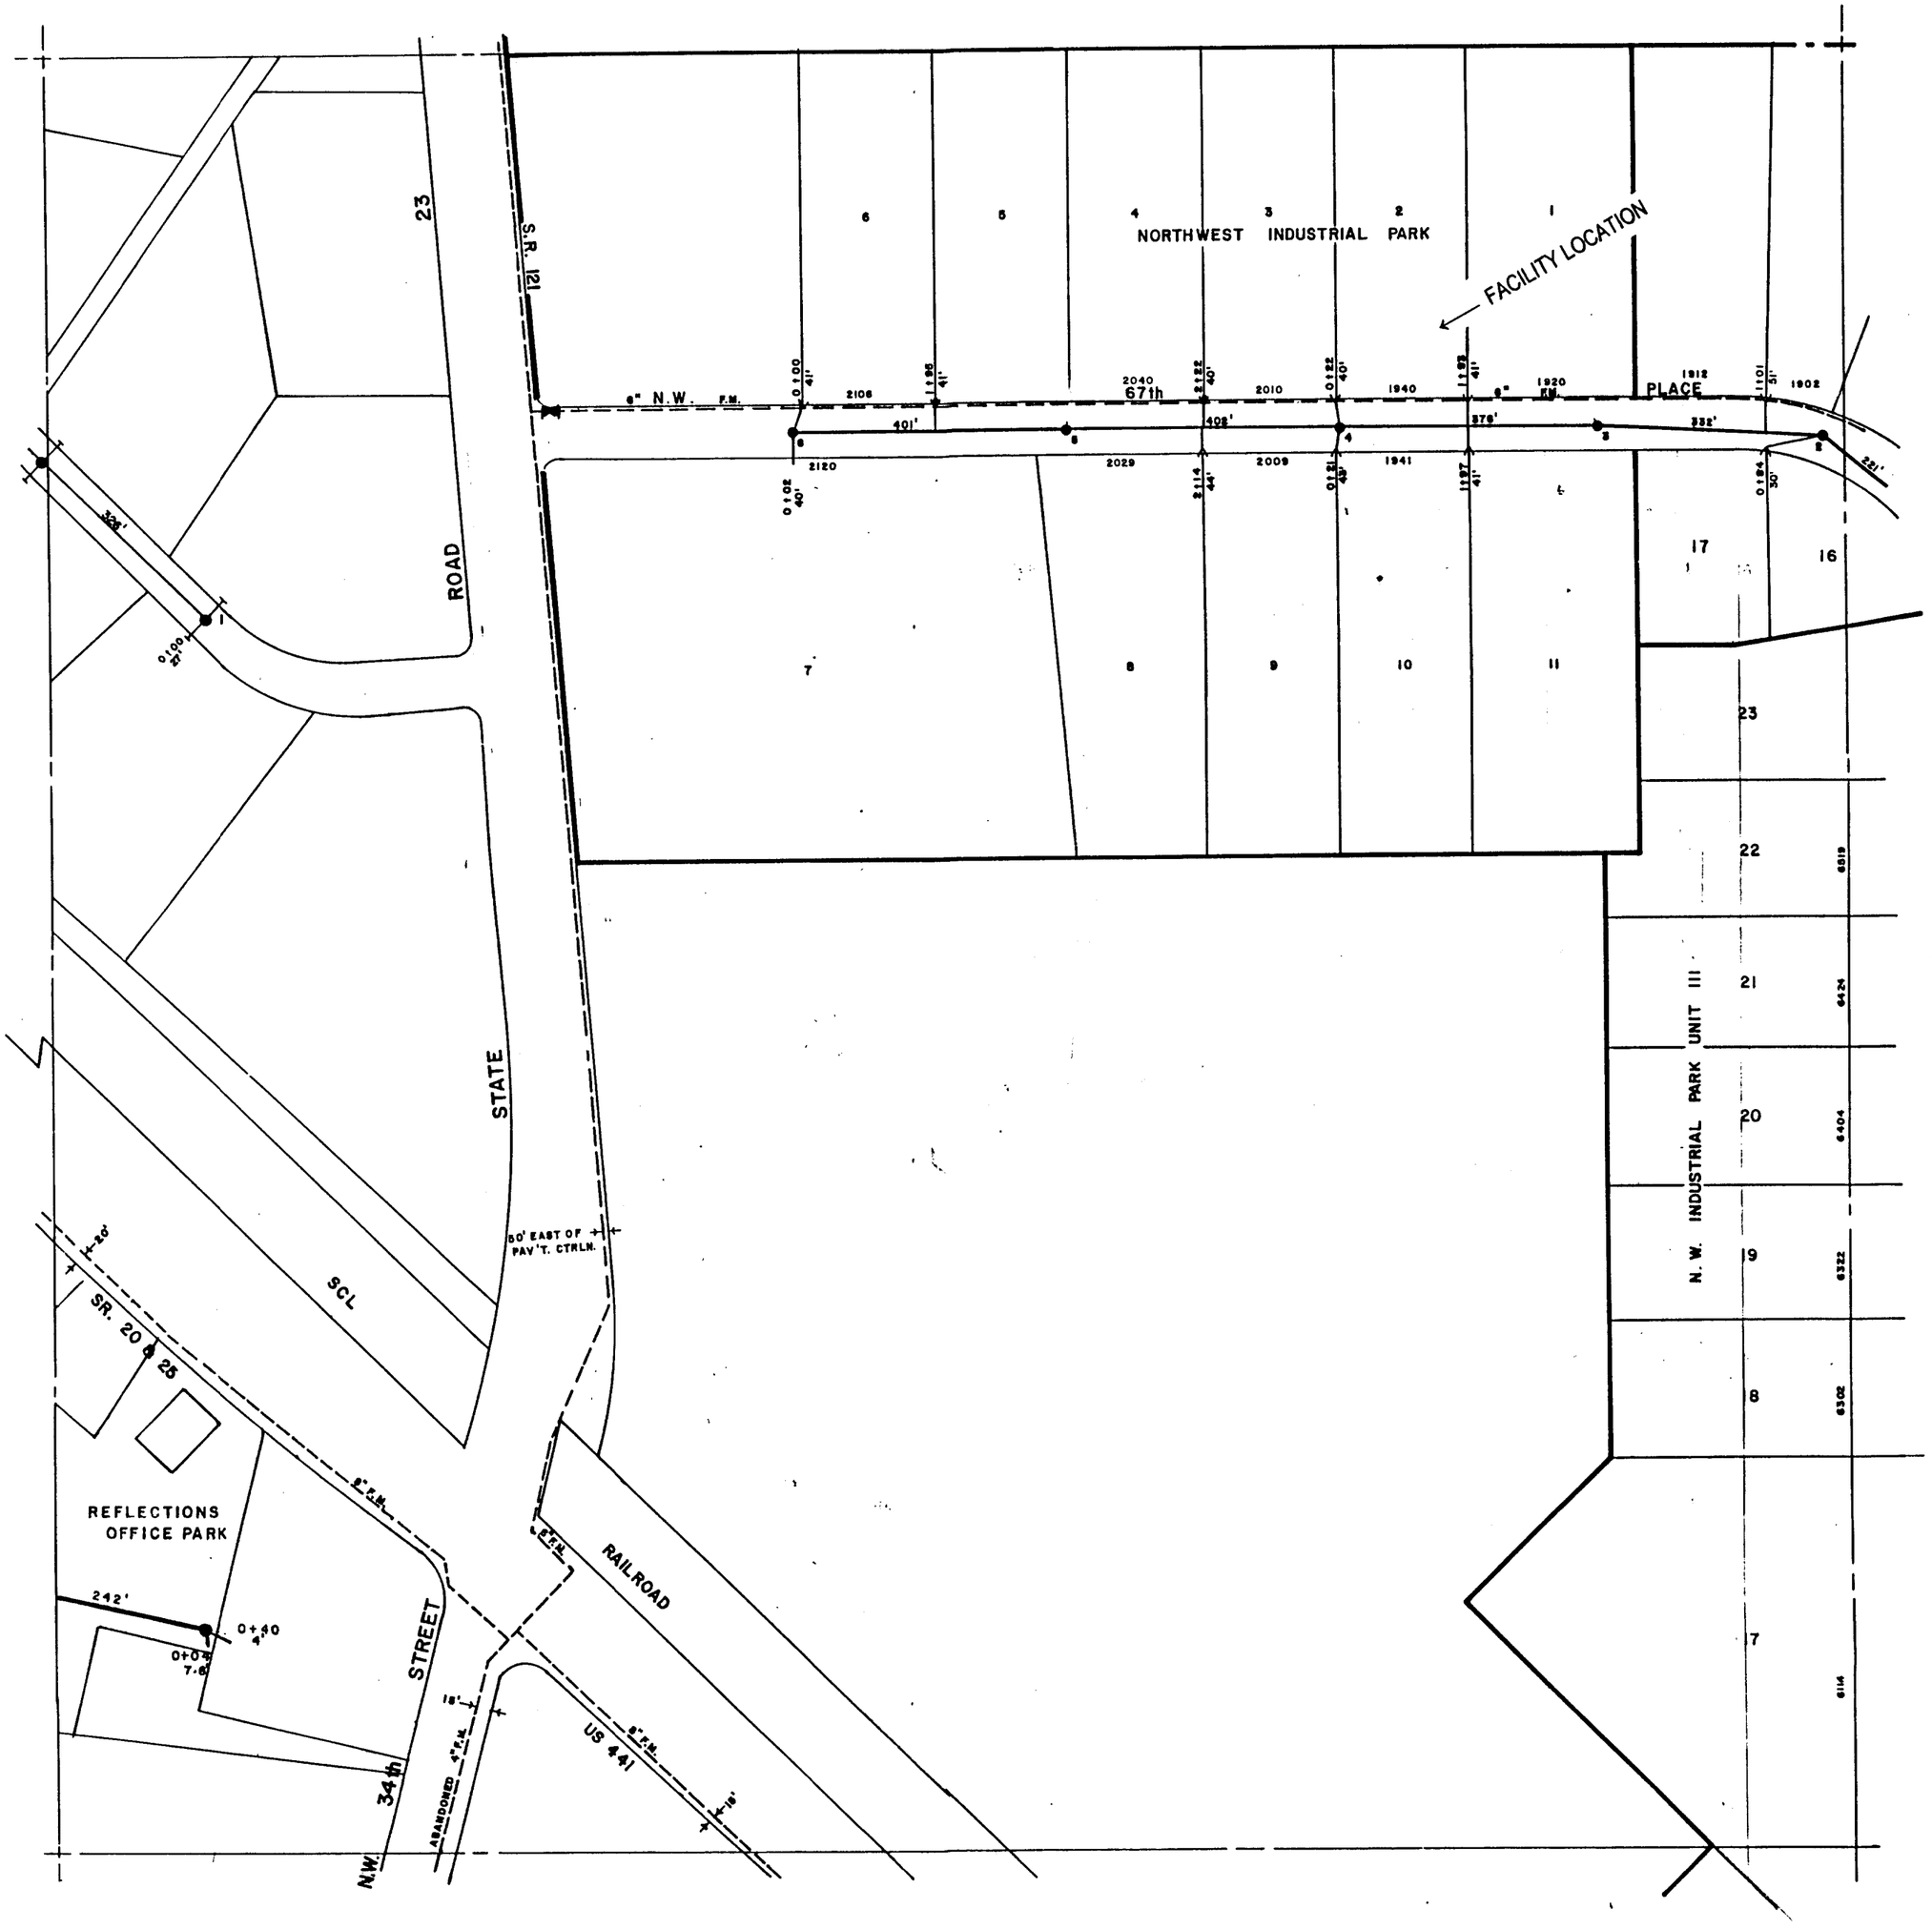


Figure II.A.10

NOTE: LOCATION AND DIMENSIONS ARE GIVEN FOR UTILITIES' STAFF USE ONLY. ENGINEER/CONTRACTOR IS RESPONSIBLE FOR FIELD VERIFICATION.

1" = 200'

"CITY"

CITY OF GAINESVILLE
SANITARY SEWER
278 NW 1/4 OF
SECTION 18 T9S R20E