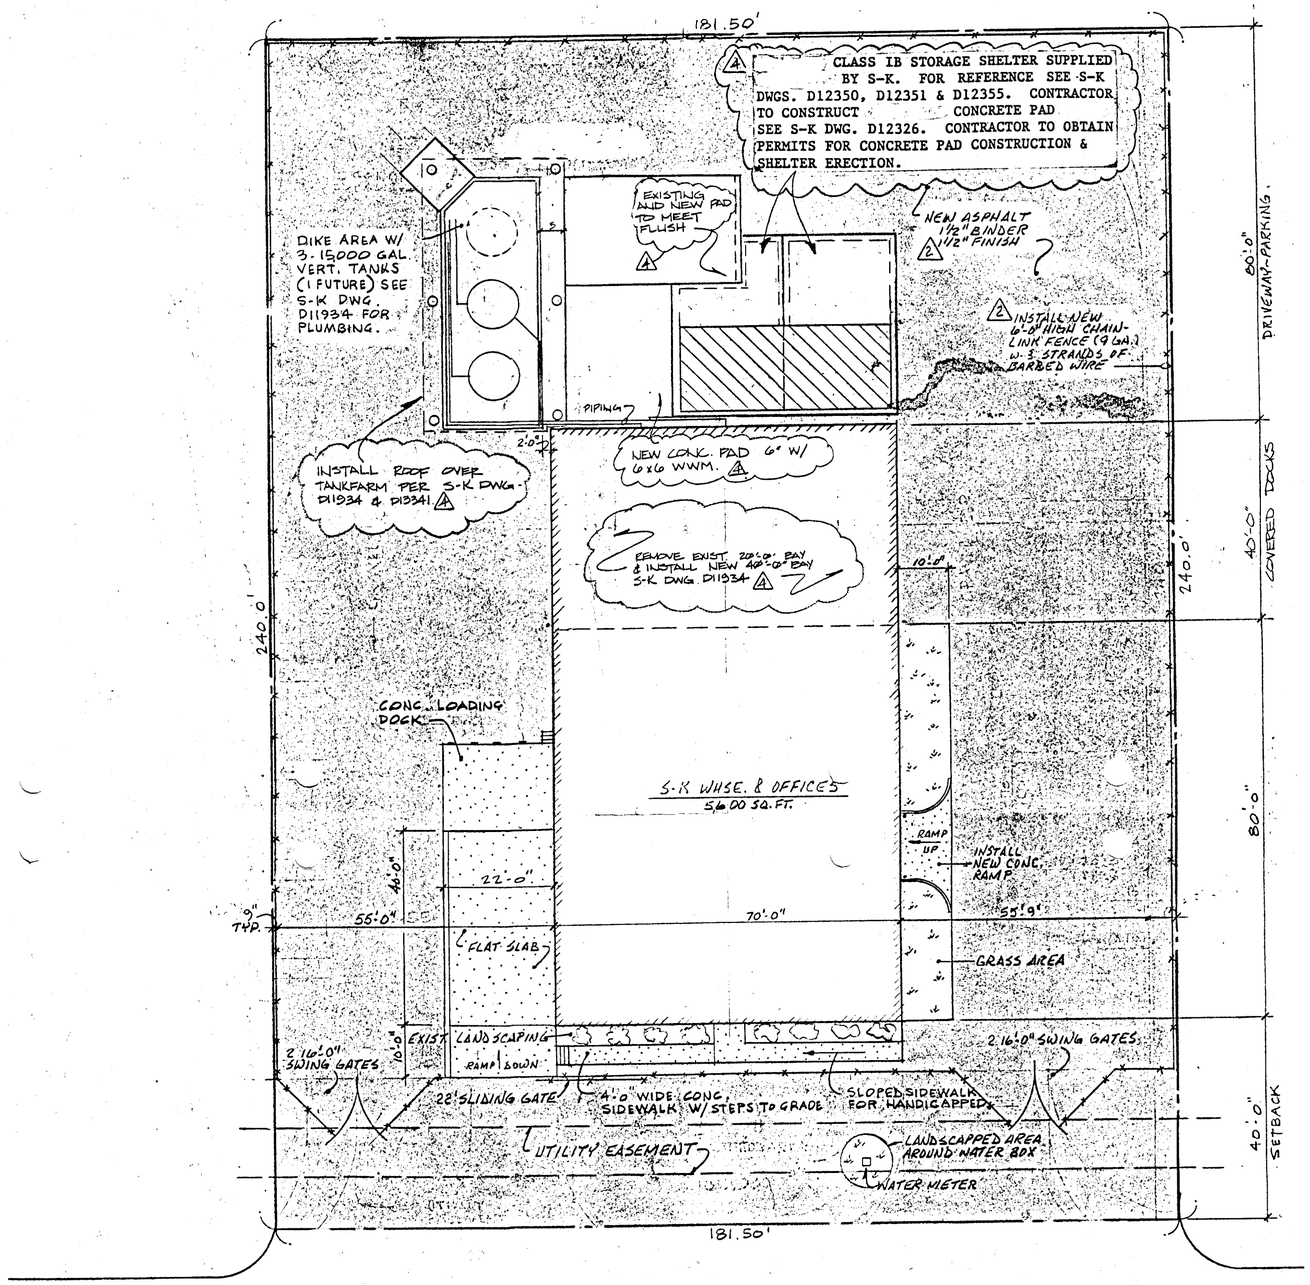


SITE PLAN

SCALE: 1" = 20'-0"

GENERAL NOTES

1. SEWER, ELECTRIC, & WATER ENTRANCES TO BE APTLY & PRACTICALLY LOCATED PER LOCAL SITE.
2. ALL STORM WATER TO BE HANDLED BY USE OF SWALES & GRADUATED GRADES TO DIRECT WATER AWAY FROM IMPROVEMENTS SO AS NOT TO DISTURB THE NATURAL FLOW OF WATER.
3. LOADING RAMP PITS (IF USED) TO BE EQUIPPED WITH CATCH BASIN DRAINS AND/OR SUMP PUMPS.
4. WAREHOUSE & OFFICE MAY BE SINGLE OR DUAL LEVEL PER LOCAL SITE CONDITIONS.
5. DRIVE SURFACE TO BE ROCKED ONLY TO SUFFICIENT DEPTH & DENSITY TO HANDLE HEAVY TRUCK TRAFFIC AS DETERMINED BY LOCAL SOIL CONDITIONS.

NORTHEAST DISTRICT RECEIVED 1990 BER-JACKSONVILLE

5	REDRAW CLS. IB STORAGE SHELT. AREA	JHD	1-5-90
4	EXTEND R/F BAY, CANOPY, TANK, RELOCATE CLASS IB SHELTER.	CAL	[illegible]

1

safety-kleen corp.
655 BIG TIMBER ROAD • ELGIN, ILLINOIS 60120 PHONE 312/697-8460

SITE PLAN

SCALE 1" = 20'-0"	REVISIONS	BY	DATE
DATE 3/25/85	1 ADDED CLASS IB SHELTER	RD	7-4-85
DR'N C.S. CK'D.	2 SHOWED 'AS BUILT' RELOCATED SHELTER ADDED NEW ASPHALT, FENCE & [illegible]	RD	7-15-86
AP'VD.	3 RELOCATED REST. & PAINT SHELTERS	LAL	4-24-87

TITLE FOR SERVICE CENTER BRANCH ORANGE PARK, FL. (3-079-01) NO. D11745