


RACK 0
GROUP 0
SLOT 3
1746-N*4

[illegible]

EXTERNAL
24V DC
POWER
SELECTOR
BACKPLANE
SET TO BACKPLANE

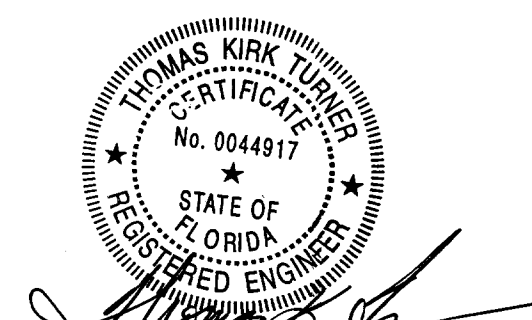

			Turner EnviroLogic ®		
5			STANDARD		
4			REGENERATIVE OXIDIZER		
3			PLC CONFIGURATION		
2	7-25-00	RSP	FELD MOD.		
1	12-10-99	RSP	AS-BHL		
NO	DATE	ID#	REVISION		

Turner EnviroLogic, Inc. reserves all rights in this drawing and all designs, details, inventions or developments covered thereby are unperfected and will be the exclusive property of Turner EnviroLogic, Inc., which reserves all patents, copyrights, or other rights. Copying, reproduction, or duplication, in whole or in part, is forbidden unless expressly authorized by Turner EnviroLogic, Inc. Any such copies shall state the exacting property of Turner EnviroLogic, Inc. This drawing and any such copies shall be returned when requested and used subject to above conditions only on authorized company stock.

DRAWN BY	RR	SCALE	NONE	REV. DRAWING	XXXX
CHECKED		DATE	9-23-99	(DRAWING NO.)	
APPROVED		PROJECT		UAT-	B-1165