

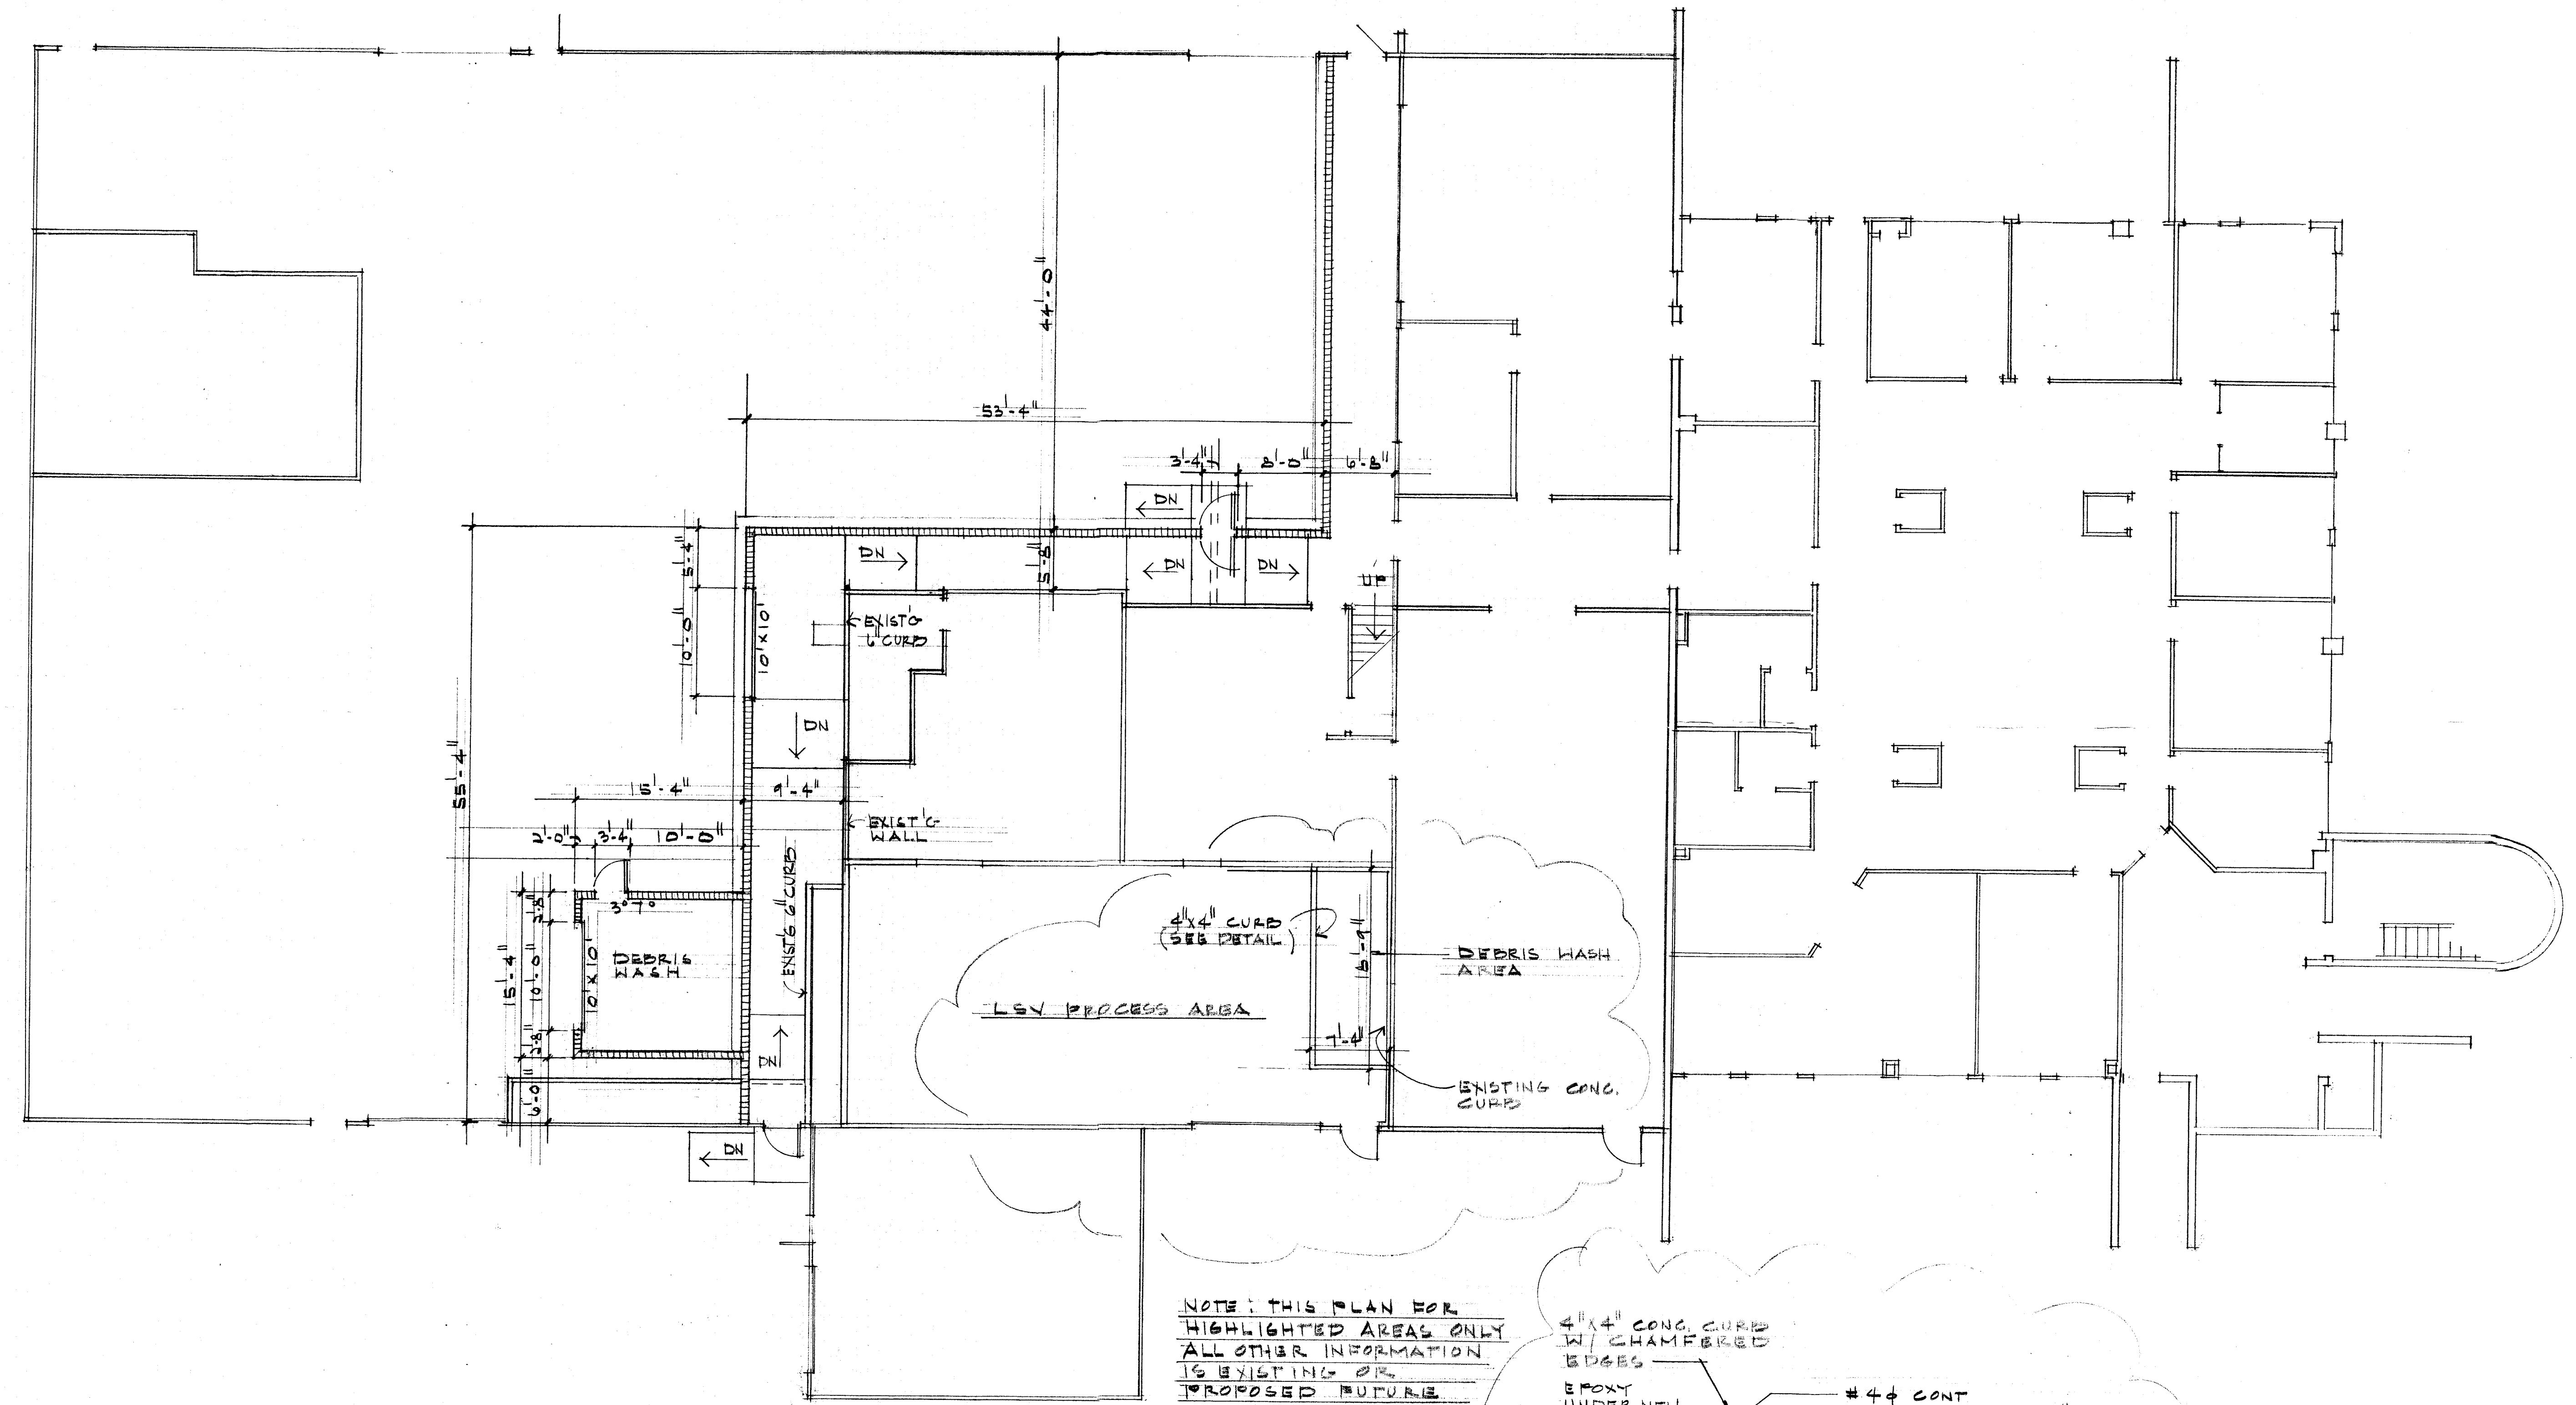


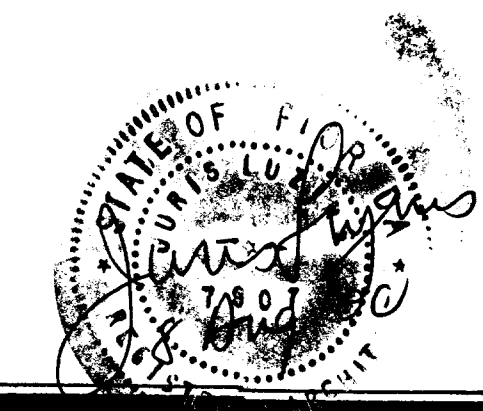

FLOOR PLAN
1/8" = 1' - 0"

NOTE: THIS PLAN FOR
HIGHLIGHTED AREAS ONLY
ALL OTHER INFORMATION
IS EXISTING OR
PROPOSED FUTURE
WORK

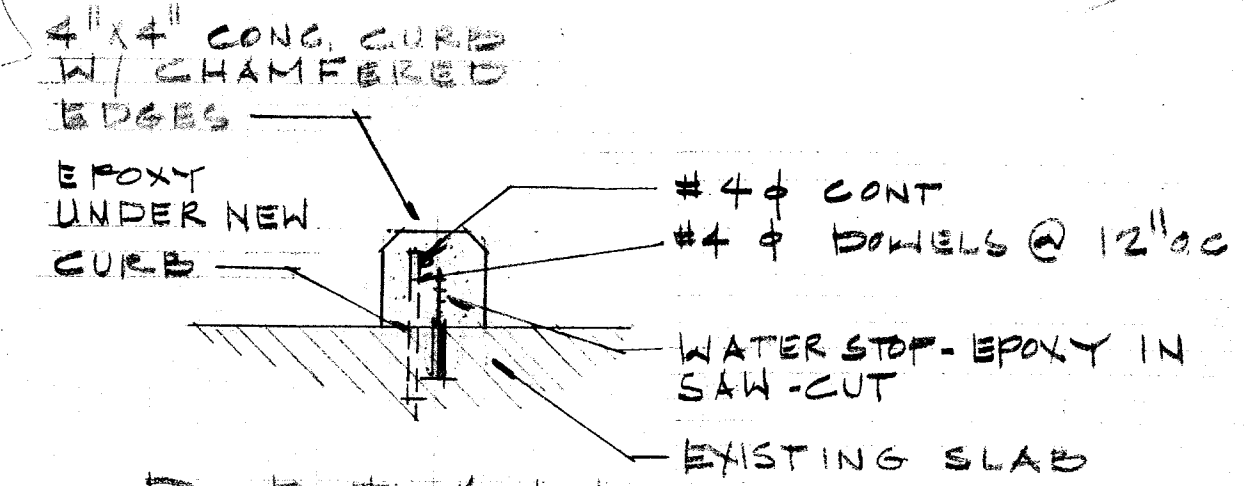

Juris Luzins
architect
gainesville florida

sheet description
drawn by
checked

PERMA-FIX OF FLORIDA
DEBRIS WASH CURBING IN LAB PROCESS
AREA

file no.
2025
date
8 AUG 00
revised
sheet
1
of