


**LEGEND**

SYMBOLS AS PER ISA S5.1 EXCEPT AS SHOWN

- C IGNITOR
- CN IGNITION TRANSFORMER
- M MOTOR
- EL MOTOP LIGHT (RUN)
- TP TEST PORT
- VFD VARIABLE FREQUENCY DRIVE
- XS SHUT OFF SWITCH
- XSS SAFETY SHUT OFF SWITCH
- XV SHUT OFF VALVE

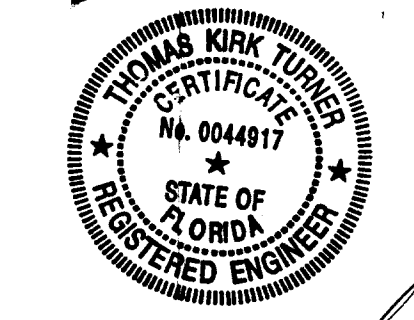

*Thomas Kirk Turner*

LIMIT OF SUPPLY (BLACK-TEI/  
WHITE-CUSTOMER)

LAST - 240

<b>Turner EnviroLogic</b> PERMA-FIX ENVIRONMENTAL SERVICES V.O.C. COLLECTION SYSTEM P&ID	
1. 3-11-00 RSP AS BUILT 2. 4-20-99 JCS SYSTEM UPDATE 3. 8-20-99 JCS SYSTEM UPDATE	REVISION RSP NONE 4-15-99 2832 5361 3