


SITE PLAN

scale: 1"=20'-0"


NOTE: DRUMS TO BE DRUM STORAGE AREA CONTAIN NON-HAZARDOUS PETROLEUM CONTAMINATED DEBRIS.

CONTAINMENT CALCULATIONS:

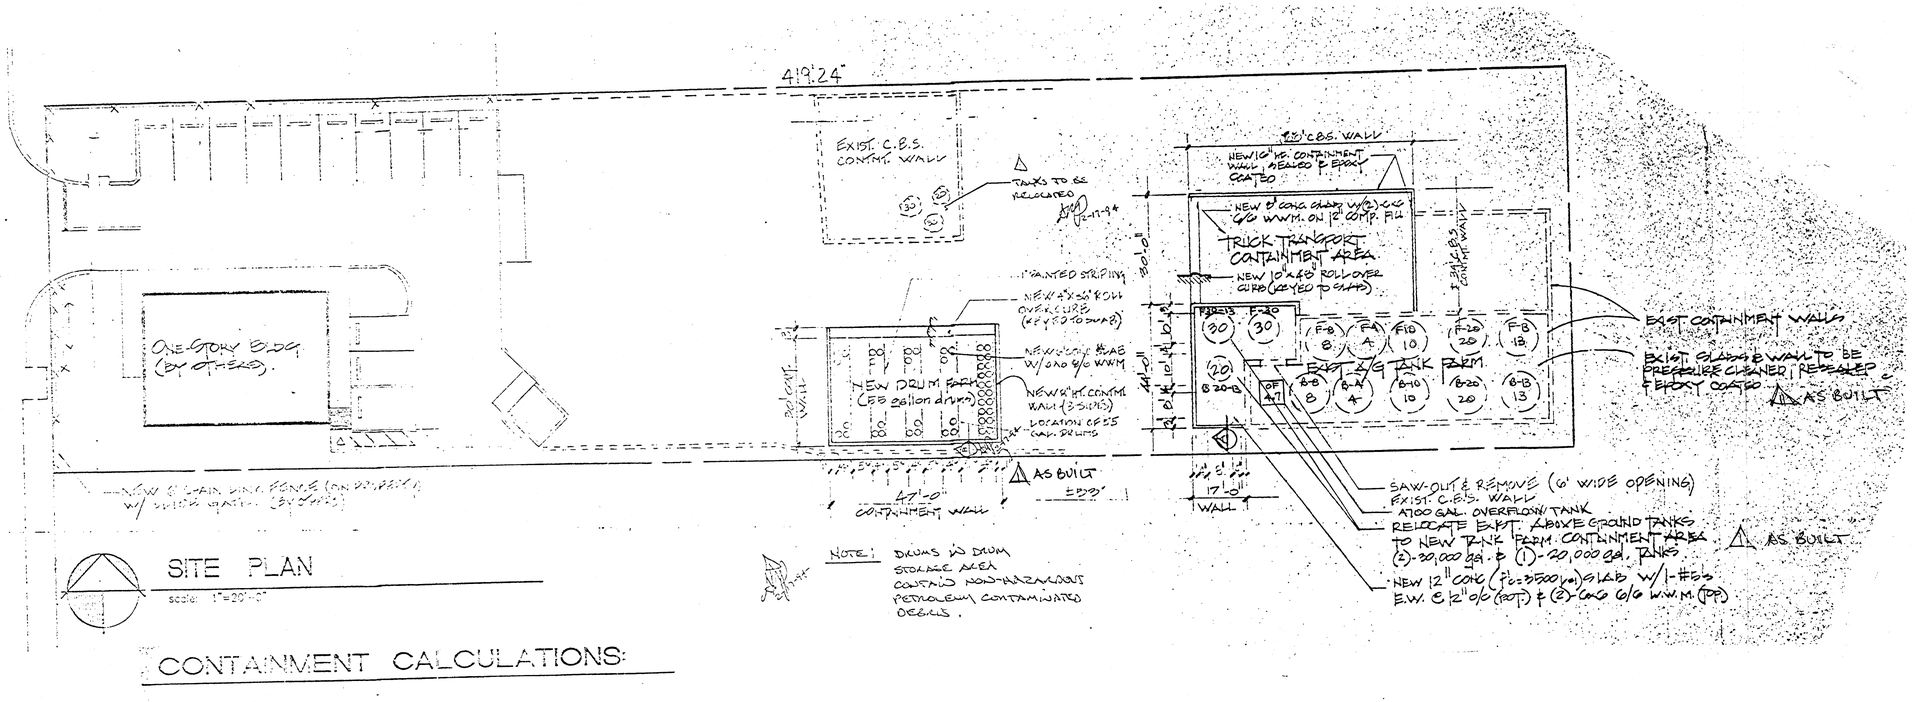

SECTION A ⚠ AS BUILT

scale: 1"=1'-0"

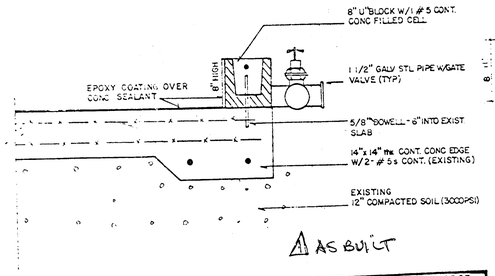


⚠ AS BUILT

SECTION B

scale 1"=1'-0"

BROWARD COUNTY OFFICE OF NATURAL RESOURCE PROTECTION
PLANS REVIEWED BY ENVIRONMENTAL ASSESSMENT AND REMEDIATION
LORENZO FERNANDEZ, P.E. - MANAGER
4/17/98

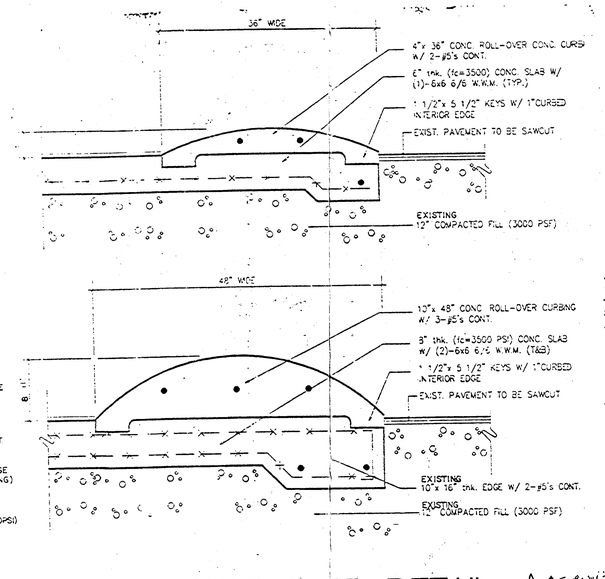

ROLL - OVER CURB DETAIL ⚠ AS BUILT

scale: 1"=1'-0"

RICHARD L. MORRIS FL. P.E. REG. # 34743 CIVIL

THIS DWG IS THE PROPERTY OF L.B.M. INC.
ANY REPRODUCTION OR USE WITHOUT PERMISSION FROM L.B.M. IS PROHIBITED.

DATE	REVISIONS	DRAWN BY
6-15-94	REV "AS-BUILT"	

ABOVEGROUND TANK STORAGE FACILITY

LINGERFELDT - MORRIS, Inc.
EB # 0007137
CORAL GATE PROFESSIONAL PLAZA
5653 N.W. 29th STREET
MARGATE, FLORIDA 33063
PHONE (954) 975-8764
FAX (954) 975-0087
ENGINEERS
SITE DEVELOPMENT
PETROLEUM CONSULTANTS
CONSTRUCTION MANAGEMENT
PERMITTING

PETROLEUM MANAGEMENT, INC.
3650 S.W. 47TH AVENUE
DAVIE, FLORIDA

JOB NO.	97134
DRAWN BY:	E.L.H.
DATE:	6/18/97
C:\ACAD\97\97134_1	
SCALE:	AS NOTED
SHEET NO:	1

3-24-98 REV. #1