


**USFLITER RECOVERY SERVICES MID-ATLANTIC
POMPAMO BEACH, FLORIDA, FACILITY
SITE PLAN - OPERATIONS AREA**

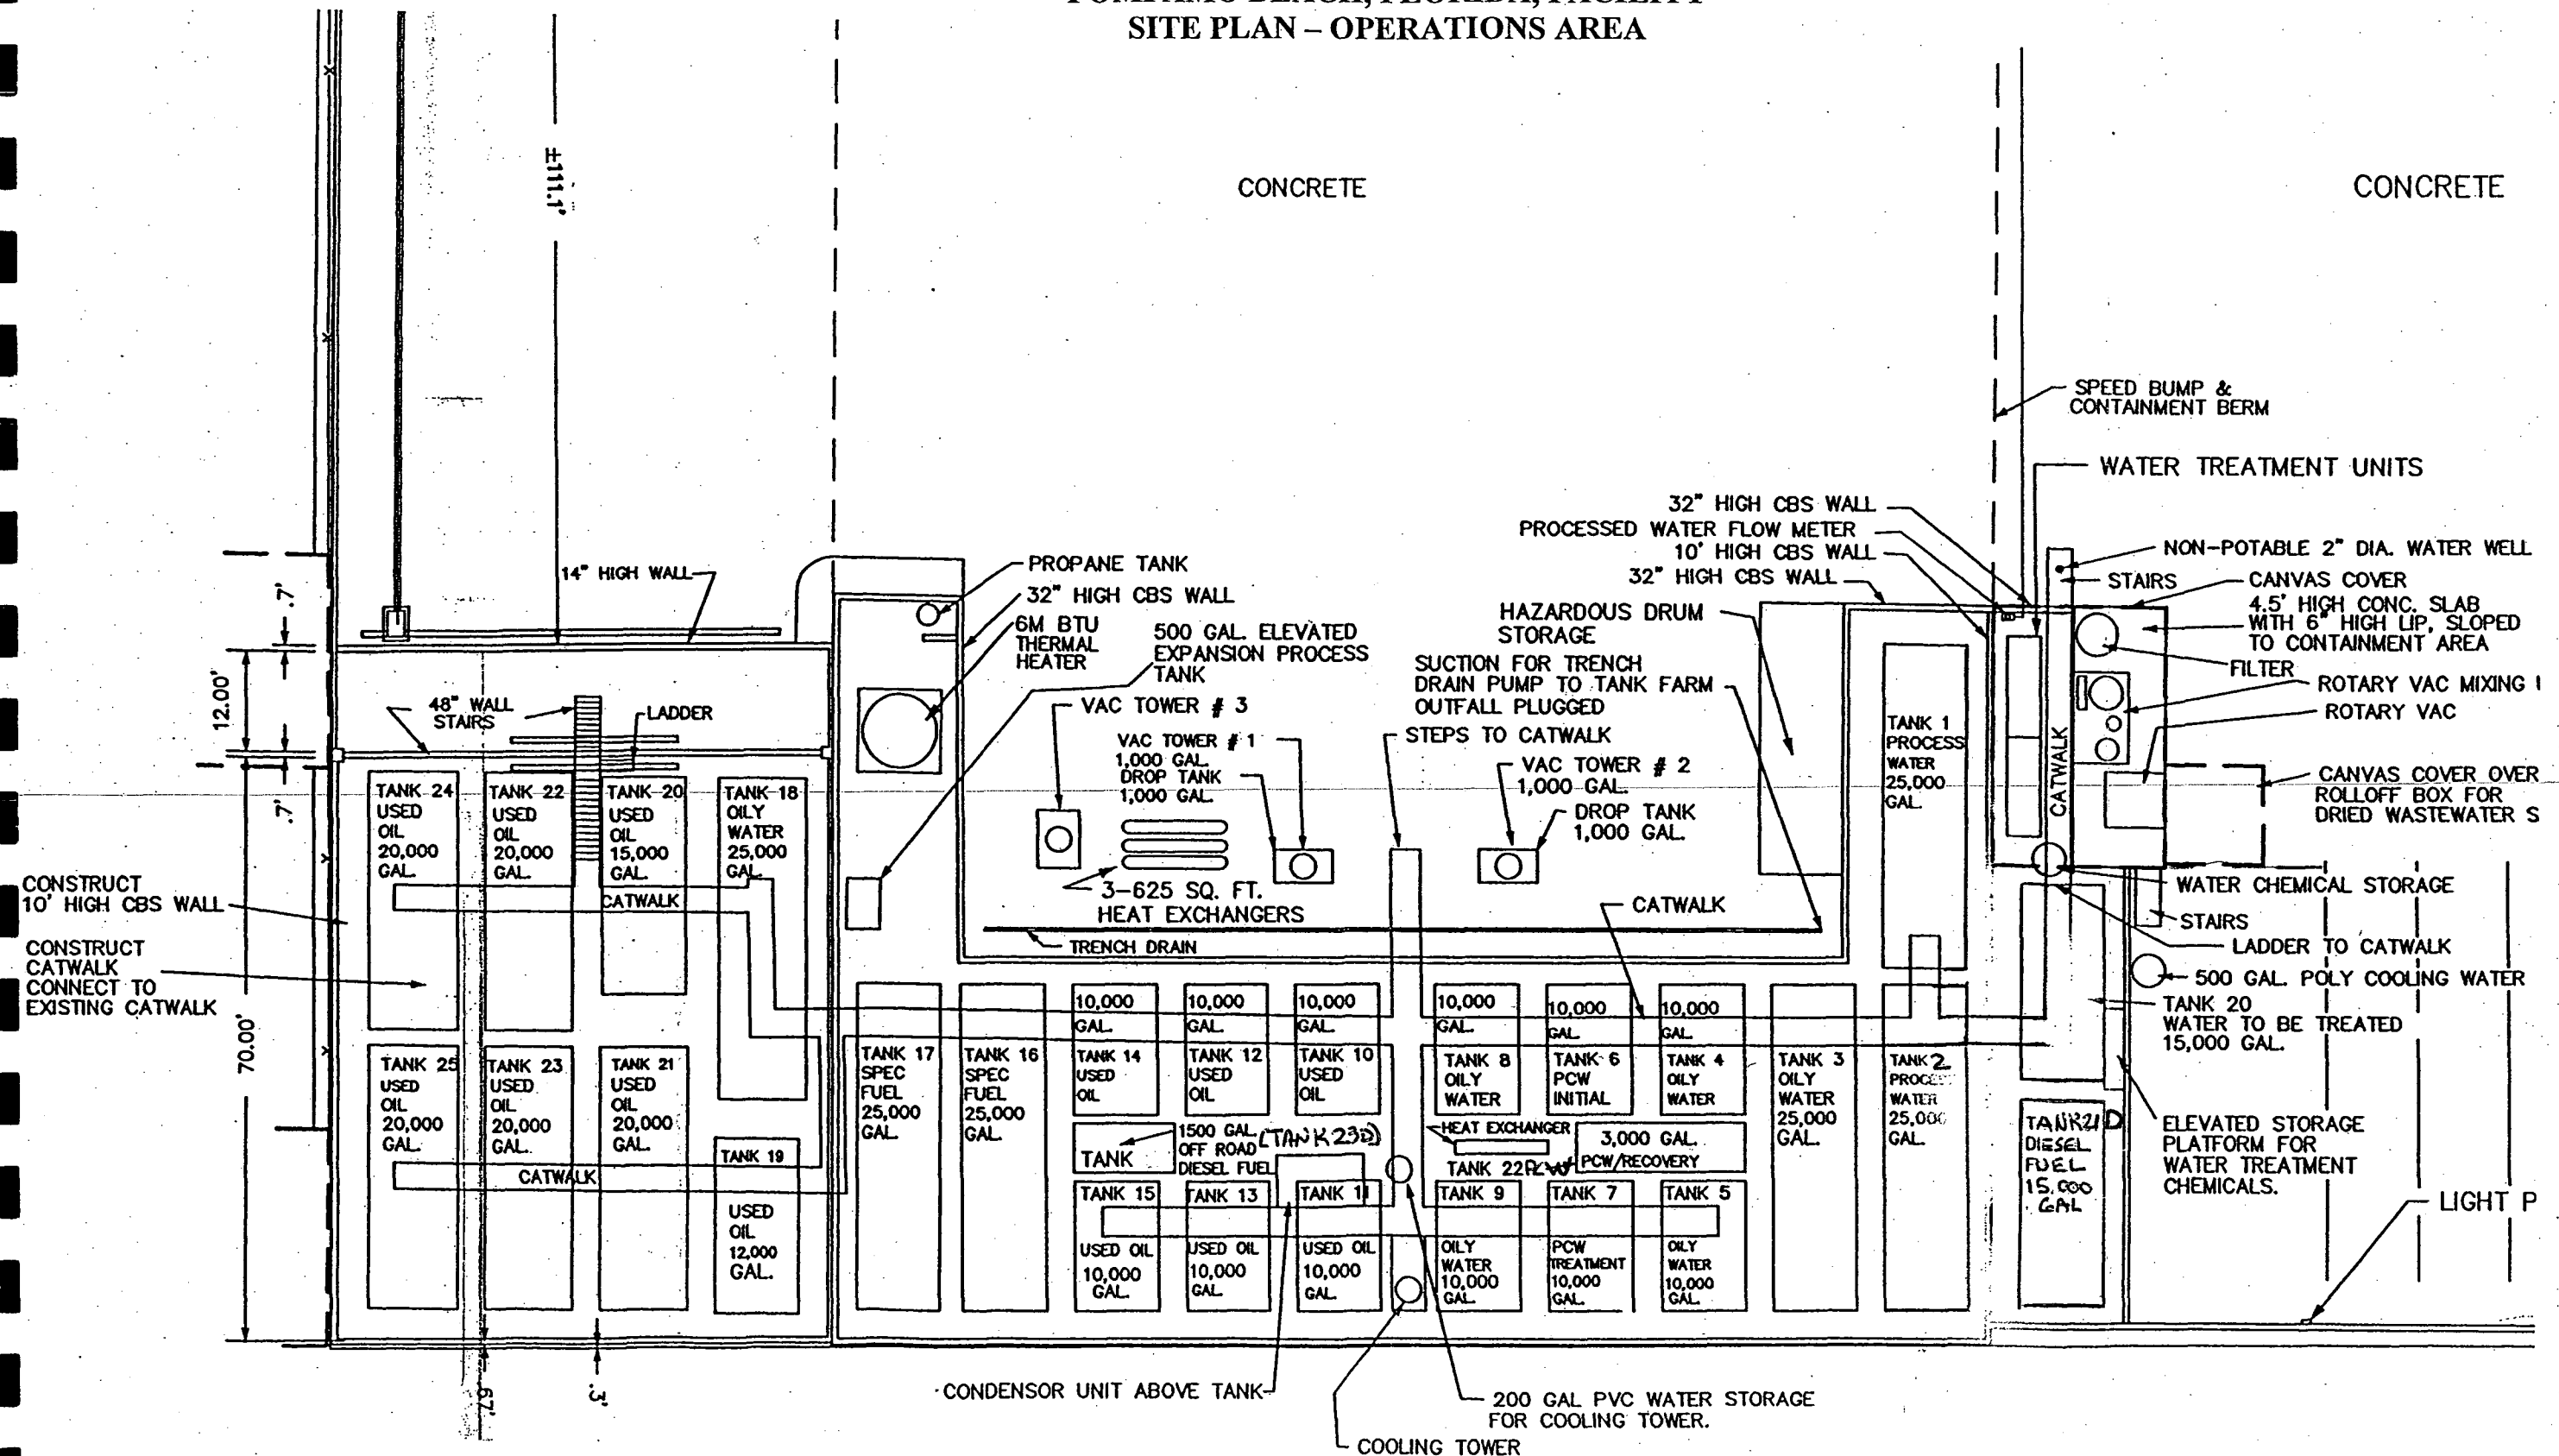

NOTE: SCALE AS NOTED ON DRAWING