


USFLITER RECOVERY SERVICES MID-ATLANTIC
POMPAMO BEACH, FLORIDA, FACILITY

SITE PLAN - ADMINISTRATIVE AREA

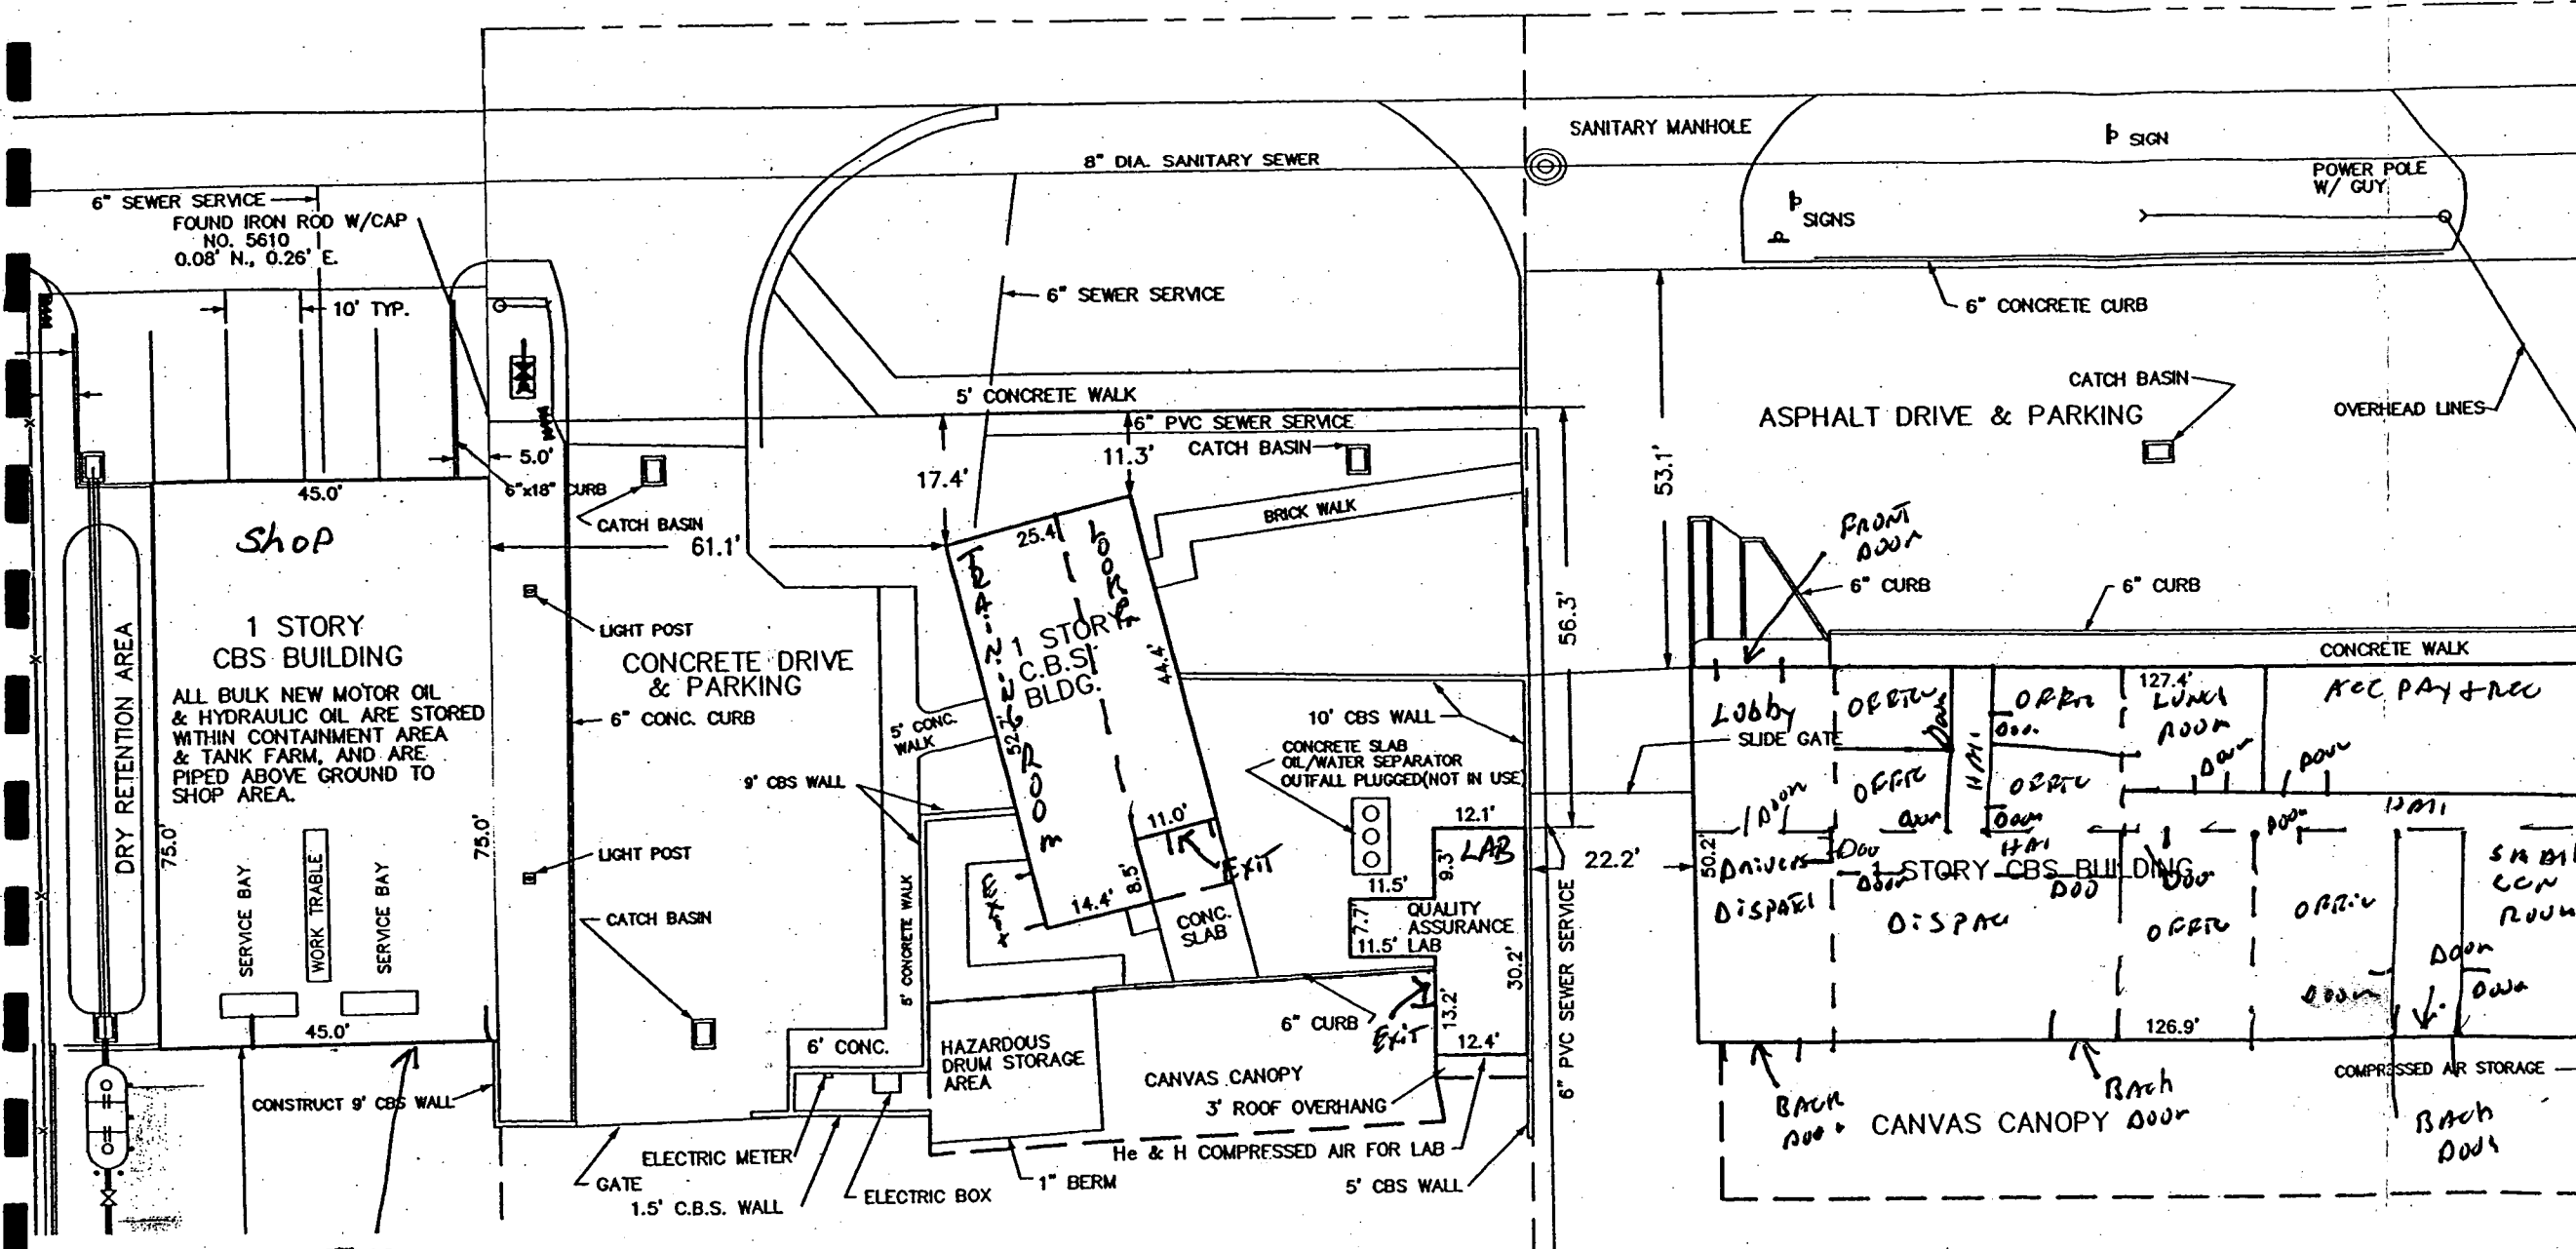

NOTE: SCALE AS NOTED ON DRAWING