


SITE PLAN – ADMINISTRATIVE AREA

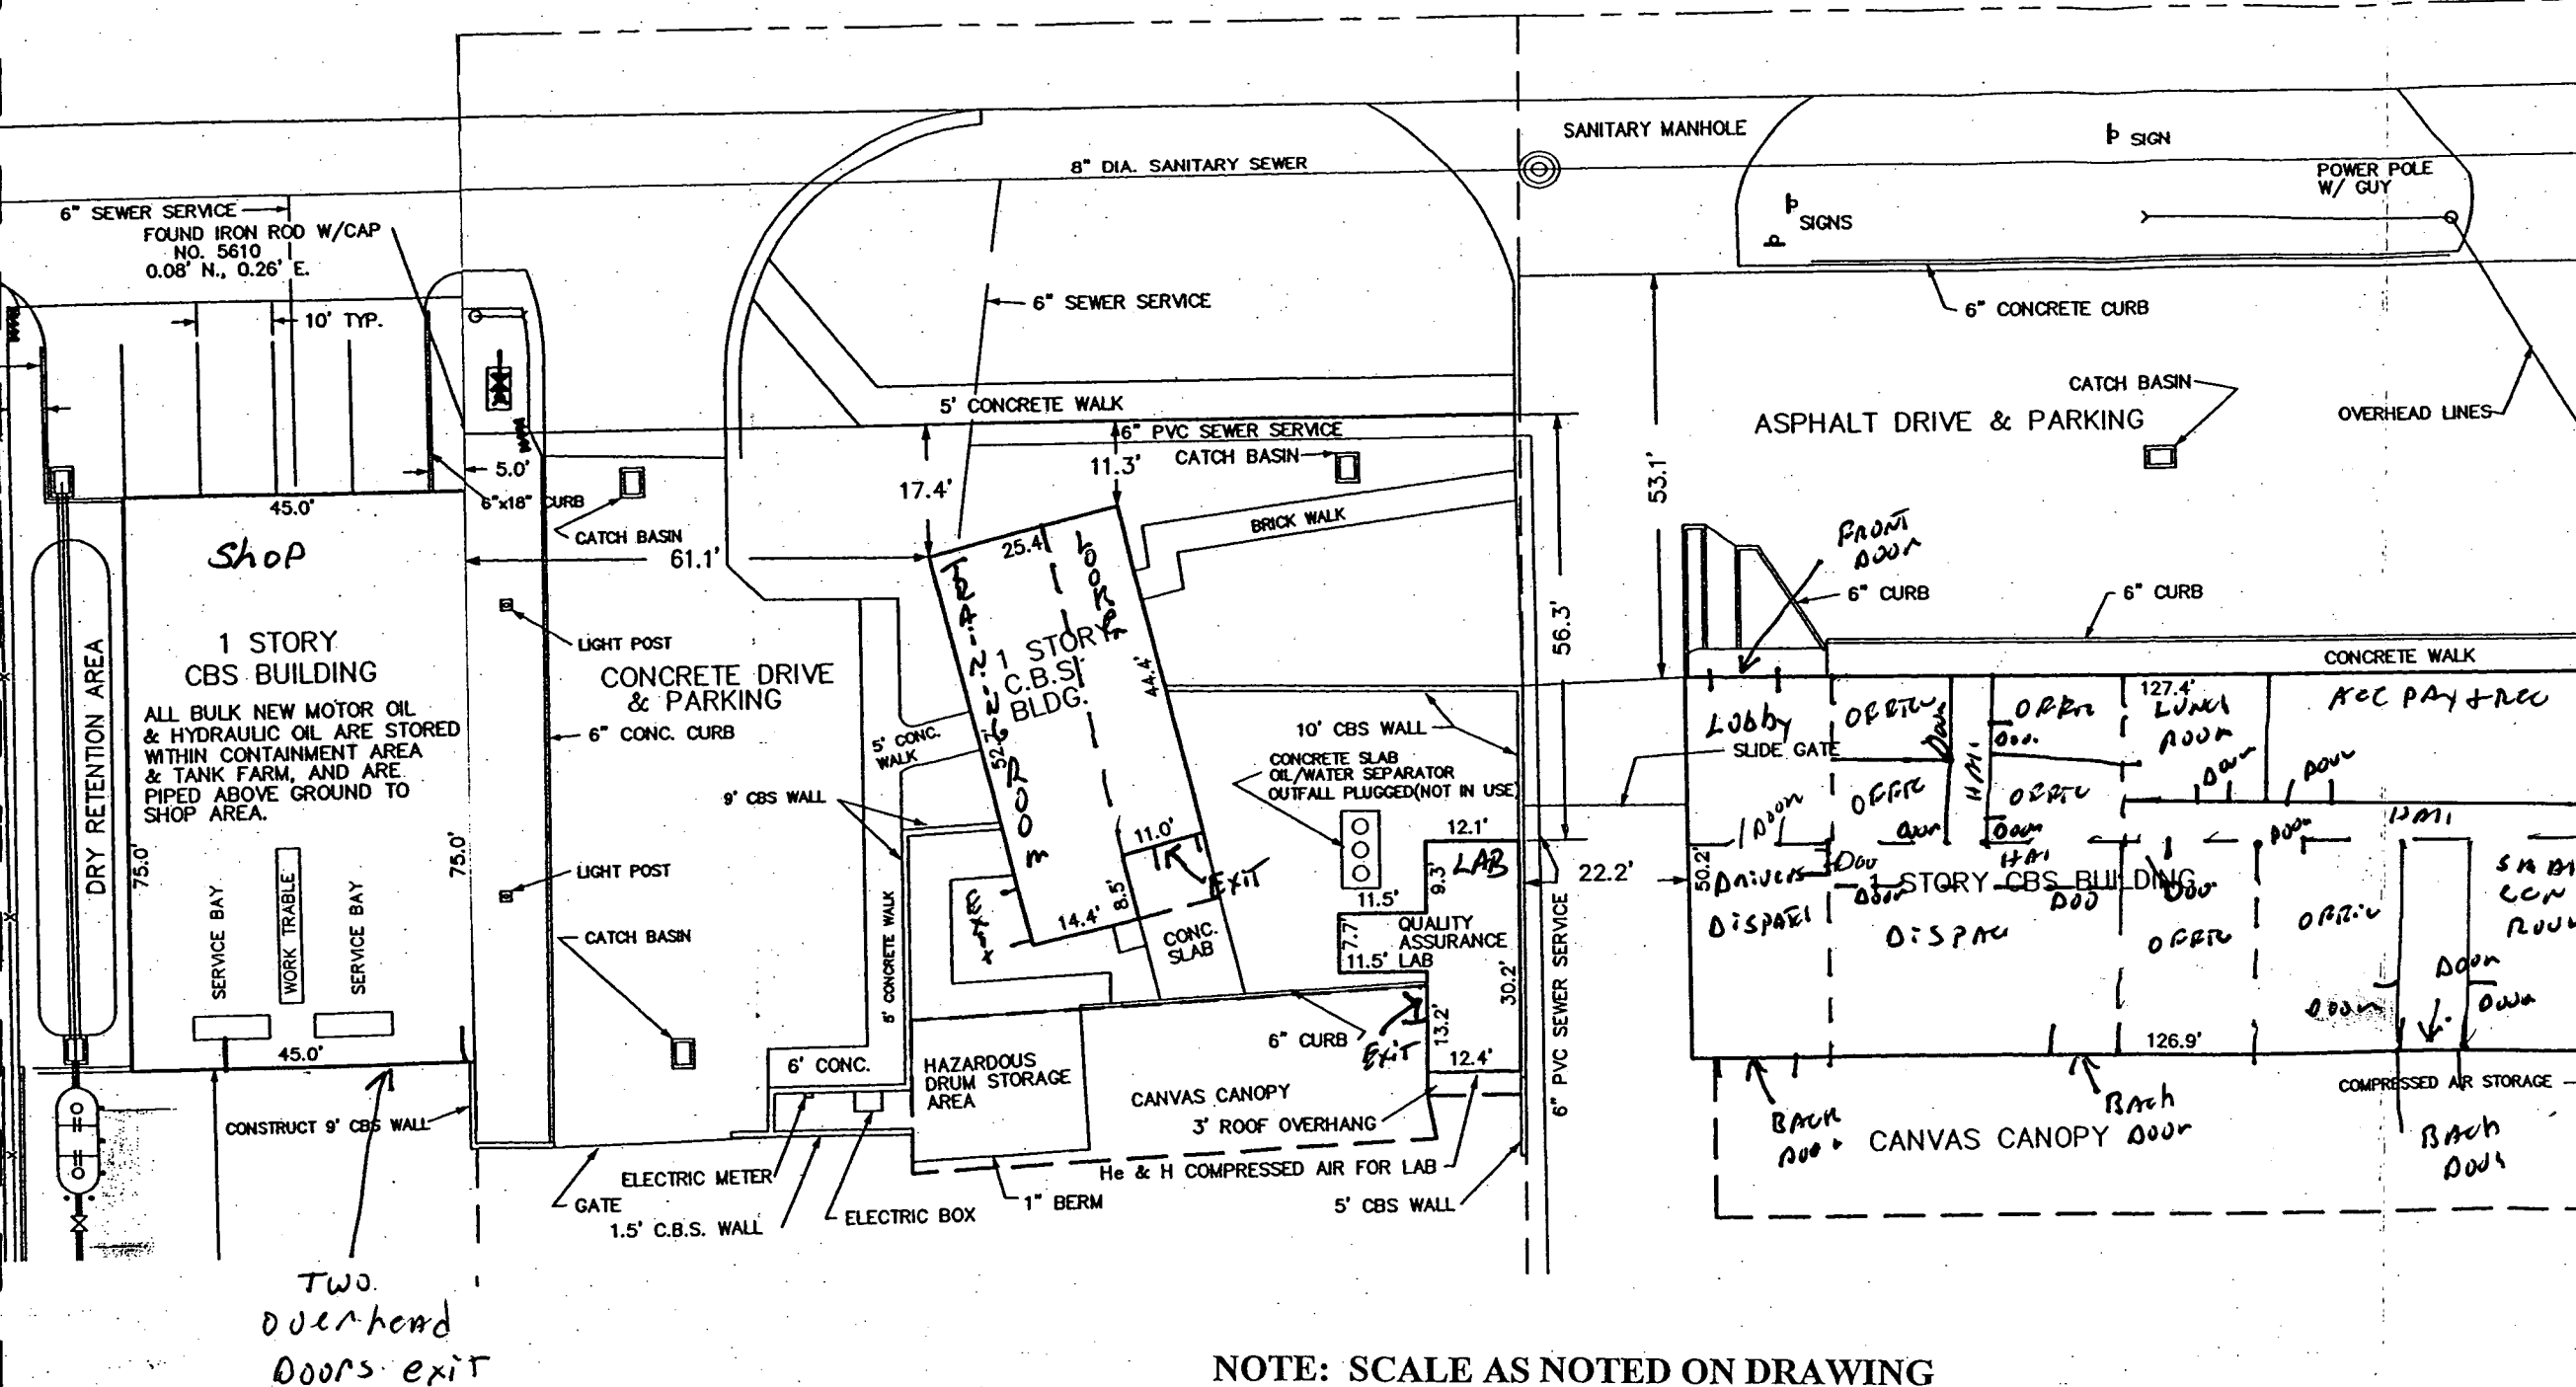

NOTE: SCALE AS NOTED ON DRAWING