APPENDIX C

USFLITER RECOVERY SERVICES MID-ATLANTIC
POMPAMO BEACH, FLORIDA, FACILITY

Evacuation Plan

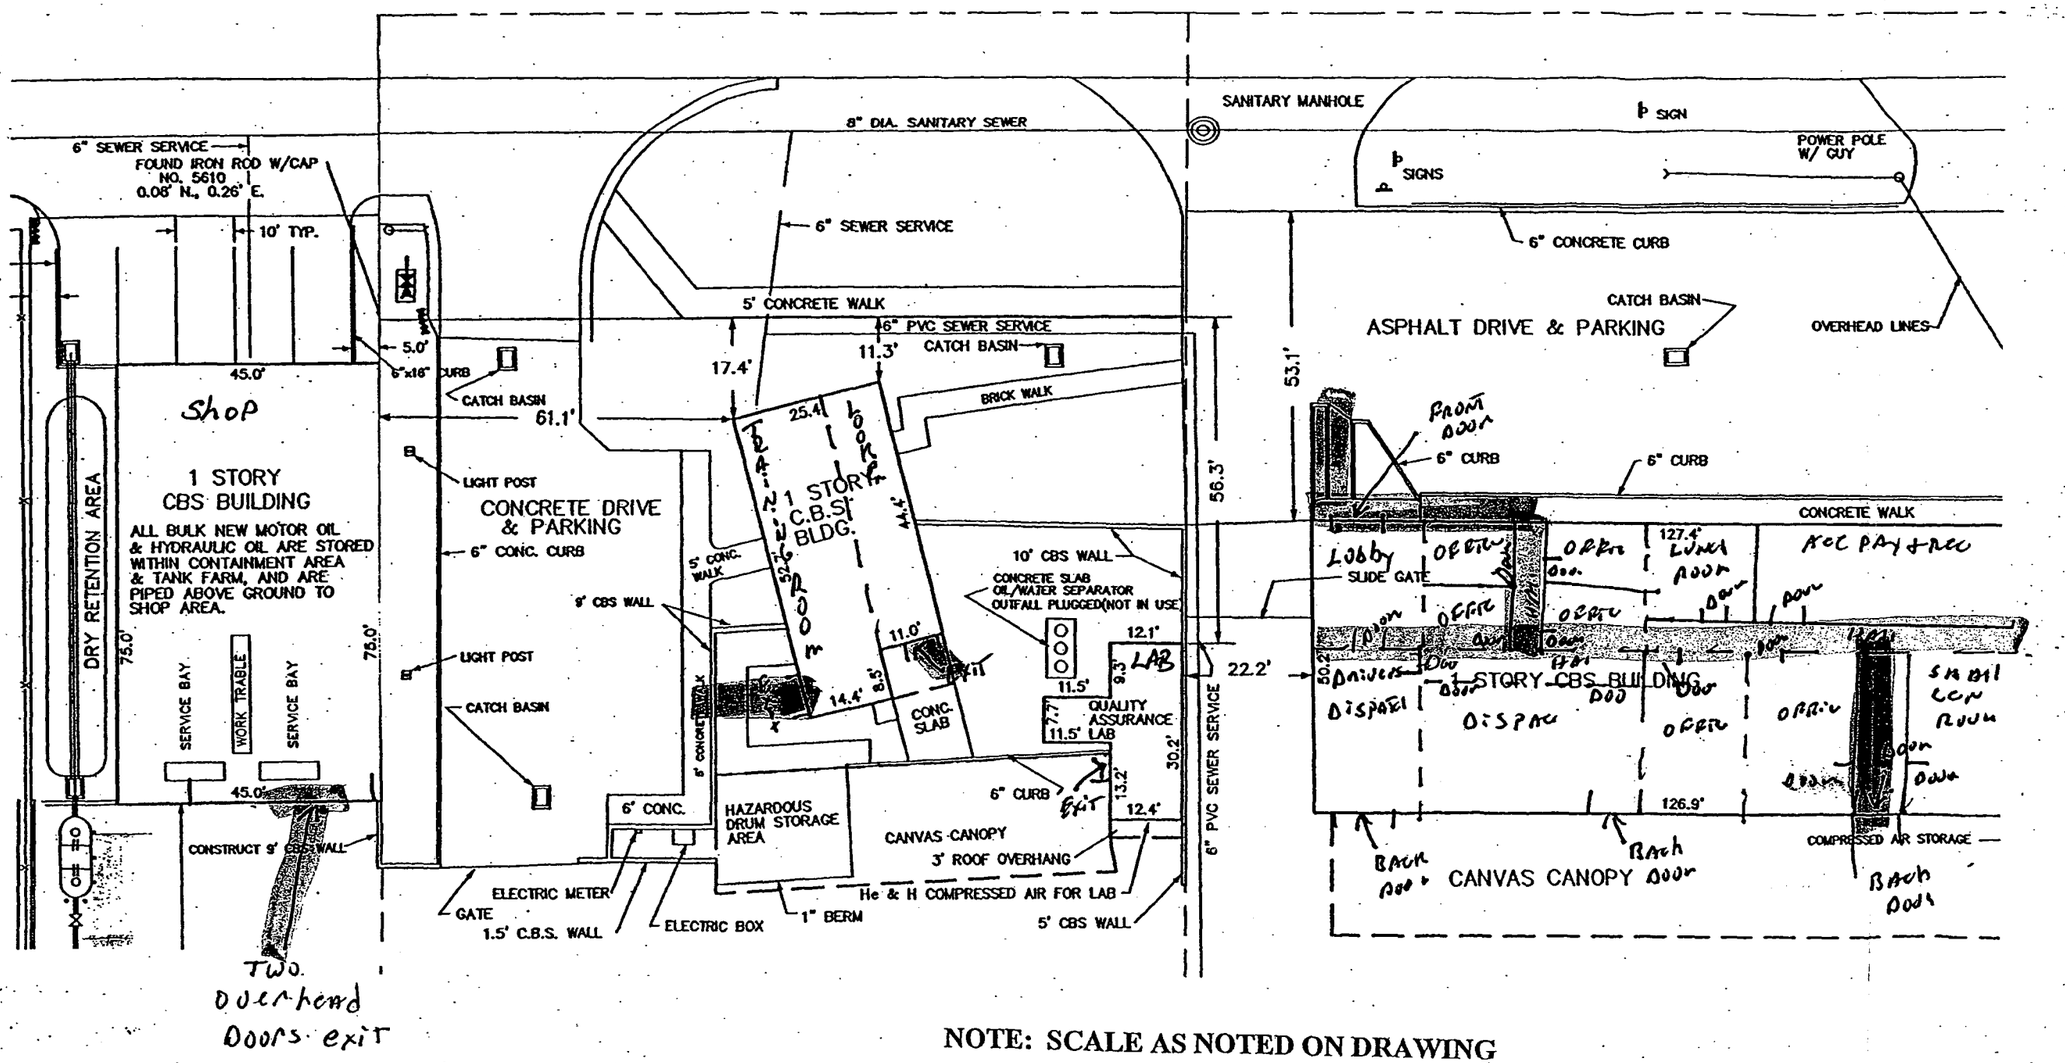

NOTE: SCALE AS NOTED ON DRAWING