
## USFLITER RECOVERY SERVICES MID-ATLANTIC POMPAMO BEACH, FLORIDA, FACILITY

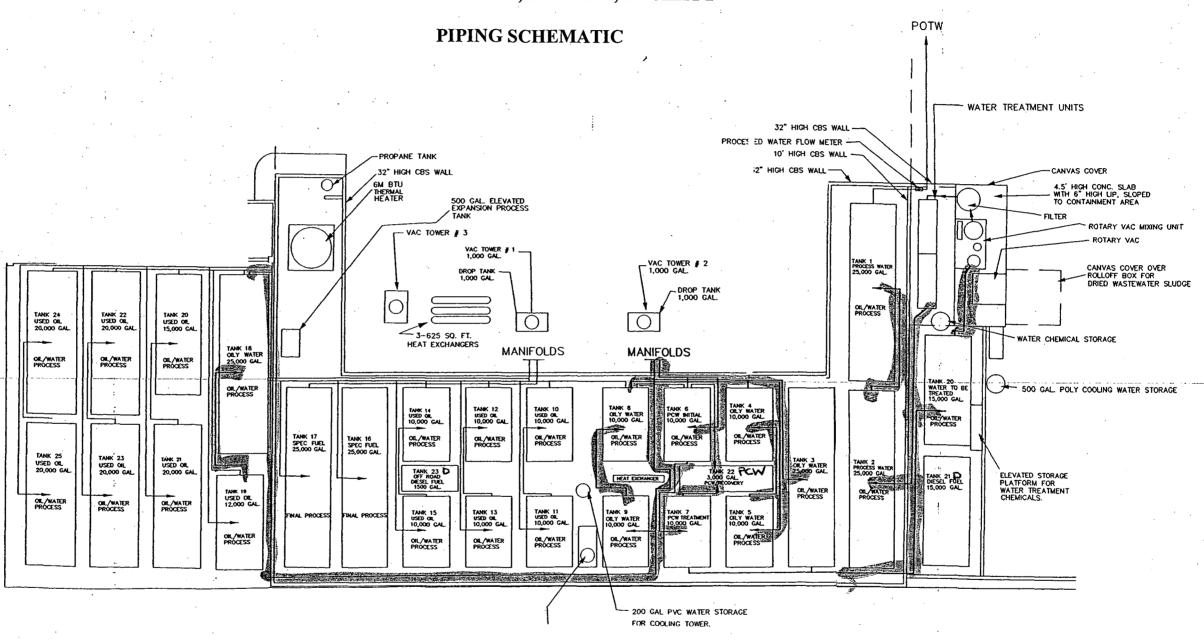

NOTE: WATER SIDE PIPING IS SHADED REMAINDER IS FOR OIL AND SPECIFICATION FUEL