


WASTEWATER TREATMENT SYSTEM PIPING DIAGRAM

Figure: II.C.3/4.-5
Revision: 0
Date: 02/25/2003

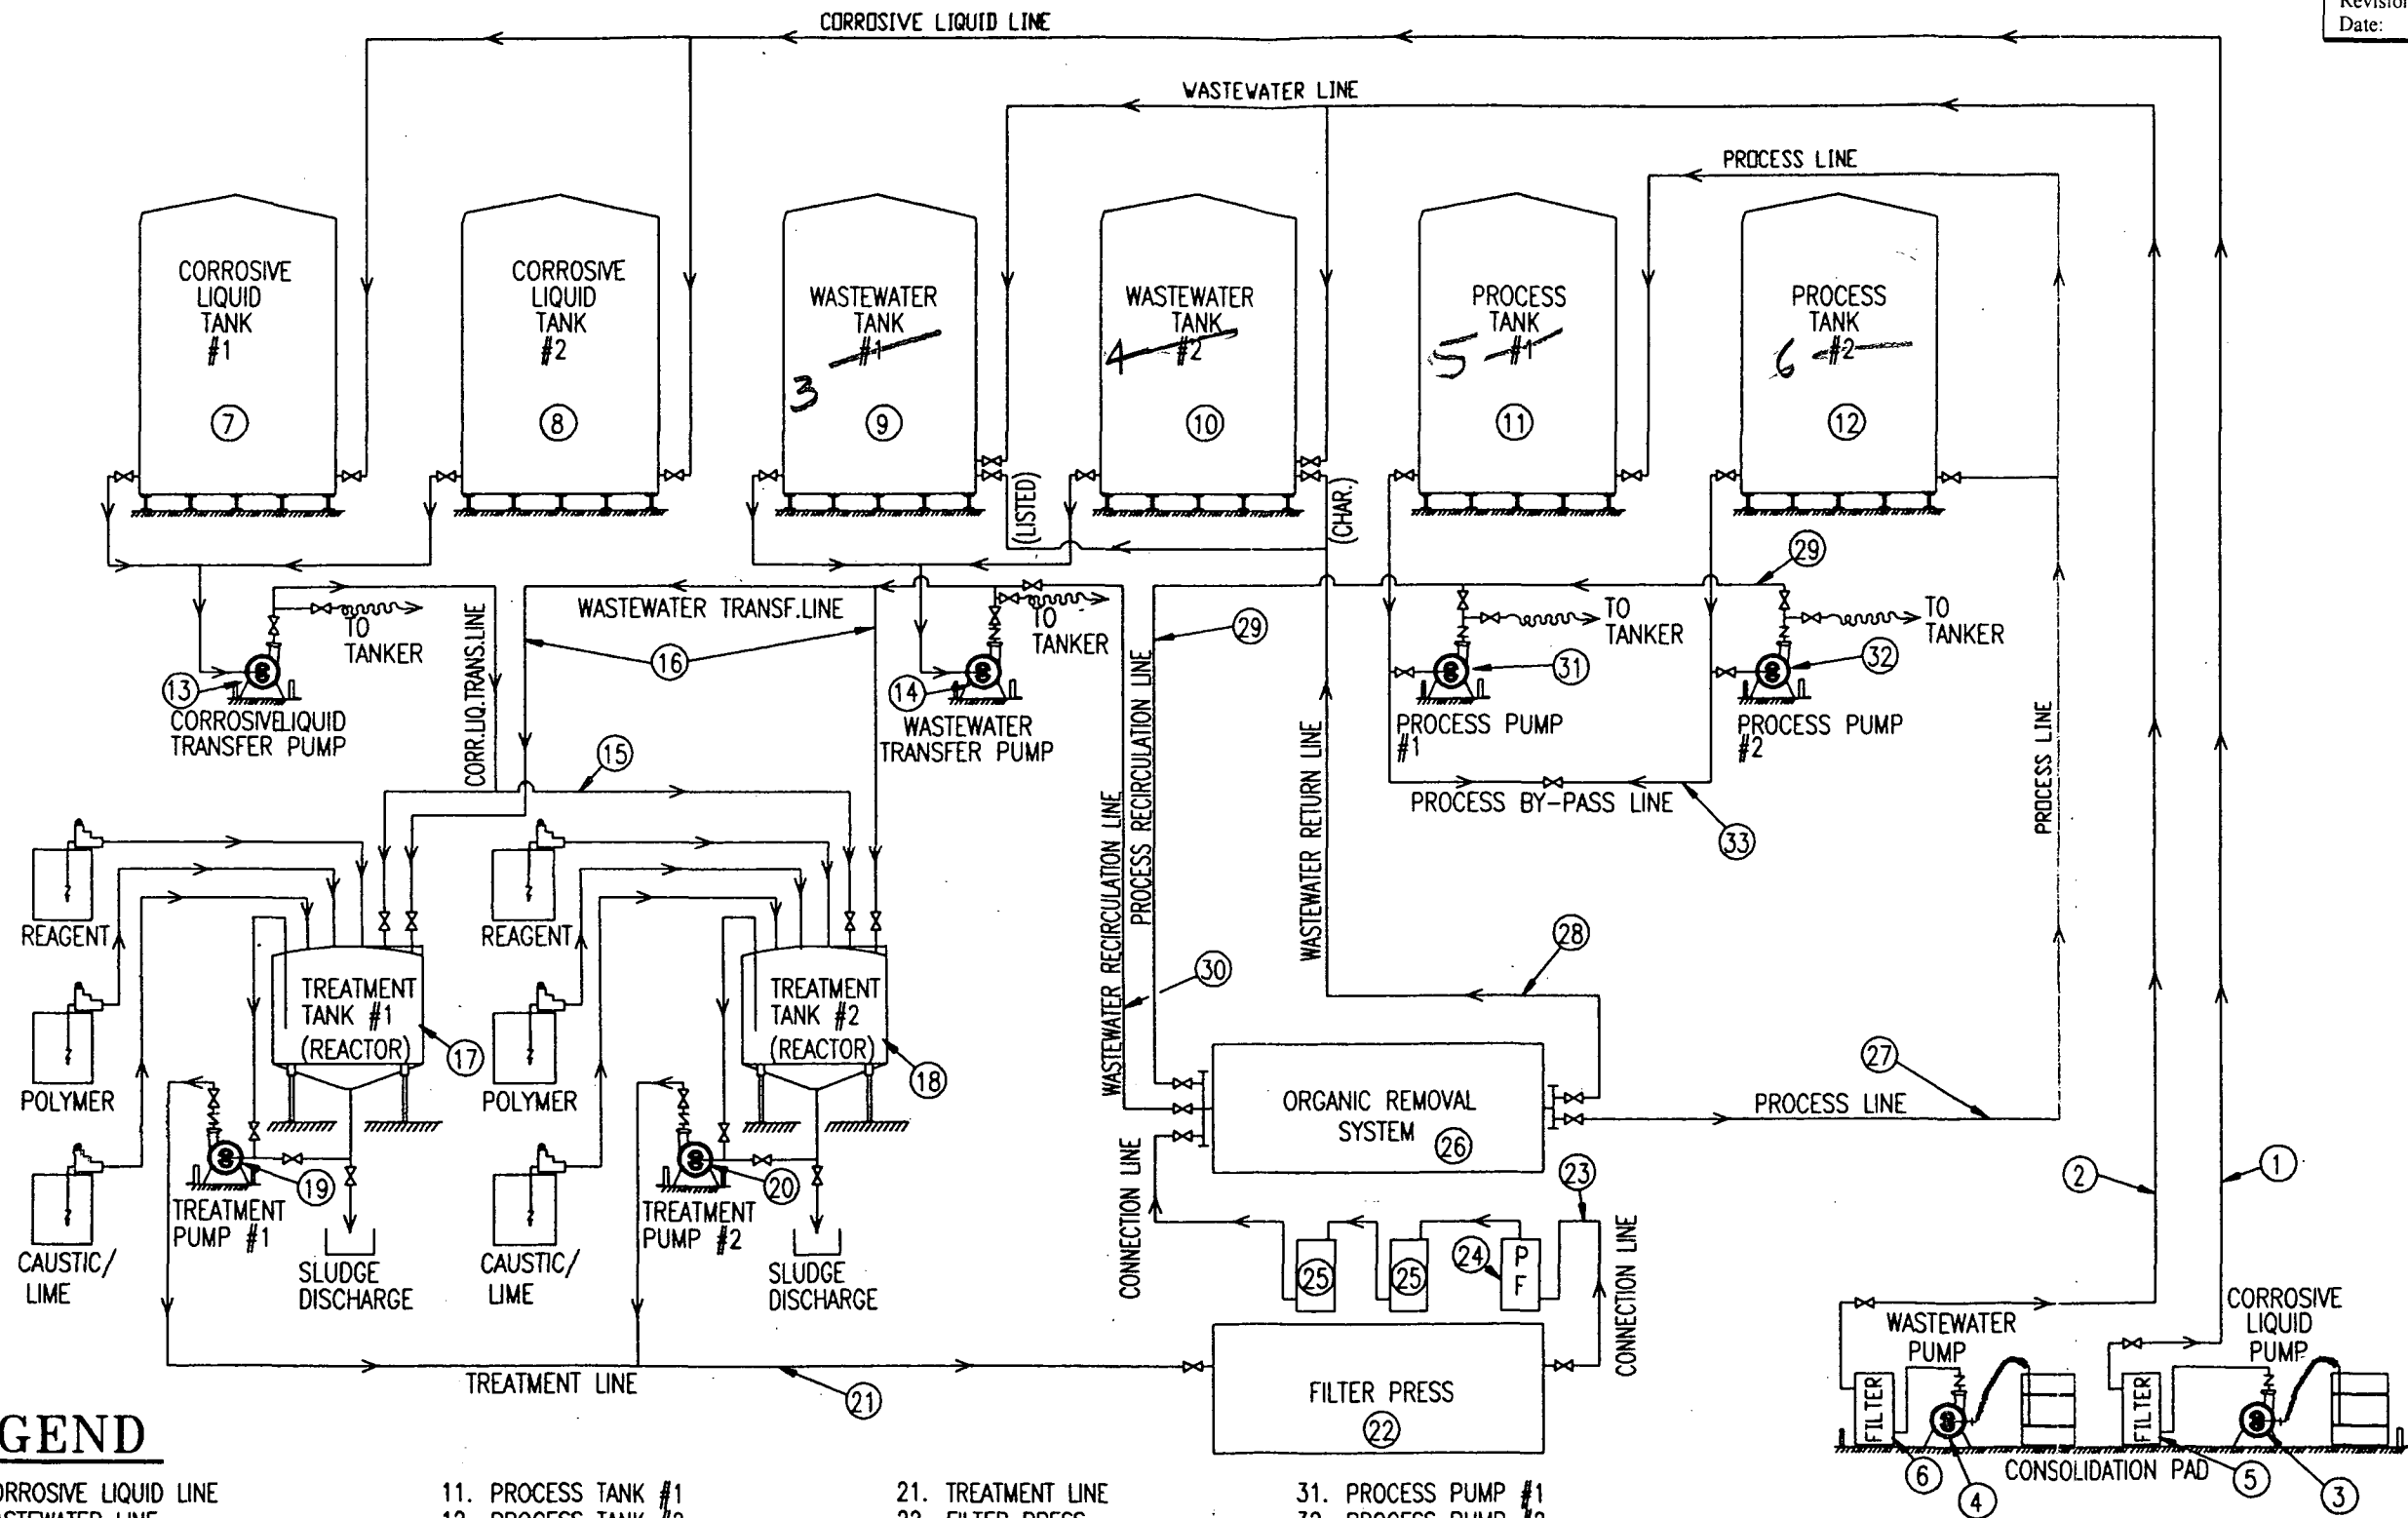


LEGEND

- | | | | |
|-----------------------------|------------------------------------|-----------------------------------|--------------------------|
| 1. CORROSIVE LIQUID LINE | 11. PROCESS TANK #1 | 21. TREATMENT LINE | 31. PROCESS PUMP #1 |
| 2. WASTEWATER LINE | 12. PROCESS TANK #2 | 22. FILTER PRESS | 32. PROCESS PUMP #2 |
| 3. CORROSIVE LIQUID PUMP | 13. CORROSIVE LIQUID TRANSFER PUMP | 23. CONNECTION LINE | 33. PROCESS BY-PASS LINE |
| 4. WASTEWATER PUMP | 14. WASTEWATER TRANSFER PUMP | 24. PARTICULATE FILTER | |
| 5. CORROSIVE LIQUID FILTER | 15. CORROSIVE LIQUID TRANSFER LINE | 25. ION EXCHANGE TOWERS | |
| 6. WASTEWATER FILTER | 16. WASTEWATER TRANSFER LINE | 26. ORGANIC REMOVAL SYSTEM | |
| 7. CORROSIVE LIQUID TANK #1 | 17. TREATMENT TANK (REACTOR) #1 | 27. PROCESS LINE | |
| 8. CORROSIVE LIQUID TANK #2 | 18. TREATMENT TANK (REACTOR) #2 | 28. WASTEWATER RETURN LINE | |
| 9. WASTEWATER TANK #1 | 19. TREATMENT PUMP #1 | 29. PROCESS RECIRCULATION LINE | |
| 10. WASTEWATER TANK #2 | 20. TREATMENT PUMP #2 | 30. WASTEWATER RECIRCULATION LINE | |

REV			
CHEMICAL CONSERVATION CORPORATION			
10100 ROCKET BOULEVARD ORLANDO, FLORIDA			
SCALE: N.T.S.	APPROVED BY	DRAWN BY	
DATE: 3/4/96		RENA DRAFTING SERVICE	
		DRAWING NUMBER	
		WTRSYSZ6 COS H4-1	

WASTEWATER TREATMENT SYSTEM PIPING DIAGRAM

Figure II.C.3/4.-5
Revision: 1
Date: 06/03/2003

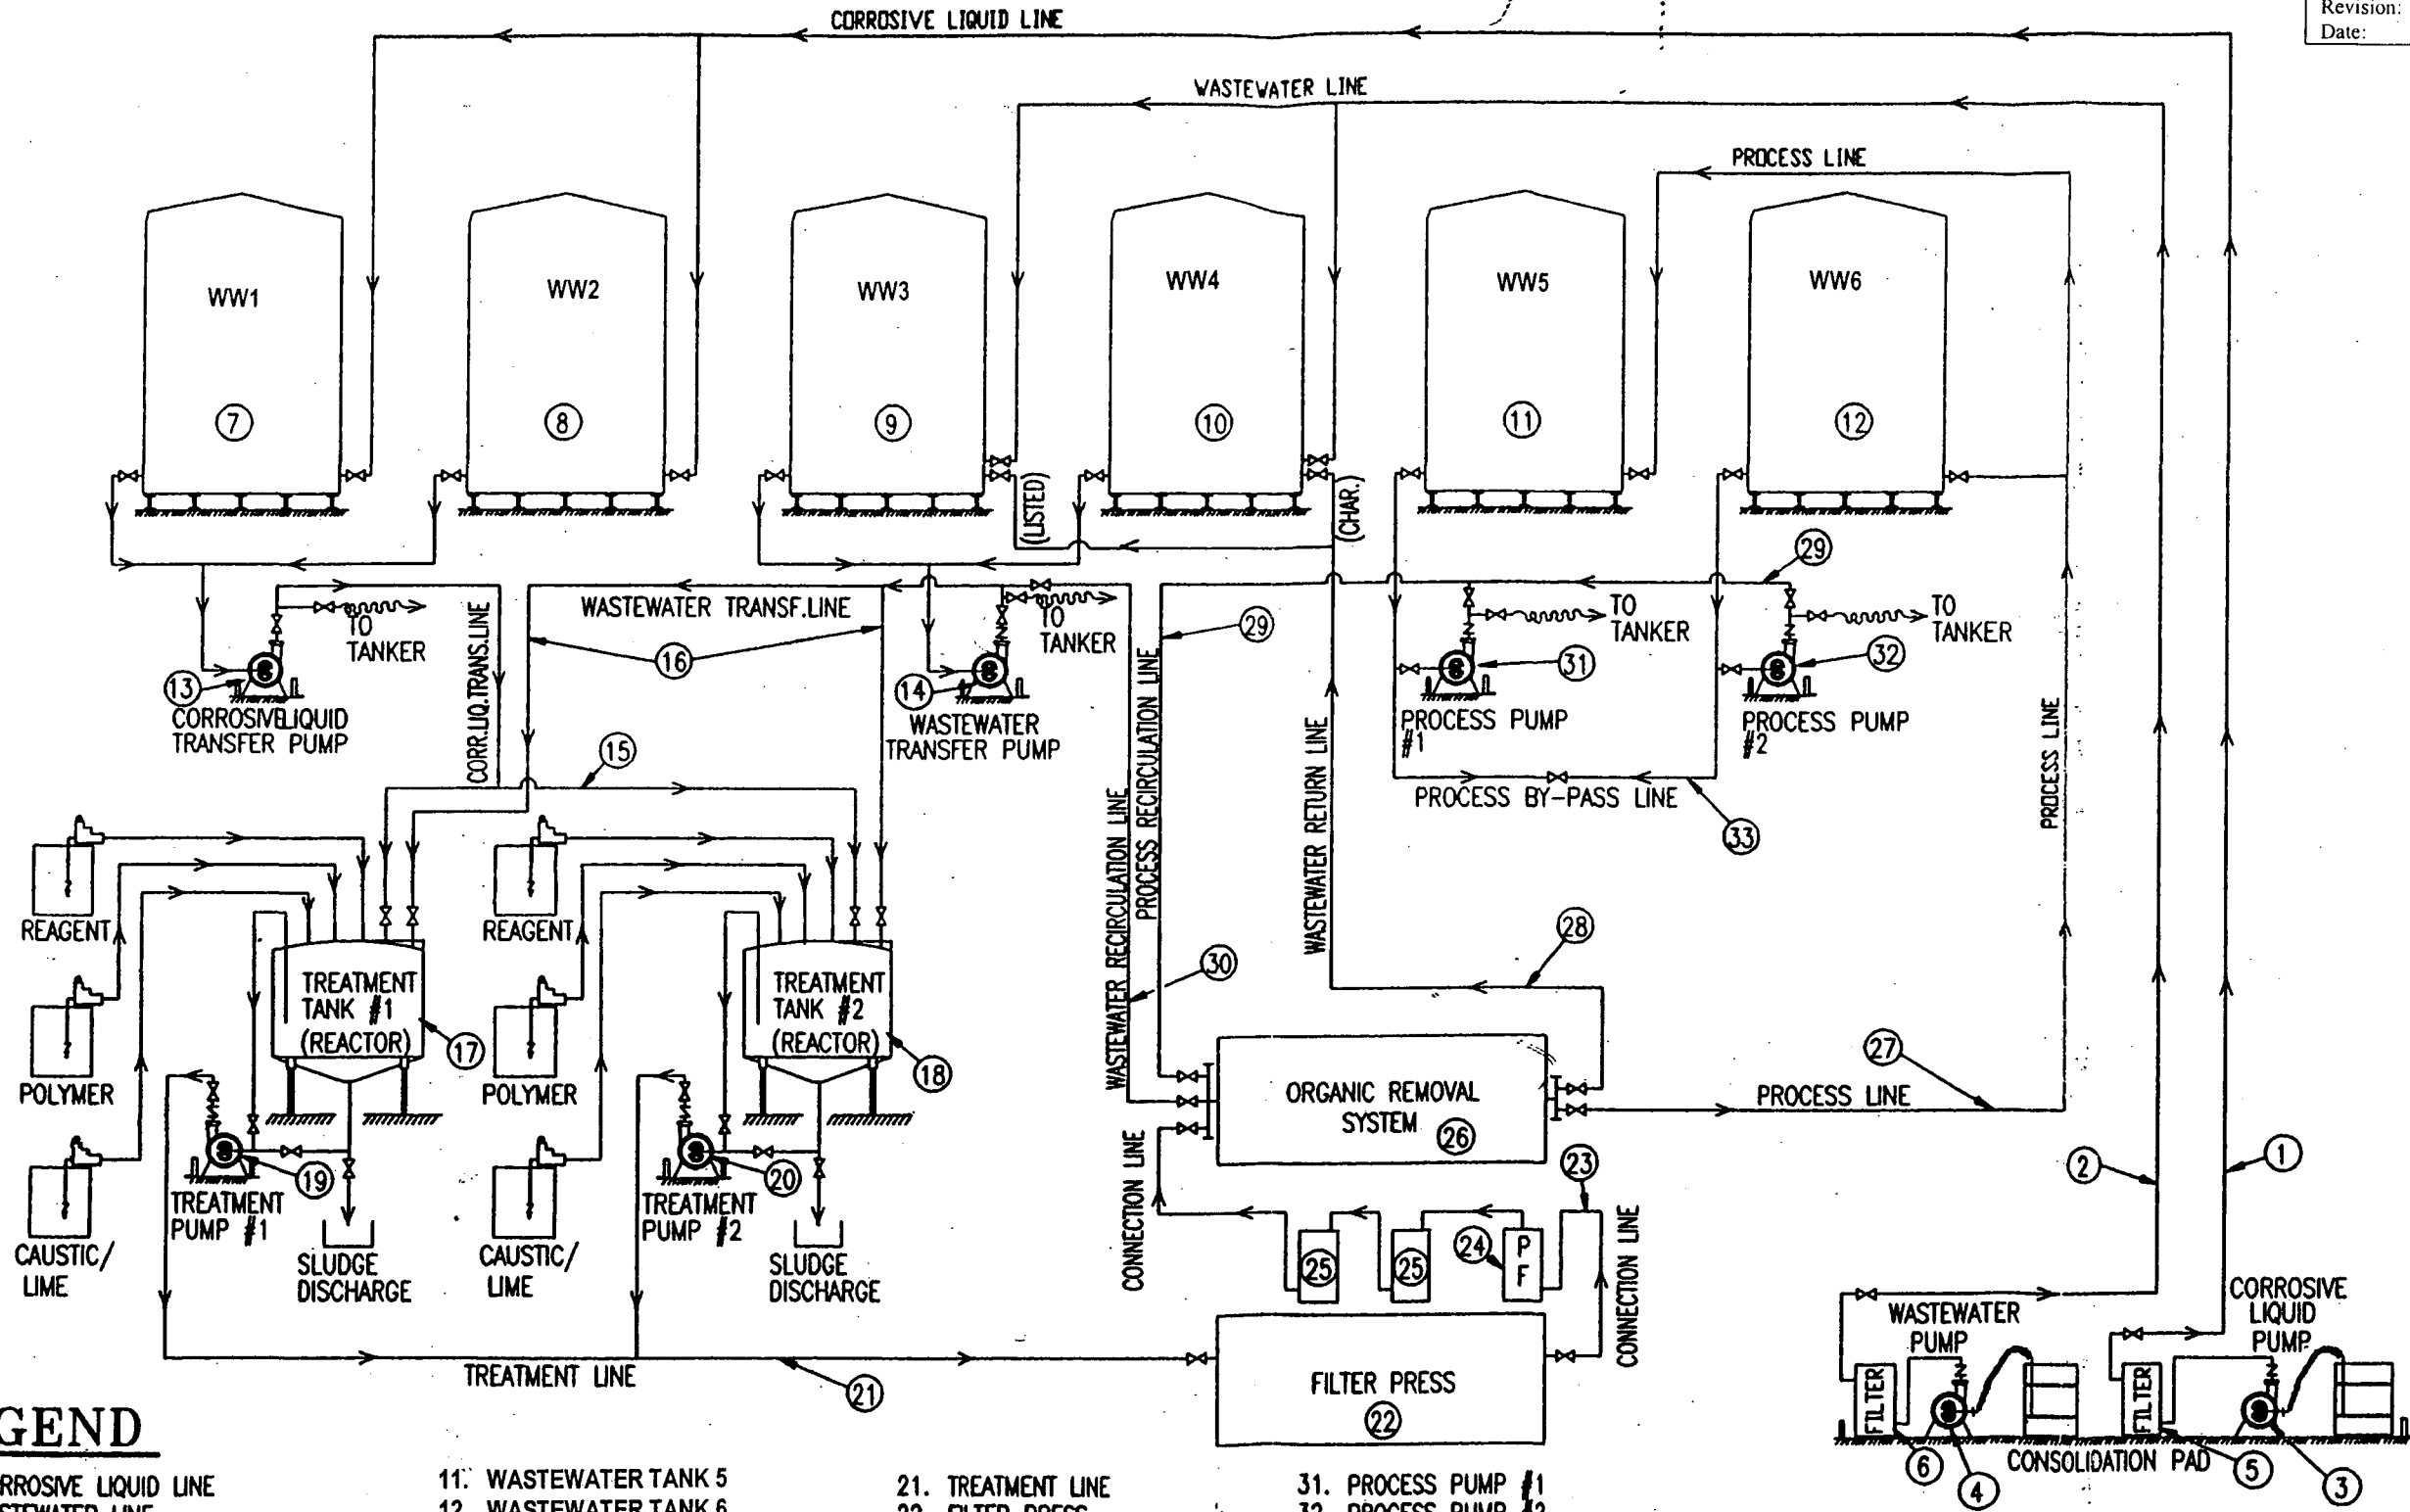

LEGEND

- | | | | |
|----------------------------|------------------------------------|-----------------------------------|--------------------------|
| 1. CORROSIVE LIQUID LINE | 11. WASTEWATER TANK 5 | 21. TREATMENT LINE | 31. PROCESS PUMP #1 |
| 2. WASTEWATER LINE | 12. WASTEWATER TANK 6 | 22. FILTER PRESS | 32. PROCESS PUMP #2 |
| 3. CORROSIVE LIQUID PUMP | 13. CORROSIVE LIQUID TRANSFER PUMP | 23. CONNECTION LINE | 33. PROCESS BY-PASS LINE |
| 4. WASTEWATER PUMP | 14. WASTEWATER TRANSFER PUMP | 24. PARTICULATE FILTER | |
| 5. CORROSIVE LIQUID FILTER | 15. CORROSIVE LIQUID TRANSFER LINE | 25. ION EXCHANGE TOWERS | |
| 6. WASTEWATER FILTER | 16. WASTEWATER TRANSFER LINE | 26. ORGANIC REMOVAL SYSTEM | |
| 7. WASTEWATER TANK 1 | 17. TREATMENT TANK (REACTOR) #1 | 27. PROCESS LINE | |
| 8. WASTEWATER TANK 2 | 18. TREATMENT TANK (REACTOR) #2 | 28. WASTEWATER RETURN LINE | |
| 9. WASTEWATER TANK 3 | 19. TREATMENT PUMP #1 | 29. PROCESS RECIRCULATION LINE | |
| 10. WASTEWATER TANK 4 | 20. TREATMENT PUMP #2 | 30. WASTEWATER RECIRCULATION LINE | |

REV			
CHEMICAL CONSERVATION CORPORATION			
10100 ROCKET BOULEVARD ORLANDO, FLORIDA			
SCALE: N.T.S.	APPROVED BY	DRAWN BY	
DATE: 3/4/96		RENA DRAFTING SERVICE	
		DRAWING NUMBER	
		VTRSYS26 DS NH	