


DESIGN: UL 142 STD. TEMP. AND PRESSURE
BUILT: APPROXIMATELY 1980 BY BUFFALO TANK CO.
INSPECTED: AUGUST 5, 1997
10'-6" DIAMETER X 23'-3" HIGH
15,000 GALLON CAPACITY
BUTT WELDED VERTICAL SEAMS
LAP WELDED HORIZONTAL SEAMS

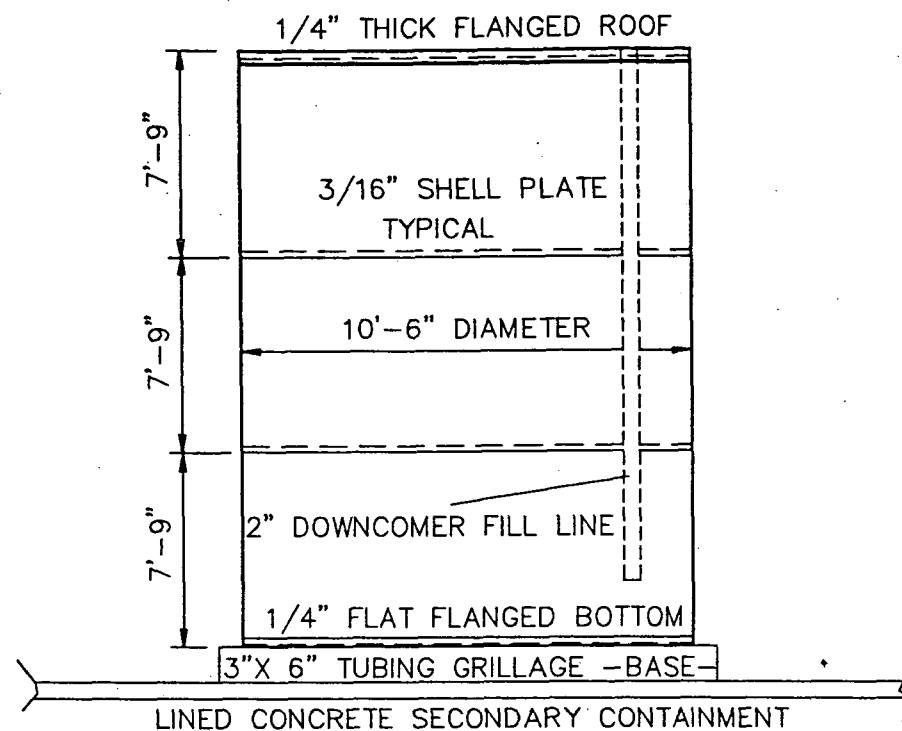



ELEVATION

NOTES:

1. SHELL RUSTING BEHIND UL 142 NAMEPLATE LOCATED ABOVE MANWAY.
2. SHELL COATING IN GOOD CONDITION - COATING BEGINNING TO FAIL ON UPPER SHELL COURSE.
3. U-T READINGS DO NOT INDICATE ANY INTERIOR CORROSION.
4. NO INTERNAL CORROSION FOUND DURING INTERIOR INSPECTION.
5. NO VISIBLE SIGNS OF TANK LEAKAGE.
6. TANK IS IN GOOD CONDITION BASED ON THIS INSPECTION

INSPECTOR: DANIEL E. COLEMAN EI - API CERTIFICATION #0867


DIRTY MINERAL SPIRITS STORAGE TANK - ORANGE PARK, FLORIDA

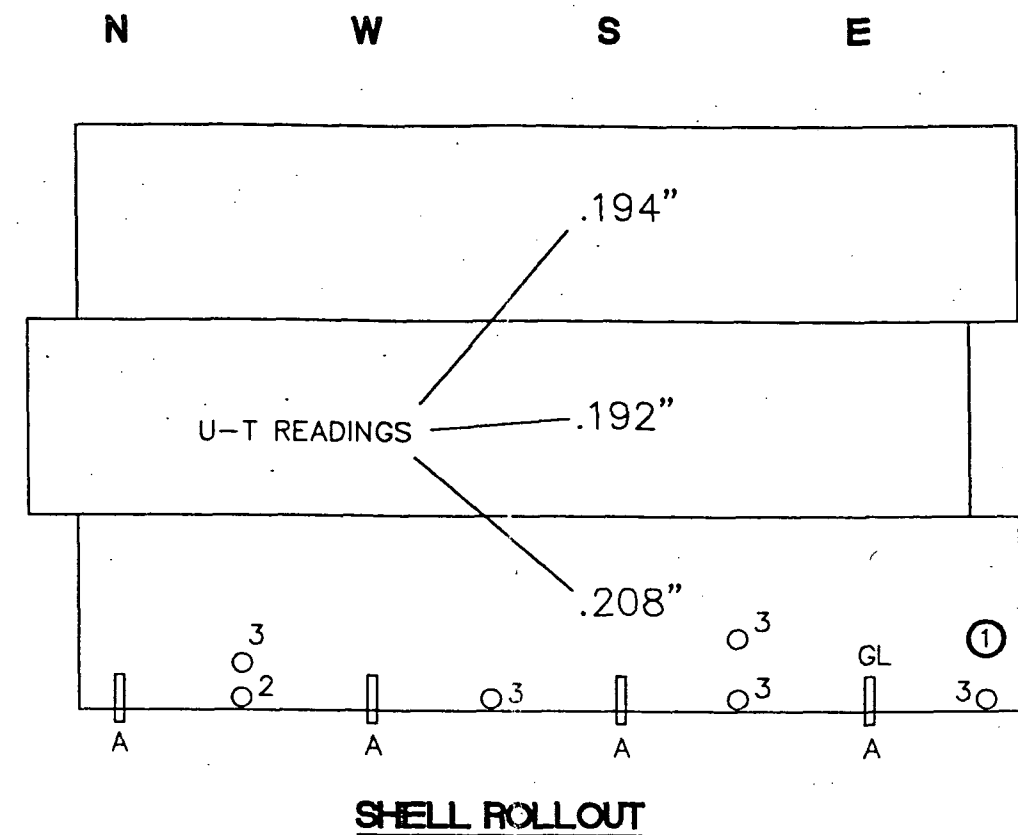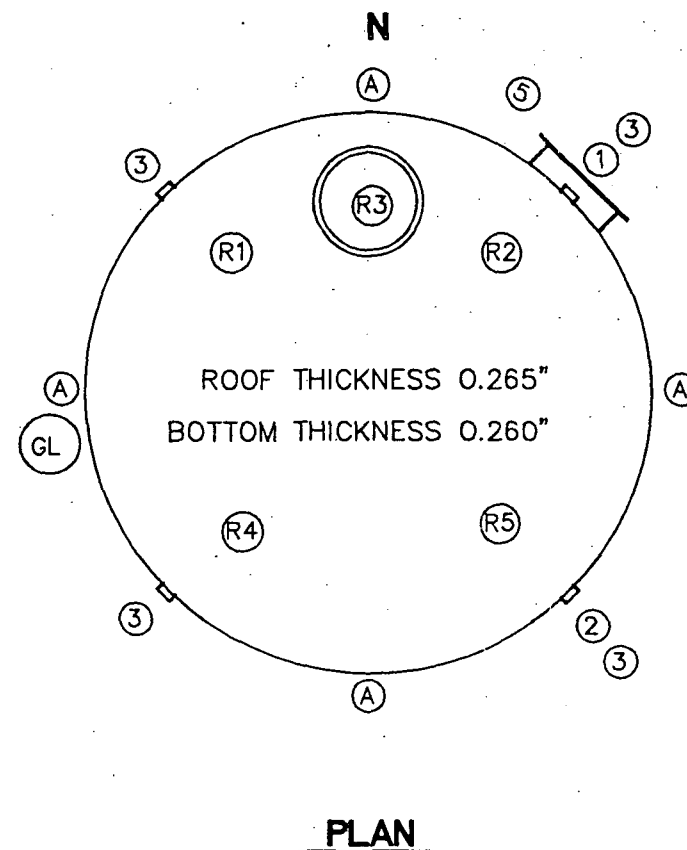

NOZZLES, FITTINGS AND ACCESSORIES

SYMBOL	DESCRIPTION	INSPECTION NOTES
1	24" SHELL MANWAY	GOOD CONDITION
2	4" COUPLING - INLET/OUTLET	GOOD CONDITION
3	4" COUPLING - SPARE NOZZLES	GOOD CONDITION
GL	GROUNDING LUG	GOOD CONDITION
A	TANK ANCHORS	HAVE COATING FAILURE AT BOLTS
R1	4" COUPLING/2" FILL PIPING - ROOF	GOOD CONDITION
R2	4" COUPLING/2" LEVEL GAUGE PIPING	GOOD CONDITION
R3	24" ROOF MANWAY	LONG BOLT CONFIGURATION - NFPA 30 - GOOD
R4	4" COUPLING W/2" P/V VENT	MORRISON FIG. 548 2oz. 20,200 CFH @ 0.5psi
R5	4" COUPLING W/2" ALARM	GOOD CONDITION

**AST INSPECTION
SERVICES, INC.**
PO BOX 902
MADISON, FLORIDA 32341
PHONE: (912) 244-9826

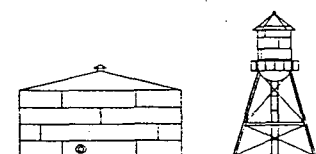

FOR:

SAFETY-KLEEN CORP.

ORANGE PARK BRANCH

ORANGE PARK, FLORIDA

PROJECT:

OUT OF SERVICE INSPECTION
DIRTY MINERAL SPIRITS
STORAGE TANK

DRAWN BY:	D.W.W.
CHECKED BY:	D.E.C.
UNIT NUMBER:	