1	3070	ALUM.	2		EXT GLASS
2	3068	WOOD	1		SOLID CORE
3	3068	WOOD	3	3	HOLLOW CORE
4	6068	WOOD	BIFOLD		HOLLOW CORE
5	6070	H.M.	–		H.M. FRAME 3/4 HR F.R.
6	3070	H.M.	1	2	H.M. FRAME
7	80100	STEEL	2		CH ROLLUP NON-RATED TYPE, SHEET TO PVC WITH CONTACTS & INSTALL
8	120140	"	1		"

A	3040	FIXED	7	FREEWAY VANE

NOTE: TRIM TO BE WHITE PINE OR PREFINISHED WOOD MOULD
·WOOD DOORS TO BE MASONITE LEGACY, PREFINISHED OR EQUAL

FOR ESTIMATES ON

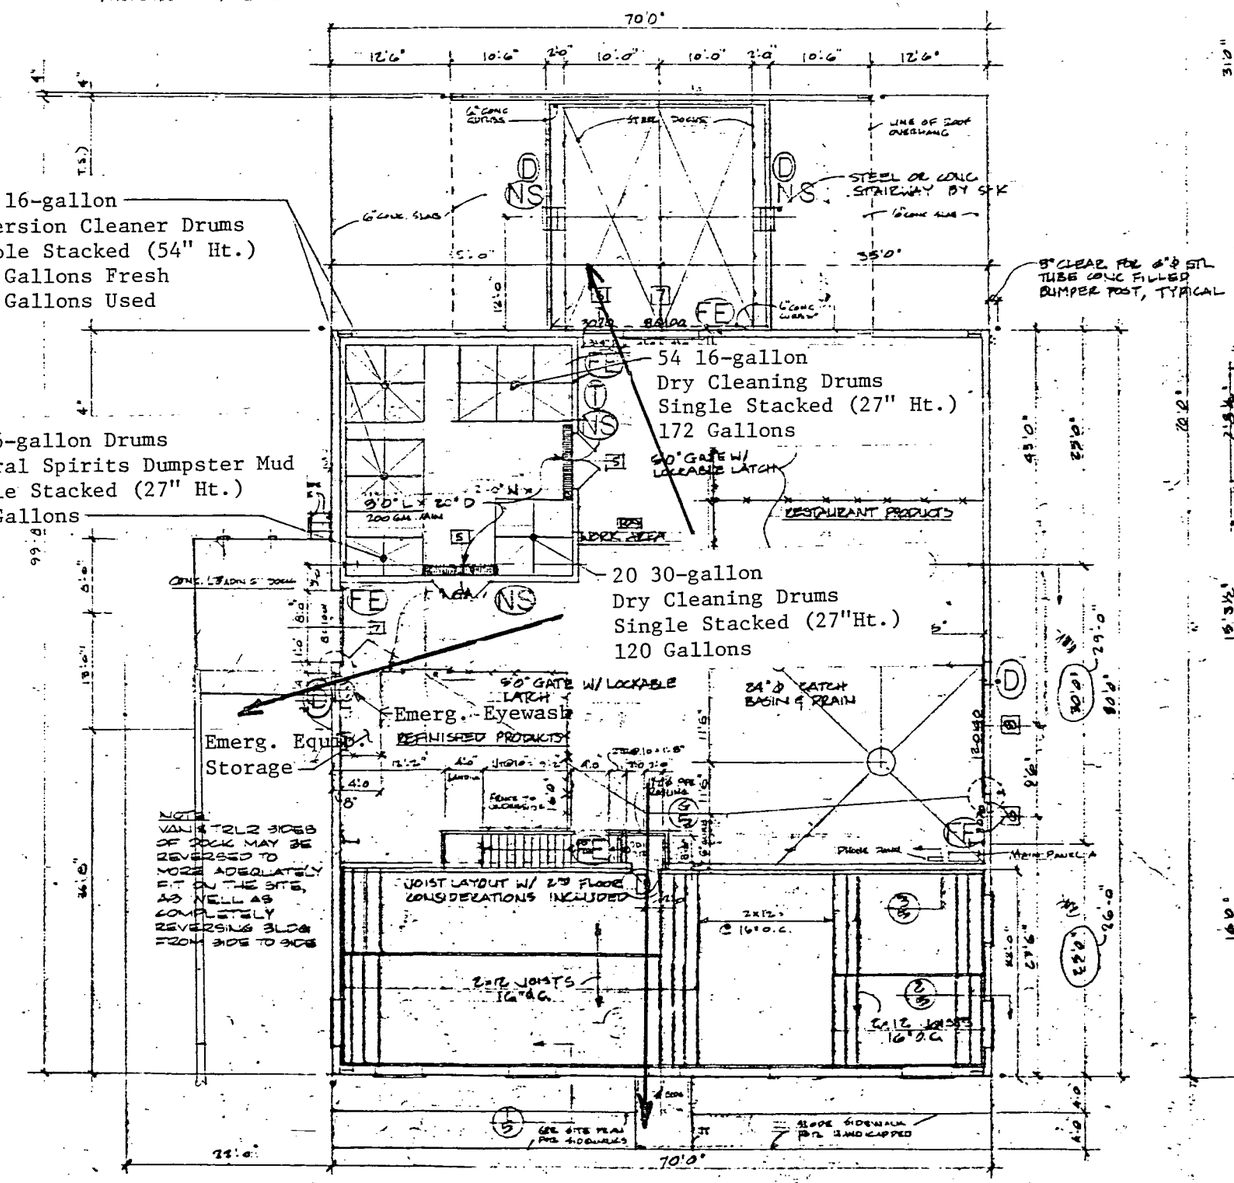

BUILDING PLAN
SCALE: 1/8"=2'0"

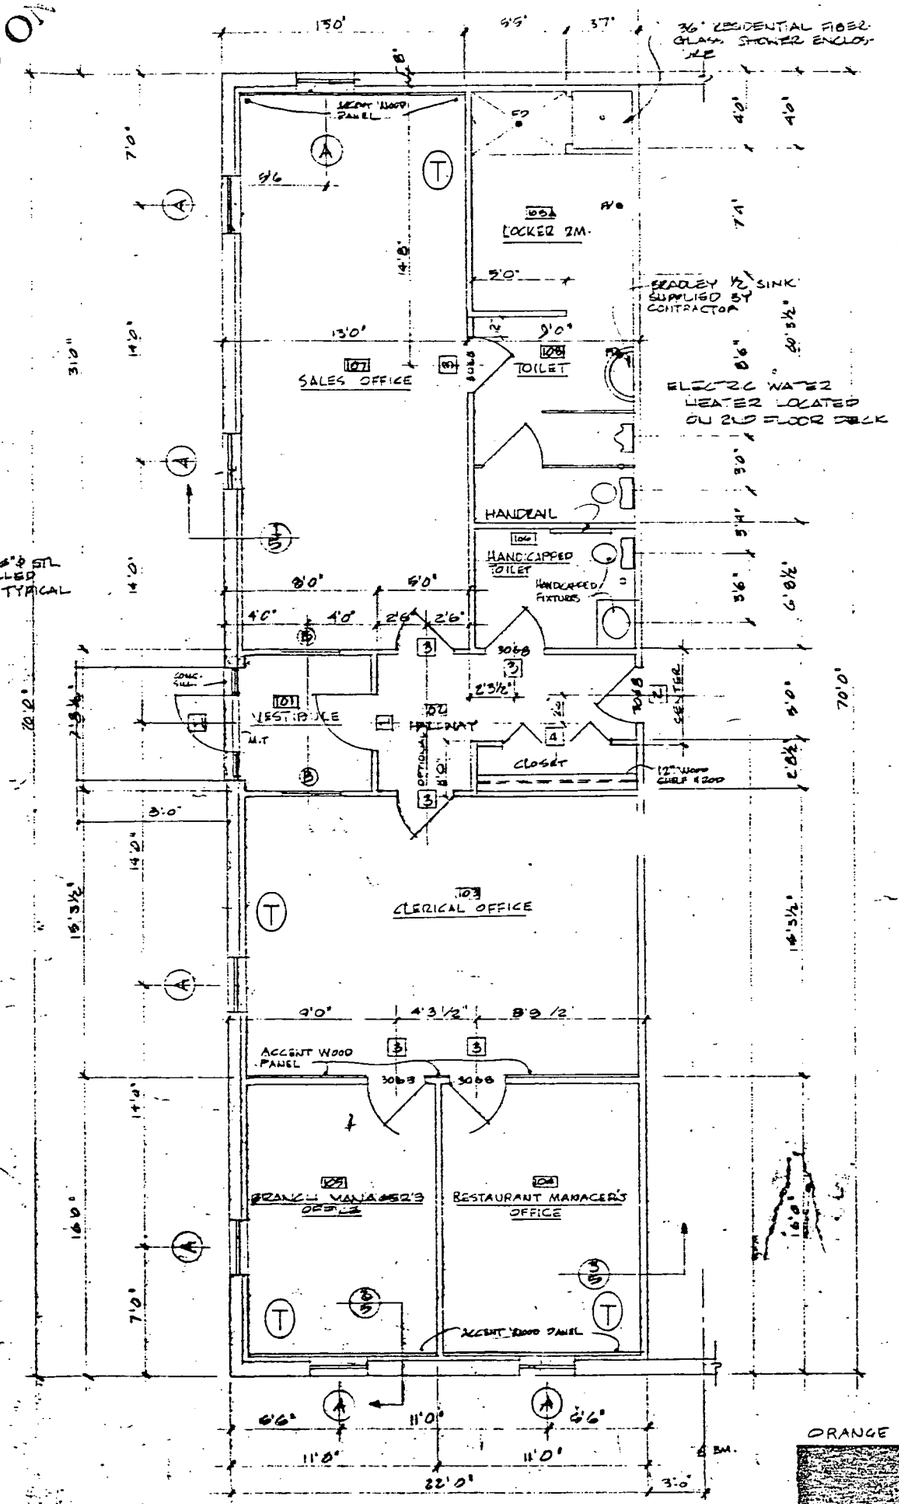

OFFICE PLAN
SCALE: 1/4"=2'0"

LEGEND:

D-Danger Sign
NS-No Smoking Sign
FE-Fire Extinguisher
FA-First Aid
T-Telephone
Evacuation Route

Exhibit I.D.5-2

ORANGE PARK, FL. (3-079-01) D11860 - FLOOR PL

SAFETY KLEEN, C