


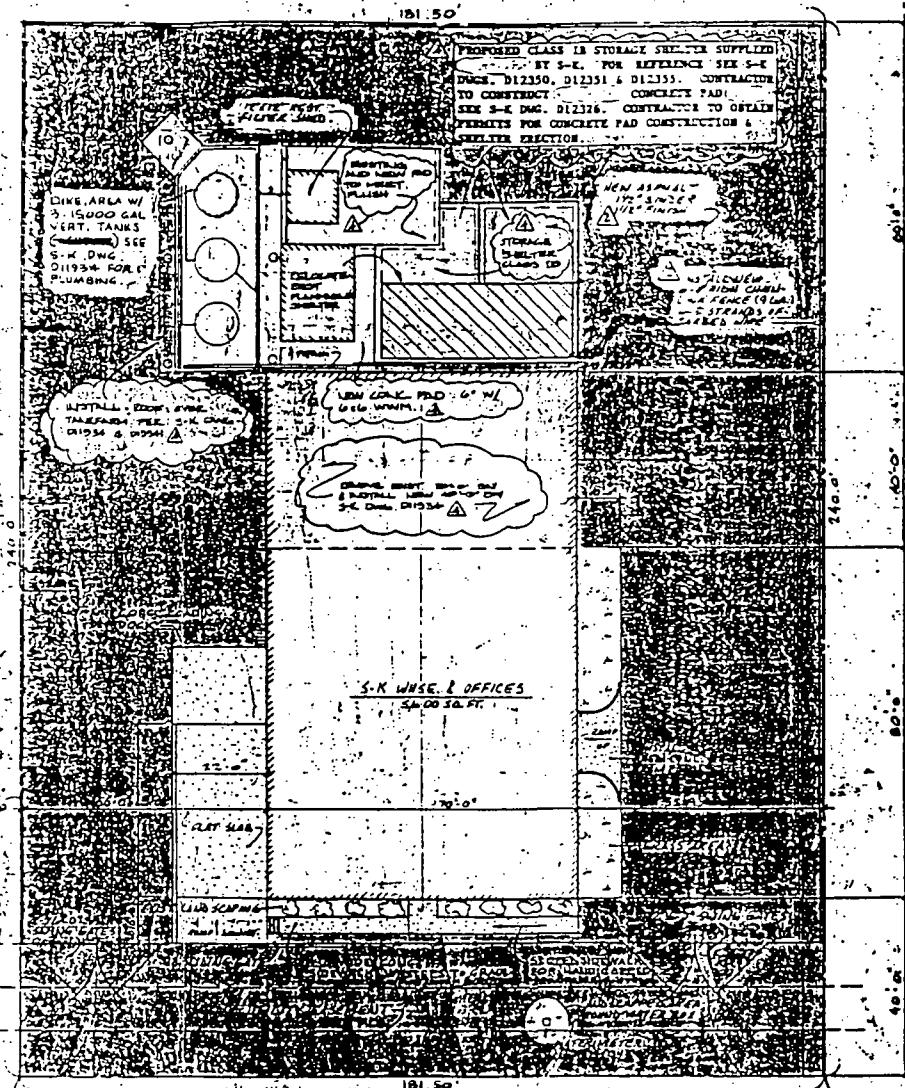

SITE PLAN SCALE: 1" = 20'-0"

GENERAL NOTES

1. SEWER, ELECTRIC, & WATER ENTRANCES TO BE APPLIED & PRACTICALLY LOCATED PER LOCAL SITE.
2. ALL STORM WATER TO BE HANDLED BY USE OF SMOLES & GRADUATED GRADES TO DIRECT WATER AWAY FROM IMPROVEMENTS SO AS NOT TO DISTURB THE NATURAL FLOW OF WATER.
3. LOADING PUMP PITS (IF USED) TO BE EQUIPPED WITH CATCH BASIN DRAINS AND/OR SUMP PUMPS.
4. WAREHOUSE & OFFICE MAY BE SINGLE OR DUAL LEVEL PER LOCAL SITE CONDITIONS.
5. DRIVE SURFACE TO BE UNDED ONLY TO SUFFICIENT DEPTH & DENSITY TO HANDLE HEAVY TRUCK TRAFFIC AS DETERMINED BY LOCAL SOIL CONDITIONS.

PLATE 2

APPROVED FOR CONSTRUCTION BY: [Signature] DATE: 10-11-87

SITE PLAN	
FOR SERVICE CENTER BRANCH ORANGE PARK, FL. (9-079-01)	