



GENERAL NOTES


1. POWER REQUIREMENT 13 TO 28 VDC
2. OUTPUT 1 - 10 m (ALARM STATE)
13 - 25 m (NORMAL STATE)
3. OPERATING TEMP. -40°F TO +140°F
4. SHIELD-TO-GROUND LOADING:
25 ohm KIL. RESISTANCE
5. AFT EFFECT: LESS THAN 2 m SHIFT
IN OPERATING POINT FOR UNIT IN
EXPLOSION-PROOF HOUSING FROM 5 m
FIELD 17, 150, OR 450 m, AT A
DISTANCE OF 5 FT. FROM EXPOSED
CABLE OR SIGNAL WIRE.
6. FAIL-SAFE: SWITCHABLE OR EITHER
LOW-LEVEL FAIL-SAFE (LLFS) OR
HIGH-LEVEL FAIL-SAFE (HLS).
7. HOUSING: NEMA 12-WATERPROOF
EXPLOSION PROOF FOR CLASS I GROUPS
A, B, C, D, AND CLASS II GROUPS E, F, G
DIV. 1 OR 2.
8. SEE INDIVIDUAL SERVICE CENTER SITE PLANS
FOR RELATIVE LOCATIONS OF THESE DETAILS.
9. CONTRACTOR TO SUPPLY & INSTALL CONDUIT
SUPPORTS & BRACKETS AS REQUIRED.
10. THIS DRAWING CONTAINS INFORMATION
PROPRIETARY TO SAFETY-KLEEN CORP. ANY
REPRODUCTION, DISCLOSURE OR USE OF THIS
DRAWING IS EXPRESSLY PROHIBITED BY
SAFETY-KLEEN
11. ALL ITEMS SHOWN WITH A SAFETY-KLEEN PART
NUMBER WILL BE SUPPLIED BY SAFETY-KLEEN
CORP. (E.G. SK-1111)
12. IF INDIVIDUAL SERVICE CENTER CONDITIONS
ARE NOT COVERED BY DETAILS SHOWN HERE,
PLEASE CONTACT TECHNICAL SERVICES AT THE
CORPORATE OFFICE FOR ASSISTANCE.
13. CALCULATIONS FOR LENGTH OF PROBE INSIDE
OF TANK ARE SET TO ACTIVATE THE ALARM
AT THE 95% VOLUME LEVEL.
14. ALL CALIBRATION OF UNIT SHALL BE DONE
IN ACCORDANCE WITH DREXELBROOKS
RECOMMENDATIONS. CALIBRATION SHALL
BE DONE AFTER ALL COMPONENTS OF
SYSTEM ARE IN PLACE.
15. ALL TANKS SHALL BE GROUNDED PRIOR
TO INSTALLATION OF ALARM SYSTEM.

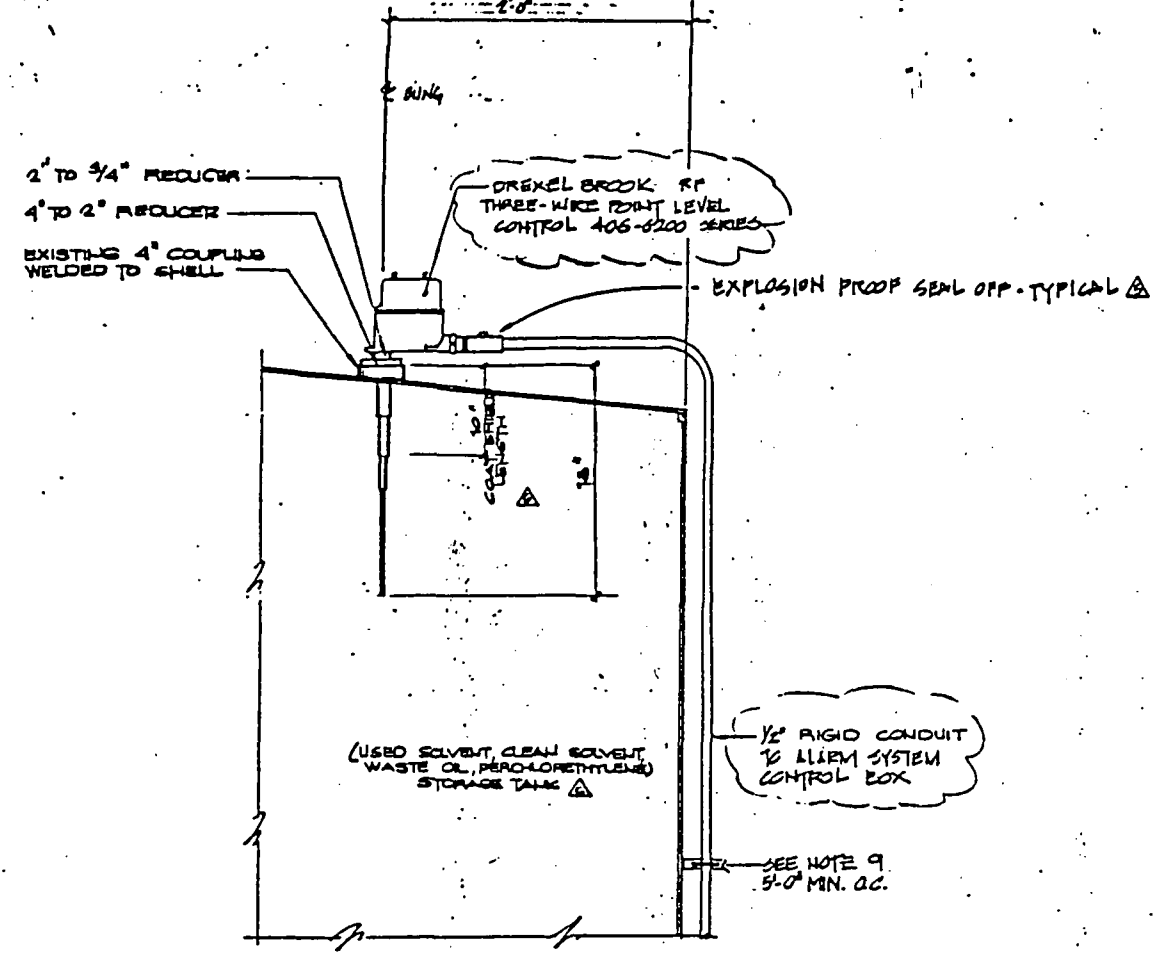



ABOVEGROUND VERTICAL TANK INSTALLATION

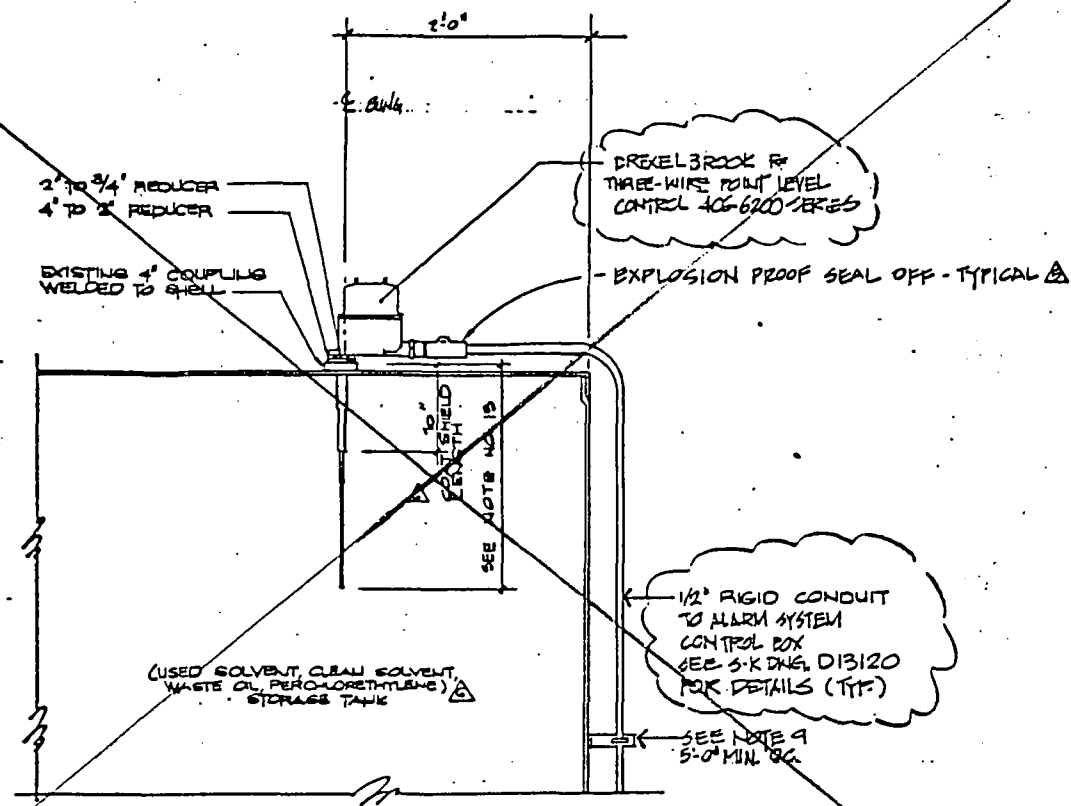

ABOVEGROUND HORIZONTAL TANK INSTALLATION

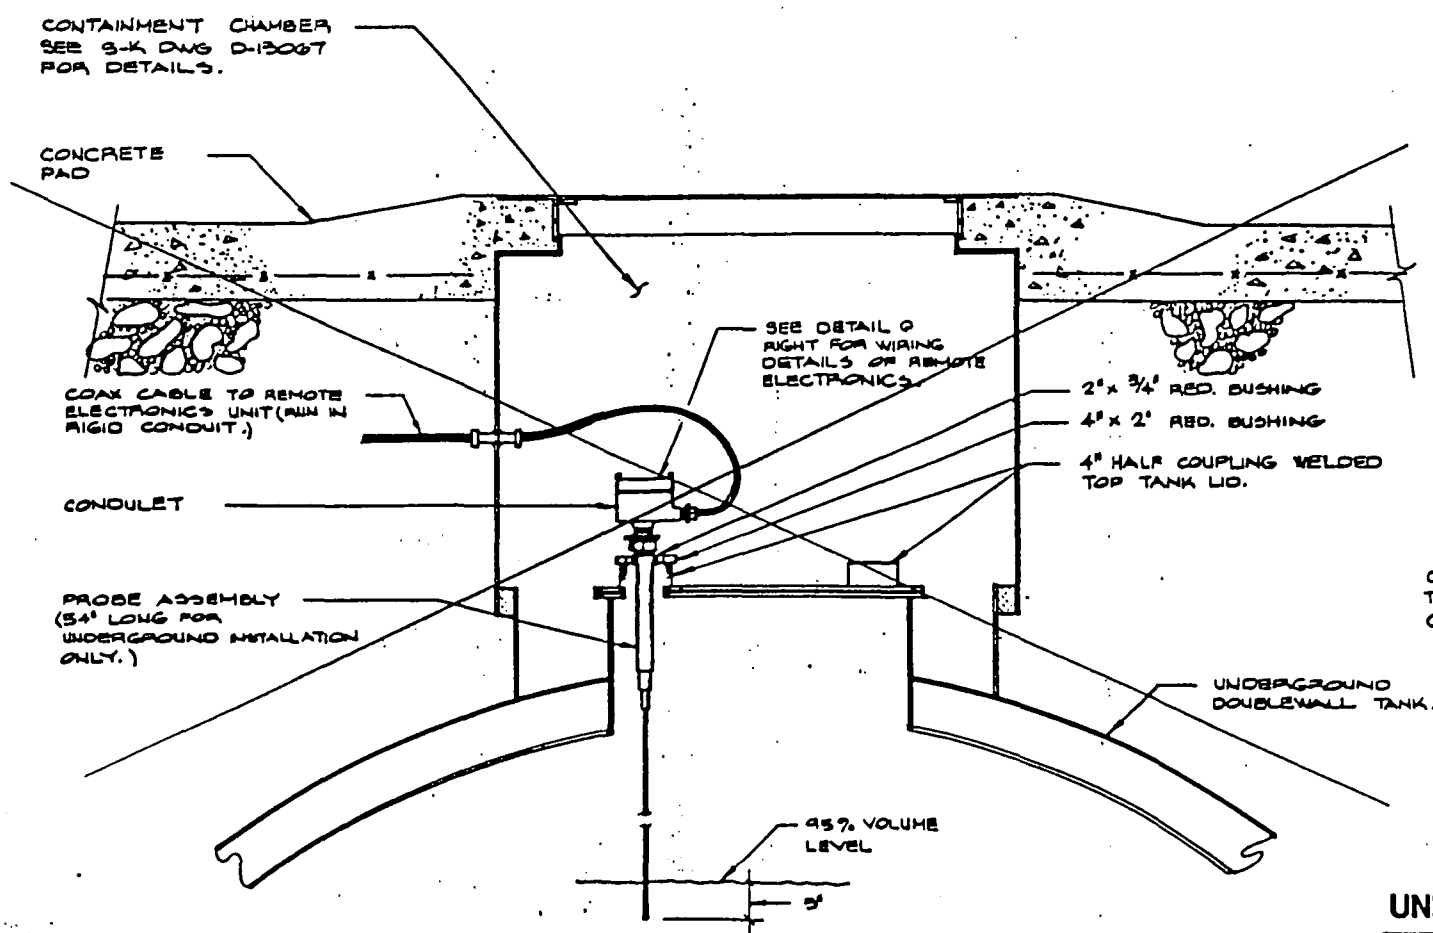

UNDERGROUND TANK INSTALLATION

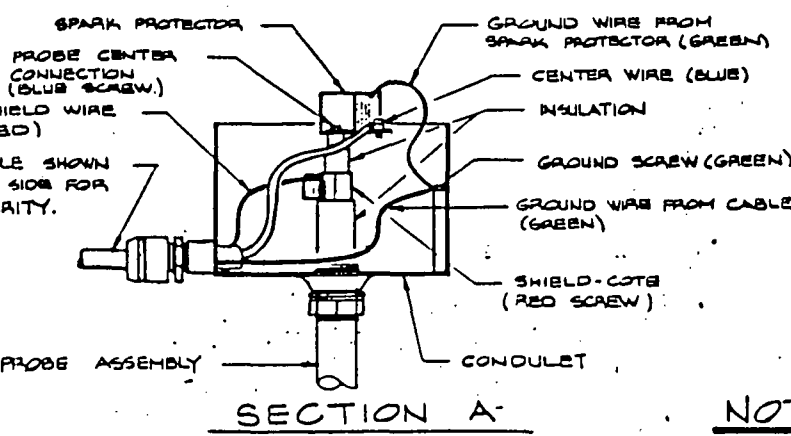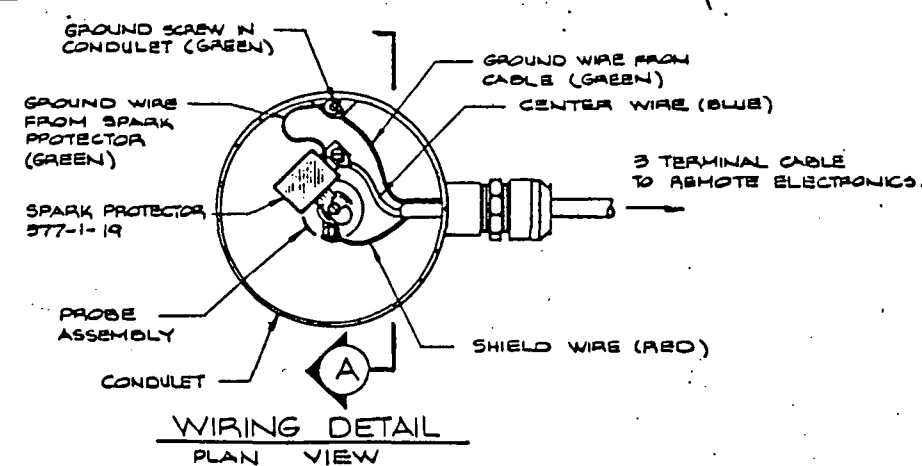

NOTE:

WORK THIS DWG. WITH SK DWGS
D-13429 AND D-14218

ADD REMOTE AND REMOTE THE DWG.	MA	7-25
ADD EXPLOSION PROOF SEAL OFF NOTE	FLB	11-13
ADD PROBE DEPTH, NOTE 13	FLB	11-13

Safety-Kleen Corp. 777 ONE THUNDER ROAD • ELGIN, ILLINOIS 60120 PHONE 312-847-6000			
HIGH LEVEL ALARM SYSTEM TRANSMITTER TO TANK INSTALLATION DETAILS			
DATE	BY	CHKD	APP'D
6-22-88	ADDON	CHART	1/14
RD	ADDON	15" x 16" x 18"	RD
FOR: SERVICE CENTER BRANCH			D1310