



RECEIVED

AUG 8 1988

HAZARDOUS WASTE
PERMITTING

July 25, 1988

Mr. James Scarbrough
U.S. EPA Region IV
Waste Management Division
345 Courtland St.
Atlanta, GA 30365

Re: S-K Corp. 3-163-01
FLD980847271 Tampa
Permit Addendum

Dear Mr. Scarbrough:

This letter is in response to the Agency's request for information dated June 7, 1988, pursuant to the requirements of 40 CFR 270.14. We appreciate the additional time granted for this response. Please note that the request referenced the incorrect I.D. no. FLD 049557408. Ms. Kim Gates of your staff confirmed that the correct I.D. number is FLD 980847271. This permit addendum is being submitted with 3 copies⁵ as requested.

Your letter listed two Solid Waste Management Units (SWMU); a septic tank, and stormwater run-off pond. In addition, the facility has two drum storage areas and one aboveground tank for storage of hazardous waste solvents. The location and description of the latter three SWMU's is identified in Parts I.E.3, II, and III of the Part B permit application. Part I.D.2 addresses the specifications of the wastes handled by those units. The stormwater pond and septic tank are described in the next paragraph. All SWMU's have been in operation from June, 1985 to the present.

The septic system consists of a 1,000 gallon tank northwest of the facility's tank farm with a septic field extending 350 feet southward. The stormwater run-off pond is approximately 30 feet wide and 175 feet long. Both SWMU's are shown on the enclosed site survey.

Releases

There have been no releases of hazardous wastes or hazardous constituents from the septic tank or rainwater run-off pond. (The septic system receives only sanitary wastes). The following hazardous substance releases have occurred:

December 2, 1987 - 10 gallons of petroleum naphtha was released when a drum was overfilled on the loading dock (between drum storage areas). The material was contained completely on pavement and cleaned up with absorbents and oil dry.

- April 13, 1987 - A drum was punctured by a handtruck, thereby releasing 1.5 gallons of Trichloroethane in the drum storage area. The material was contained completely on concrete and cleaned up with absorbents.
- June 13, 1986 - The storage tank manway gasket developed a leak which released 50 gallons of petroleum naphtha. The material was contained completely in the concrete containment structure, and pumped into a tanker truck. Spill residues were cleaned up.

This letter shall become an appendix to the Part B permit application for the facility. The certification statement is enclosed. Please contact me if additional information is needed.

Sincerely,



Paul Pederson

Enclosure

cc: Armando Gonzalez, FDER Tampa (w/encl)
Ellen Jurczak (w/encl)
Frank Taylor, 3-163-01 (w/encl)
Fred Stockbarger

PP/jo


CERTIFICATION STATEMENT

Tampa, Florida Service Center


FLD 930847271

Safety-Kleen 3004 Response to EPA dated July 25, 1988

The undersigned, being a vice president of Safety-Kleen Corp., the permit applicant, certifies under penalty of law that this document and all attachments were prepared under my direction or supervision in accordance with a system designed to assure that qualified personnel properly gather and evaluate the information submitted. Based on my inquiry of the person or persons who manage the system, or those persons directly responsible for gathering the information, the information submitted is, to the best of my knowledge and belief, true, accurate, and complete. I am aware that there are significant penalties for submitting false information, including the possibility of fine and imprisonment for knowing violations.

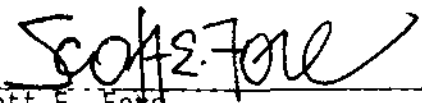


Scott E. Fore
Vice President
Environment, Health and Safety

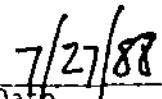

Date

88-204

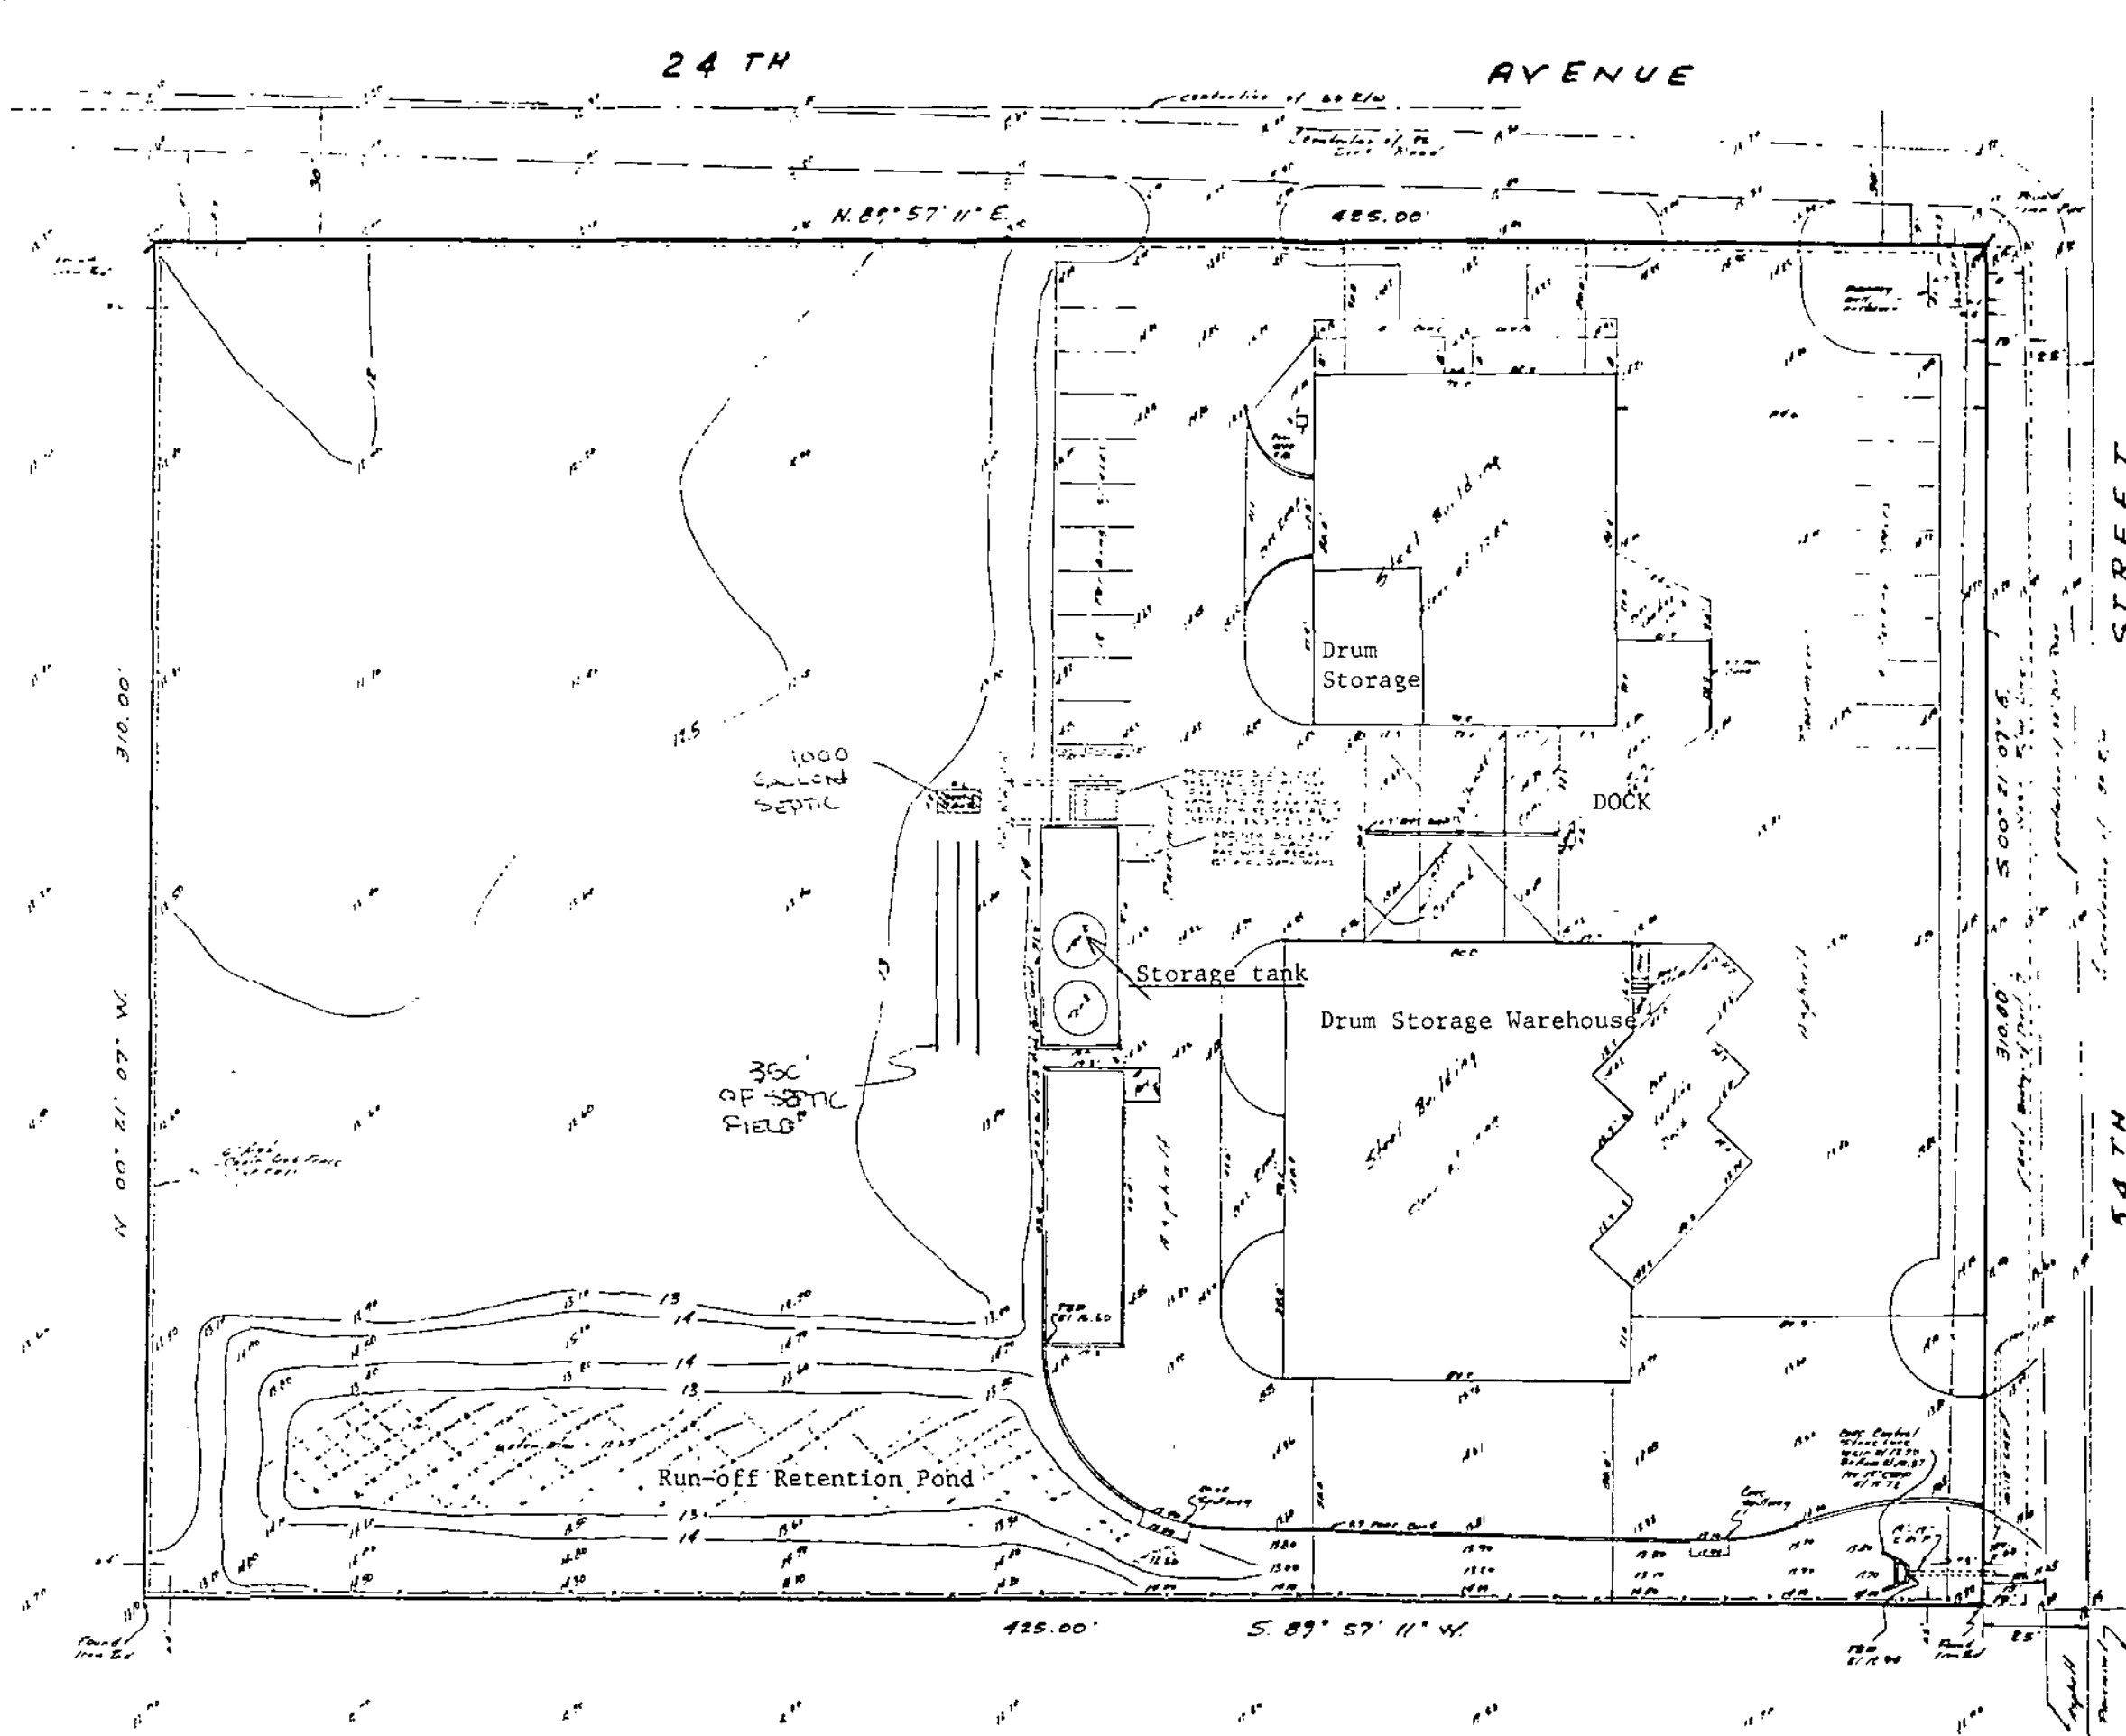

Notes: This Parcel as described is in zone "B" as defined by the National Flood Insurance Program. (Community Panel No. 120112 0167 C) Bearings as indicated refer to an assumed meridian.

Survey of: The West 425.00 feet of the East 425.00 feet of the North 310.00 feet of TRACT 9, in the Southwest 1/4 of Section 27, Township 29 South, Range 19 East, SOUTH TAMPA SUBDIVISION, according to map or plat thereof as recorded in Plat Book 6, Page 3 of the Public Records of Hillsborough County, Florida.

This certifies that we have made a survey of the above described property and that the survey and this plat conforms to the minimum technical standards set forth by the Florida Board of Land Surveyors, pursuant to Section 472.027, Florida Statutes. August 28, 1987

JOHN KELLER & ASSOCIATES, INC.



For: Safety Klean
JK Job No. R873581

SITE PLAN	
