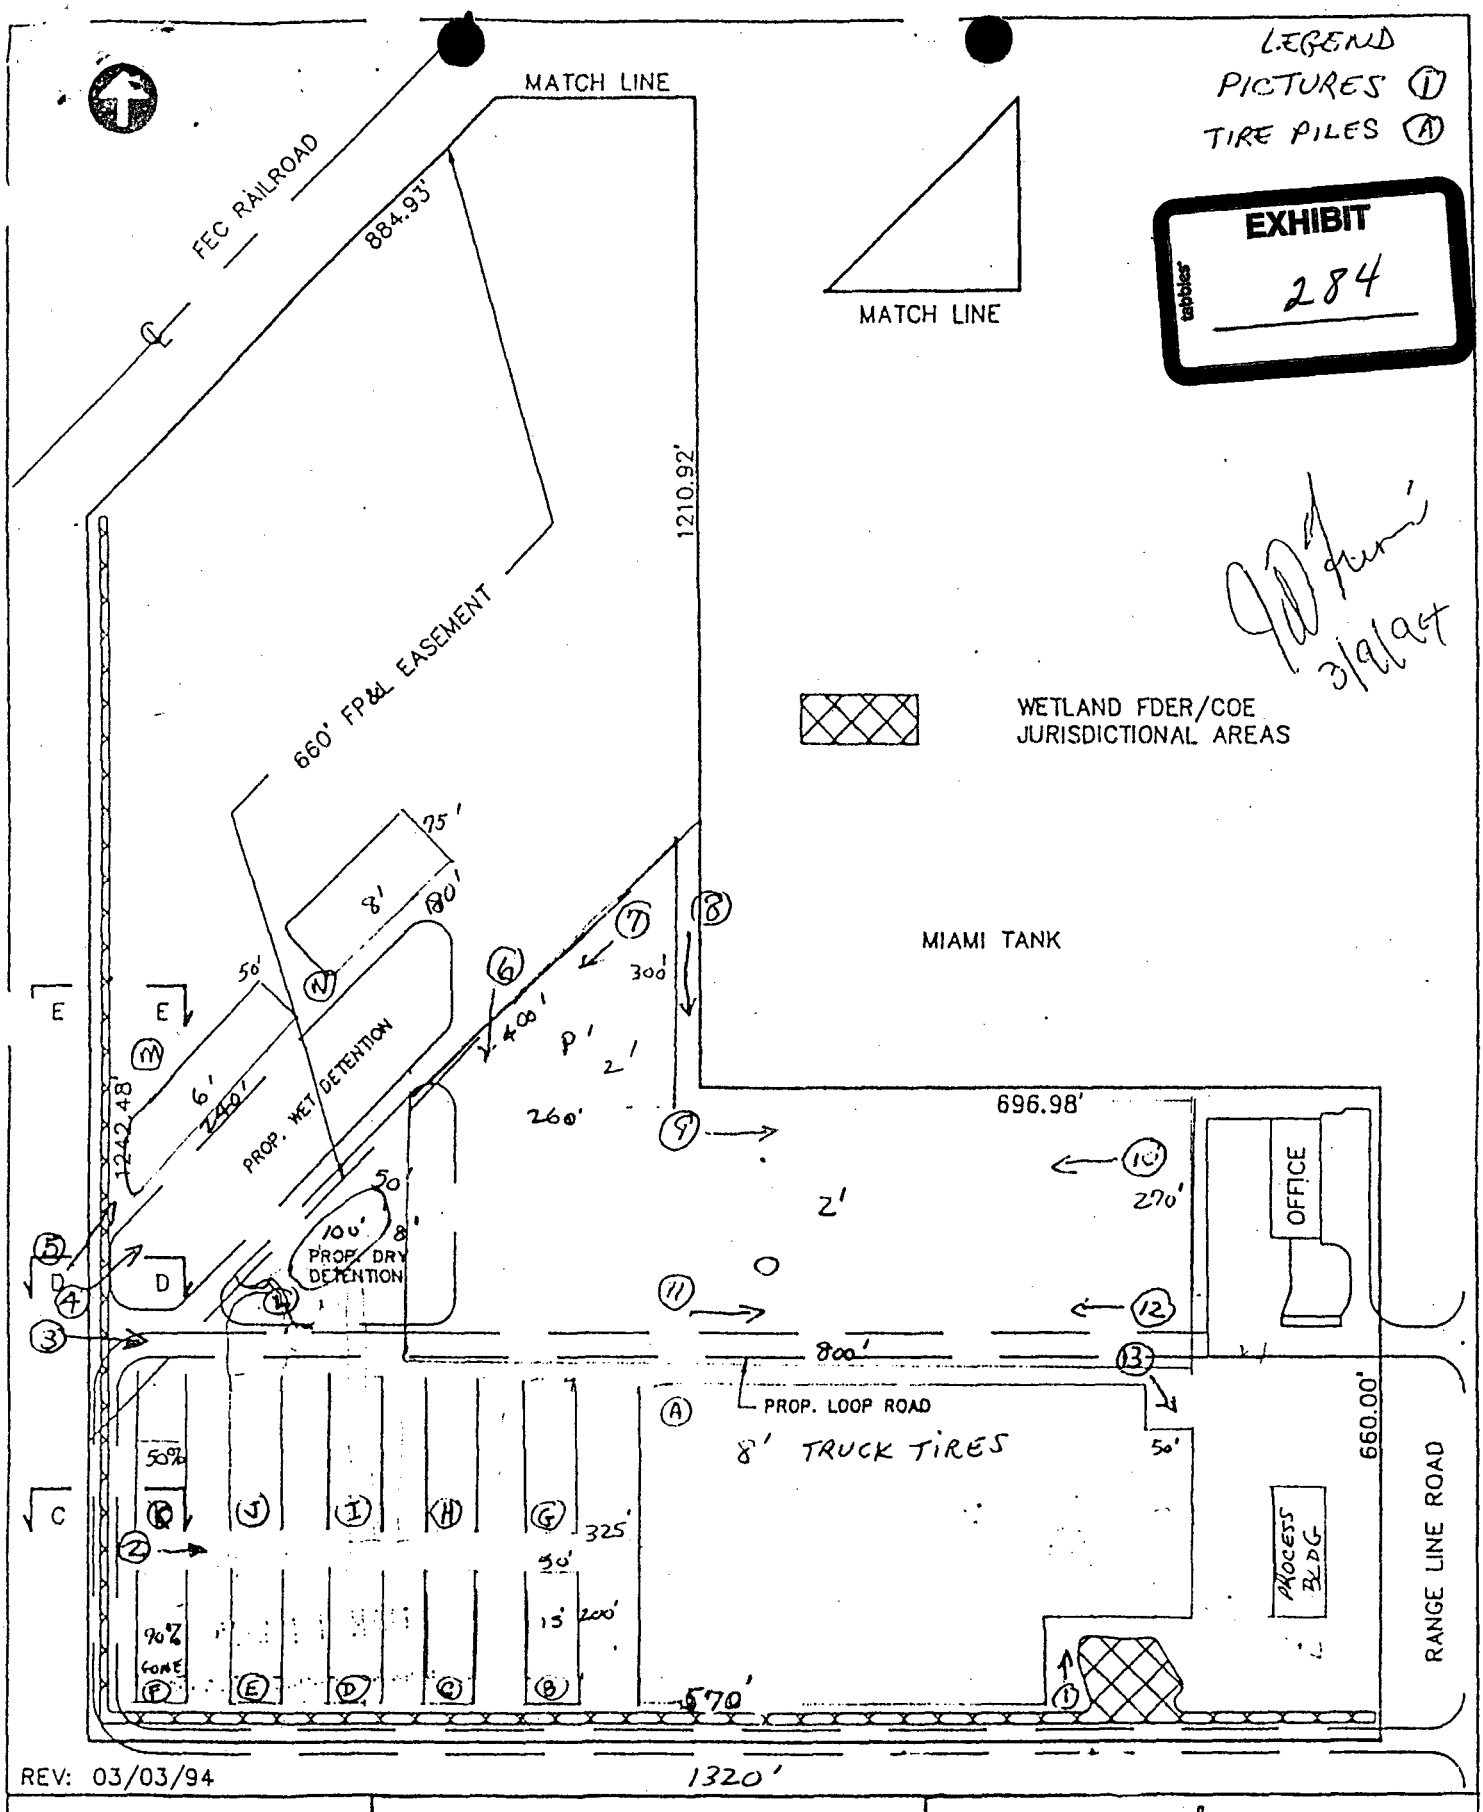


DRAWN BY:	J.T.F.
LOCKED BY:	J.T.F.
DATE:	02/10/94
SCALE:	1" = 200'
JOB NO.:	9243DF

FLORIDA TIRE RECYCLING
DREDGE & FILL
EXISTING CONDITIONS – PLAN
SH. 2 OF 5

JOSEPH T. FRISCIA, P.E., INC.
1665 SW BILTMORE ST.
PORT ST. LUCIE, FLORIDA 34984
407-340-4990

FLORIDA TIRE RECYCLING, INC.
Estimated Inventory on Hand
November 10, 2000

AREA	MATERIAL	DIMENSIONS L	W	H	VOLUME CU.FT.	VOL USED	CU.FT. USED	LBS. CU.FT.	TOTAL LBS	TOTAL TONS
A	Whole tires	48	48	8	9,216	100%	9,216	10	92,160	46
B	Unregulated construction tires								-	-
B/C	Whole tires	220	12	12	15,840	100%	15,840	10	158,400	79
C	Unregulated construction tires								-	-
D	Unregulated construction tires								-	-
E	Shredded tires	200	50	15	75,000	50%	37,500	30	1,125,000	563
F	Unregulated construction tires								-	-
G	Shredded tires	200	50	15	75,000	90%	67,500	30	2,025,000	1,013
H	Unregulated construction tires								-	-
I	Shredded tires	200	50	15	75,000	100%	75,000	30	2,250,000	1,125
J	Shredded tires	200	50	15	75,000	100%	75,000	30	2,250,000	1,125
K	Shredded tires	200	50	15	75,000	20%	15,000	30	450,000	225
L	Area cleared								-	-
M	Whole tires	240	50	6	36,000	5%	1,800	10	18,000	9
N	Area cleared								-	-
O	Shredded tires	800	270	1	108,000	100%	108,000	30	3,240,000	1,620
P	Shredded tires	520	300	2	156,000	50%	78,000	30	2,340,000	1,170
									13,948,560	6,974

11/13/00 10:24

whole 134
shred 6840

EXHIBIT
tabbies
285