




Dept. of Environmental
Protection
SEP 1, 2011
Southwest District

TOPOGRAPHIC SURVEY
SOUTHEAST LANDFILL
LOCATED IN SECTION 28, TOWNSHIP 32 SOUTH,
RANGE 23 EAST, HILLSBOROUGH COUNTY, FLORIDA
PREPARED FOR: WASTE MANAGEMENT

SURVEYOR'S NOTES:

- 1) North, the grid, and the coordinates shown hereon are referenced to the West Zone of the Florida State Plane Coordinate System, NAD 83, 1993 adjustment.
- 2) Elevations are to National Geodetic Vertical Datum of 1929.
- 3) This topographic survey was prepared by photogrammetric methods. See the attached report for map accuracy and surveyor's signature and seal. This map is limited to those features visible on aerial photography.

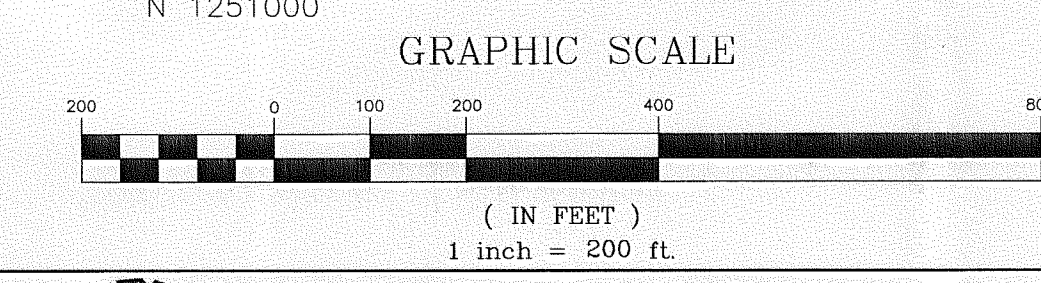

PICKETT
SURVEYING & PHOTOGRAMMETRY
PICKETT & ASSOCIATES, INC.
4711 SOUTH PINET AVENUE
BOCA RATON, FLORIDA 33433
PHONE: (561) 334-1888
FAX: (561) 334-1484

Horizontal Scale: 1" = 200'
Edited by: RP
Compiled by: BF
Contour Interval: 1'

Flight Date: 07/05/11
Drawing Name: 11994-10B.DWG

THIS MAP AND ATTACHED REPORT ARE NOT FULL AND COMPLETE WITHOUT THE OTHER AND ARE NOT VALID WITHOUT THE SIGNATURE AND THE ORIGINAL RAISED SEAL OF A FLORIDA LICENSED SURVEYOR AND MAPPER

No.	DATE	APPROVED	REVISION
D.R.	06/08/11	RJP	ORIGINAL RELEASE

(THESE FEATURES ARE REPRESENTED BY SYMBOLS NOT TO SCALE)		LEGEND: (THESE FEATURES ARE TO SCALE)	
△ CONTROL	□ CATH BASIN	— CURB	— PIPELINE
○ UTILITY POLE	□ VALVE	— PAVED SURFACE	— RECREATION
✱ LIGHT POLE	□ ELECTRICAL	— CONCRETE SURFACE	— EDGE OF GROVE
✱ TRAFFIC LIGHT	□ AIR CONDITIONER	— UNPAVED ROAD	— SWAMP LINE
□ POST	□ MISCELLANEOUS SYMBOL	— FENCE	— OBSCURED CONTOUR
□ FLAG	□ SWAMP/MARSH	— GUARDRAIL	— DEPRESSION CONTOUR
□ MAIL BOX	□ TREE	— RAILROAD	— ARE NOT SCALE DEPENDENT)
□ GUTTER	□ PALM	— STRUCTURE	— W.E. WATER ELEVATION
□ MANHOLE	□ SHRUB	— TREE LINE	— SPOT ELEVATION
□ HYDRANT		— SHRUB LINE	— OBSCURED SPOT