



PHASE II PHASE I

PRIMARY GEOMEMBRANE LINER EXTRUSION WELDED TO SECONDARY GEOMEMBRANE LINER


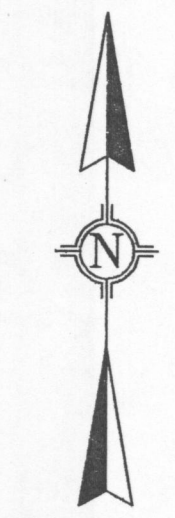


SCALE

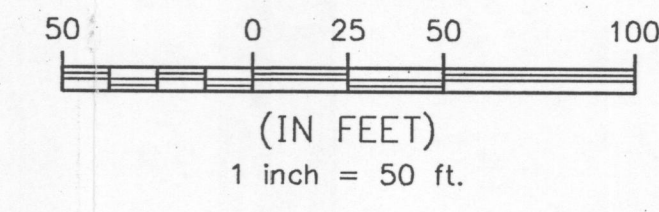


LEGEND

- P18 PRIMARY GEOMEMBRANE PANEL NUMBER
- DS 24 PASSED DESTRUCTIVE SEAM SAMPLE
- DS 37 FAILED DESTRUCTIVE SEAM SAMPLE
- ▲ EXTRUSION WELD REPAIR LOCATION
- PATCH REPAIR LOCATION
- EXTRUDED SEAM
- ▨ CAPPED SEAM (EXTRUSION SEALED)
- FUSION SEAM
- LEACHATE COLLECTION PIPE
- CL OF ANCHOR TRENCH
- LEACHATE CONTROL FLAP
- CONTAINMENT/RETAINING WALL

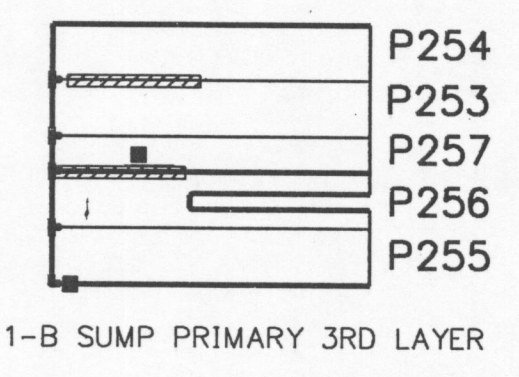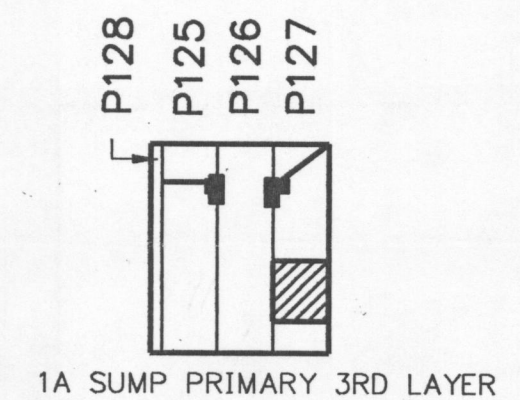

PHASE IA
PHASE IB

PHASE IB
PHASE IC

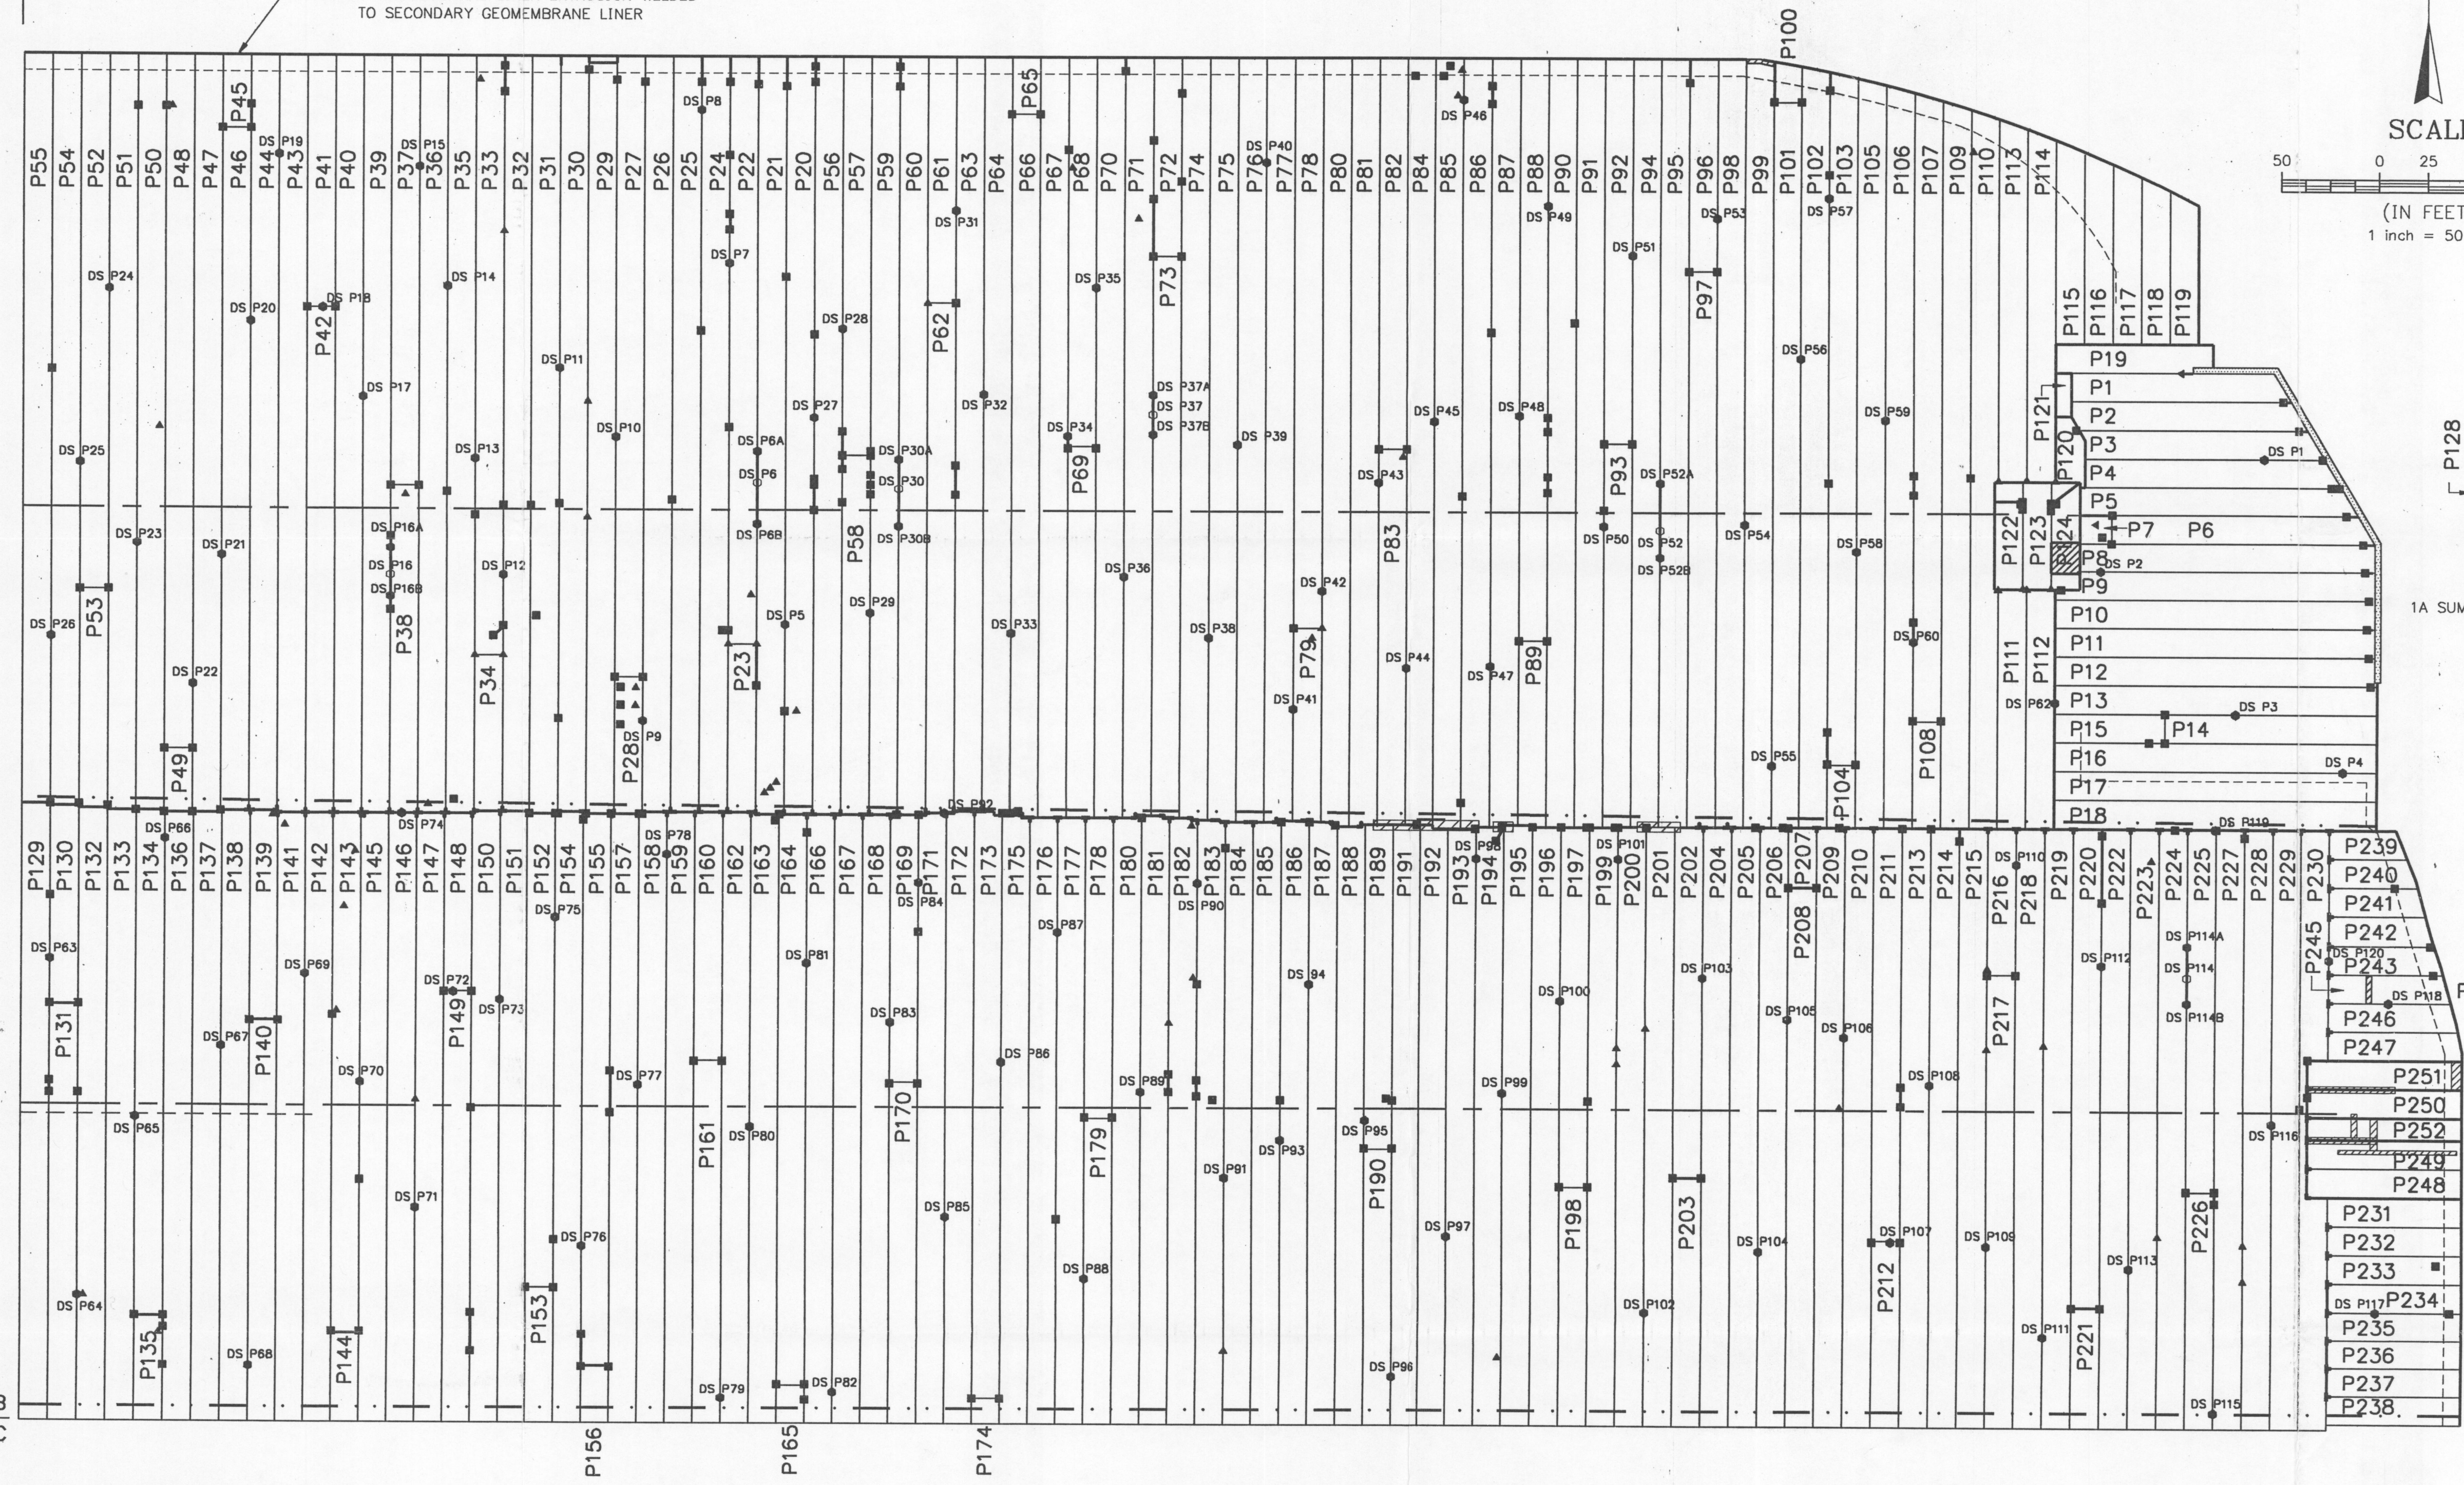

THIS RECORD DRAWING IS A GRAPHIC REPRESENTATION OF THE PRIMARY HDPE GEOMEMBRANE PANEL PLACEMENT AND DESTRUCTIVE SEAM SAMPLE LOCATIONS. FOR TRUE LENGTH OF THE HDPE GEOMEMBRANE PANELS, SEAMS, AND SAMPLE LOCATIONS, REFER TO APPENDICES OF GEOSYNTEC CONSULTANTS CQA FINAL REPORT DATED MAY 1992.

GEOSYNTEC
CONSULTANTS
Boynton Beach, Florida

11 May 1992
DATE

REV.	DATE	DESCRIPTION	DRN BY	APP BY
DATE:	5-9-92	PROJECT NO. FQ203	SCALE: 1"=50'	
DES BY:	SLB	PROJECT:	TRAIL RIDGE LANDFILL	
DRN BY:	SLB		PHASE IA AND IB	
CHK BY:	HMT	SHEET TITLE:		
REV BY:	DAS	PRIMARY GEOMEMBRANE PANEL		
APP BY:	AK	LAYOUT AND SEAM REPAIR LOCATION		



Trail Ridge Landfill, Inc.

SHEET 2 OF 3
DRAWING NO.

2