
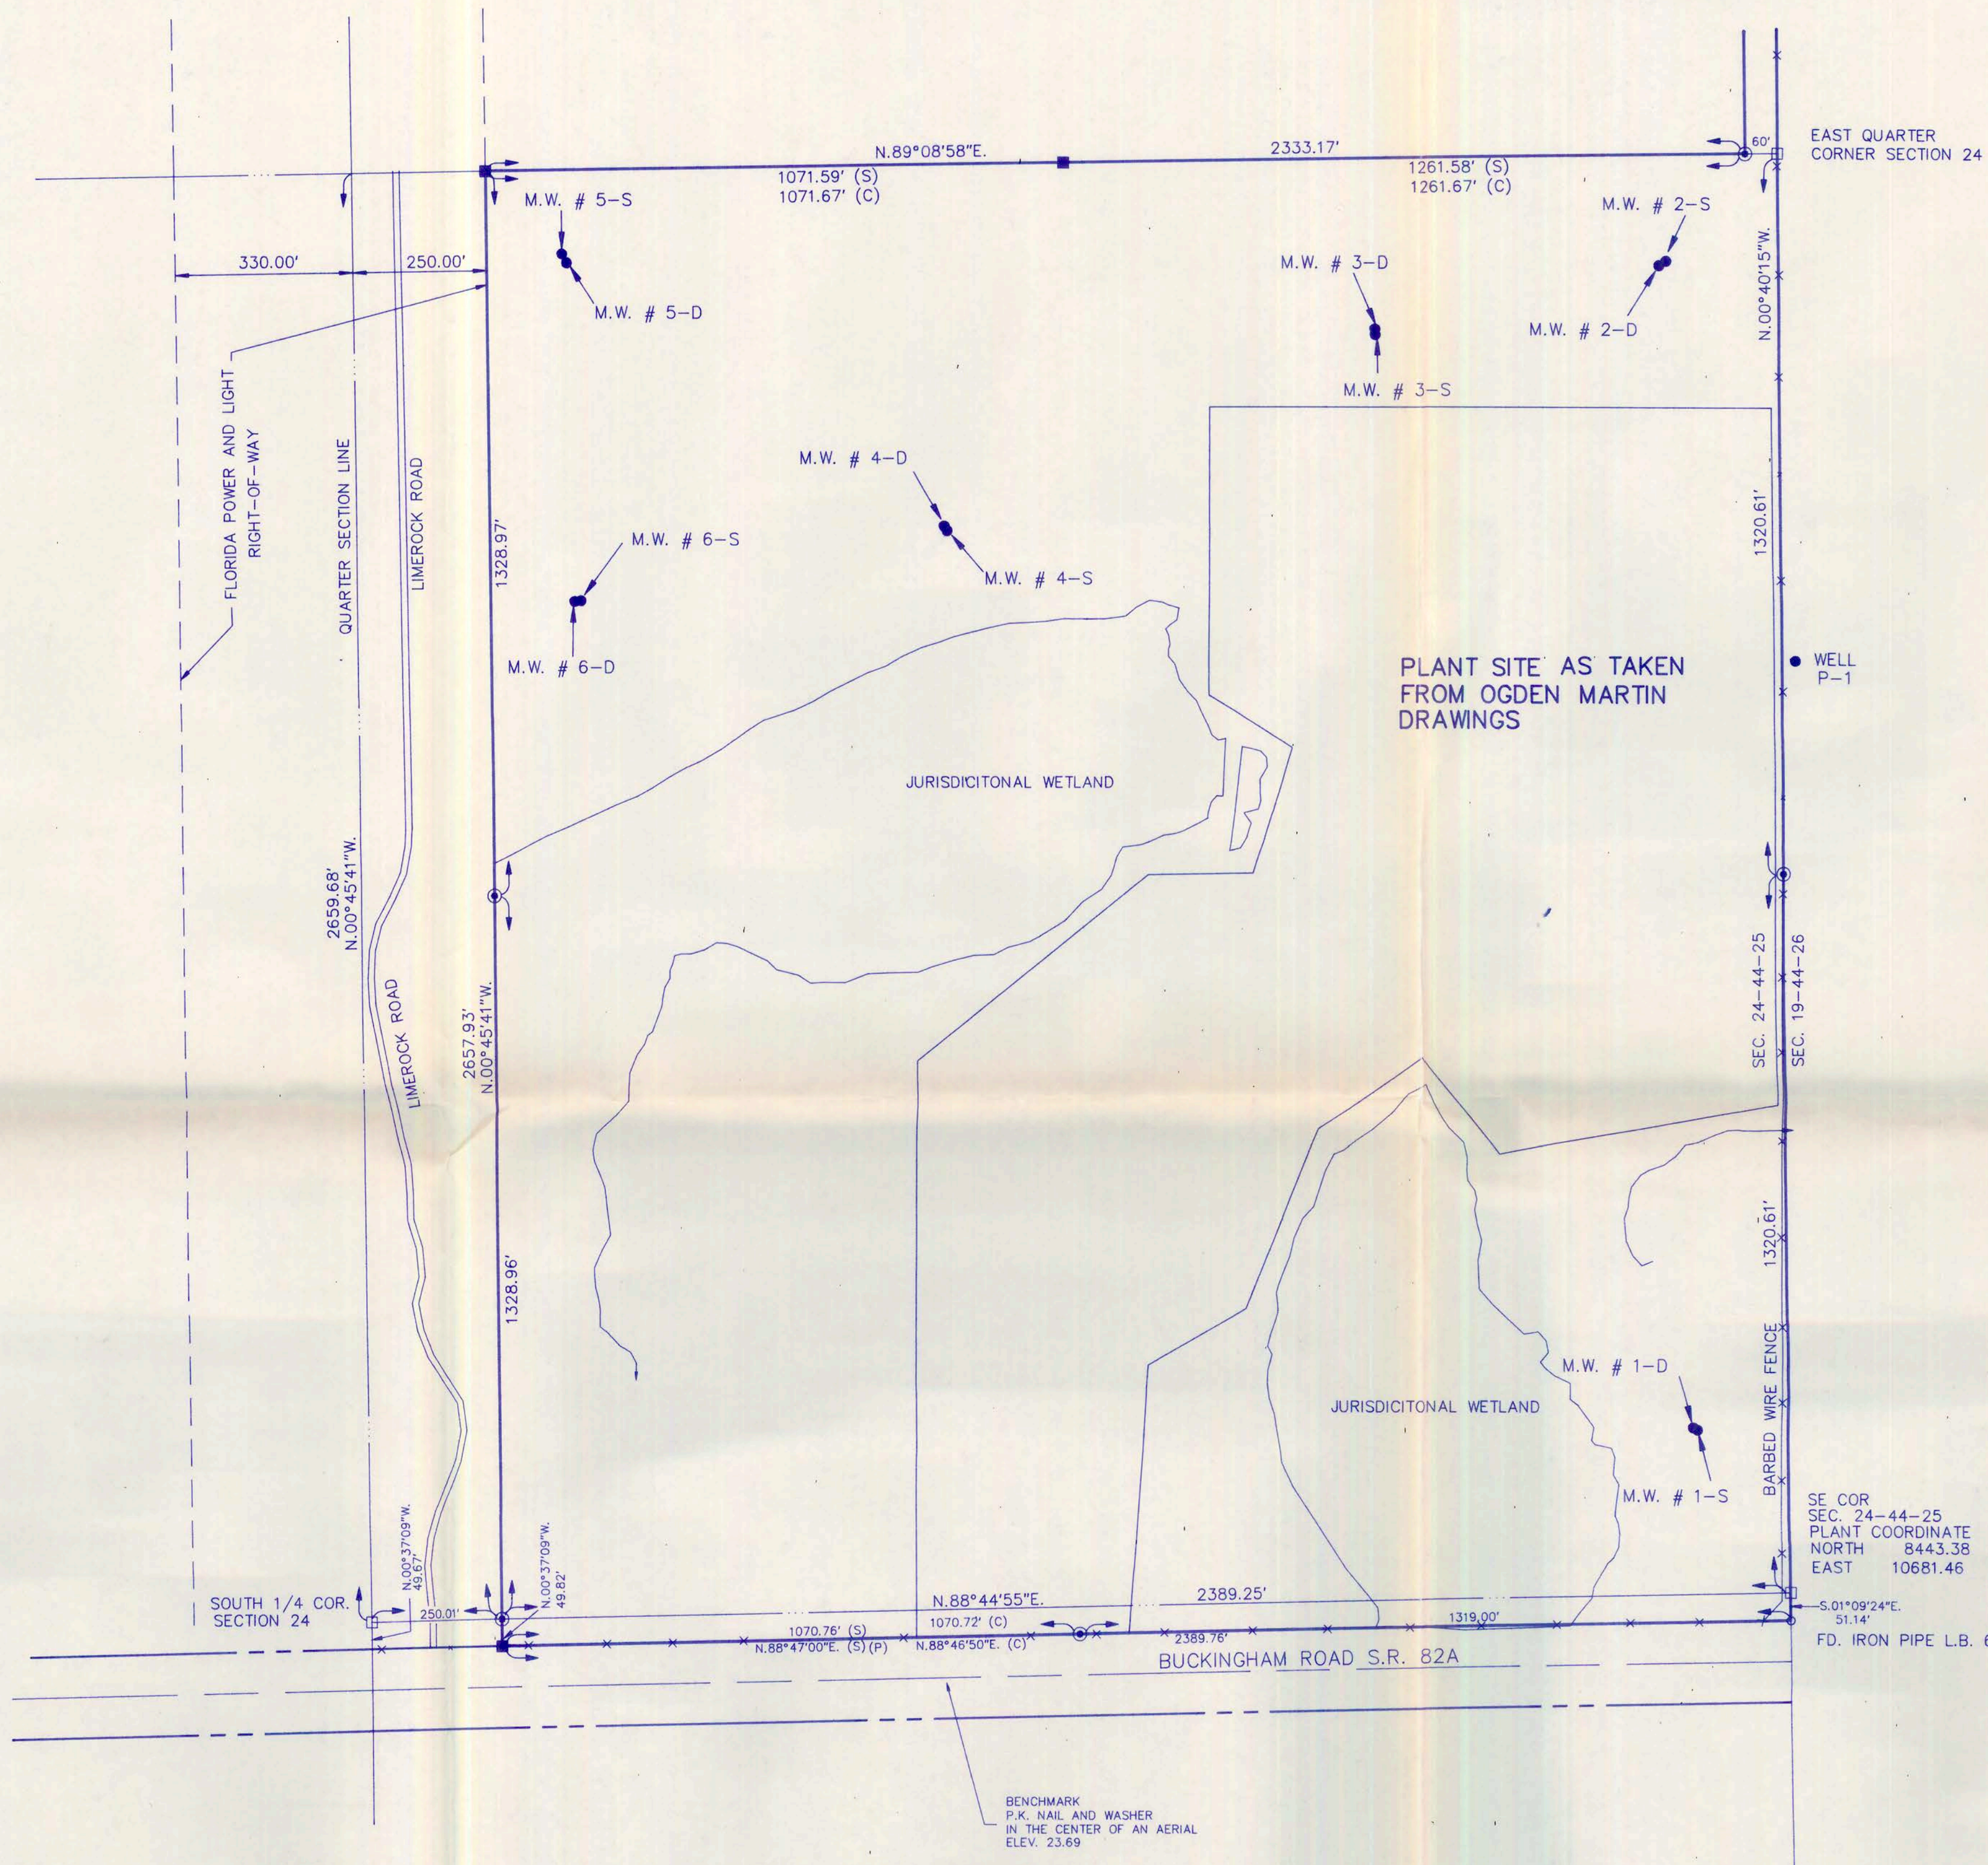



SPECIFIC PURPOSE SURVEY MONITORING WELLS

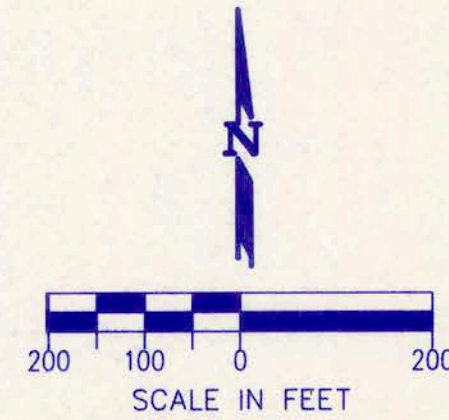

WELL CHART

DESCRIPTION	NORTHING	EASTING	ELEVATION @ TOP PIPE	GROUND ELEVATION	LATITUDE	LONGITUDE
M.W. # 1-S	8742.37	10510.43	21.91'	21.2'	26°37'41"	81°45'36"
M.W. # 3-S	10749.55	9907.34	23.15'	21.3'	26°38'01"	81°45'42"
M.W. # 4-S	10389.31	9113.44	22.48'	20.9'	26°37'58"	81°45'51"
P-1	10152.96	10686.19	24.10'	22.0'	26°37'55"	81°45'34"
M.W. # 1-D	8746.32	10502.54	22.96'	21.1'	26°37'42"	81°45'36"
M.W. # 2-D	10877.66	10431.45	23.52'	21.0'	26°38'03"	81°45'37"
M.W. # 2-S	10885.57	10444.67	24.18'	21.2'	26°38'03"	81°45'37"
M.W. # 3-D	10760.19	9906.72	23.90'	21.2'	26°38'01"	81°45'42"
M.W. # 5-D	10880.87	8408.35	24.50'	21.2'	26°38'03"	81°45'59"
M.W. # 5-S	10896.92	8399.51	23.81'	20.9'	26°38'03"	81°45'59"
M.W. # 6-D	10259.89	8423.76	22.91'	20.8'	26°37'57"	81°45'59"
M.W. # 6-S	10261.19	8435.74	23.66'	20.9'	26°37'57"	81°45'59"
M.W. # 4-D	10397.85	9108.26	23.81'	20.9'	26°37'58"	81°45'51"

NOTE: ALL ELEVATIONS WERE OBTAINED AT THE HIGHEST POINT ON WELL PIPES

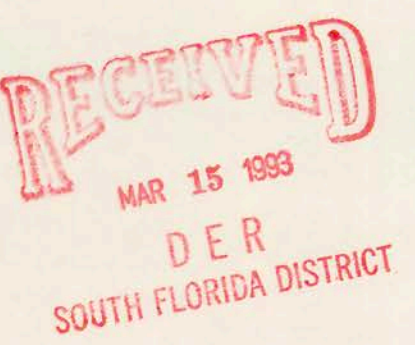

- SYMBOLS**
- DENOTES FOUND REBAR & CAP L.B. 3664
 - ✕✕ BARBED WIRE FENCE AS SCALED FROM SURVEY
 - DENOTES FOUND CONCRETE MONUMENT L.B. 3664
 - DENOTES FOUND CONCRETE MONUMENT
 - MONITORING WELL LOCATION

SURVEYOR'S CERTIFICATE
WE HEREBY CERTIFY THAT A SPECIFIC PURPOSE SURVEY SHOWING THE LOCATION AND ELEVATION OF MONITORING WELLS WAS MADE UNDER THE DIRECT SUPERVISION OF THE UNDERSIGNED SURVEYOR IN ACCORDANCE WITH THE MINIMUM TECHNICAL STANDARDS FOR LAND SURVEYING, CHAPTER 21 H&S FAC, AS SET FORTH BY THE FLORIDA BOARD OF LAND SURVEYORS, PURSUANT TO SECTION 472.027, FLORIDA STATUTES, AND THAT THE SKETCH HEREON IS A TRUE AND CORRECT REPRESENTATION THEREOF TO THE BEST OF OUR INFORMATION AND BELIEF.
SUBJECT TO NOTES AND QUALIFICATIONS SHOWN HEREON.
LAST FIELD WORK: 12/15/92 INK ENGINEERING, INC.
DATE OF SIGNATURE: 3/8/93 NICK POULOS, FOR THE PROFESSIONAL LAND SURVEYOR, FLA. CERTIFICATE NO. 44568
NOT VALID UNLESS SIGNED, DATED AND STAMPED WITH EMBOSSED SEAL.

NOTE: LATITUDES AND LONGITUDES SHOWN HEREON ARE SCALED FROM U.S.G.S. QUAD MAP "FORT MYERS, FLA" USING THE FLORIDA STATE PLANE COORDINATE FOR WEST ZONE PER CERTIFIED CORNER RECORD NUMBER 0030287, FILED BY JOHNSON ENGINEERING, INC. AND DATED 11/21/1988

LEGEND:



T.	TOWNSHIP
R.	RANGE
LB.	LICENSED BUSINESS
(C)	CALCULATED
(S)	DIMENSION AS SHOWN ON SURVEY
(P)	PLAT
FD	FOUND
COR	CORNER
S.R.	STATE ROAD
MON	MONUMENT
ELEV.	ELEVATION
M.W.	MONITORING WELL

SURVEYOR'S NOTES

- ELEVATIONS SHOWN (IF ANY) ARE BASED ON NATIONAL GEODETIC VERTICAL DATUM, (N.G.V.D.) US GEOLOGICAL SURVEY BENCHMARK "51 WIM 1952" SURVEYOR'S NOTES
- SURVEY BASED ON FOUND MONUMENTATION AS ESTABLISHED BY OTHERS. REFERENCE IS MADE TO A BOUNDARY SURVEY OF PART OF SECTIONS 24 AND 25, TOWNSHIP 44 SOUTH, RANGE 25 EAST, PERFORMED BY AGNOLI, BARBER & BRUNDAGE, INC., AND DATED JUNE 22, 1990.
- BOUNDARY INFORMATION IS SHOWN FOR REFERENCE ONLY. VERIFICATION OF PREVIOUS BOUNDARY SURVEY BY AGNOLI, BARBER & BRUNDAGE, INC. NOT INCLUDED UNDER THE SCOPE OF THIS SURVEY.

REVISIONS	DATE	DESCRIPTION	BY
3/04/93	ADDED LAT. & LONGITUDES	N.P.	
1/20/93	RE-NUMBERED WELLS/REV. DWG.	N.P.	

CLIENT: **MALCOLM PIRNIE, INC.**
TEL (305) 731-7110 3230 WEST COMMERCIAL BLVD.
FT. LAUDERDALE, FLORIDA 33909

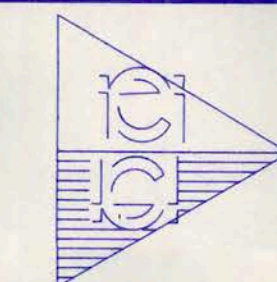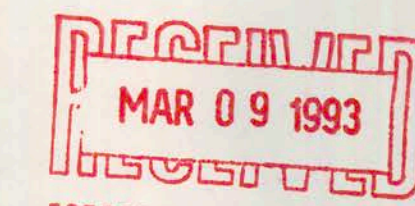

INK ENGINEERING, INC.
ENGINEERS • SURVEYORS • PLANNERS
6320 BEAU DRIVE N. FT. MYERS, FLORIDA 33903
TEL (813) 995-8500 • FAX (813) 997-3407

JOB NO. **9133**
SHEET 1 OF 1
SEC. TWP. RGE. **24-44-25**