
RECEIVED
JUN 18 1993
D.E.R. South District

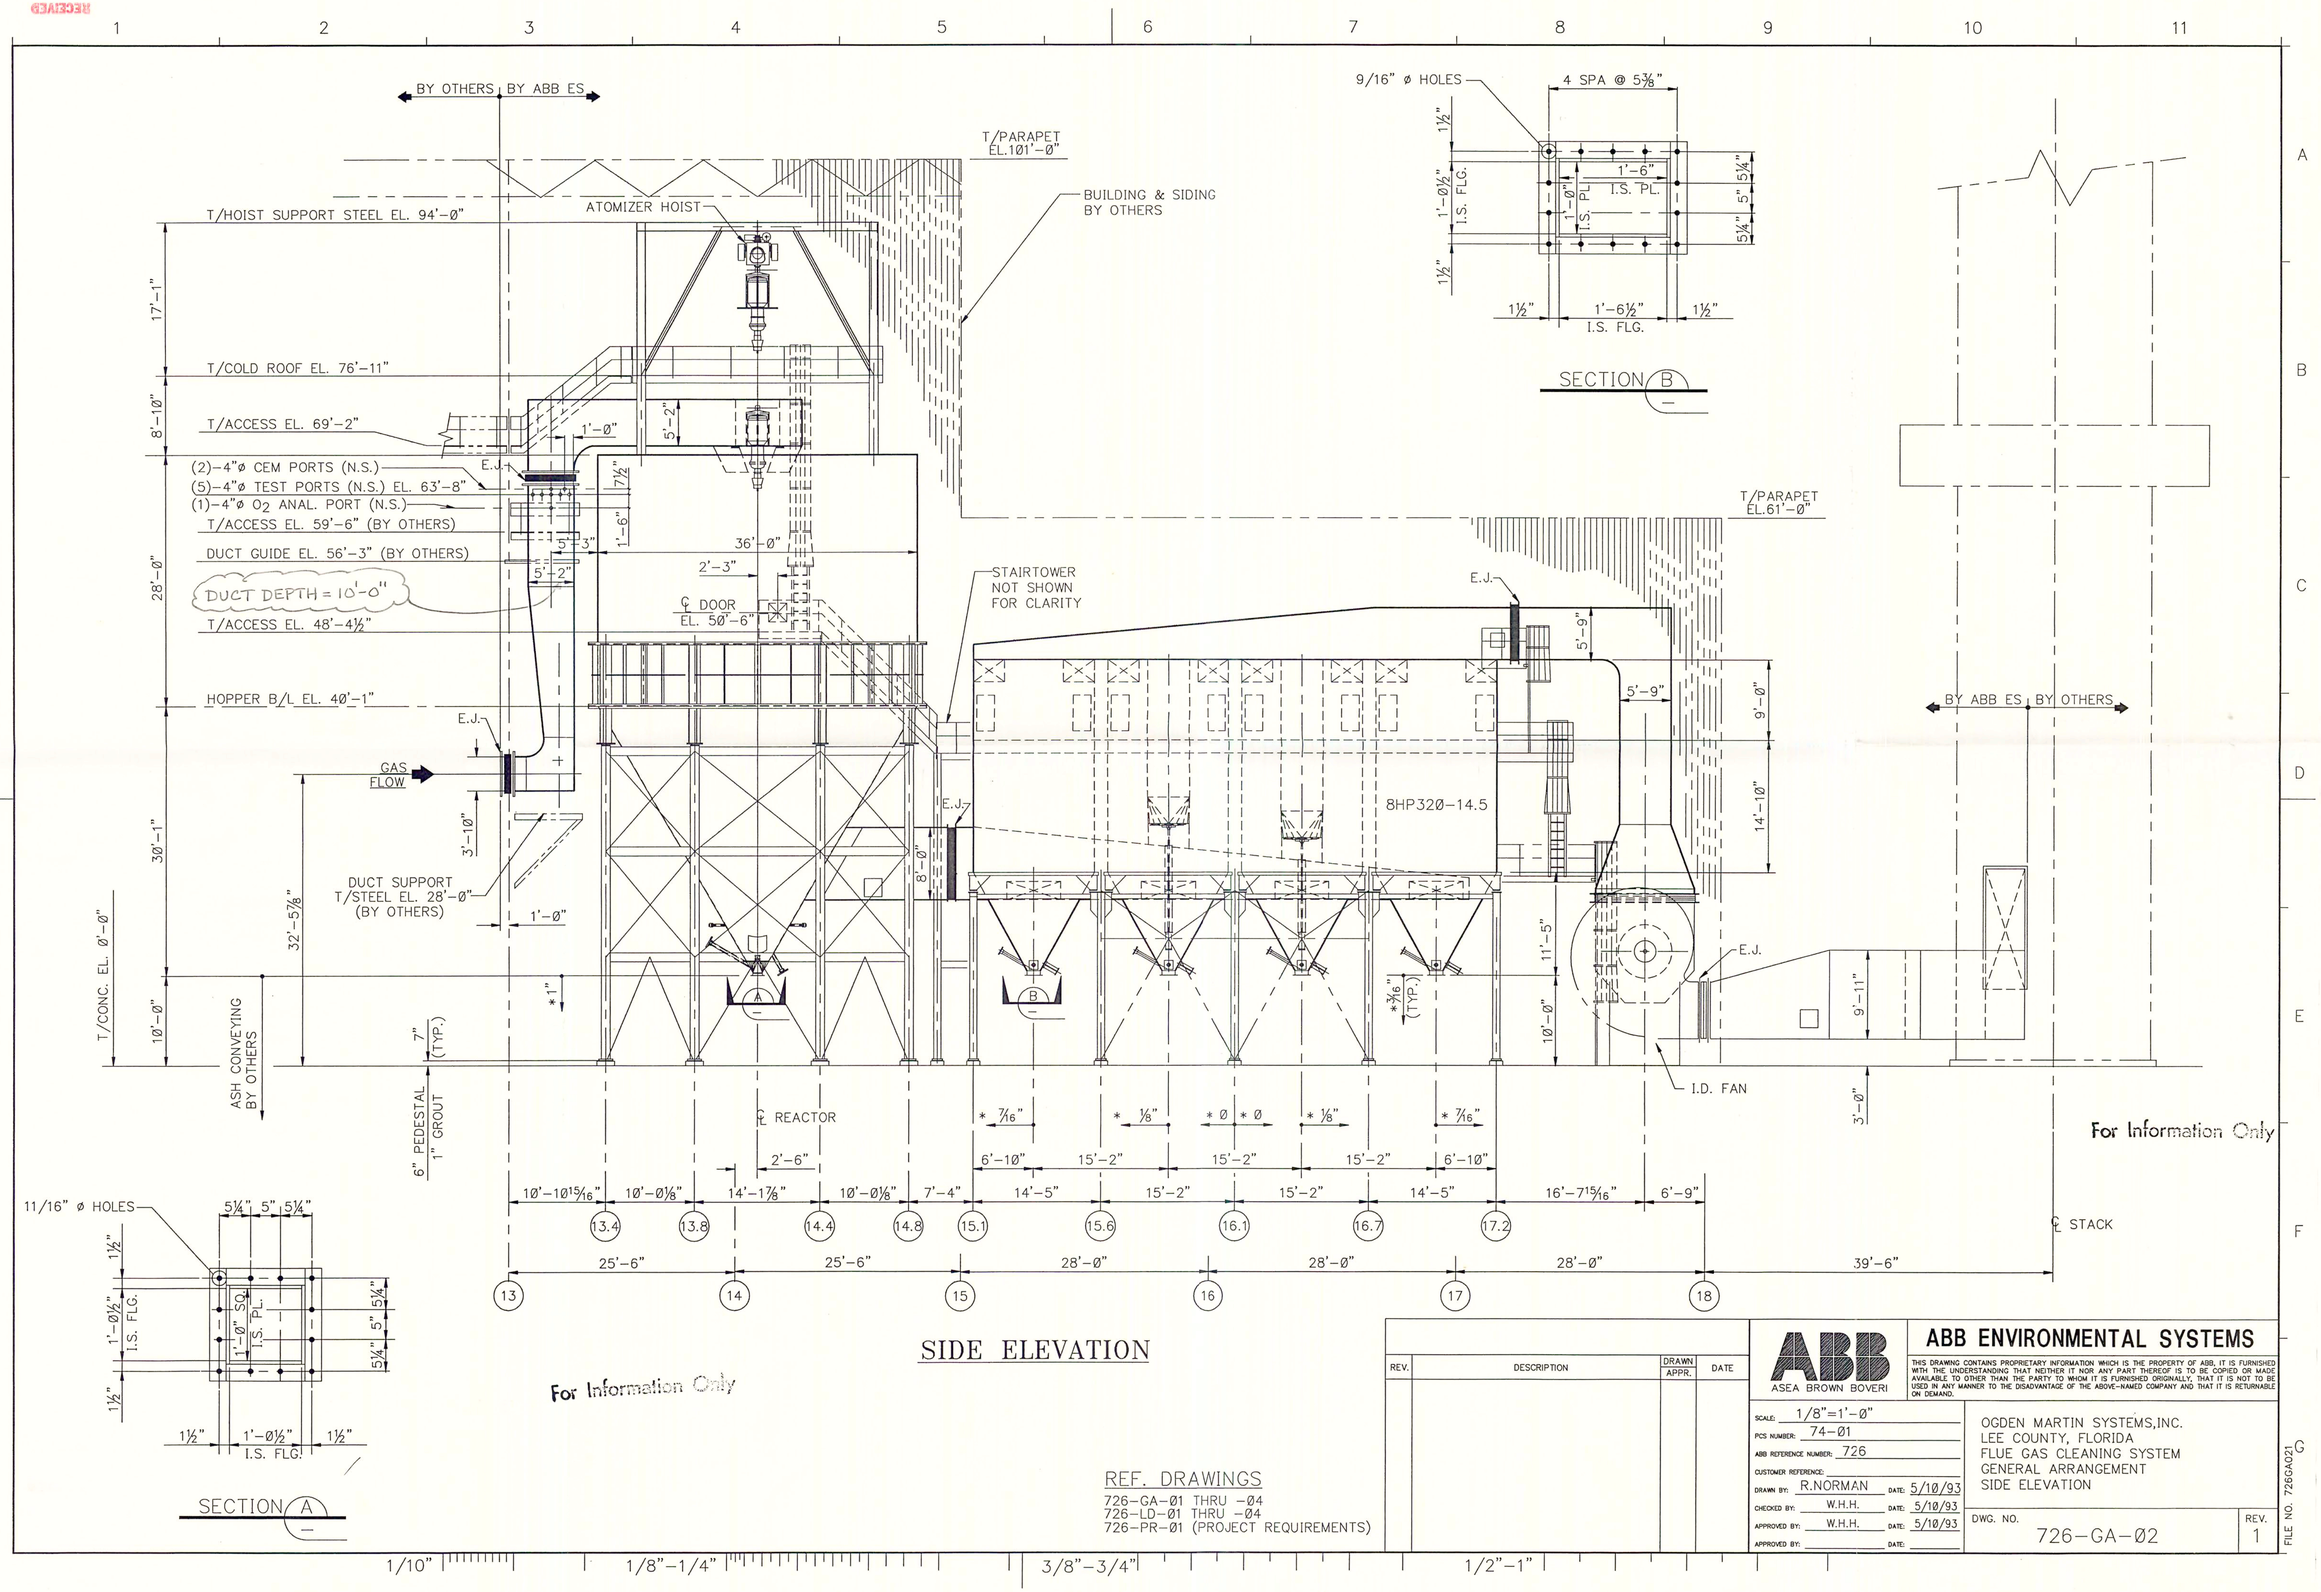

SIDE ELEVATION

SECTION B

SECTION A

For Information Only

REF. DRAWINGS
726-GA-Ø1 THRU -Ø4
726-LD-Ø1 THRU -Ø4
726-PR-Ø1 (PROJECT REQUIREMENTS)

REV.	DESCRIPTION	DRAWN APPR.	DATE

ABB ASEA BROWN BOVERI

ABB ENVIRONMENTAL SYSTEMS

THIS DRAWING CONTAINS PROPRIETARY INFORMATION WHICH IS THE PROPERTY OF ABB. IT IS FURNISHED WITH THE UNDERSTANDING THAT NEITHER IT NOR ANY PART THEREOF IS TO BE COPIED OR MADE AVAILABLE TO OTHER THAN THE PARTY TO WHOM IT IS FURNISHED ORIGINALLY, THAT IT IS NOT TO BE USED IN ANY MANNER TO THE DISADVANTAGE OF THE ABOVE-NAMED COMPANY AND THAT IT IS RETURNABLE ON DEMAND.

SCALE: 1/8"=1'-Ø"
PCS NUMBER: 74-Ø1
ABB REFERENCE NUMBER: 726
CUSTOMER REFERENCE:
DRAWN BY: R.NORMAN DATE: 5/10/93
CHECKED BY: W.H.H. DATE: 5/10/93
APPROVED BY: W.H.H. DATE: 5/10/93
APPROVED BY: DATE:

OGDEN MARTIN SYSTEMS,INC.
LEE COUNTY, FLORIDA
FLUE GAS CLEANING SYSTEM
GENERAL ARRANGEMENT
SIDE ELEVATION

DWG. NO. 726-GA-Ø2
REV. 1
FILE NO. 726GA021

1/10" 1/8"-1/4" 3/8"-3/4" 1/2"-1"

RECEIVED
JUN 18 1993
D.E.R. South District