

Public Works Department Solid Waste Division

September 7, 2012

ENV-12-144

Mr. F. Thomas Lubozynski Waste Administrator Florida Department of Environmental Protection Central District Office 3319 Maguire Boulevard Suite 232 Orlando, FL 32803

Re:

Quarterly Landfill Gas Monitoring Report – Third Quarter 2012

Volusia County's Tomoka Farms Road

Permit No. S064-0078767

Dear Mr. Lubozynski:

Enclosed please find a copy of the Third Quarter 2012 Landfill Gas Monitoring Report for Volusia County's Tomoka Farms Road Landfill.

If you have any comments or questions regarding this matter please contact me at (386)947-2952 or jstirk@co.volusia.fl.us.

Sincerely,

Jennifer R. Stifk

Environmental Specialist III

Enclosure:


Landfill Gas Monitoring Report

Third Quarter 2012 September 6, 2012 Tomoka Farms Road Landfill

Building	CH4 Percent	O2 Percent	LEL Percent
Scale House	0.0	18.7	0.0
Maintenance Building	0.0	17.6	0.0
Administration Building	0.0	18.6	0.0

Gas Monitoring Report Tomoka Roads Landfill

Gas	Gas CH4		O2	Balance	LEL
Probes	Percent	Percent	Percent	Percent	Percent
MW-1	0.0	0.3	17.1	82.6	0.0
MW-2	0.0	0.3	17.2	82.4	0.0
MW-3	0.0	2.2	17.4	80.2	0.0
MW-4	0.0	2.4	17.4	80.3	0.0
MW-5	0.0	1.4	17.4	81.2	0.0
MW-7	0.0	0.1	18.1	81.8	0.0
MW-8	0.0	0.0	18.3	81.7	0.0

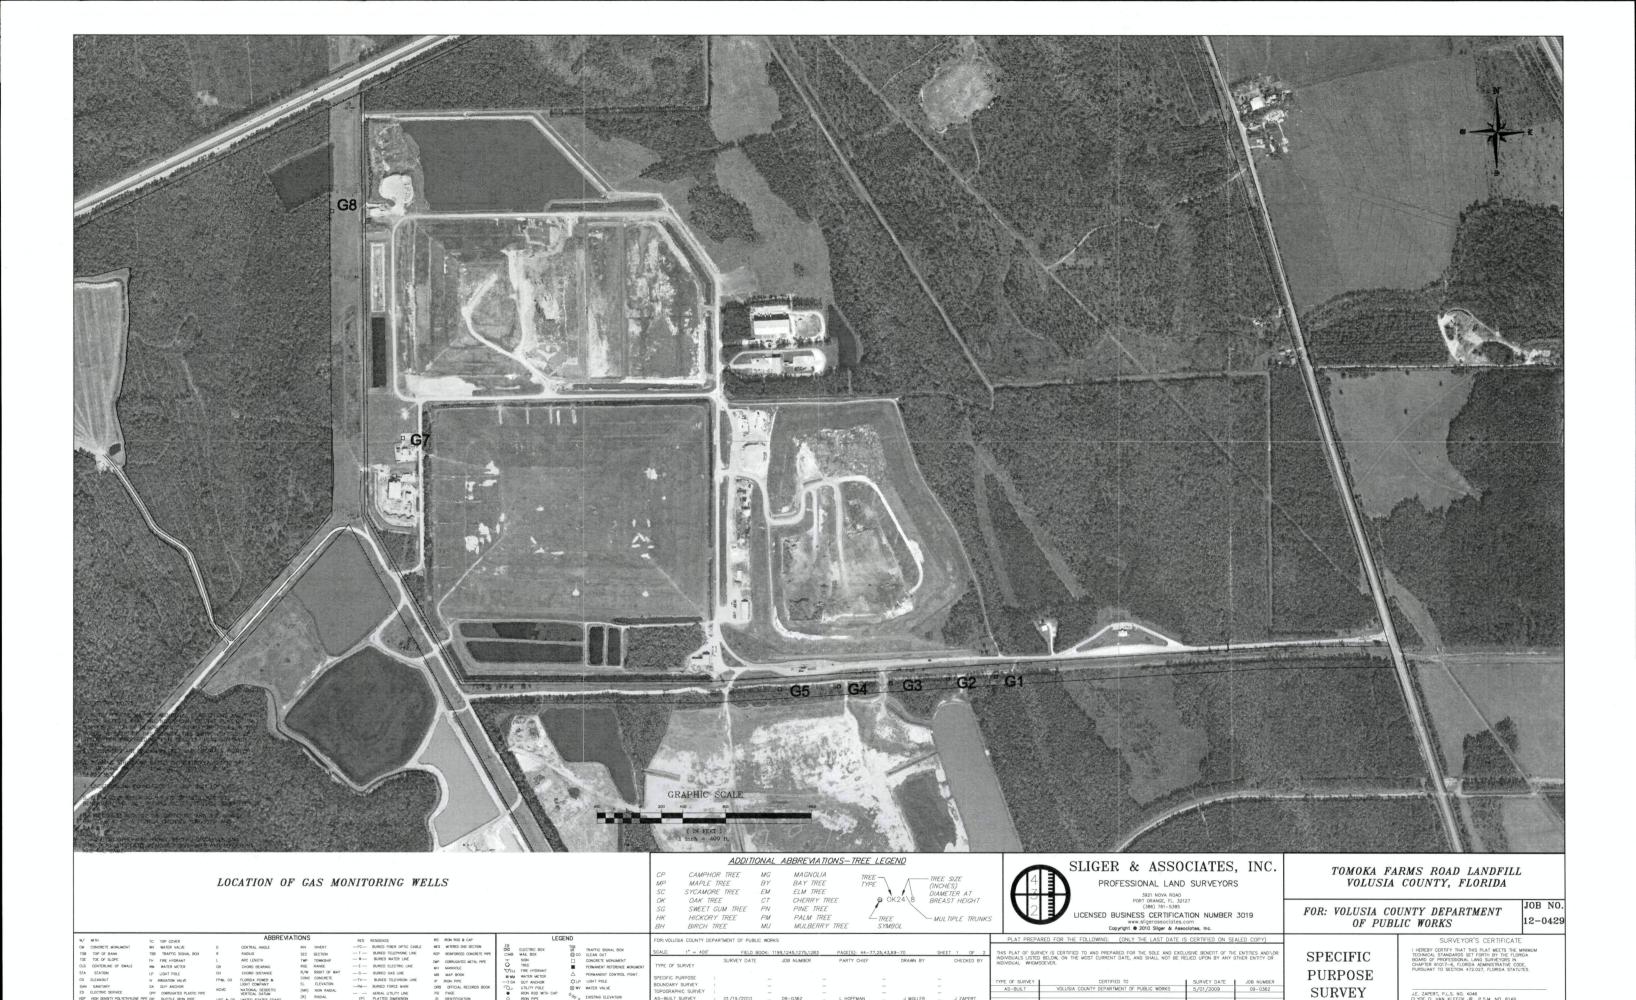

CERTIFIED TO ANY ENTITIES AND/OR INDIVIDUALS

Field Calibration Documentation for the GEM2000

Volusia County Solid Waste Division

Date	Time	Location Where	Individual Performing	Results Actual	Passed or	Readings associated	Corrective actions	Calibrated (Yes or	Initials
		check is	Check	Reading	Failed	with a failed	taken to fix	No)	
		performed			(Yes or No)	check	problem		
7/5/2011	0845	TOMOKA	ERNL	50/34.8/4.0		NA	10A	YEE	EPHI.
11/16/2011	8.5	Tomola		36.8/35.0/3.		CH4 36.3	send Riv	NO	J. Stirk
11/27/204	8:30	Tomoka	•	50.19317/39		NA	NA	Yes	P.B
3/14/2012	2:00P	Tumoka		50.0 31.8/4.6	Yes	NA	NA	Yes	J.RS.
3-16/2012		TomoKA	K. States	49.9 35.04		NA	NA	Y€S	KS
6.5-2012			K-Stotes	50 3 35 68 4	2 yes	NA	NA	VES	KS
8(9/12	8:00 Am	Timoka	JShrk	495 34.194	34es	NA	NA	Yes	JB
96/12	8:35 AM	Torroka	J.Stirk	34.2/4.	o yes	NA	NA	yes	URS
<u> </u>									
									
			<u> </u>						
			<u> </u>						
				-					
			<u> </u>	L		l	<u> </u>	<u> </u>	