



Florida Department of Environmental Protection

Central District
3319 Maguire Boulevard, Suite 232
Orlando, Florida 32803-3767

Charlie Crist
Governor

Jeff Kottkamp
Lt. Governor

Michael W. Sole
Secretary

By E-Mail
Aws97@aol.com

Mr. Gerald Laurencio
Friends Recycling, LLC
2350 N. W. 27th Avenue
Ocala, FL 34475

OCD-SW-09-0055

Marion County – SW
Friends Recycling, LLC – C&D Disposal & Recycling
Permit Application No. SO42-0019600-007
Review of Partial Cell 2A Certification of Construction Completion

Dear Mr. Laurencio:

Guerra Development Corporation submitted the form "Certification of Construction Completion of a Solid Waste Management Facility" and other documents regarding 2.77 acres of Cell 2A on your behalf. The first submittal was electronic on February 19, 2009. The submittal included an inflation adjusted cost estimate and a drawing of the 2.77 acre prepared area. I responded in an e-mail dated February 20, 2009 regarding changes needed for the cost estimate. The final version of the "Certification of Construction Completion of a Solid Waste Management Facility" form was dated February 19, 2009. The final version of the inflation adjusted cost estimate was dated February 24, 2009. Both were received on February 27, 2009. On February 25, 2009 the Department conducted a site visit regarding this submittal. The 2.77 acre is properly prepared.

The inflation adjusted cost estimate is approved by the Department. It satisfies the requirement to submit a cost estimate before using the new area in Cell 2A. Please update the financial assurance mechanism for the facility to match the amounts shown on this estimate.

As I discussed after the site visit, the "Certification of Construction Completion" for the 2.77 acres of Cell 2A depicted on the drawing dated February 19, 2009 is acceptable. You may begin placing waste in that portion of Cell 2A.

If you have any questions, please contact me at 407-893-3328.

Sincerely,

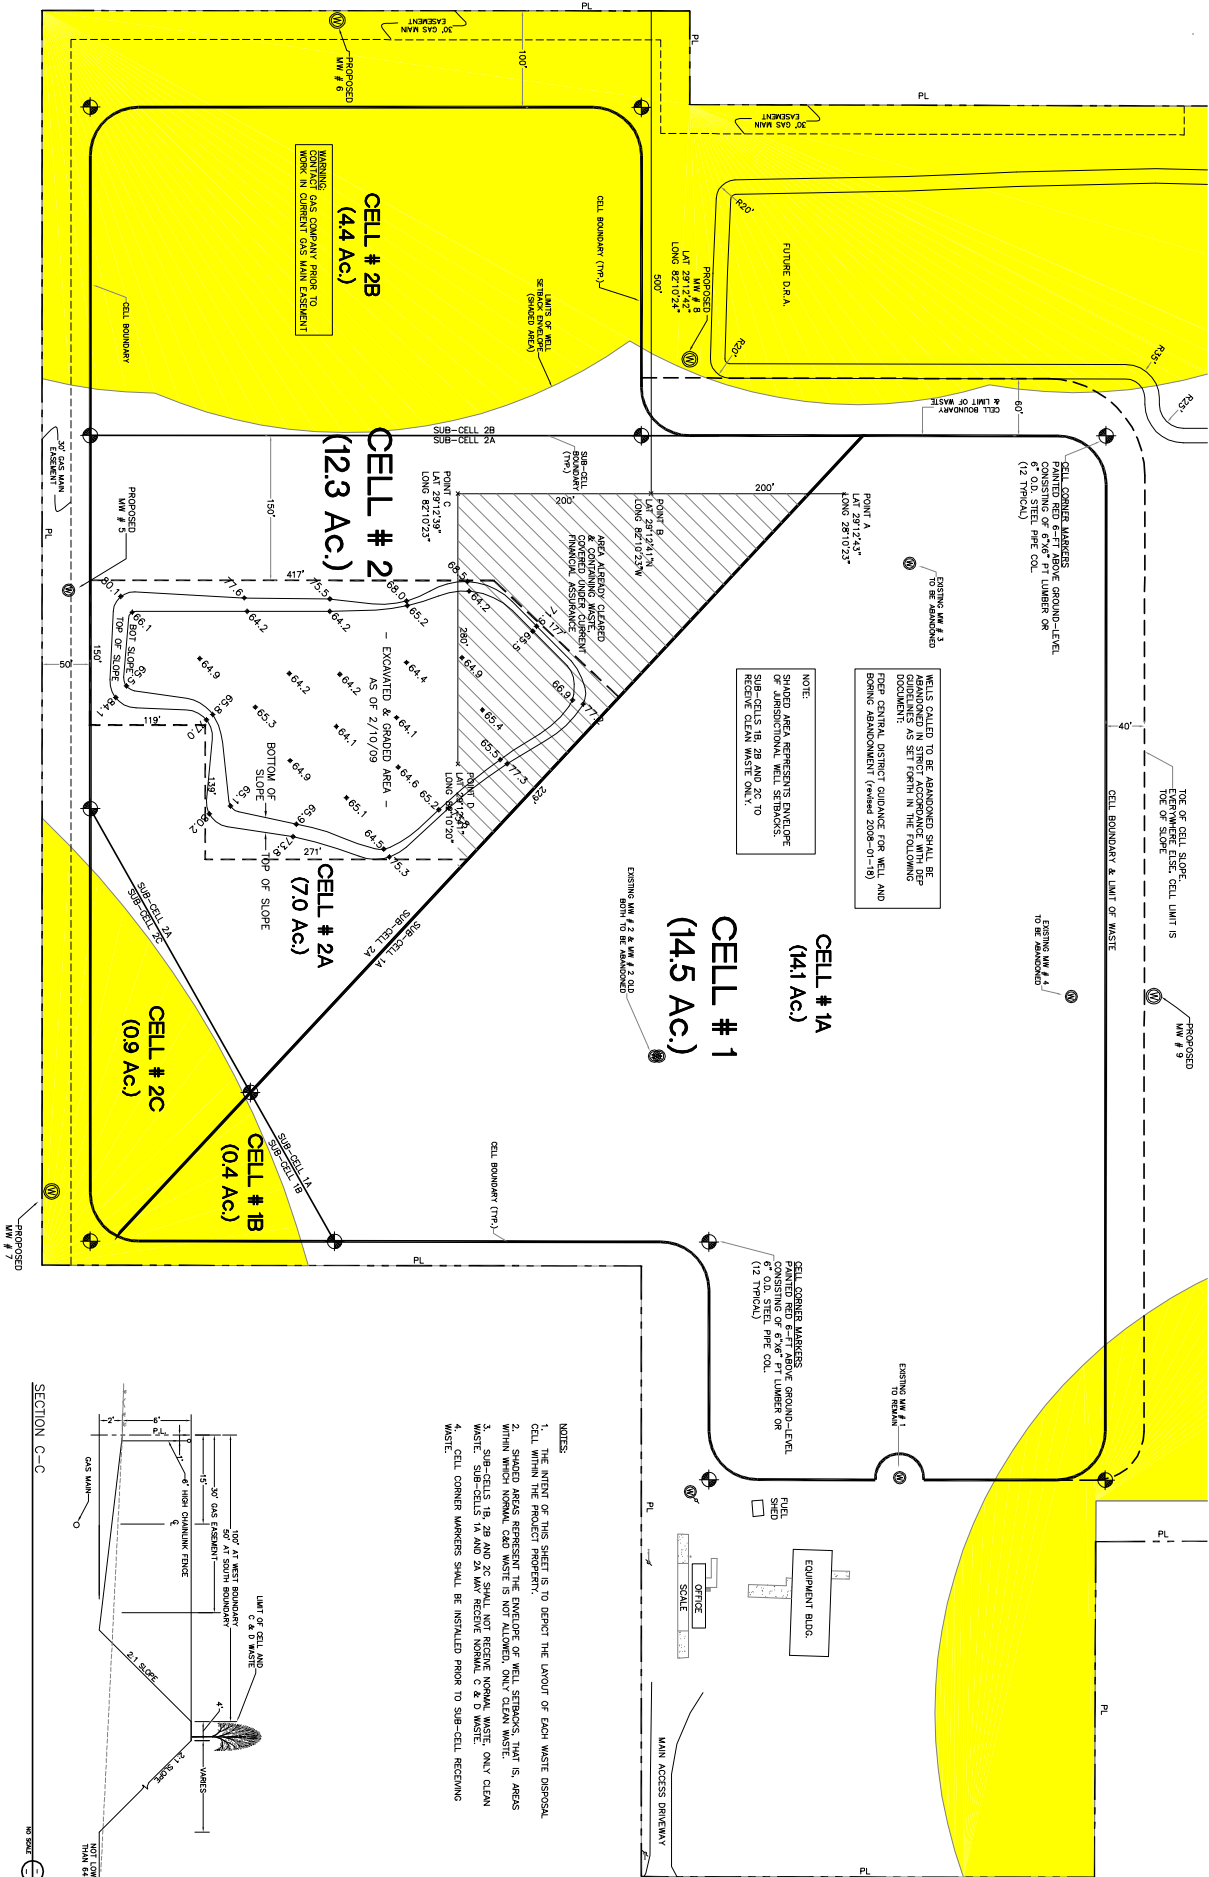
F. Thomas Lubozynski, P.E.
Waste Program Administrator



Date: March 3, 2009

FTL

Attachment: Drawing submitted with Certification, dated February 19, 2009

cc: Juan C. Guerra, P.E., Guerra Development Corp. guerracorp@att.net



REVISIONS		SCALE	
Date	By	Normal	1"=12'-0"
		Reduced	1"=12'-0"
Guerra Development Corp. Consulting Engineering 2817 N.E. 3rd Street, Dania, FL 33470 Ph: 352-429-8080 Fax: 352-429-4379		N.T.S.	
			
1" = 60'		1" = 60'	
0 30' 60'		0 30' 60'	
Approved By		JOB INFO	
		0307	
		SHEET NO.	
		2 of 6	
		DRAWING NO.	
		0307-PLAN	
		PROJECT NAME	
		FRIENDS RECYCLING RENEWAL	
		SHEET TITLE	
		CELL LAYOUT	
		CLIENT	
		FRIENDS RECYCLING, LLC	