FLORIDA DEPARTMENT OF
ENVIRONMENTAL PROTECTION
OCT 24 2006
SOUTHWEST DISTRICT
TAMPA

AUGUST 06 VOLUMES

Site Volume Table: UNADJUSTED
SITE: AUGUST-06
STRATUM: aug-06 sept-aug-06-base sept-aug-06

Cut cu.yds	Fill cu.yds	Net cu.yds	Method
321	55600	55278	(F)Grid
343	55662	55319	(F)Composite
345	55676	55331	(F)End area
343	55671	55328	(F)Prismoidal

SPECIFIC PURPOSE:

DESCRIPTION:

CLASS 1 LANDFILL, CENTRAL COUNTY SOLID WASTE DISPOSAL COMPLEX, LYING IN SECTIONS 2, 3, 10 & 11, TOWNSHIP 38 SOUTH, RANGE 19 EAST, SARASOTA COUNTY, FLORIDA.

SURVEYORS NOTATIONS:

1.) ELEVATIONS ARE BASED ON N.G.V.D. 1929.


2.) BASE BENCH MARK: 4" X 4" CONCRETE MONUMENT STAMPED S.E. 12, AT THE N/E CORNER OF THE LANDFILL SITE, BEING EL= 21.11'.

3.) CONTOURS AND QUANTITIES SHOWN HEREON WERE OBTAINED BY USING A CONTOURING AND SURFACE MODELING PROGRAM WHICH GENERATES OPTIMIZED TRIANGULATED IRREGULAR NETWORKS.

4.) QUANTITIES SHOWN HEREON ARE ACCURATE TO PLUS OR MINUS 5%.

5.) THE PURPOSE OF THIS SURVEY IS TO CALCULATE FILL VOLUMES, OF REFUSE ON A MONTH TO MONTH BASIS, TO DETERMINE THE AMOUNT OF REFUSE DEPOSITED IN A ONE MONTH PERIOD.

6.) CONTOURS ARE SHOWN IN ONE (1) FOOT INTERVALS.

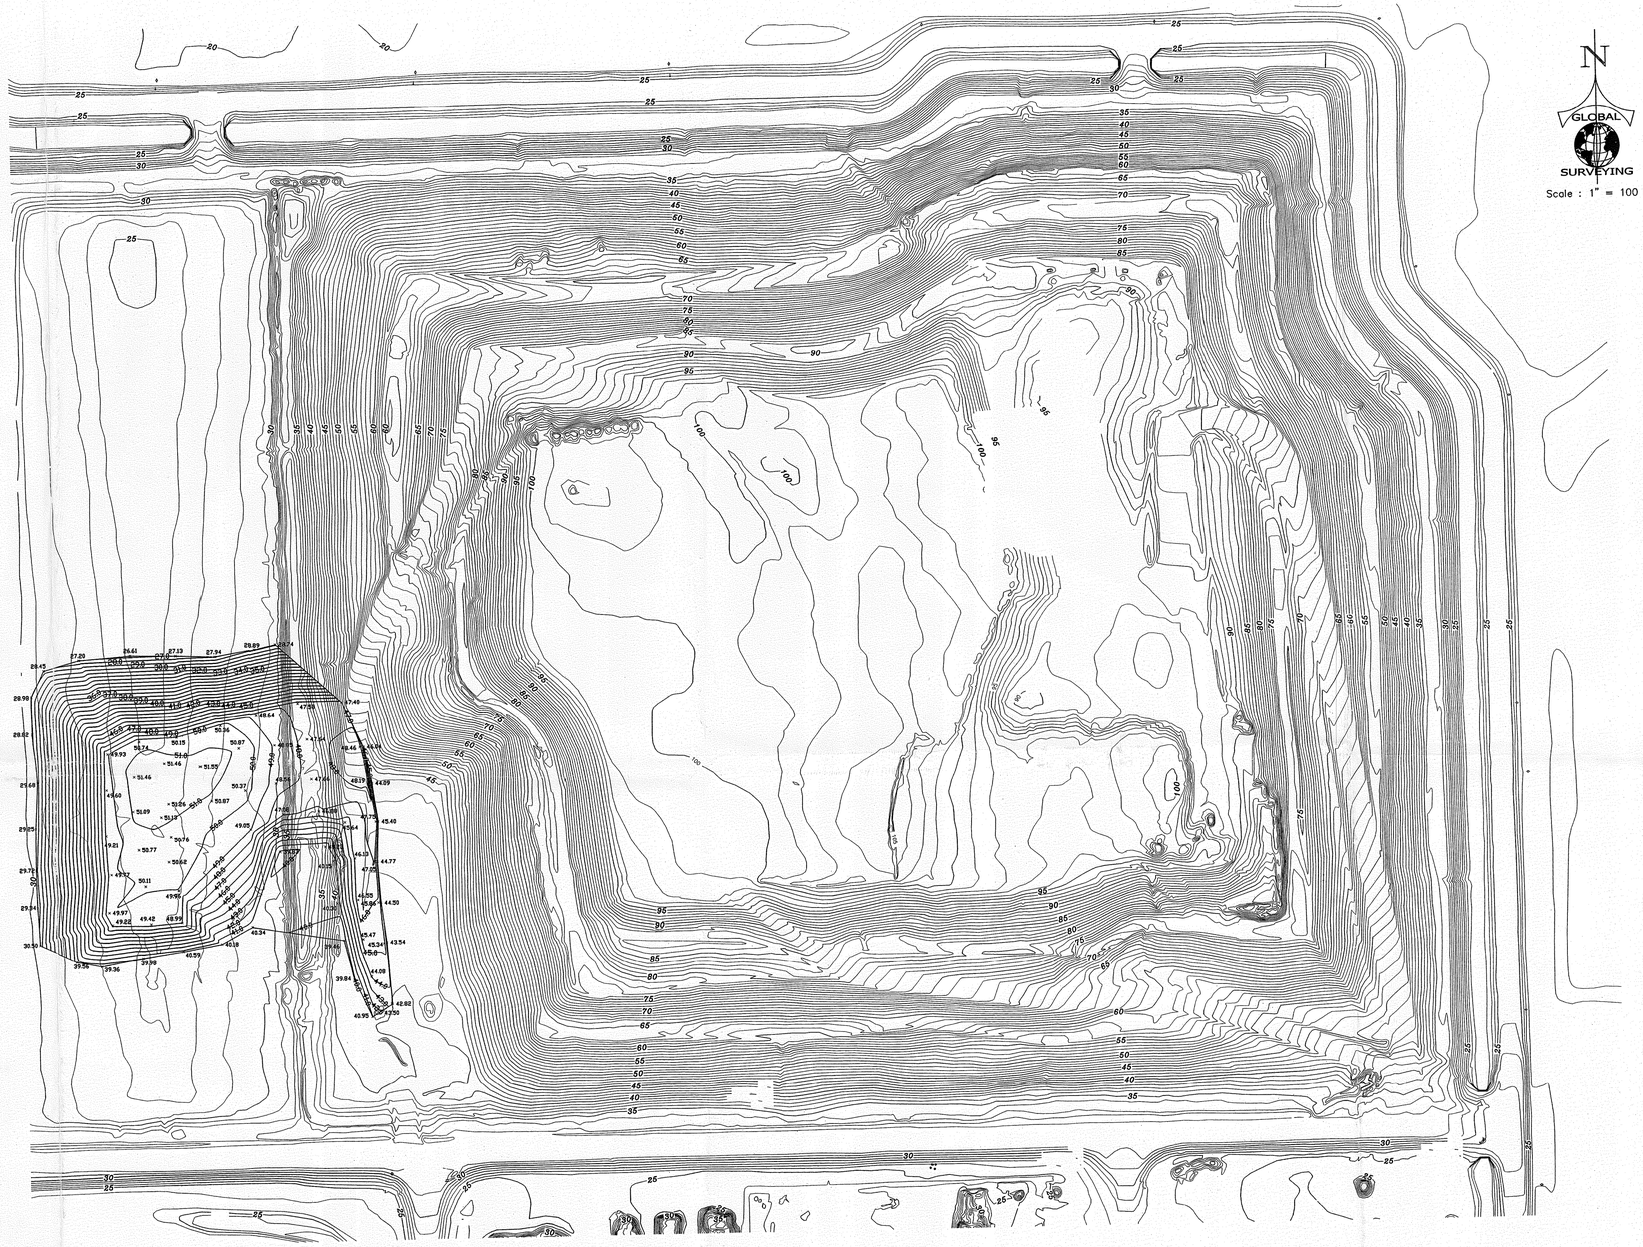



SURVEYOR'S CERTIFICATE:

THIS SURVEY WAS PREPARED UNDER MY DIRECTION AND IS TRUE AND CORRECT TO THE BEST OF MY KNOWLEDGE AND BELIEF. THIS SURVEY WAS ALSO PREPARED TO COMPLY WITH MINUMUM TECHNICAL STANDARDS EFFECTIVE THE DATE OF THIS SURVEY AS SET FORTH BY THE FLORIDA BOARD OF PROFESSIONAL SURVEYORS AND MAPPERS IN CHAPTER 61G17-6, FLORIDA ADMINISTRATIVE CODE, PURUANT TO CHAPTER 472.027, FLORIDA STATUES. SUBJECT TO ALL NOTES AND NOTATIONS SHOWN HEREON.

N

GLOBAL SURVEYING

Scale : 1" = 100 Ft.

Not valid without the signature and the original raised seal of a Florida licensed Surveyor and Mapper.

NO.	REVISION	DATE	BY
1.	FEBRUARY 2006 VOLUME	03/20/06	JH
2.	APRIL 2006 VOLUME	04/17/06	JH
3.	MARCH 2006 VOLUME	05/18/06	JH
4.	MAY 2006 VOLUME	06/09/06	JH
5.	JUNE 2006 VOLUME	07/07/06	JH
6.	JULY 2006 VOLUME	08/16/06	JH
7.	AUGUST 2006 VOLUME	09/15/06	JH
8.			
9.			
10.			
11.			

GLOBAL SURVEYING of Bradenton, L.L.C.
CERTIFICATE OF AUTHORIZATION LB 0007327
BRADENTON
904 STATE ROAD 64 EAST
BRADENTON, FLORIDA 34208
(941) 746-1512 (941) 742-0697FAX

Design By: JPH | Drawn By: JPH | Checked By: JC
OADD File: LANDFILL JAN'06 | Plot Index: 050799 | Date: 02/21/06 | Proj. No.: 050799 | SCALE: 1"=100'

This document, together with the concepts and designs presented herein, as an instrument of service, is intended only for the specific purpose and client for which it was prepared. Reuse of and improper reliance on this document without written authorization and adaptation by Global Surveying of Bradenton, L.L.C. will be without liability to Global Surveying of Bradenton, L.L.C.

X Tony L. Pursley

TONY L. PURSLEY P.S.M. #4451
FLA. CERT. NO.
2/01/06

FOR:
TITLE: ONYX
SPECIFIC PURPOSE SURVEY
DESC: SECTION 2,3,10 & 11 TOWNSHIP 38 SOUTH, RANGE 19 EAST

1