



SARASOTA COUNTY

"Dedicated to Quality Service"

Dept. Of Environmental Protection

OCT 17 2012

Southwest District

October 15, 2012

John Morris, PG
Solid Waste Section
Department of Environmental Protection
Southwest District Office
13051 North Telecom Parkway
Temple Terrace, Florida 33637-0926

Re: Central County Solid Waste Disposal Complex, WACS No. 51614
Permit Number 130542-002-SO/01
Extension of CW-8A and MW-8A

Dear Mr. Morris:

In accordance with the Phase I Closure Construction Drawings submitted in October 2011 as part of a minor permit modification application approved by Permit No. 130542-016-SF/MM, the upper casings for monitoring wells CW-8A and MW-8A were extended to accommodate construction of the south swale for the Phase I Class I Landfill Closure at the Sarasota County Central County Solid Waste Disposal Complex (CCSWDC). The extension construction was observed by HDR Engineering, Inc. (HDR) and Ardaman and Associates, Inc. (Ardaman). The construction of the extensions was documented by Ardaman in the report provided in Attachment A. The new top of casing and top of concrete pad elevations for CW-8A and MW-8A were surveyed by a Professional Land Surveyor licensed in Florida and a report was provided which is included in Attachment B. The well top of casing and top of concrete pad elevations changed as shown in the table below:


Well ID	WACS No.	Top of Casing Elevation (OLD)	Top of Casing Elevation (NEW)	Concrete Pad Elevation (NEW)
CW-8A	21453	26.13	35.04	32.03
MW-8A	22883	28.64	35.4	32.10

Well completion figures are provided in the Ardaman report in Appendix I for the extended wells. The top of casing elevation listed for CW-8A and MW-8A above will be used for all future groundwater level determination for these wells. In addition, revised monitoring well completion reports for CW-8A and MW-8A indicating the new top of casing elevations listed in the above table are provided in Attachment C for the Department's records.

John Morris, FDEP
October 15, 2012
Page 2 of 2

Please contact me anytime at 941-861-1572 if you have any questions or require any additional information regarding the groundwater well extensions.

Sincerely,

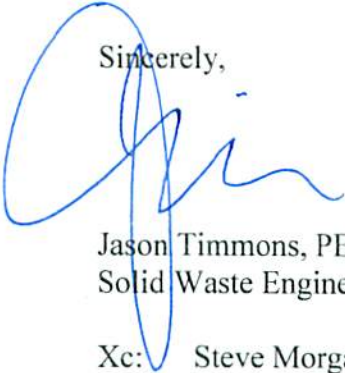A handwritten signature in blue ink, appearing to read 'J Timmons', is written over the word 'Sincerely,'.

Jason Timmons, PE
Solid Waste Engineer

Xc: Steve Morgan, FDEP
Lois Rose, Sarasota County

Attachments (3)

ATTACHMENT A



Ardaman & Associates, Inc.

Geotechnical, Environmental and
Materials Consultants

(Revised September 17, 2012)
September 7, 2012
File No. 09-7375

TO: HDR Engineering, Inc.
5426 Bay Center Drive, Suite 400
Tampa, FL 33609-3444

Attention: Richard Siemering

Subject: Extension of Groundwater Monitoring Well Casings at
"Central County Solid Waste Disposal Complex,"
4000 Knights Trail Road, Nokomis, Sarasota County, Florida

Dear Richard:

Construction of the "Phase I Class I Landfill Closure and Landfill Gas Collection System" at the subject site has required placement of soil fill in the areas of monitor wells MW-8A and CW-8A. For this reason, the above-grade casings of the monitor wells needed to be extended upward and a new protective cover installed.

Ardaman & Associates was retained to provide a licensed water well contractor (SWFWMD License #9418) to perform and oversee this work. In general, extension of the monitor well casings and placement of cement grout was performed by the water well contractor, while construction of the protective cover and concrete pad was performed by the general contractor (Thalle Construction).

A diagram of the completed construction for each well extension is included as Figures W-1 and W-2 in Appendix I of this report. As-built monitor well locations and elevations were determined by others and are summarized in the table below:

Well I.D.	WACS No.	Northing	Easting	Top of Casing Elevation	Concrete Pad Elevation
MW-8A	21453	1042388.262	530462.808	35.399 ft	32.101 ft
CW-8A	22883	1042359.929	530430.144	35.038 ft	32.028 ft

Copies of the Southwest Florida Water Management District (SWFWMD) well repair permits are included in Appendix II, for your records.

The work was performed in two stages. Each stage is described in the following paragraphs.

The first stage included removing the hinged lid from the existing 4-inch by 4-inch aluminum protective cover. The top of the existing 2-inch PVC well casings were female flush threaded.

A new, clean section of 10 feet long by 2 inch diameter, schedule 40, flush-threaded PVC monitor well casing (threads matching the existing casing) was threaded onto the existing casing. A top plug was installed on top of the new casing to prevent foreign matter from entering the well. An 8-inch diameter PVC casing (approximately 7 feet long) was installed as shown on the attached Figures and neat cement grout was installed inside the 8-inch casing by the tremie method, to form a seal and to stiffen and protect the monitor well during subsequent earthwork filling around the wells.

The second stage was performed after filling operations had reached somewhat above the top of the 8-inch casing. The top of the previous grout was cleared of any soil, then additional neat cement grout was placed up to the proposed bottom elevation of the concrete pad. The top of the 2-inch PVC monitor well casing was then cut to the appropriate height, new 6" x 6" aluminum protective covers were set into place and a new 4' x 4' x 6" concrete pad constructed.

We understand that the construction also requires bollards to be installed surrounding each of the monitor wells. These bollards were not installed under our observation, since they are not directly a part of the monitor well construction.


We appreciate the opportunity to be of your service on this project. Please contact us when we may be of further service, or if you should have any questions concerning this report.


Very truly yours,

ARDAMAN & ASSOCIATES, INC.
Certificate of Authorization No. 5950


Jerry H. Kuehn, P.E.
Senior Project Engineer
Fl. License No. 35557


JHK/GHS:ly

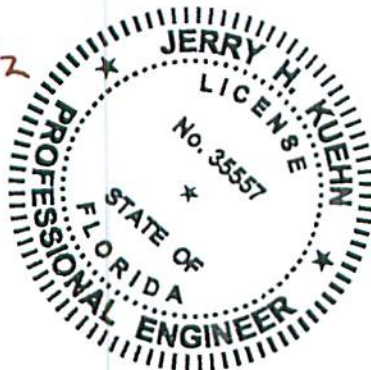


Gary H. Schmidt, P.E.
Vice President
Fl. License No. 12305



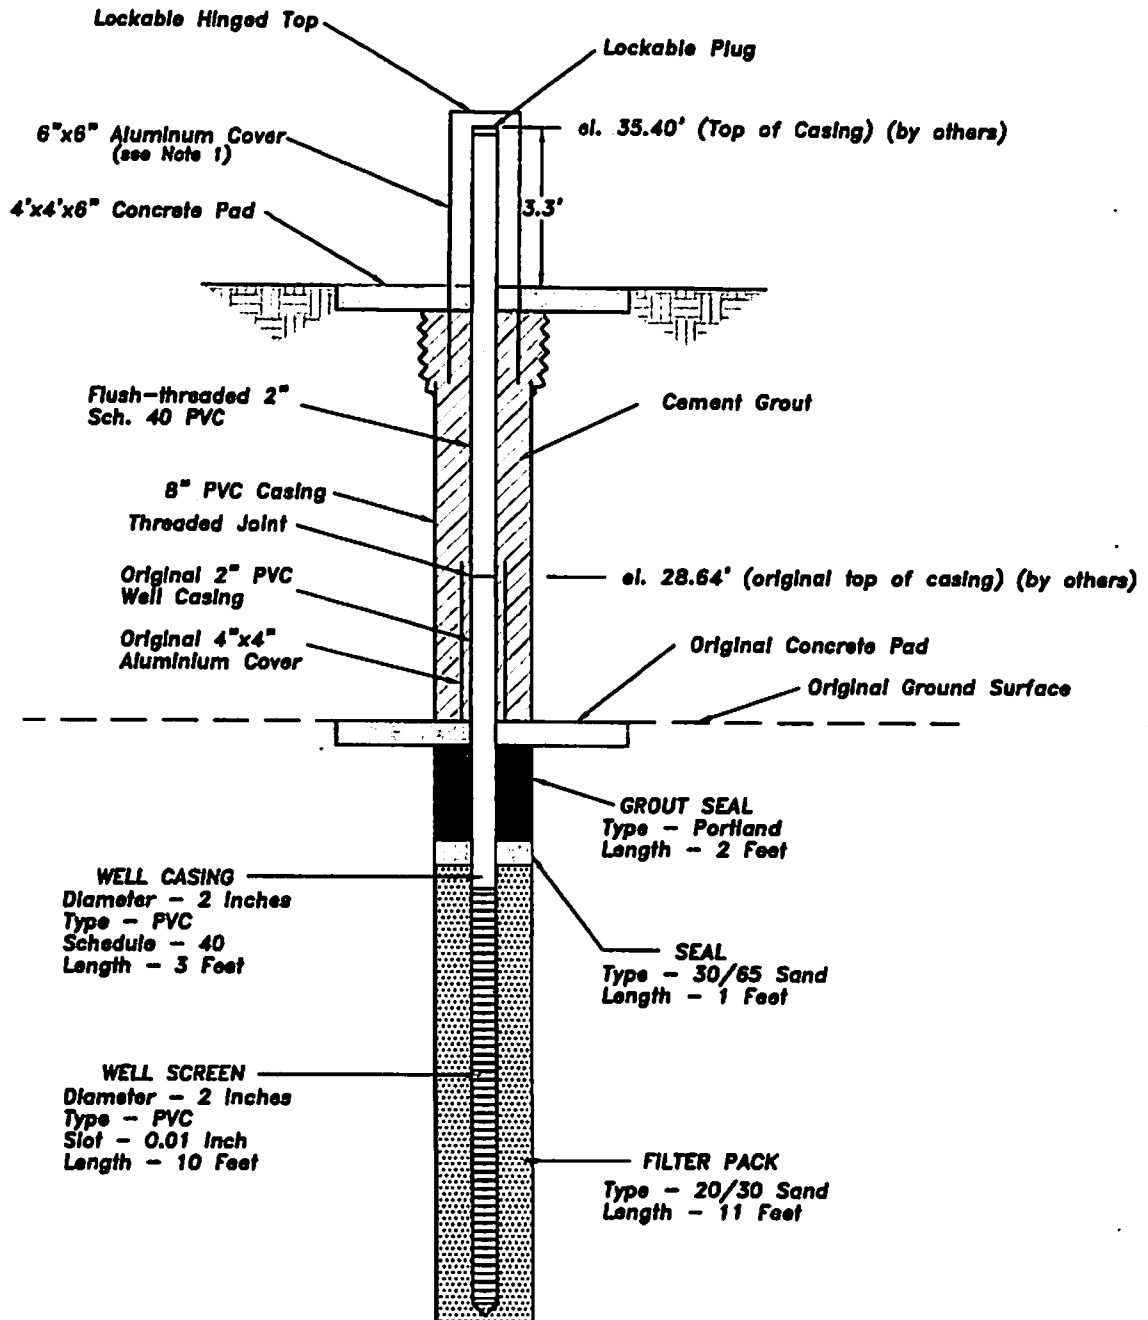

APPENDIX I




NOTES:

1. Bottom saw-cut at corners and sides flared-out as necessary to fit over 8" PVC casing and previous grout.
2. All below original ground surface by others. Information provided by others.

VERTICAL SCALE: 1"=4'
HORIZONTAL SCALE: EXAGGERATED

 Ardaman & Associates, Inc. Geotechnical, Environmental and Materials Consultants			
Monitor Well MW-8A CCSWDC Sarasota County, Florida			
DRAWN BY: KGS	CHECKED BY:	DATE: 9/17/12	
FILE NO. 09-7375	APPROVED BY: 	PLOTTED:	W-1

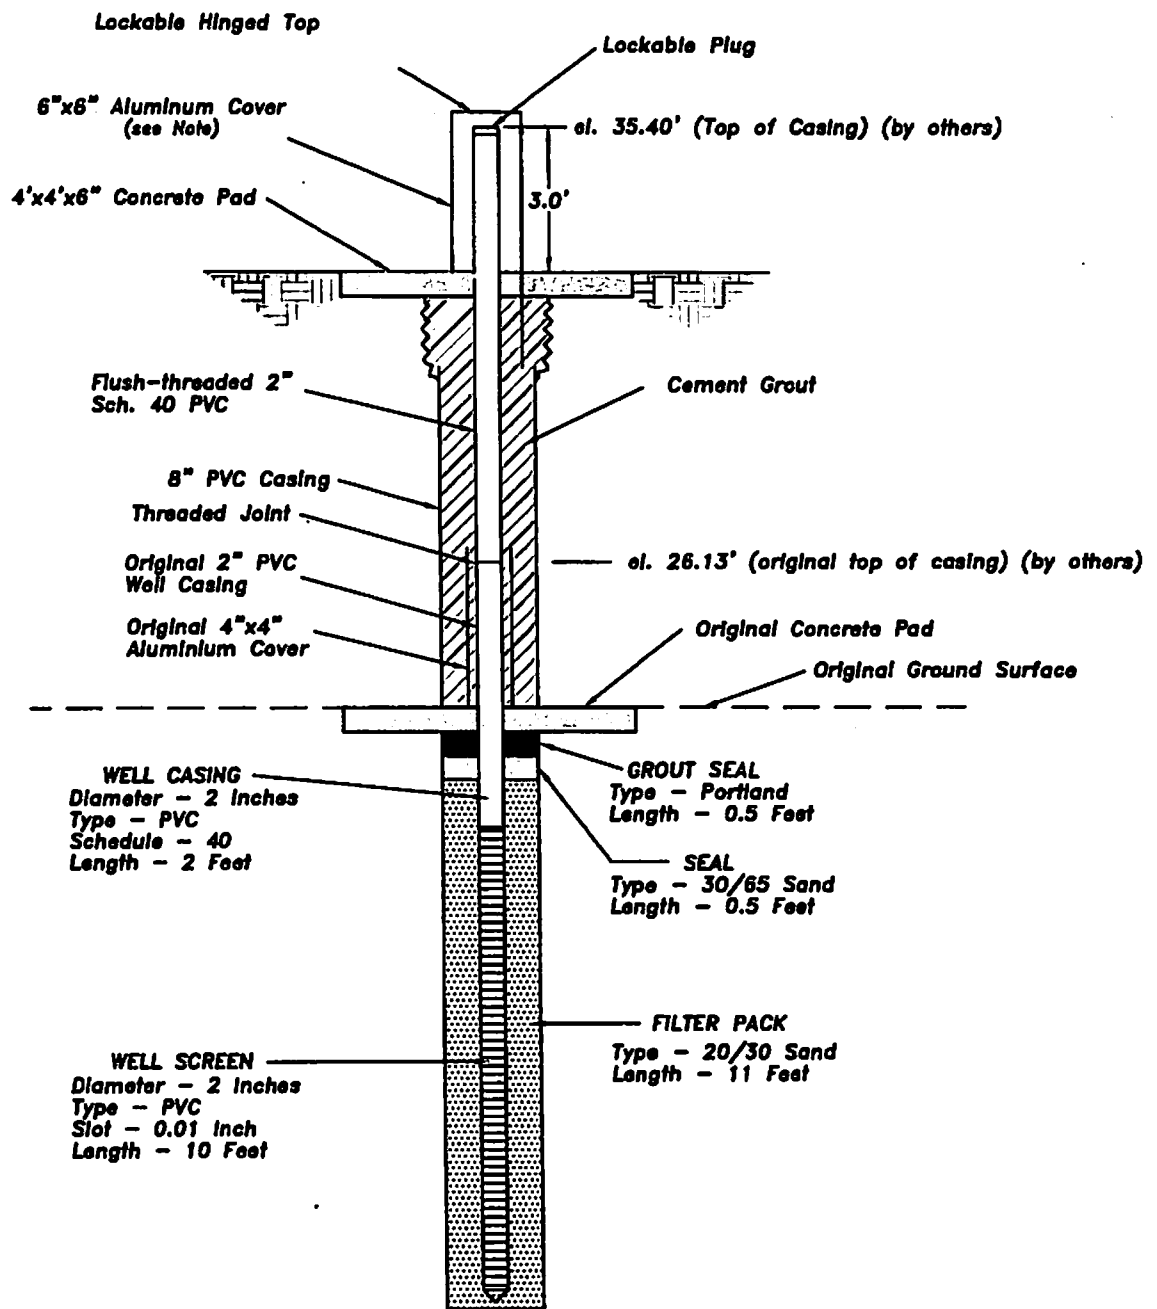

NOTES:

1. Bottom saw-cut at corners and sides flared-out as necessary to fit over 8" PVC casing and previous grout.
2. All below original ground surface by others. Information provided by others.

VERTICAL SCALE: 1"=4'
HORIZONTAL SCALE: EXAGGERATED

Ardaman & Associates, Inc. Geotechnical, Environmental and Materials Consultants			
Monitor Well CW-8A CCSWDC Sarasota County, Florida			
DESIGN BY	KGS	CHECKED BY	DATE 9/17/12
FILE NO.	09-7375	APPROVED BY	FIGURE W-2

APPENDIX II



STATE OF FLORIDA PERMIT APPLICATION TO CONSTRUCT,
REPAIR, MODIFY, OR ABANDON A WELL

- ☒ Southwest
☐ Northwest
☐ St. Johns River
☐ South Florida
☐ Suwannee River
☐ DEP

☒ Delegated Authority (If Applicable) SARASOTA

PLEASE FILL OUT ALL APPLICABLE FIELDS
(*Denotes Required Fields Where Applicable)

The water well contractor is responsible for completing
this form and forwarding the permit application to the
appropriate delegated authority where applicable.

Permit No. 821716
Florida Unique ID S12-281
Permit Stipulations Required (See Attached)
01.39.54
62-524 Quad No. Q2820 Detention No. _____
CUPWUP Application No. _____

ABOVE THIS LINE FOR OFFICIAL USE ONLY

1. Sarasota County OFFICE OF MGMT AND BUDGE SARASOTA FL 34230-0008
*Owner, Legal Name if Corporation *Address *City *State *ZIP *Telephone Number

2. 4000 KNIGHTS TRAIL RD
*Well Location - Address, Road Name or Number, City N/A

3. 0327-00-1000
*Parcel ID No. (PIN) or Alternate Key (Circle One) Lot Block Unit

4. 3 38 19 SARASOTA Subdivision Check if 62-524: Yes X No
*Section or Land Grant *Township *Range *County

5. Daniel Peace 9418 (941)922-3526 dpeace@ardaman.com
*Water Well Contractor *License Number *Telephone Number E-mail Address

6. 78 SARASOTA CENTER BLVD SARASOTA FL 34240
*Water Well Contractor's Address City State ZIP

7. *Type of Work: Construction X Repair Modification Abandonment
*Number of Proposed Wells 1 Reason for Repair, Modification, or Abandonment

9. *Specify Intended Use(s) of Well(s):
Domestic Landscape Irrigation Agricultural Irrigation Site Investigation
Bottled Water Supply Recreation Area Irrigation Livestock Monitoring
Public Water Supply (Limited Use/DOH) Nursery Irrigation Test
Public Water Supply (Community or Non-Community/DEP) Commercial/Industrial Earth-Coupled Geothermal
Class I Injection Golf Course Irrigation HVAC Supply
Class V Injection Recharge Commercial/Industrial Disposal Aquifer Storage and Recovery Drainage
Remediation Recovery Air Sparge Other (Describe) Other (Describe) REPAIR IRRIGATION
(Note: Not all types of wells are permitted by a given permitting authority)

10. *Distance from Septic System if ≤ 200 ft. 1,000 11. Facility Description Landfill monitor wells 12. Estimated Start Date 08/01/2012

13. *Estimated Well Depth 20 ft. *Estimated Casing Depth 20 ft. *Primary Casing Diameter 2 in. Open Hole: From 20 To 20 ft.

14. Estimated Screen Interval: From 20 To 20 ft.

15. *Primary Casing Material: Black Steel Galvanized X PVC Stainless Steel
Not Cased Other

16. Secondary Casing: Telescope Casing Liner Surface Casing Diameter 2 in.

17. Secondary Casing Material: Black Steel Galvanized PVC Stainless Steel Other

18. *Method of Construction, Repair, or Abandonment: X Auger Cable Tool Jetted Rotary Sonic
Combination (Two or More Methods) Hand Driven (Well Point, Sand Point) Hydraulic Point (Direct Push)
Horizontal Drilling Plugged by Approved Method Other (Describe)

19. Proposed Grouting Interval for the Primary, Secondary, and Additional Casing:

20. Indicate total number of existing wells on site 20 List number of existing unused wells on site 0

21. *Is this well or any existing well or water withdrawal on the owner's contiguous property covered under a Consumptive/Water Use Permit (CUP/WUP) or CUP/WUP Application? Yes X No If yes, complete the following: CUP/WUP No. _____ District Well ID No. _____

22. Latitude 27 12 03.25 Longitude 82 23 11.61

23. Data Obtained From: GPS X Map Survey Datum: NAD 27 X NAD 83 WGS 84

Date Stamp
Received:
May 29, 2012 1:24 pm
Official Use Only

Digitally Signed _____ 9418 Digitally Signed _____ 6/1/2012
Signature of Contractor License No. Signature of Owner or Agent Date

DO NOT WRITE BELOW THIS LINE - FOR OFFICIAL USE ONLY

Approval Granted By Sam Hanna STATUS: ISSUED Issue Date 08/01/2012 Expiration Date 08/30/2012 Hydrologist Approval _____
Fee Received \$ 150.00 Receipt No. 8276510 Check No. _____

THIS PERMIT IS NOT VALID UNTIL PROPERLY SIGNED BY AN AUTHORIZED OFFICER OR REPRESENTATIVE OF THE WMD OR DELEGATED AUTHORITY. THE PERMIT SHALL BE AVAILABLE AT THE WELL SITE DURING ALL CONSTRUCTION, REPAIR, MODIFICATION, OR ABANDONMENT ACTIVITIES.

SOUTHWEST FLORIDA WATER MANAGEMENT DISTRICT
2379 BROAD STREET, BROOKSVILLE, FL 34604-6899
PHONE: (352) 796-7211 or (800) 423-1476
WWW.SFWMD.STATE.FL.US

ST. JOHNS RIVER WATER MANAGEMENT DISTRICT
4049 REID STREET, PALATKA, FL 32178-1429
PHONE: (386) 329-4500
WWW.SJRWMD.COM

NORTHWEST FLORIDA WATER MANAGEMENT DISTRICT
152 WATER MANAGEMENT DR., HAVANA, FL 32333-4712
(U.S. Highway 90, 10 miles west of Tallahassee)
PHONE: (850) 539-5999
WWW.NFWMD.STATE.FL.US

SOUTH FLORIDA WATER MANAGEMENT DISTRICT
P.O. BOX 24680
3301 GUN CLUB ROAD
WEST PALM BEACH, FL 33416-4680
PHONE: (561) 686-8800
WWW.SFWMD.GOV

SUWANNEE RIVER WATER MANAGEMENT DISTRICT
9225 CR 49
LIVE OAK, FL 32060
PHONE: (386) 362-1001 or (800) 226-1066 (Florida only)
WWW.MYSUWANNEERIVER.COM

Comments:

Extending above ground casing an additional 10' to allow filling/raising the ground around the well.

General Site Map of Proposed Well Location

Monitor well MW-8A.



Identify known roads and landmarks. Give distances from all reference points or structures, septic systems, sanitary hazards, and contamination sources, if applicable.



STATE OF FLORIDA PERMIT APPLICATION TO CONSTRUCT,
REPAIR, MODIFY, OR ABANDON A WELL

- ☒ Southwest
☐ Northwest
☐ St. Johns River
☐ South Florida
☐ Suwannee River
☐ DEP

☒ Delegated Authority (If Applicable) SARASOTA

PLEASE FILL OUT ALL APPLICABLE FIELDS
(*Denotes Required Fields Where Applicable)

The water well contractor is responsible for completing
this form and forwarding the permit application to the
appropriate delegated authority where applicable.

Permit No. 821720

Florida Unique ID S12-270

Permit Stipulations Required (See Attached)

01.39.54

G2-524 Quad No. Q2620 Delineation No. _____

CUPWUP Application No. _____

ABOVE THIS LINE FOR OFFICIAL USE ONLY

1. Sarasota County OFFICE OF MNGMT AND BUDGE SARASOTA FL 34230-0008
*Owner, Legal Name if Corporation *Address *City *State *ZIP *Telephone Number

2. 4000 KNIGHTS TRAIL RD
*Well Location - Address, Road Name or Number, City N/A

3. 0327-00-1000
*Parcel ID No. (PIN) or Alternate Key (Circle One) Lot Block Unit

4. 3 38 19 SARASOTA Subdivision Check if G2-524: Yes X No
*Section or Land Grant *Township *Range *County

5. Daniel Peaco 9418 (941) 922-3526 dpeaco@ardaman.com
*Water Well Contractor *License Number *Telephone Number E-mail Address

6. 78 SARASOTA CENTER BLVD
*Water Well Contractor's Address SARASOTA FL 34240
City State ZIP

7. *Type of Work: Construction X Repair Modification Abandonment

8. *Number of Proposed Wells 1

9. *Specify Intended Use(s) of Well(s):
Domestic Landscape Irrigation Agricultural Irrigation Site Investigation
Bottled Water Supply Recreation Area Irrigation Livestock Monitoring
Public Water Supply (Limited Use/DOH) Nursery Irrigation Test
Public Water Supply (Community or Non-Community/DEP) Commercial/Industrial Earth-Coupled Geothermal
Class I Injection Golf Course Irrigation HVAC Supply
Class V Injection: Recharge Commercial/Industrial Disposal Aquifer Storage and Recovery Drainage
Remediation: Recovery Air Sparge Other (Describe)
X Other (Describe) REPAIR IRRIGATION (Note: Not all types of wells are permitted by a given permitting authority)

10. *Distance from Septic System If ≤ 200 ft. 1,000 11. Facility Description Landfill monitor wells 12. Estimated Start Date 06/01/2012

13. *Estimated Well Depth 20 ft. *Estimated Casing Depth _____ ft. *Primary Casing Diameter 2 in. Open Hole: From _____ To _____ ft.

14. Estimated Screen Interval: From _____ To _____ ft.

15. *Primary Casing Material: Black Steel Galvanized X PVC Stainless Steel
Not Cased Other:

16. Secondary Casing: Telescope Casing Liner Surface Casing Diameter _____ in.

17. Secondary Casing Material: Black Steel Galvanized PVC Stainless Steel Other

18. *Method of Construction, Repair, or Abandonment: X Auger Cable Tool Jettied Rotary Sonic
Combination (Two or More Methods) Hand Driven (Well Point, Sand Point) Hydraulic Point (Direct Push)
Horizontal Drilling Plugged by Approved Method Other (Describe)

19. Proposed Grouting Interval for the Primary, Secondary, and Additional Casing:
From _____ To _____ Seal Material (Bentonite Neat Cement Other)
From _____ To _____ Seal Material (Bentonite Neat Cement Other)
From _____ To _____ Seal Material (Bentonite Neat Cement Other)
From _____ To _____ Seal Material (Bentonite Neat Cement Other)

20. Indicate total number of existing wells on site 20 List number of existing unused wells on site 0

21. *Is this well or any existing well or water withdrawal on the owner's contiguous property covered under a Consumptive/Water Use Permit (CUP/WUP) or CUP/WUP Application? Yes X No If yes, complete the following: CUP/WUP No. _____ District Well ID No. _____

22. Latitude 27 12 03.03 Longitude 82 23 12.26

23. Data Obtained From: GPS X Map Survey Datum: NAD 27 X NAD 83 WGS 84

I hereby certify that I will comply with the applicable rules of Title 40, Florida Administrative Code, and that I will obtain a permit or other approval from the appropriate authority, if needed, prior to construction of the well. I further certify that all information provided in this application is accurate and that I will obtain necessary approval from other federal, state, or local governments, if applicable. I agree to provide a well completion report to the District within 30 days after completion of the construction, repair, modification, or abandonment authorized by this permit, or the permit expiration, whichever occurs first.

I certify that I am the owner of the property, that the information provided is accurate, and that I am aware of my responsibilities under Chapter 373, Florida Statute, to maintain or properly abandon this well, or, I certify that I am the agent for the owner, that the information provided is accurate, and that I have informed the owner of his responsibilities as stated above. Owner consents to allowing personnel of this WMD or Delegated Authority access to the well site during the construction, repair, modification, or abandonment authorized by this permit.

Digitally Signed

*Signature of Contractor

9418

*License No.

Digitally Signed

*Signature of Owner or Agent

6/1/2012

*Date

DO NOT WRITE BELOW THIS LINE - FOR OFFICIAL USE ONLY

Approval Granted By Sam Hanna STATUS: ISSUED

Issue Date 08/01/2012

Expiration Date 08/30/2012

Hydrologist Approval _____

Fee Received \$150.00

Receipt No. 8276641

Check No. _____

THIS PERMIT IS NOT VALID UNTIL PROPERLY SIGNED BY AN AUTHORIZED OFFICER OR REPRESENTATIVE OF THE WMD OR DELEGATED AUTHORITY. THE PERMIT SHALL BE AVAILABLE AT THE WELL SITE DURING ALL CONSTRUCTION, REPAIR, MODIFICATION, OR ABANDONMENT ACTIVITIES.

SOUTHWEST FLORIDA WATER MANAGEMENT DISTRICT
2379 BROAD STREET, BROOKSVILLE, FL 34604-6899
PHONE: (352) 796-7211 or (800) 423-1476
WWW.SWFWMD.STATE.FL.US

ST. JOHNS RIVER WATER MANAGEMENT DISTRICT
4049 REID STREET, PALATKA, FL 32178-1429
PHONE: (386) 329-4500
WWW.SJRWMD.COM

NORTHWEST FLORIDA WATER MANAGEMENT DISTRICT
152 WATER MANAGEMENT DR., HAVANA, FL 32333-4712
(U.S. Highway 90, 10 miles west of Tallahassee)
PHONE: (850) 539-5999
WWW.NWFWMD.STATE.FL.US

SOUTH FLORIDA WATER MANAGEMENT DISTRICT
P.O. BOX 24680
3301 GUN CLUB ROAD
WEST PALM BEACH, FL 33416-4680
PHONE: (561) 886-8800
WWW.SFWMD.GOV

SUWANNEE RIVER WATER MANAGEMENT DISTRICT
9225 CR 49
LIVE OAK, FL 32080
PHONE: (386) 362-1001 or (800) 226-1066 (Florida only)
WWW.MYSUWANNEERIVER.COM

Comments:

Monitor Well CW-8A. Extending above ground casing an additional 10' to allow filling/raising the ground around the
well.

General Site Map of Proposed Well Location

Along south side of access road on south side of landfill Phase 1 area.




Identify known roads and landmarks. Give distances from all reference points or structures, septic systems, sanitary hazards, and contamination sources, if applicable.

ATTACHMENT B

ATTACHMENT C

PHASE I

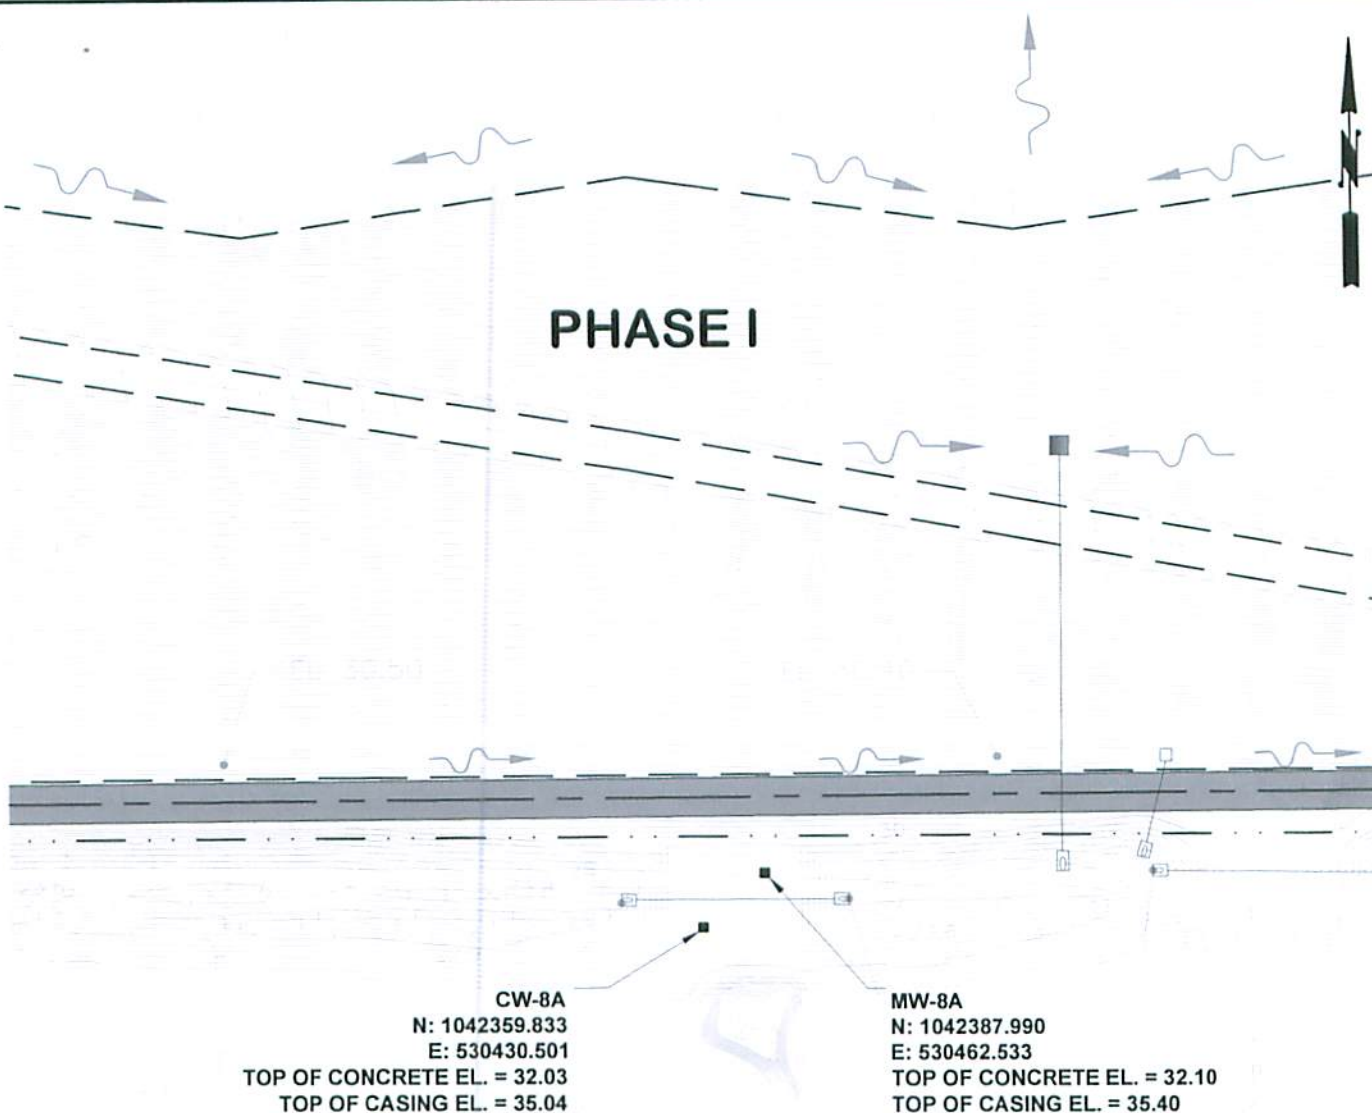

SURVEYOR'S NOTES:

1. THE PURPOSE OF THIS SURVEY IS TO SHOW THE HORIZONTAL AND VERTICAL LOCATIONS OF THE MONITORING WELLS CW-8A AND MW-8A FOR THE PHASE I AREA FOR THE PHASE I CLASS I LANDFILL CLOSURE AND LANDFILL GAS COLLECTION SYSTEM PROJECT FOR SARASOTA COUNTY.
2. COORDINATES BASED ON FLORIDA STATE PLANE WEST ZONE, NORTH AMERICAN DATUM, 1983 ADJUSTMENT.
3. ELEVATIONS BASED ON NATIONAL GEODETIC VERTICAL DATUM 1929 AND ARE BASED ON BENCHMARK INFORMATION PROVIDED BY HDR ENGINEERING, INC. AND SHOWN IN CONSTRUCTION PLANS FOR THE PHASE I CLASS I LANDFILL CLOSURE AND LANDFILL GAS COLLECTION SYSTEM PROJECT FOR SARASOTA COUNTY, AS TEMPORARY BENCHMARKS.
4. ELEVATIONS AND COORDINATES PERTAIN ONLY TO THE MONITORING WELLS AND SHOULD NOT BE USED AS CONTROL.

ABBREVIATIONS:

CW	COMPLIANCE WELL
E	EASTING
EL	ELEVATION
MW	MONITORING WELL
N	NORTHING



DATE: 10-2-12

LAYOUT SERVICES, INC.
3380 S PARK AVE STE 7
TITUSVILLE, FL 32780
(321) 759-2779
(321) 264-9748 (FAX)

UNLESS IT BEARS THE SIGNATURE AND ORIGINAL RAISED SEAL OF A FLORIDA LICENSED SURVEYOR AND MAPPER THIS DRAWING, SKETCH, PLAT OR MAP IS FOR INFORMATIONAL PURPOSES ONLY AND IS NOT VALID.

I hereby certify that the survey shown hereon is true and correct to the best of my knowledge and belief, based on actual measurements taken in the field. This survey meets the Minimum Technical Standards as set forth by the Florida Board of Professional Land Surveyors in Chapter 6J-17, Florida Administrative Code, pursuant to Section 472.027, Florida Statutes.

James Zimmerman
Professional Land Surveyor No. 6545
State of Florida

SPECIFIC PURPOSE SURVEY
CW-8A AND MW-8A MONITORING WELLS
CENTRAL COUNTY SOLID WASTE
DISPOSAL COMPLEX
SARASOTA COUNTY, FLORIDA

Florida Department of Environmental Protection
Twin Towers Office Bldg. 2600 Blair Stone Road Tallahassee, Florida 32399-2400

DEP Form # 62-522.900(3)
Form Title <u>MONITOR WELL COMPLETION REPORT</u>
Effective Date _____
DEP Application No. _____ (Filled in by DEP)

MONITOR WELL COMPLETION REPORT

DATE: 1/7/08 *Revised 10/12/12*

INSTALLATION NAME: Sarasota County Central Complex

DEP PERMIT NUMBER: 130542-002-SO/01 GMS NUMBER: _____

WELL NUMBER: CW-8A (WACS #22883) WELL NAME: CW-8A

DESIGNATION: Background _____ Immediate _____ Compliance X

LATITUDE/LONGITUDE: Lat: 27° 12' 02.89" Lon: 82° 23' 12.59"

AQUIFER MONITORED: Surficial

INSTALLATION METHOD: Hollow-stem auger

INSTALLED BY: PBS&J/CDP Drilling, Inc.

TOTAL DEPTH: 12' (bls) DEPTH OF SCREEN: 2-12' (bls)

SCREEN LENGTH: 10' SCREEN SLOT SIZE: 0.01" SCREEN TYPE: PVC

CASING DIAMETER: 2" CASING TYPE: PVC

LENGTH OF CASING: 5" FILTER PACK MATERIAL: 20/30 grade sand

TOP OF CASING ELEVATION (MSL): ~~-26.132'~~ 35.04' (revised 10/2/2012) JT Sarasota Co.
(See Corr dated 10/12/12)

GROUND SURFACE ELEVATION (MSL): NA

COMPLETION DATE: 1/7/08

DESCRIBE WELL DEVELOPMENT: Used centrifugal pump to purge water from well at a rate of approximately ¼ GPM. Purged water until relatively clear of sediment.

POST DEVELOPMENT WATER LEVER ELEVATION (MSL): 16.6'

DATE AND TIME MEASURED: 1/8/08 - 1300

REMARKS: (soils information, stratigraphy, etc.): See boring log.

REPORT PREPARED BY: Greg Mudd, P.G., PBS&J, (407) 806-4339
(name, company, phone number)

NOTE: PLEASE ATTACH BORING LOG.

(bls)= Below Land Surface



Florida Department of Environmental Protection

Bob Martinez Center
2600 Blair Stone Road
Tallahassee, Florida 32399-2400

DEP Form # 62-701 900(30)

Form Title: Monitoring Well Completion Report

Effective Date: January 6, 2010

Incorporated in Rule 62-701 510(3), F.A.C.

MONITORING WELL COMPLETION REPORT

DATE: October 15, 2012

FACILITY NAME: Sarasota County Central County Solid Waste Disposal Complex

DEP PERMIT NO.: 130542-018-SO/MM WACS FACILITY ID NO.: SWD/58/51614

WACS MONITORING SITE NUM.: 21453 WACS WELL NO.: MW-8A

WELL TYPE: BACKGROUND ☐ DETECTION ☒ COMPLIANCE ☐

LATITUDE: 27° 12' 3.1717" LONGITUDE: 82° 23' 12.2417"

(see back for LAT / LONG requirements):

Coordinate Accuracy 0.1 feet Datum NAD 1983 Elevation Datum NGVD 1929

Collection Method Survey Collection Date 10/2/12

Collector Name Layout Services, Inc. Collector Affiliation Construction Surveyor

AQUIFER MONITORED: surficial

DRILLING METHOD: hollow-stem auger DATE INSTALLED: November 2005

INSTALLED BY: Extension installed by Ardaman and Associates, Inc., August 2012.

BORE HOLE DIAMETER: 8 inches TOTAL DEPTH: 20.4 feet (BLS)

CASING TYPE: PVC Sch. 40 CASING DIAMETER: 2 inch CASING LENGTH: 3 feet

SCREEN TYPE: PVC SCREEN SLOT SIZE: 0.01-inch SCREEN LENGTH: 10 feet

SCREEN DIAMETER: 2-inch SCREEN INTERVAL: 3 feet TO 13 feet (BLS)

FILTER PACK TYPE: Sand FILTER PACK GRAIN SIZE: 20/30

INTERVAL COVERED: 3 feet TO 11 feet (BLS)

SEALANT TYPE: Sand 30/65 SEALANT INTERVAL: 2 feet TO 3 feet (BLS)

GROUT TYPE: Portland GROUT INTERVAL: 0 feet TO 2 feet (BLS)

TOP OF CASING ELEVATION (NGVD): 35.40 feet GROUND SURFACE ELEVATION (NGVD): 32.0 feet

DESCRIBE WELL DEVELOPMENT: N/A

POST DEVELOPMENT WATER LEVEL ELEVATION (NGVD): N/A

DATE AND TIME MEASURED: N/A

REMARKS: Well originally constructed in November 2005. In August 2012, well top of casing extended for construction of stormwater swale for Phase I Closure. Survey completed on October 2, 2012.

NAME OF PERSON PREPARING REPORT: Jason Timmons, PE; Sarasota County Solid Waste Operations;

941-861-1572; jtimmons@scgov.net

(Name, Organization, Phone No., E-mail)

Northwest District
160 Government Center
Pensacola, FL 32501-5794
850-595-8380

Northeast District
7825 Baymeadows Way Ste 200B
Jacksonville, FL 32256-7590
904-807-3300

Central District
3319 Maguire Blvd., Ste. 232
Orlando, FL 32803-3767
407-894-7555

Southwest District
13051 N. Telecom Pky.
Tempe Terrace, FL
813-632-7800

South District
2295 Victoria Ave., Ste. 364
Fort Myers, FL 33901-3881
239-332-6975

Southeast District
400 North Congress Ave.
West Palm Beach, FL 33401
561-681-6800