


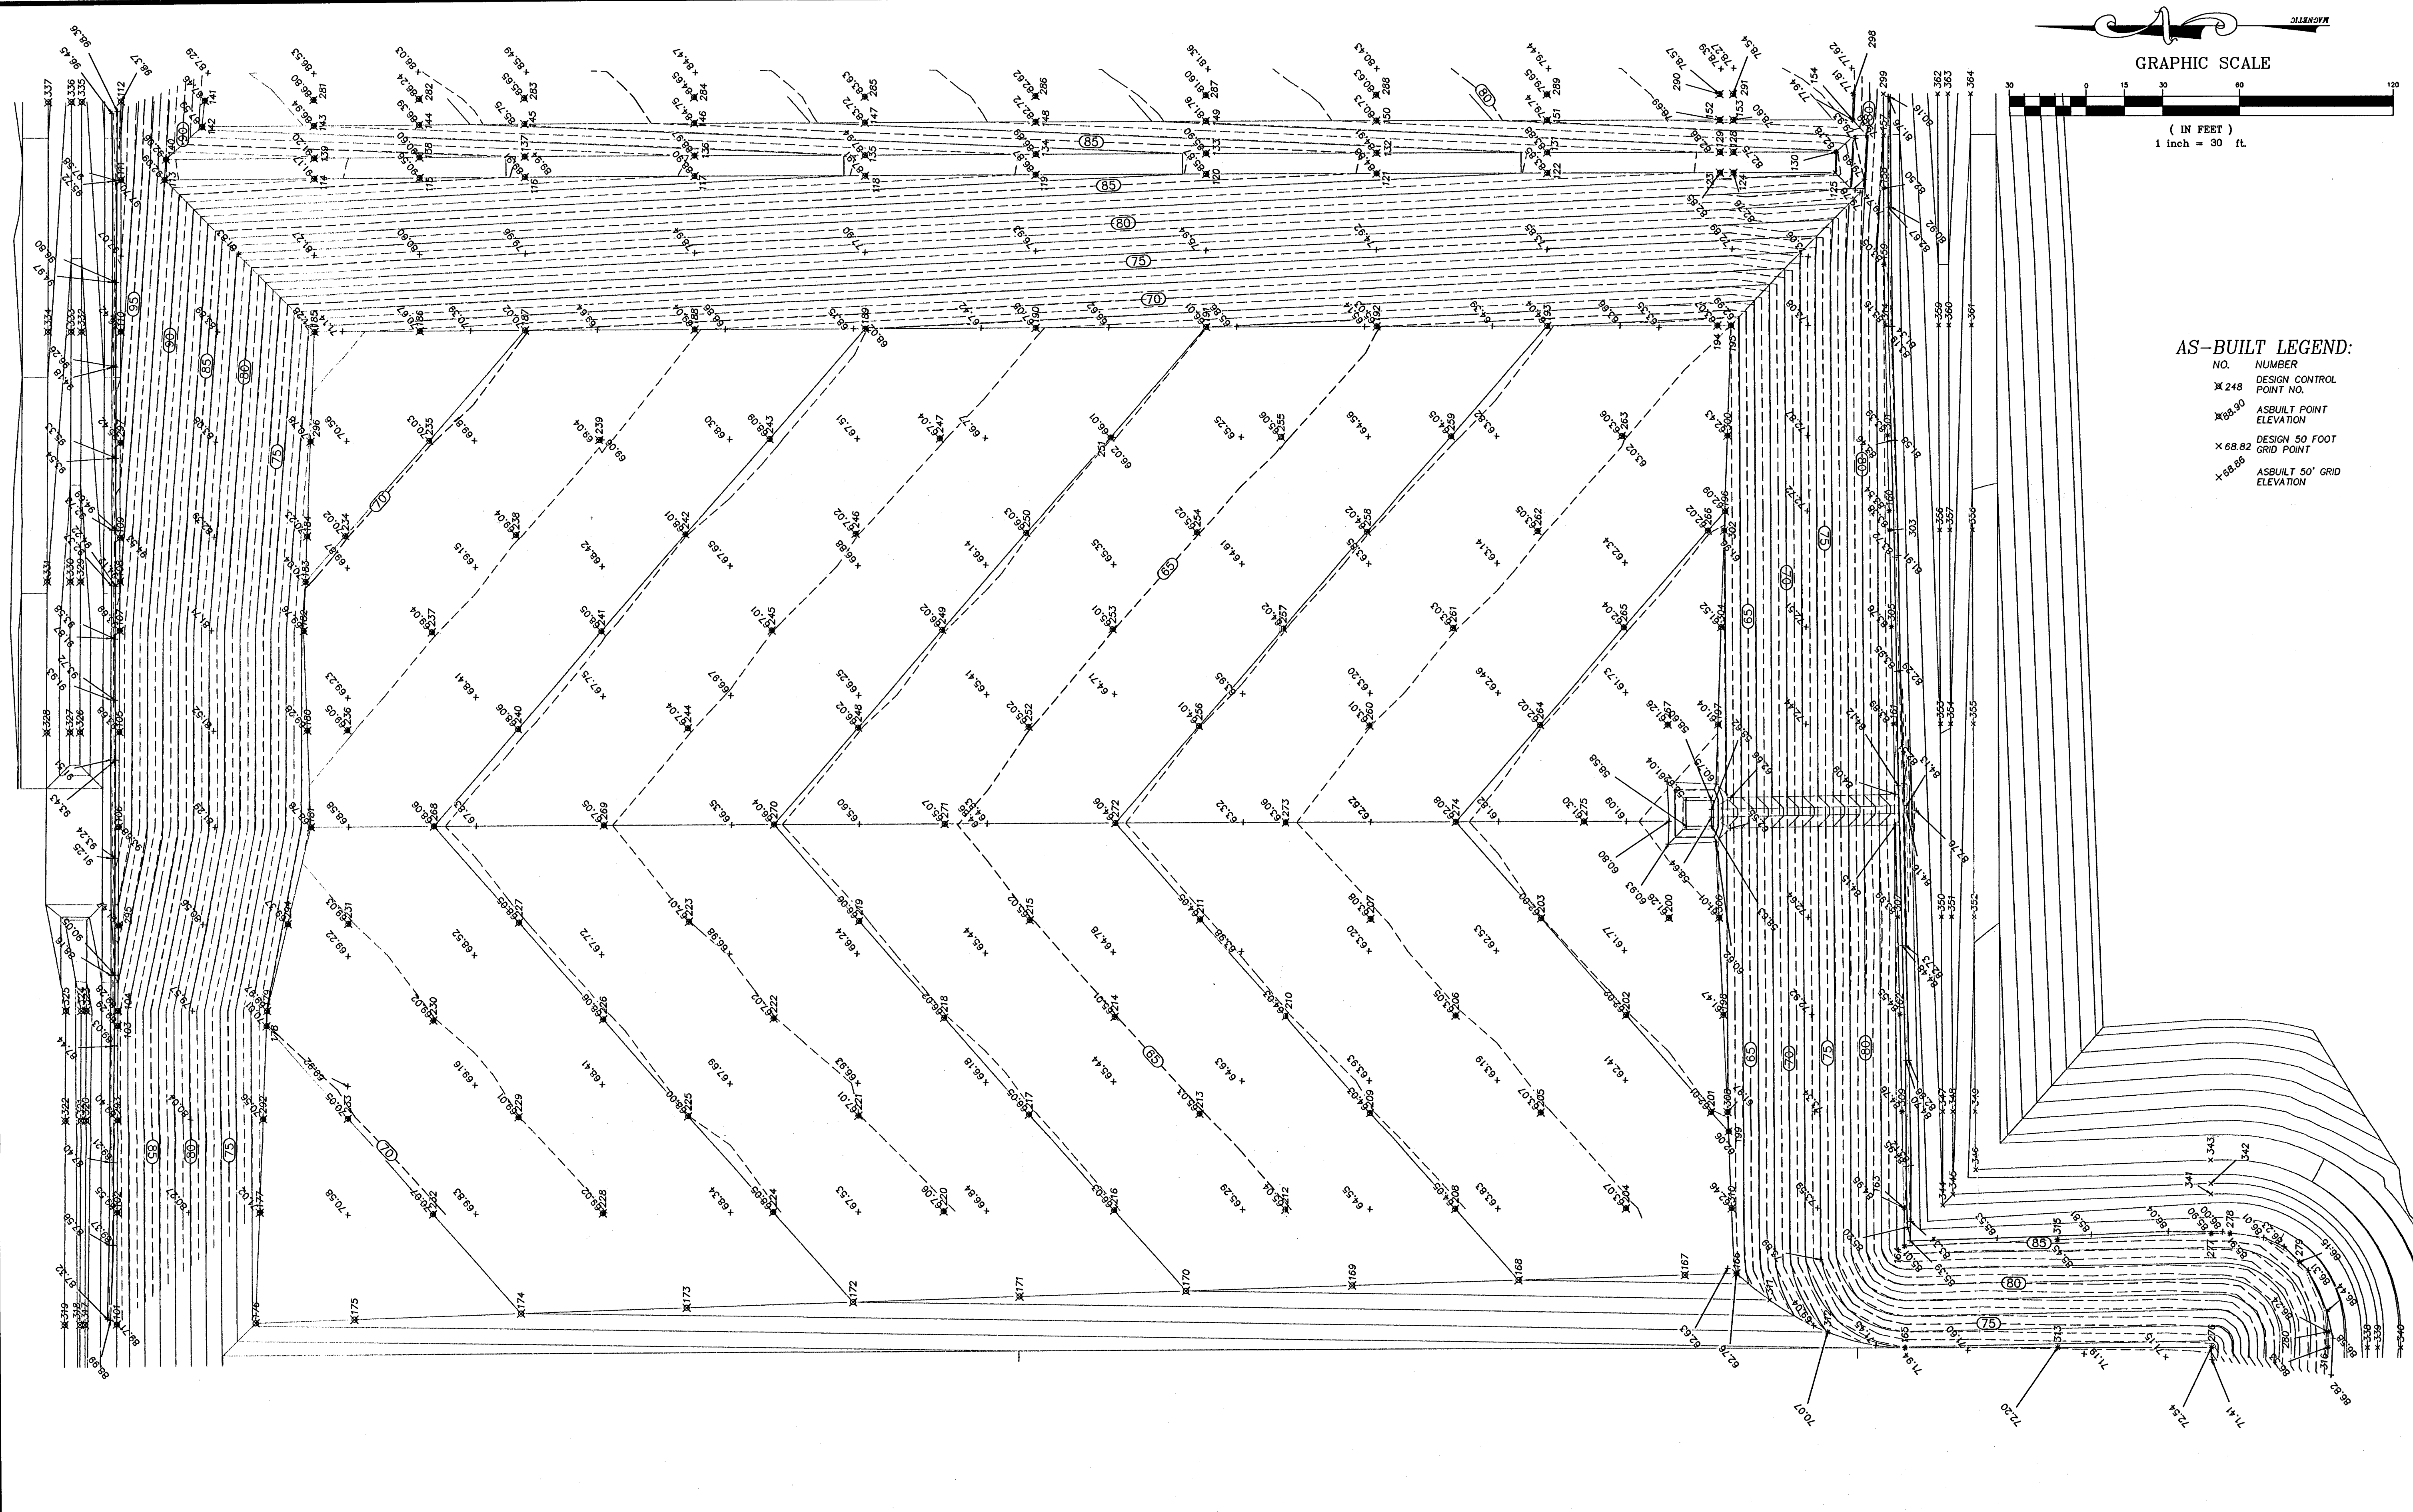

GRAPHIC SCALE

(IN FEET)
1 inch = 30 ft.

AS-BUILT LEGEND:

NO.	NUMBER
X 248	DESIGN CONTROL POINT NO.
X 68.90	ASBUILT POINT ELEVATION
X 68.82	DESIGN 50 FOOT GRID POINT
X 68.86	ASBUILT 50' GRID ELEVATION

AS-BUILT SURVEY VISTA CELL 3 SUB-BASE-CONTROL POINTS

CLIENT:

ERC GENERAL CONTRACTOR
8890 Carter Road Suite 170
Winter Garden, FL 34787

Drawn By:	DLP
Party Chief:	DR
Field Book:	18
Page:	2-26

[illegible]



DEBORAH L. PRAVEY, P.S.M.
FLORIDA REGISTRATION
NUMBER 8345
FLORIDA BUSINESS
NUMBER 7726
9/17-25/2012
SURVEY DATE

SCALE 1"=30'	DRAWING NO. 135
PROJECT NO. 135	SHEET 2

AS-BUILT LEGEND:

NO. NUMBER
OR-18 REPAIR NUMBER
AND LOCATION
XDS-5 R-19 DESTROYED AND REPAIR
NUMBER LOCATION
P-23 PANEL NUMBER
GRID LINE

GRAPHIC SCALE

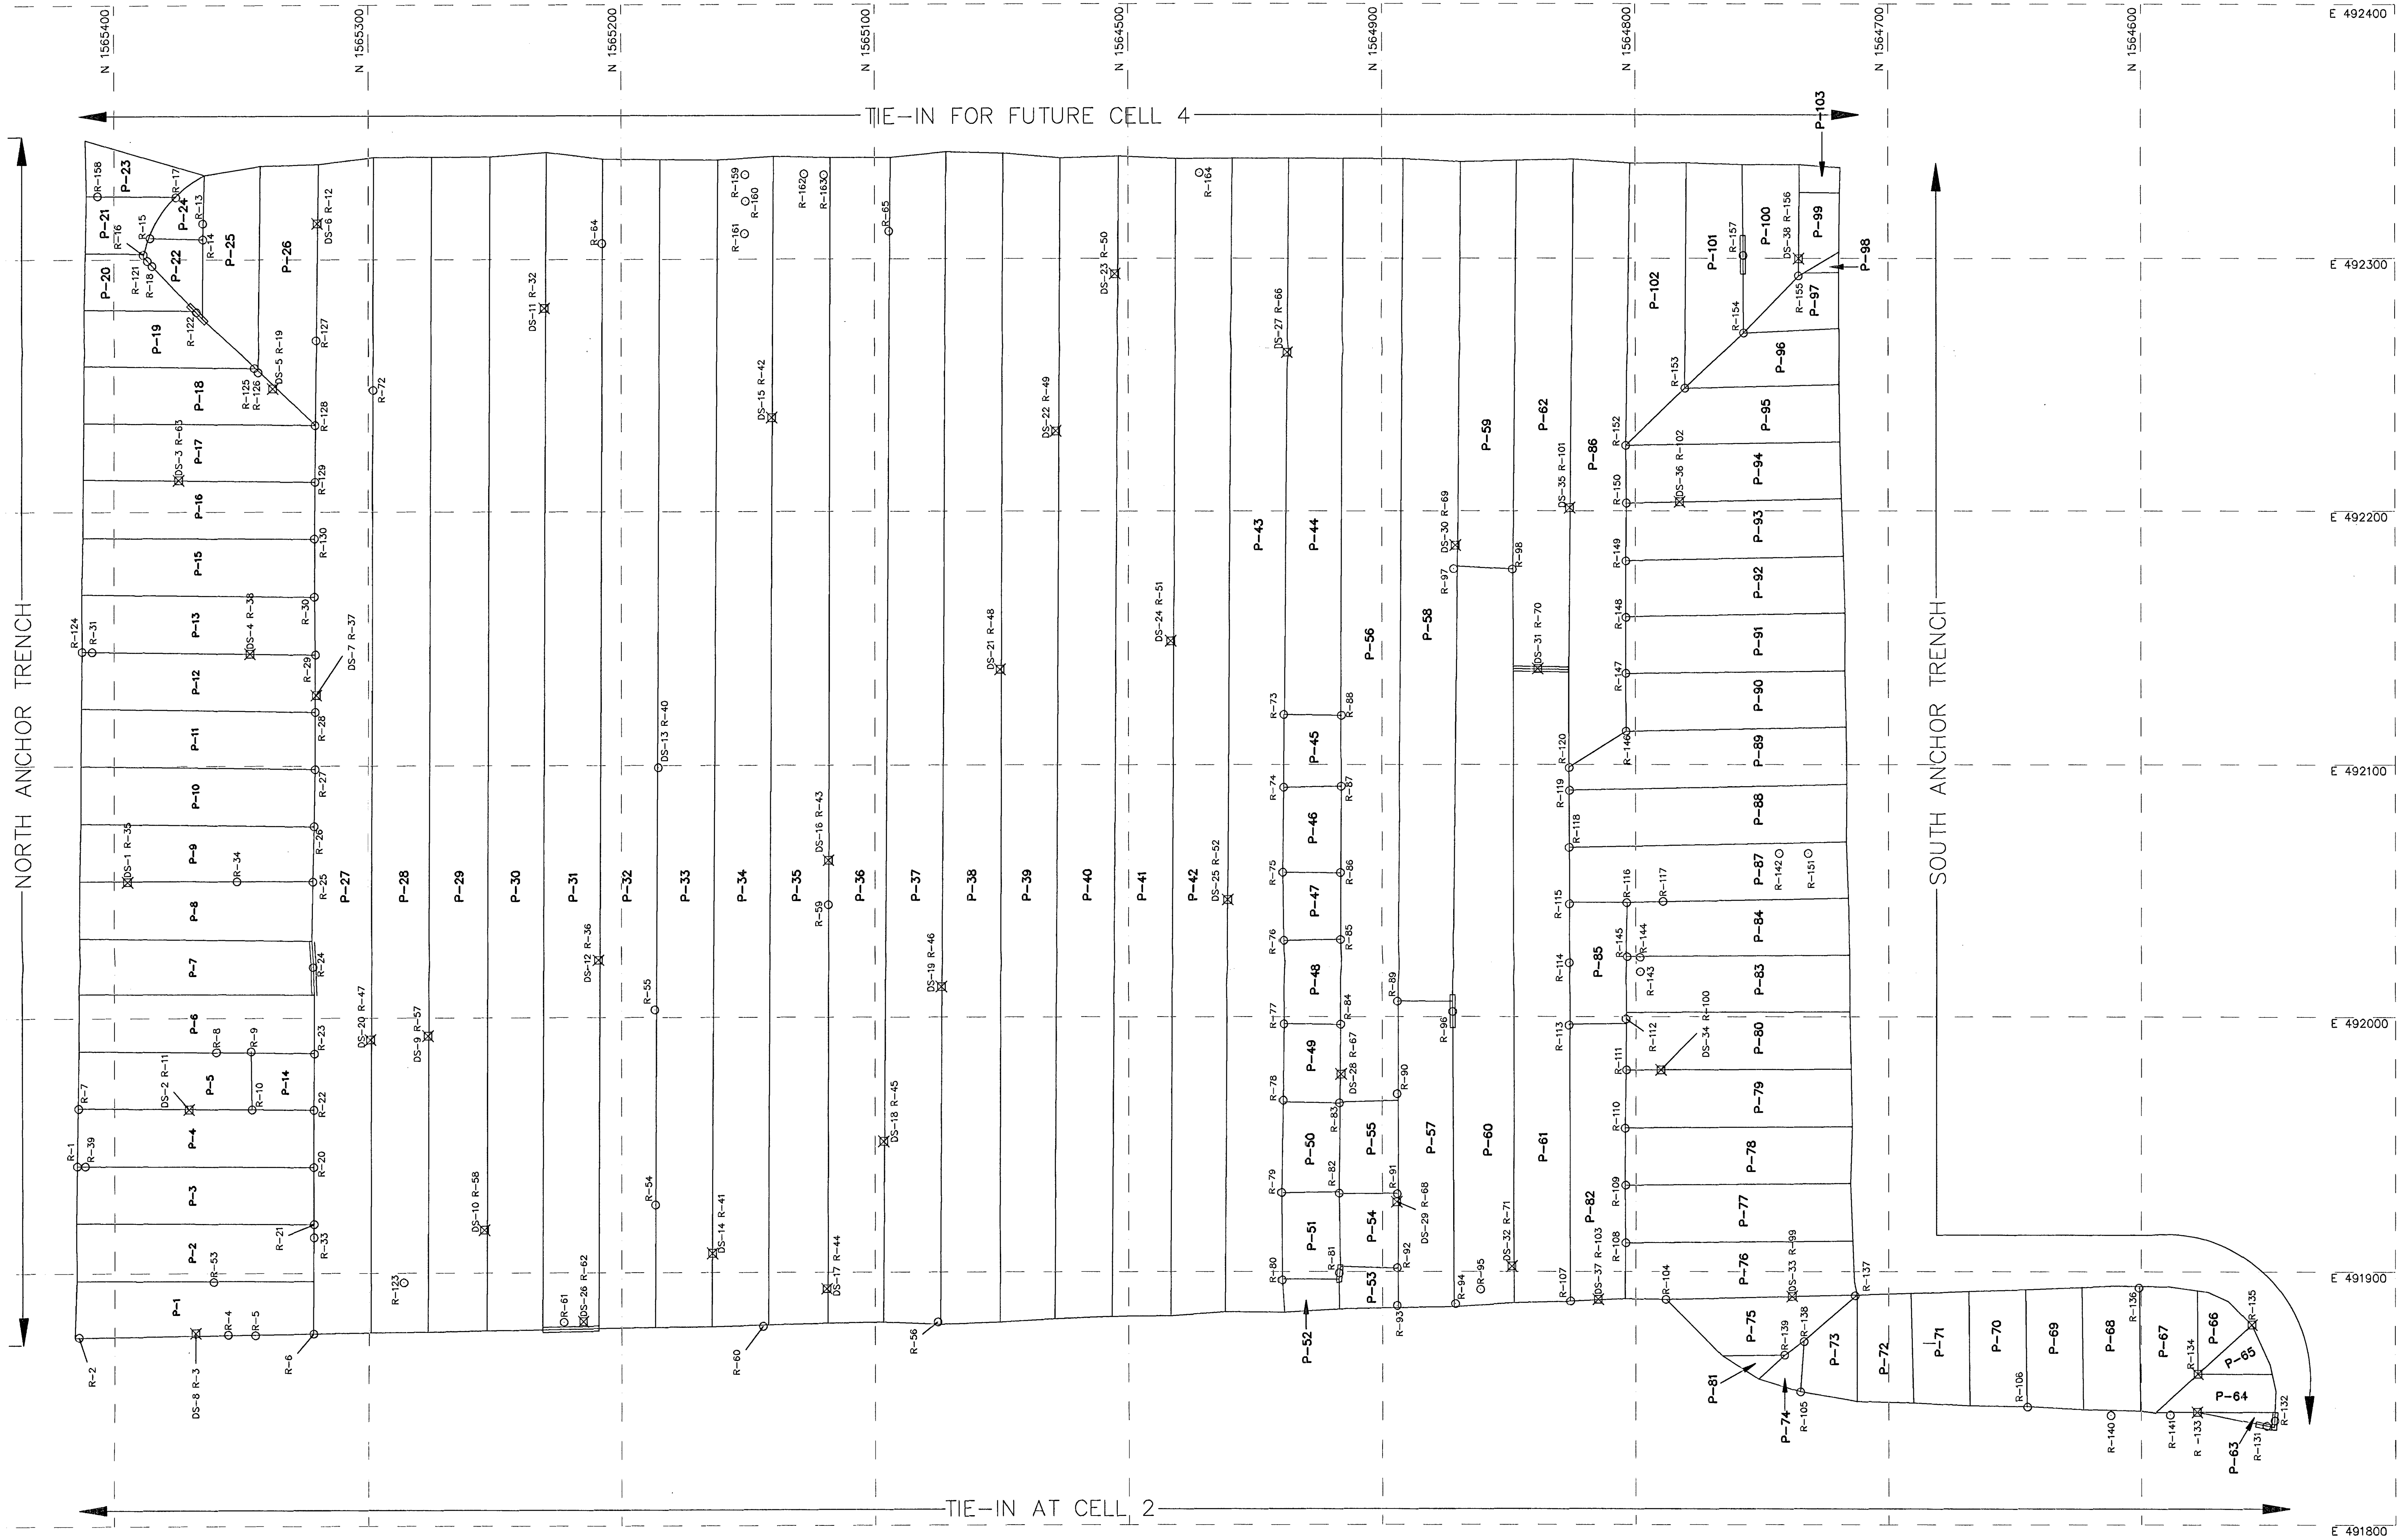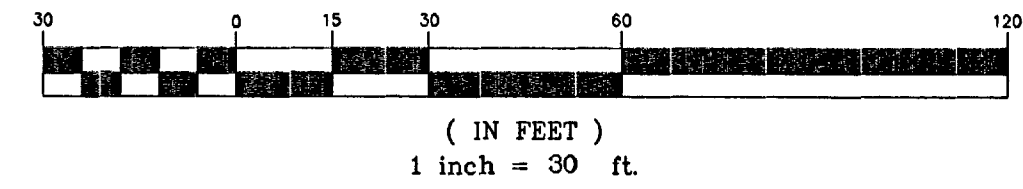

AS-BUILT SURVEY VISTA CELL 3
Geomembrane Panel Record Drawing
KEENE ROAD RECYCLING AND DISPOSAL
FACILITY LOCATED IN APOKA, FL

CLIENT:

ERC GENERAL CONTRACTOR
890 Center Road Suite 170
Winter Garden, FL 34787



Peavey & Associates
SURVEYING & MAPPING PA

690 ALICE PLACE
BARTOW, FL 33830
PHONE: 863-738-4960
FLORIDA BUSINESS NO. 7779



THIS SURVEY IS
NOT VALID WITHOUT
THE SIGNATURE AND
ORIGINAL RAISED
SEAL OF A FLORIDA
LICENSED SURVEYOR
AND MAPPER.

Drawn By: DLP
Party Chief: DR
Field Book: 18
Page: 2-26
FILE NAME: 135_erc_vista_cell_3_ash_liner.dwg

PROJECT NO. 135
SHEET 3

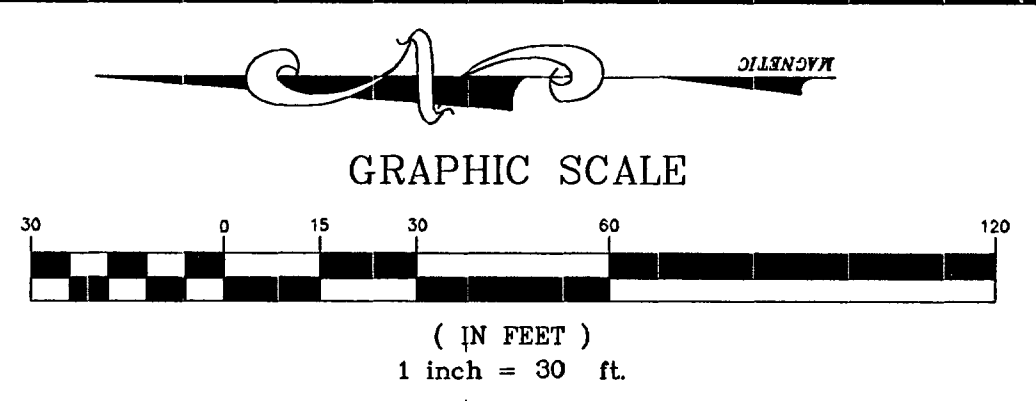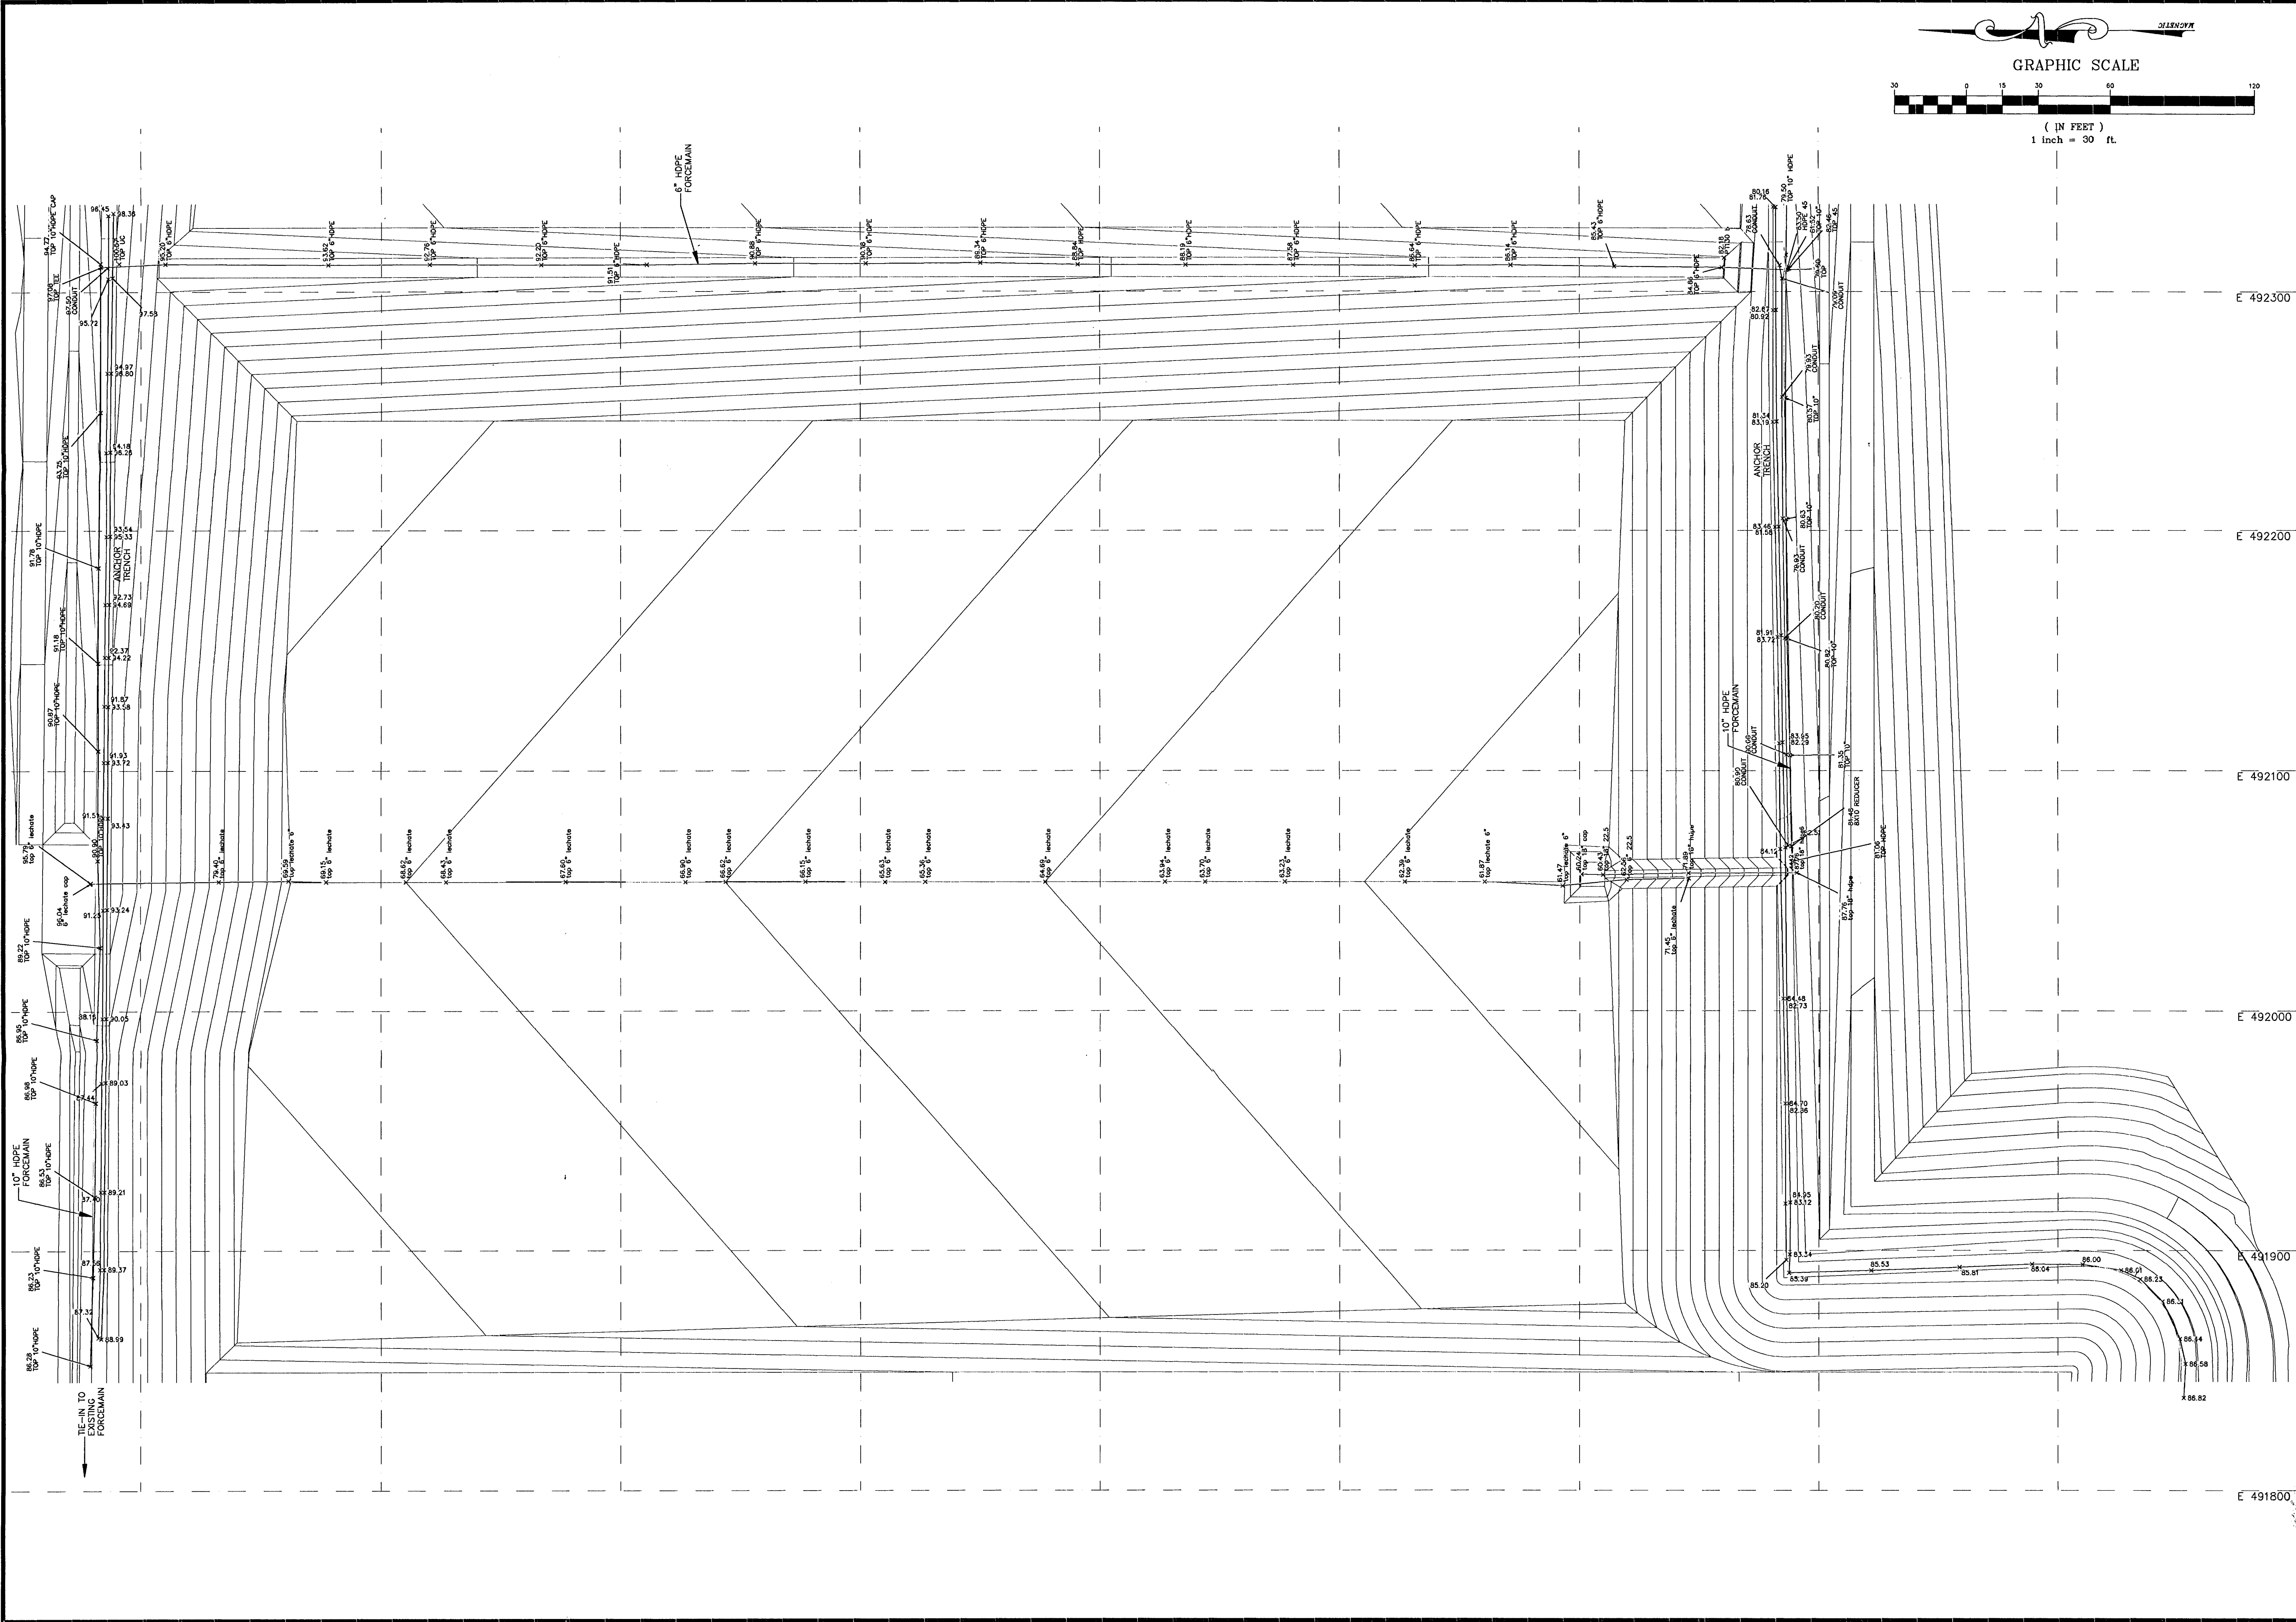

	SCALE: 1\"/>
	PROJECT NO. 135
SHEET 4	
AS-BUILT SURVEY VISTA CELL 3 LEACHATE SYSTEM KEENE ROAD RECYCLING AND DISPOSAL FACILITY LOCATED IN APOPKA, FL	
CLIENT: ERC GENERAL CONTRACTOR 880 Center Road Suite 170 Winter Garden, FL 34787	
Peavey & Associates SURVEYING & MAPPING PA 680 ALICE PLACE BARTOW, FL 33530 PHONE: 863-738-4960 FLORIDA BUSINESS NO. 7779	
Drawn By: DLP Permit Chief: DR Field Book: 18 Page: 2-26	THIS SURVEY IS NOT VALID WITHOUT THE ORIGINAL RAISED SEAL OF A FLORIDA LICENSED SURVEYOR AND MAPPER. FILE NAME: 135_erc_vista_cell_3_cab_planning
NO. DATE	REVISION

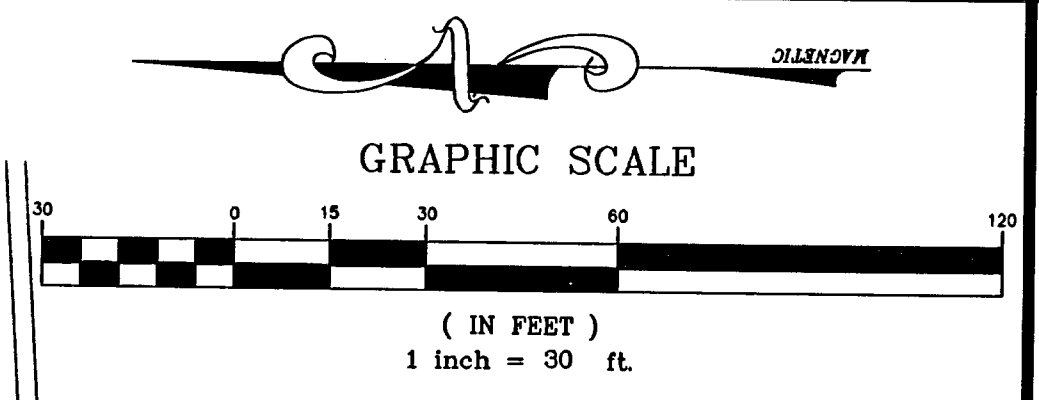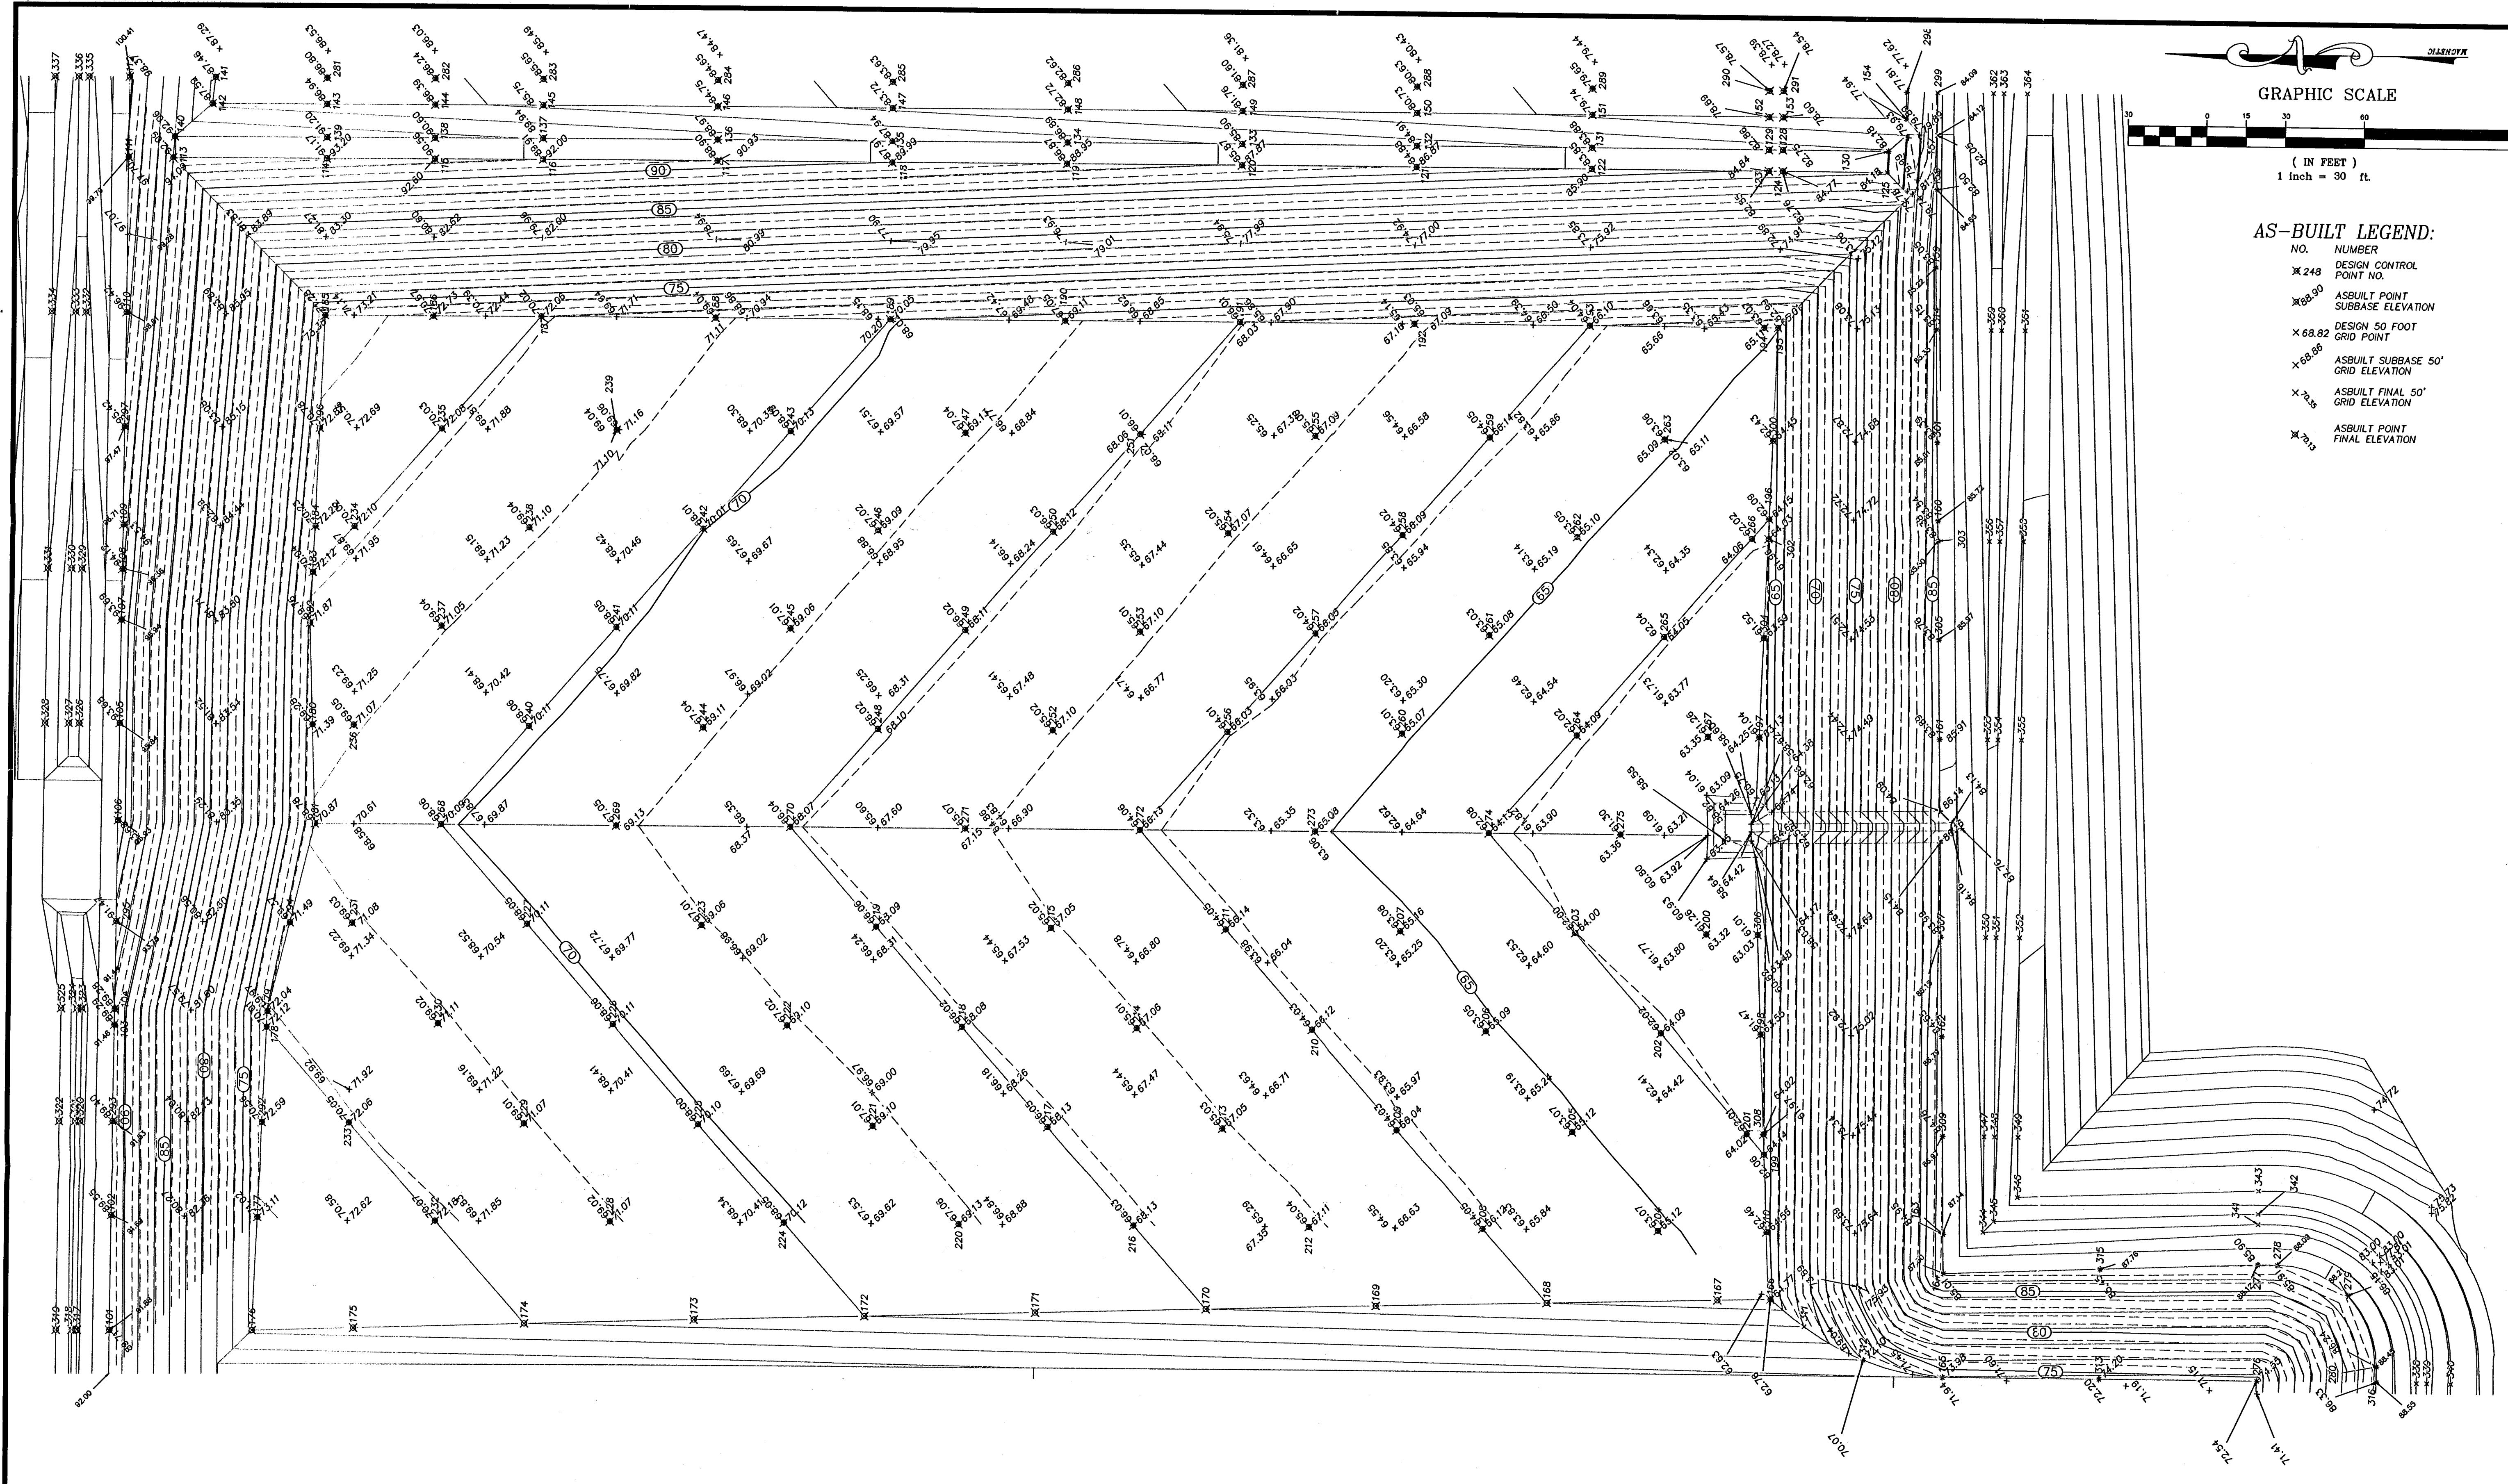

- AS-BUILT LEGEND:**
- NO. NUMBER
 - ✕ 248 DESIGN CONTROL POINT NO.
 - ✕ 68.90 ASBUILT POINT SUBBASE ELEVATION
 - ✕ 68.82 DESIGN 50 FOOT GRID POINT
 - ✕ 68.66 ASBUILT SUBBASE 50' GRID ELEVATION
 - ✕ 72.35 ASBUILT FINAL 50' GRID ELEVATION
 - ✕ 72.35 ASBUILT POINT FINAL ELEVATION

AS-BUILT SURVEY VISTA CELL 3
FINAL COVER-CONTROL POINTS
KEENE ROAD RECYCLING AND DISPOSAL
FACILITY LOCATED IN APOPKA, FL

CLIENT:
ERC GENERAL CONTRACTOR
880 Center Road Suite 170
Winter Garden, FL 34787

Peavey & Associates
SURVEYING & MAPPING P.A.
690 ALICE PLACE
BARTOW, FL 33830
PHONE 863-738-4960
FLORIDA BUSINESS NO. 7779

THIS SURVEY IS
NOT VALID WITHOUT
THE SIGNATURE AND
SEAL OF A FLORIDA
LICENSED SURVEYOR
AND MAPPER.

NO.	DATE	REVISION

