932008
(1)

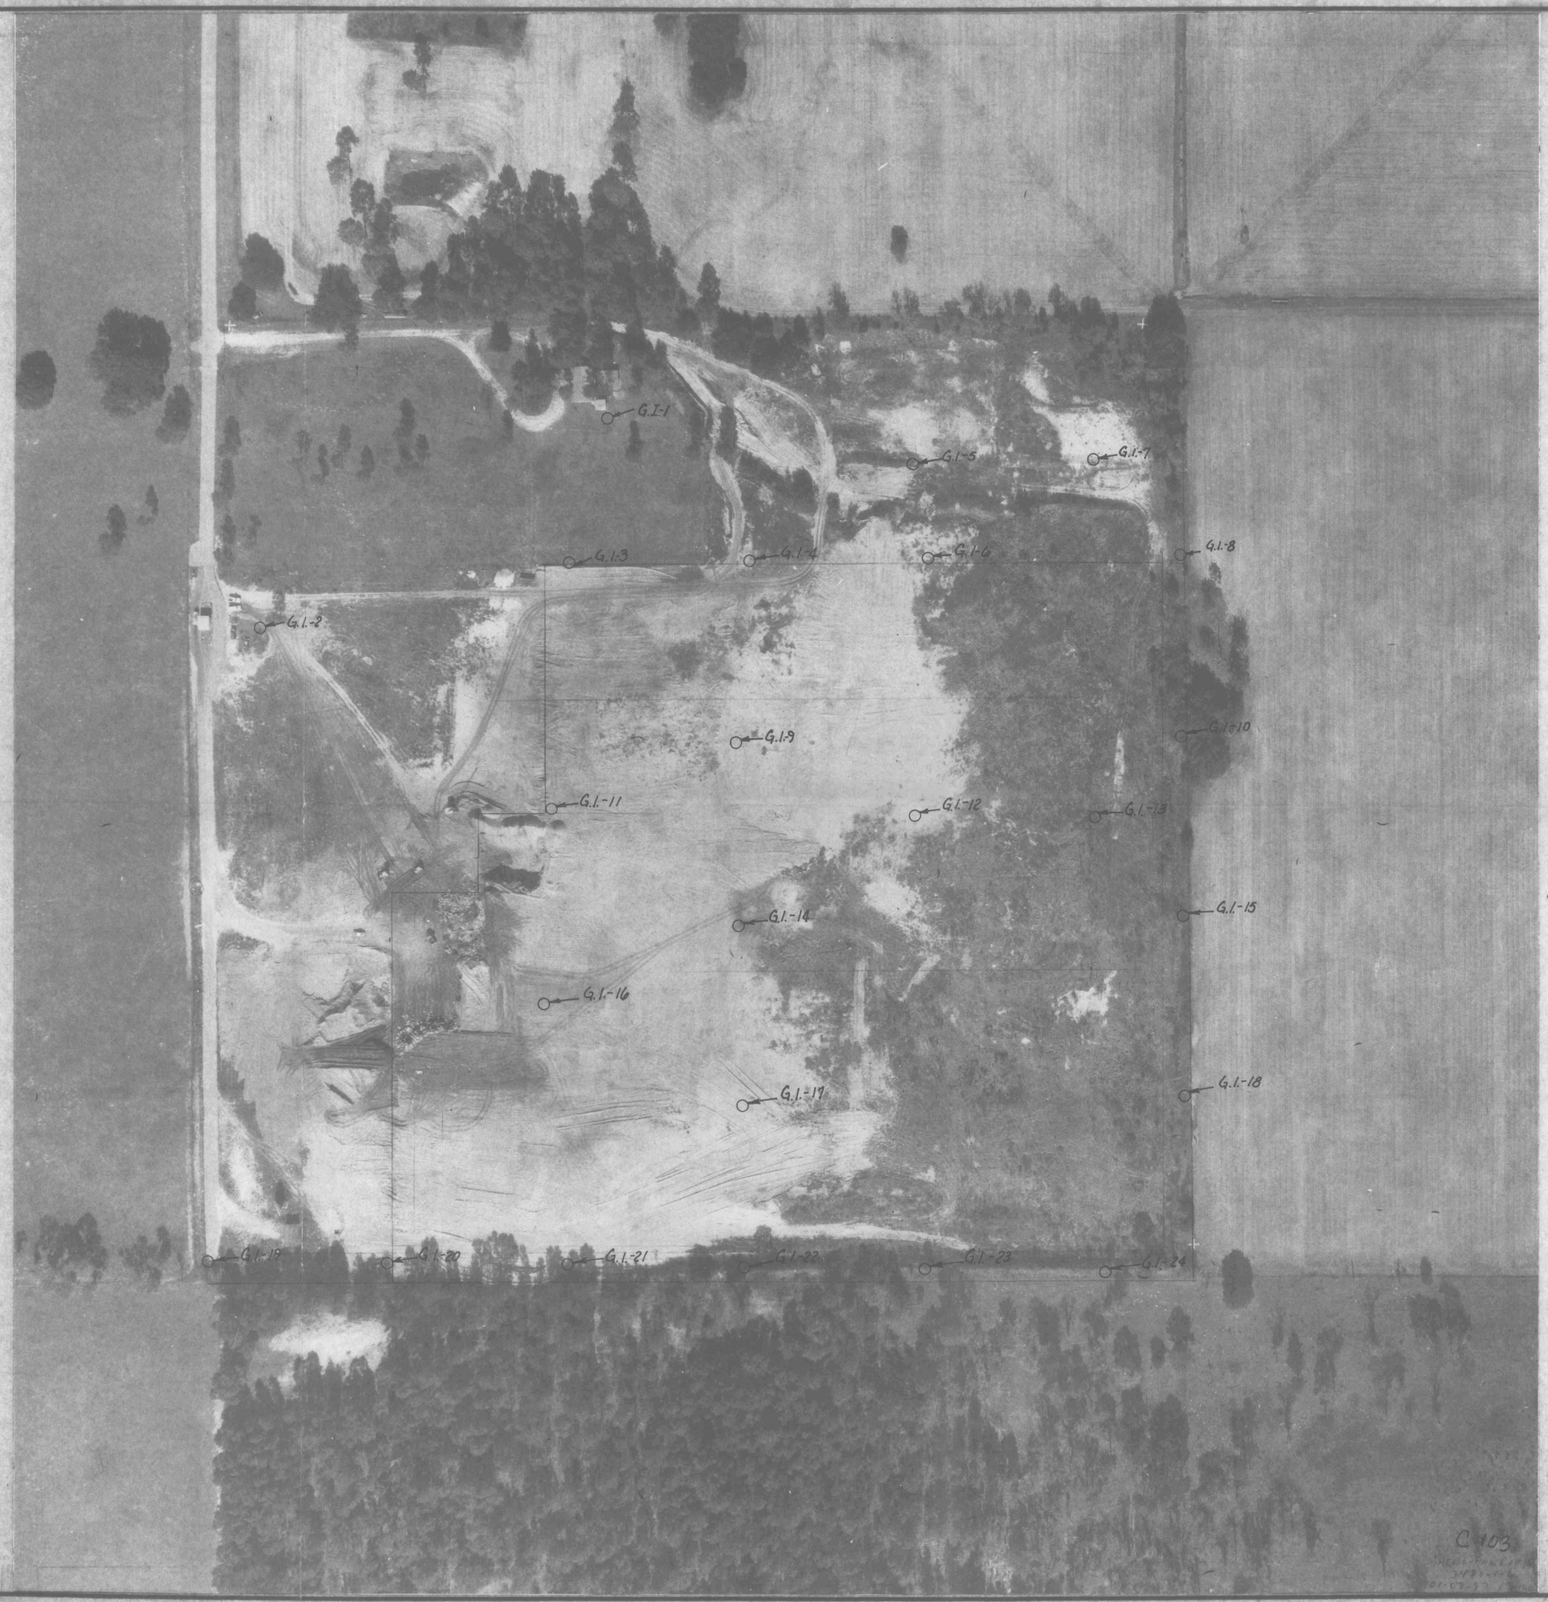

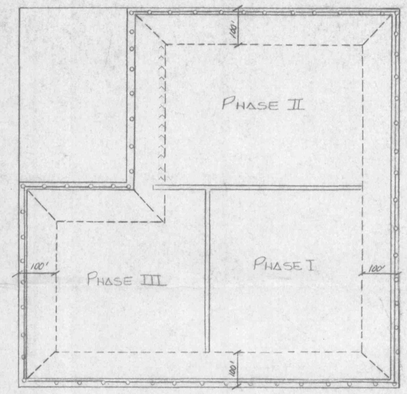

GAS MIGRATION INVESTIGATION - ○ G.I-1 LOCATION OF GAS PROBE VENTS

PHOTOGRAPH TAKEN 1-8-87

3-31-88 APPROVED BY DER

SPRINGSTEAD ENGINEERING INC.
consulting engineers
Leesburg — Boshnell

AERIAL OF SUMTER Co. LANDFILL

DATE	SCALE	FILE	JOB NO.
3-1987	1"=100'	C-103	C103
DESIGN	DRAWN	CHECKED	SHEET
PB	JAH	PB	1 OF 6

C-103