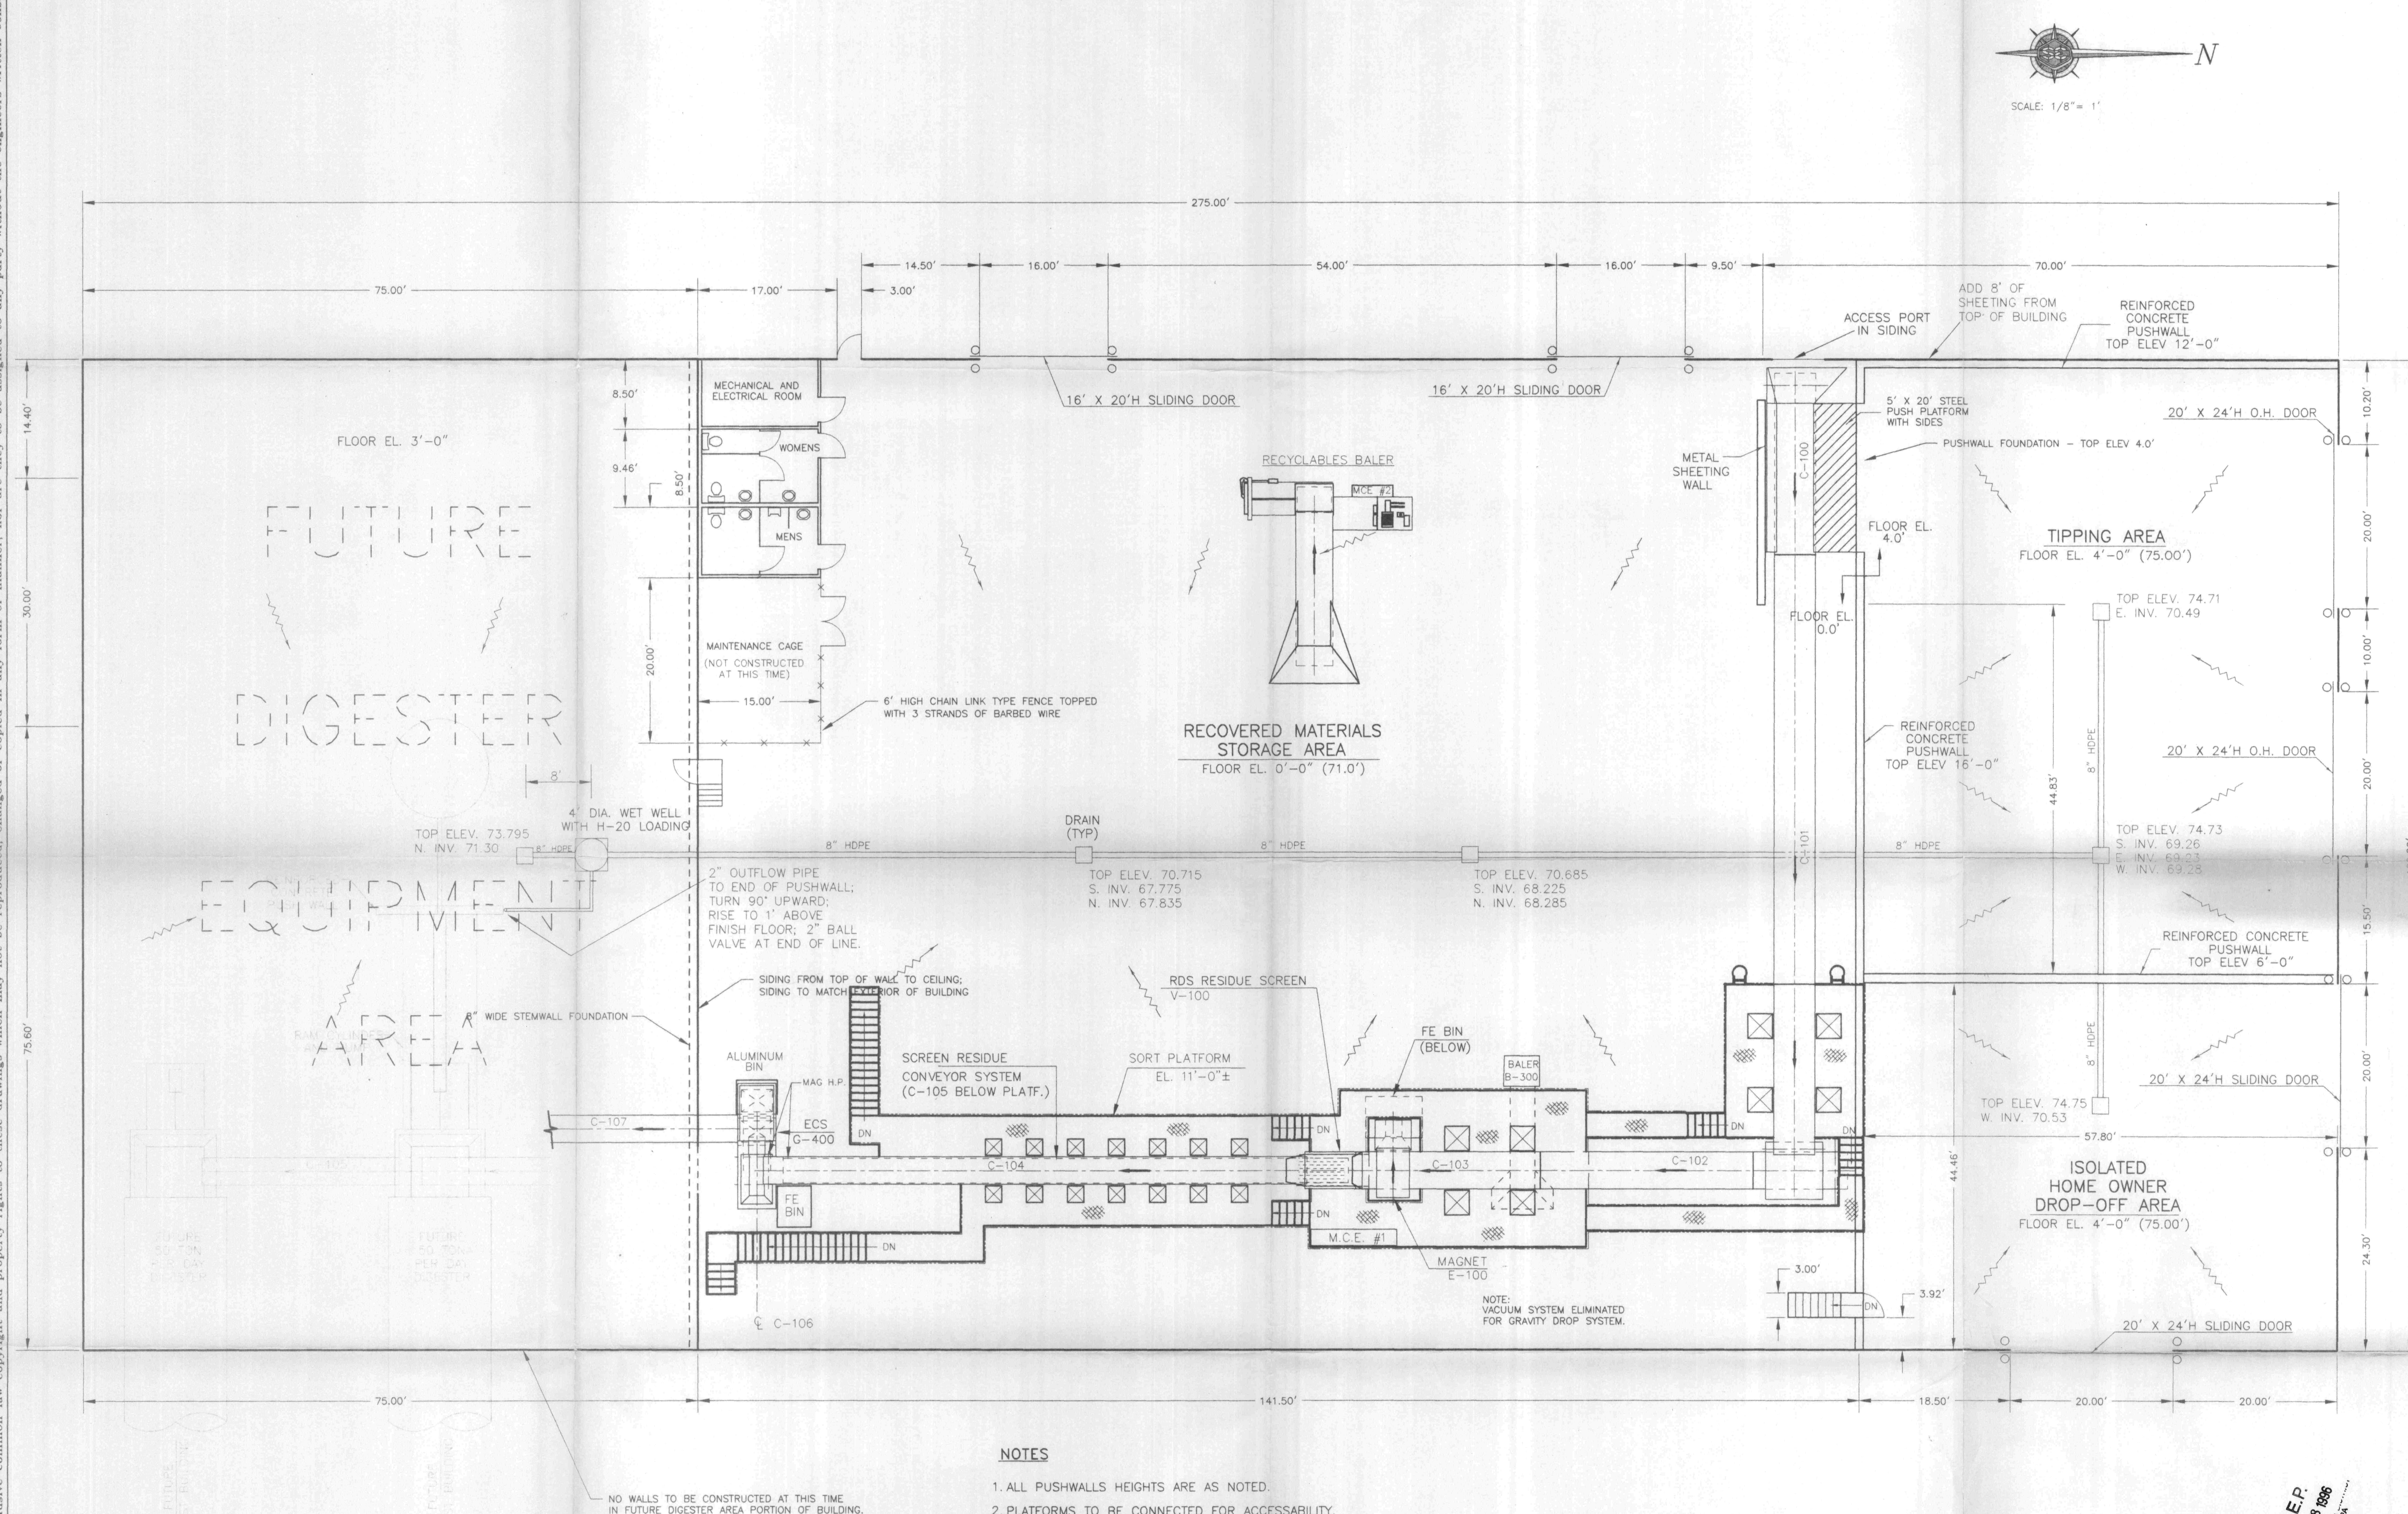

NOTES

1. ALL PUSHWALLS HEIGHTS ARE AS NOTED.
2. PLATFORMS TO BE CONNECTED FOR ACCESSABILITY. RECYCLING EQUIPMENT NOT INCLUDED IN BUILDING CONTRACT. BUILDING CONTRACTOR WILL WORK WITH EQUIPMENT CONTRACTOR TO LOCATE ANY FIXTURES NECESSARY IN SLAB AND/OR WALLS.
3. END BENTS SHALL BE SAME AS INTERIOR BENTS.
4. LATERAL LONGITUDINAL BRACING SHALL BE TAKEN BY REACTION COLUMNS. NO RODS OR CABLE BRACING SHALL BE USED.
5. FINAL FOOTING DESIGN TO BE PERFORMED BY BY ENGINEER AFTER ACTUAL LOADS ARE SUPPLIED BY METAL BUILDING MANUFACTURER IN SHOP DRAWINGS.
6. SLIDING DOORS SHALL BE DOUBLE SLIDING AS SHOWN ON DETAIL SHEET OR EQUIVALENT.
7. FLOOR SHALL SLOPE TOWARD DRIAN INLETS. INLET ELEVATIONS TO BE PROVIDED BY ENGINEER PRIOR TO CONSTRUCTION.

D.E.P. AUG 08 1996

FILE

RECORD DRAWING

REV. BY:	DESCRIPTION	DATE:	DRAWN
	REVISED OUTFLOW PIPE	8/2/96	
	ADDED NOTE	7/10/96	
	RECARD DRAWING	7/1/96	

7 of 10

CLIENT: SUMTER COUNTY BOARD OF COUNTY COMMISSIONERS

PROJECT: SOLID WASTE MANAGEMENT FACILITY

DRAWING: PROPOSED MATERIALS RECOVERY BUILDING FLOOR PLAN

Springstead Engineering, inc.
Consulting Engineers
Planners
Surveyors
727 South 14th Street
Leesburg, Fl. 34748
(904) 787-1414

SCALE:	FILE:	DATE:
1/8"=1'	FACILITY	05/22/95
DESIGN:	DRAWN:	CHECKED:

DRAWING: PROPOSED MATERIALS RECOVERY BUILDING FLOOR PLAN

CLIENT: SUMTER COUNTY BOARD OF COUNTY COMMISSIONERS

JOB NO.:	SHEET: 7
921100.000	OF: 10

AUG 07 1996