



11x17.Density Grid.dwg

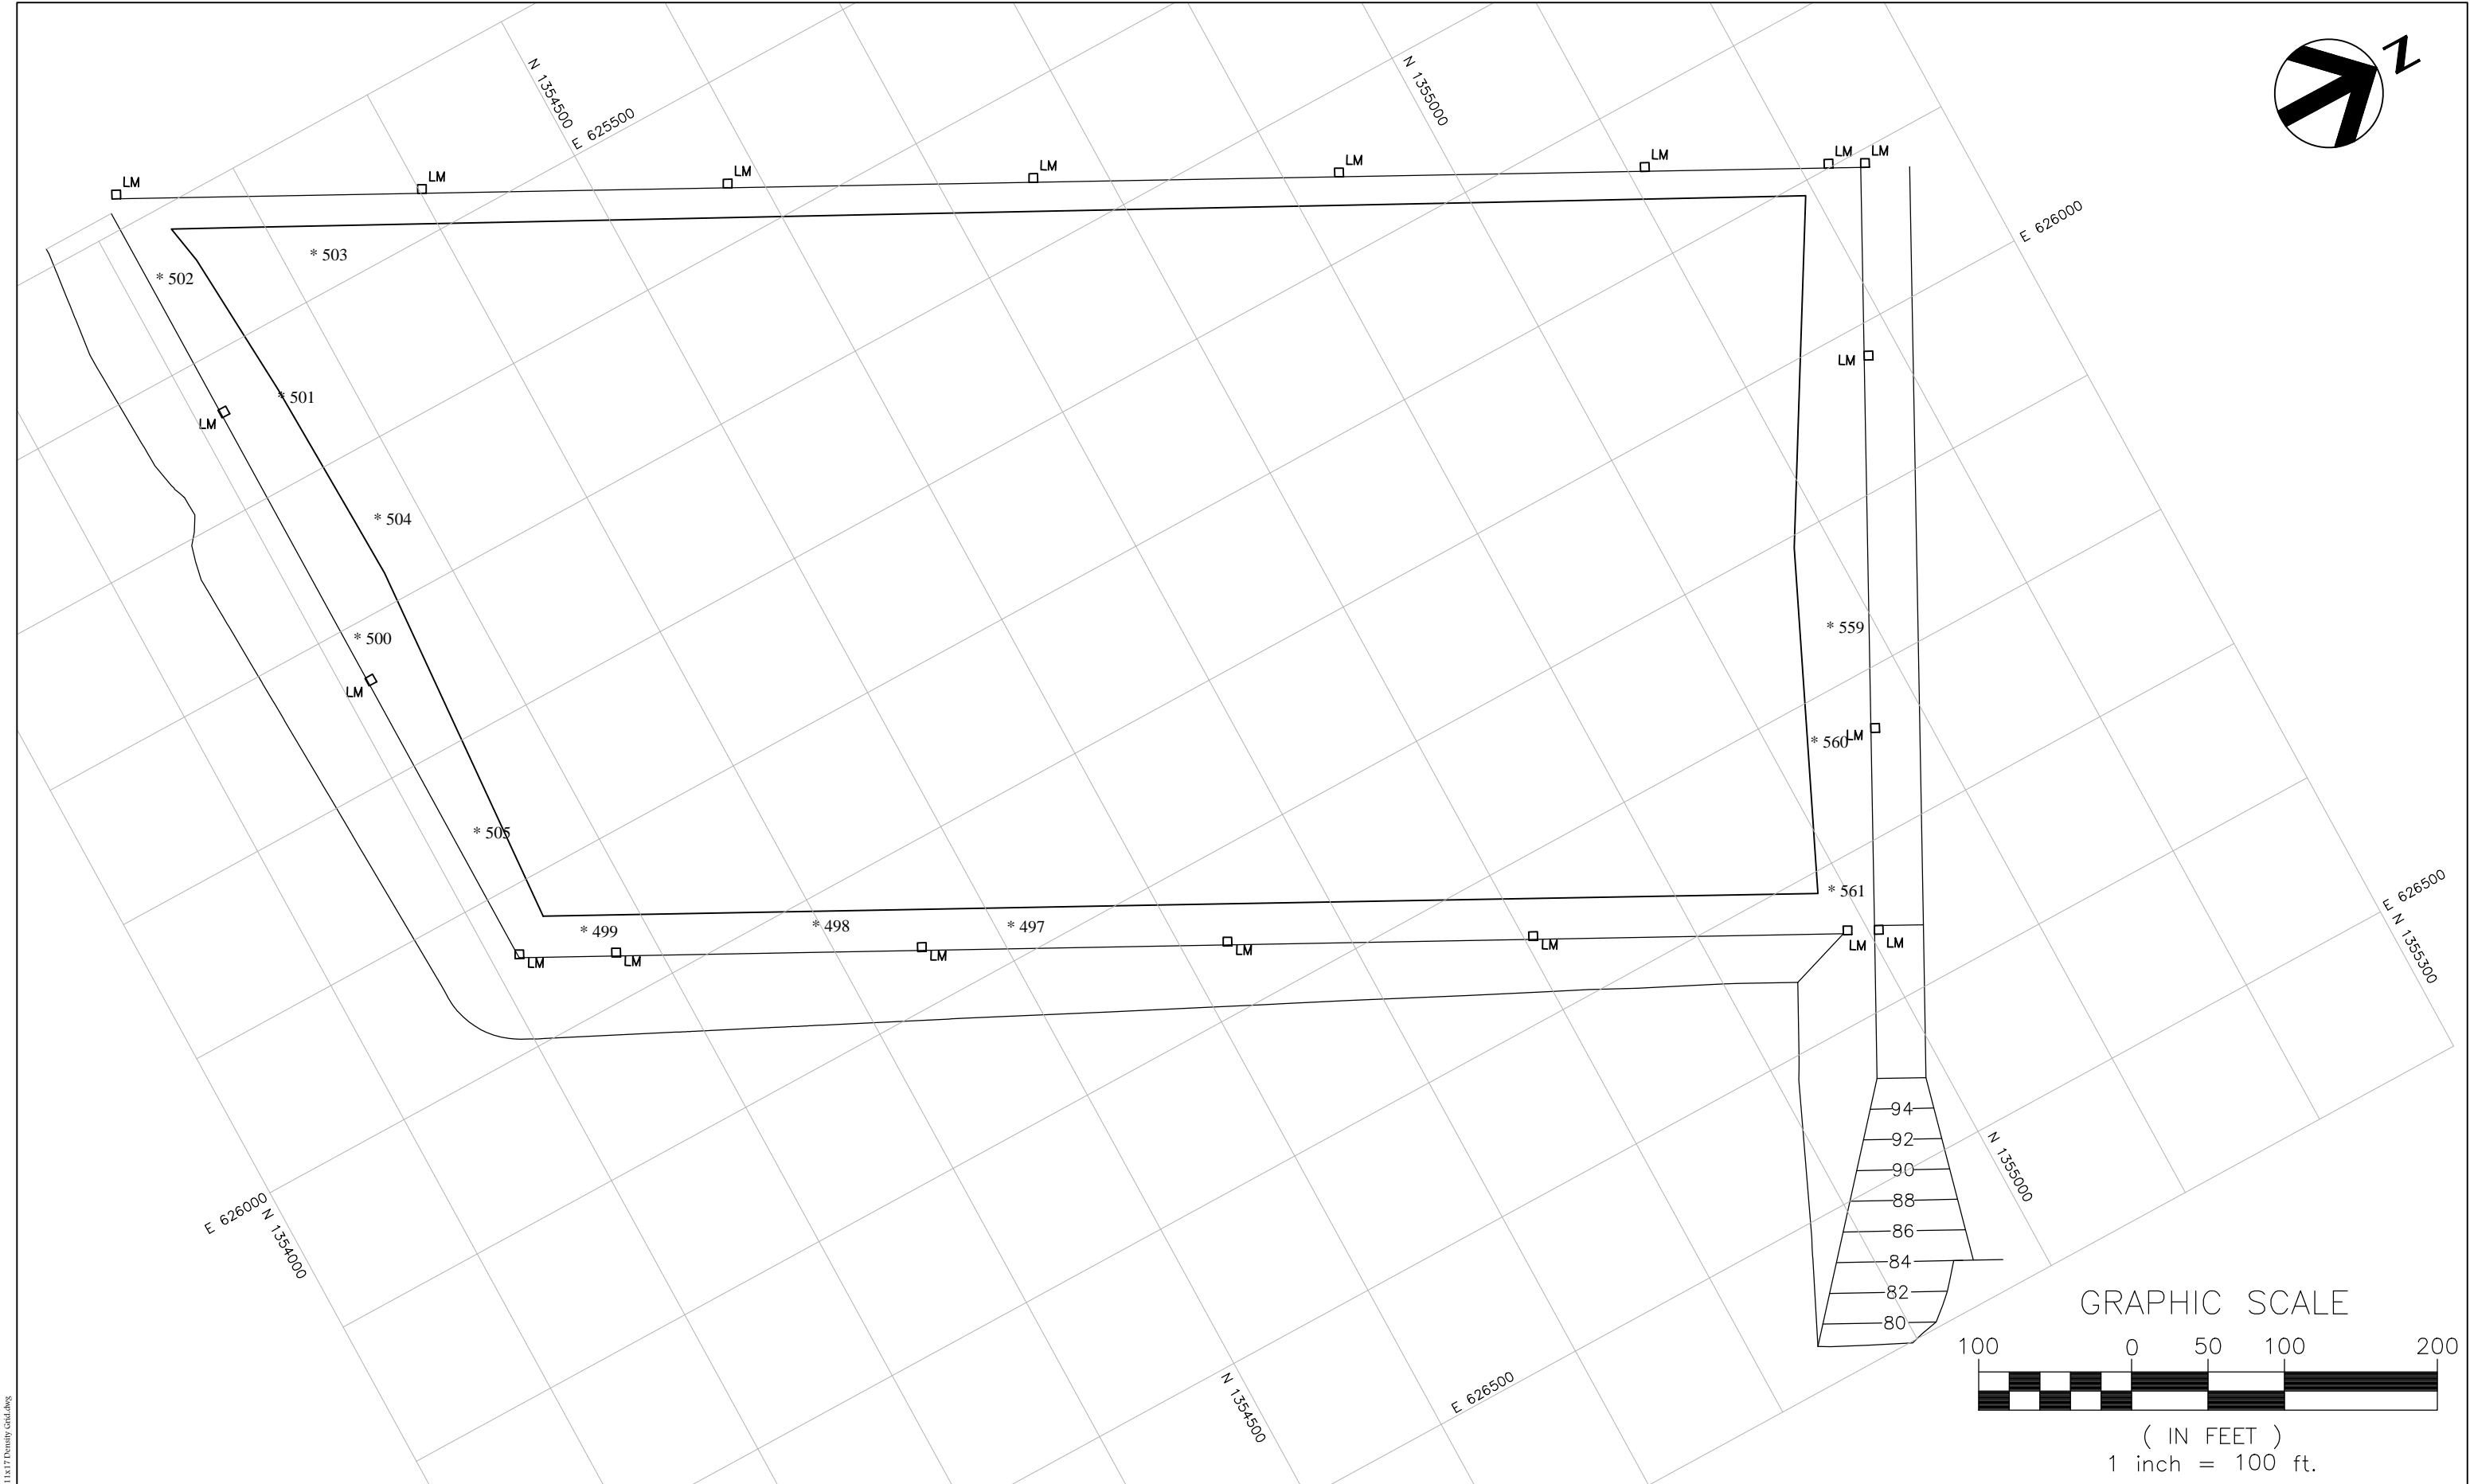

<div><div>Brantley Engineering, LLC</div></div>						PROJECT MANAGER:	A. BRANTLEY, PE	JED SOLID WASTE MANAGEMENT FACILITY CELL 10 CONSTRUCTION	LIFT 11	MOISTURE/DENSITY TEST LOCATIONS FOR SUBGRADE	LIFT 11
						DESIGNED BY:	A. BRANTLEY, PE				
						QC'ED BY:	S. NEJAD, PE				
						DRAWN BY:	A. BRANTLEY, PE				
0	3/5/14	BRANTLEY ENGINEERING, LLC.	INITIAL ISSUE								
ISSUE	DATE	RESPONSIBLE ENG.	DESCRIPTION			PROJECT NUMBER	1014-101				

01"2"

SCALE: 1" = 100'

FILENAME

DIRECTORY

11X17 GRID LAYOUT

JED/CELL 10/DWG

1

FIGURE