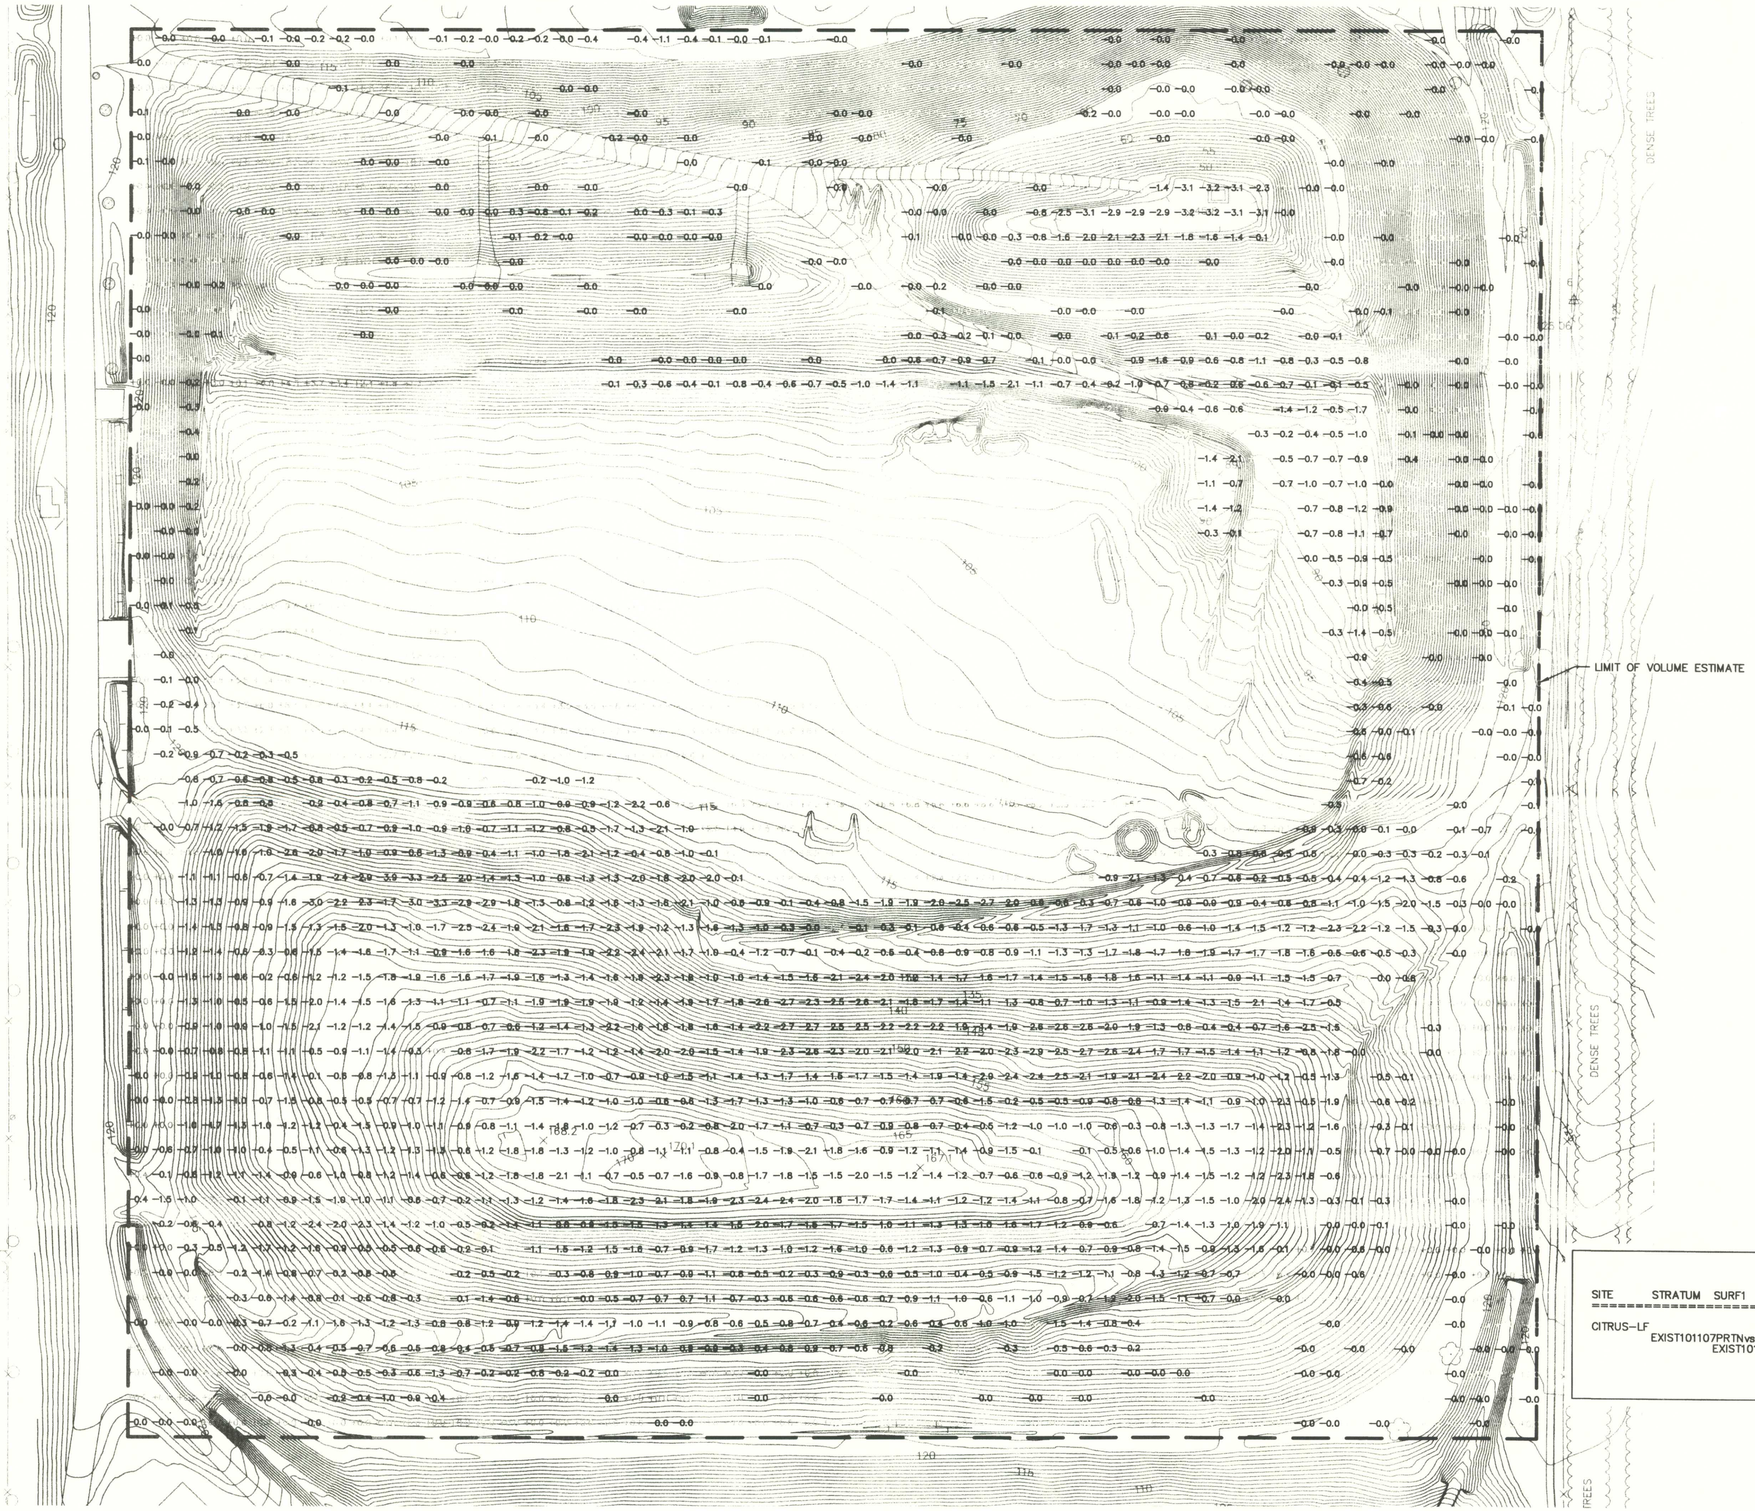


INSERTED INTO OCULUS
NOV 2 0 2008
INITIAL

LEGEND

- EXISTING ELEVATIONAL CONTOUR (5 FOOT INTERVAL) 10/11/07 SURVEY
- EXISTING ELEVATIONAL CONTOUR (1 FOOT INTERVAL) 10/11/07 SURVEY
- EXISTING SPOT ELEVATION 10/11/07 SURVEY
- 80 EXISTING ELEVATIONAL CONTOUR (5 FOOT INTERVAL) 04/12/08 SURVEY
- EXISTING ELEVATIONAL CONTOUR (1 FOOT INTERVAL) 04/12/08 SURVEY
- ×125.8 EXISTING SPOT ELEVATION 04/12/08 SURVEY
- FILL AREA AND DEPTH (FEET) BETWEEN 10/11/07 TOPOGRAPHIC SURVEY AND 04/12/08 TOPOGRAPHIC SURVEY
- -12.8 CUT AREA AND DEPTH (FEET) BETWEEN 10/11/07 TOPOGRAPHIC SURVEY AND 04/12/08 TOPOGRAPHIC SURVEY

SITE VOLUME TABLE: UNADJUSTED

SITE	STRATUM	SURF1	SURF2	CUT CU. YARDS	FILL CU. YARDS	NET CU. YARDS	METHOD
CITRUS–LF	EXIST101107PRTNvsEXIST–041208–PRTN EXIST101107PORTION EXIST–041208–PORTION			21,373	83,575	62,202 (FILL)	GRID

Dept. of Environmental Protection
AUG 14 2008
Southwest District

SURVEY SOURCE NOTE:

SURVEY PERFORMED BY KUCERA SOUTH, 2215 SOUTH FLORIDA AVENUE, LAKELAND FLORIDA 33803, TEL: (863) 686–8640. SURVEY INFORMATION SHOWN WAS COMPILED USING PHOTOGRAMMETRIC METHODS WITH PHOTO DATES OF OCTOBER 11, 2007 AND APRIL 12, 2008.

JOHN A. BANKS, P.E.
CERTIFICATE NO. 39397

REV	DATE	DESCRIPTION	BY

DRAWING TITLE
10/11/07 SURVEY vs. 04/12/08 SURVEY
VOLUME ESTIMATE SITE PLAN

PROJECT TITLE
CENTRAL LANDFILL
REMAINING CAPACITY REPORT

CLIENT
CITRUS COUNTY
LECANTO, FLORIDA

SCS ENGINEERS
STEARNS, CONRAD AND SCHMIDT
CONSULTING ENGINEERS
4041 PARK OAKS BLVD., SUITE 100, TAMPA, FL 33610
PH (813) 621-0080 FAX NO. (813) 853-5757
FLORIDA CERTIFICATE OF AUTHORIZATION NO. 00004892

PROJ. NO. 046703.03
DSN. BY: JAB
DWN. BY: SDA
CHK. BY: JAB
QA/QC BY: JAB
APP. BY: RJD

CADD FILE: 046703CAP–VOLS5
DATE: MAY 2008
SCALE: AS SHOWN
DRAWING NO. 1 of 2