


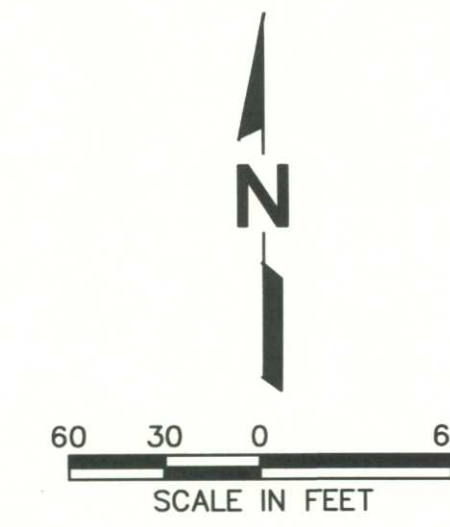

LEGEND

- 90 — EXISTING ELEVATIONAL CONTOUR
 (5 FOOT INTERVAL) 10/14/05 SURVEY
 — 80 — EXISTING ELEVATIONAL CONTOUR
 (1 FOOT INTERVAL) 10/14/05 SURVEY
 X 117.58 EXISTING SPOT ELEVATION
 — 80 — EXISTING ELEVATIONAL CONTOUR
 (5 FOOT INTERVAL) 04/05/05 SURVEY
 — 80 — EXISTING ELEVATIONAL CONTOUR
 (1 FOOT INTERVAL) 04/05/05 SURVEY
 +10 FILL DEPTH (FEET)
 -12 CUT DEPTH (FEET)

SITE VOLUME TABLE: UNADJUSTED							
SITE	STRATUM	SURF1	SURF2	CUT YARDS	FILL YARDS	NET YARDS	METHOD
CITRUS-VOL1	EXIST040505PORTIONvs	EXIST101405					
	EXIST040505PORTION	EXIST101405		16,310	96,515	80,206 (F)	GRID

[illegible]