

Pannell, Narrisa

From: Roudebush, Rick
Sent: Thursday, May 14, 2015 7:33 AM
To: Pannell, Narrisa
Subject: FW: WACS 51614 - Central County Solid Waste Disposal Complex - Leachate Spill During Forcemain Maintenance Work
Attachments: RE Sarasota CCSWDC Upcoming Projects - Permit Determination Assistance; Approximate Location of ARV 7 and Leachate Spill 5.12.15.pdf

From: Jason Timmons [mailto:jtimmons@scgov.net]
Sent: Tuesday, May 12, 2015 5:30 PM
To: Sautter, Mark; Roudebush, Rick
Cc: Lois Rose; Banks Jr, John A; Mmossman@wesinc.com
Subject: WACS 51614 - Central County Solid Waste Disposal Complex - Leachate Spill During Forcemain Maintenance Work

Mark and Rick:

Today, May 12, 2015, at approximately 2:00PM, WES Industries, Inc. was performing maintenance work on the leachate forcemain from the landfill to the wastewater lift station on Knights Trail. This work includes re-installing air release valves (ARVs) along the forcemain to improve forcemain operations. While performing work on ARV #7, approximate location shown on the attached drawings, the piping for the valve assembly failed and leachate was released on to the soils surrounding the ARV. WES immediately closed a shutoff valve at the tap for the ARV and contained the leachate as quickly as possible. WES is currently in the process removing all soil contaminated with leachate from the area, they plan to cover the soil tonight with tarps, then tomorrow transport the soil to the landfill for disposal. The area will then be backfilled with clean soil. We will document the cleanup activities and provide a final completion report as soon as possible.

Please also accept this email as a courtesy notification of the maintenance work being performed beginning on May 1, 2015. Per an email provided by Cory Dilmore at FDEP Tallahassee (see attached), this work (listed as the #2 in the list of work in the email), and several other work items, was determined to be exempted from permitting. However, Cory requested that we notify the South District and Tallahassee when the work commenced. I apologize for the oversight in not providing notification of the work sooner. I plan to send a formal courtesy notification to you and Tallahassee FDEP tomorrow as well as ensure we provide notification for the other work items listed when they commence.

Please contact me if you have any questions or need any additional information regarding this event.

Thank you.


Jason

Jason Timmons, P.E.
Sarasota County Public Utilities | Solid Waste Engineer



office: 941-861-1572
cell: 941-400-2370
email: jtimmons@scgov.net

4000 Knights Trail Road, Nokomis, FL 34275

All communications sent to and from Sarasota County Government are subject to the public records law of Florida.

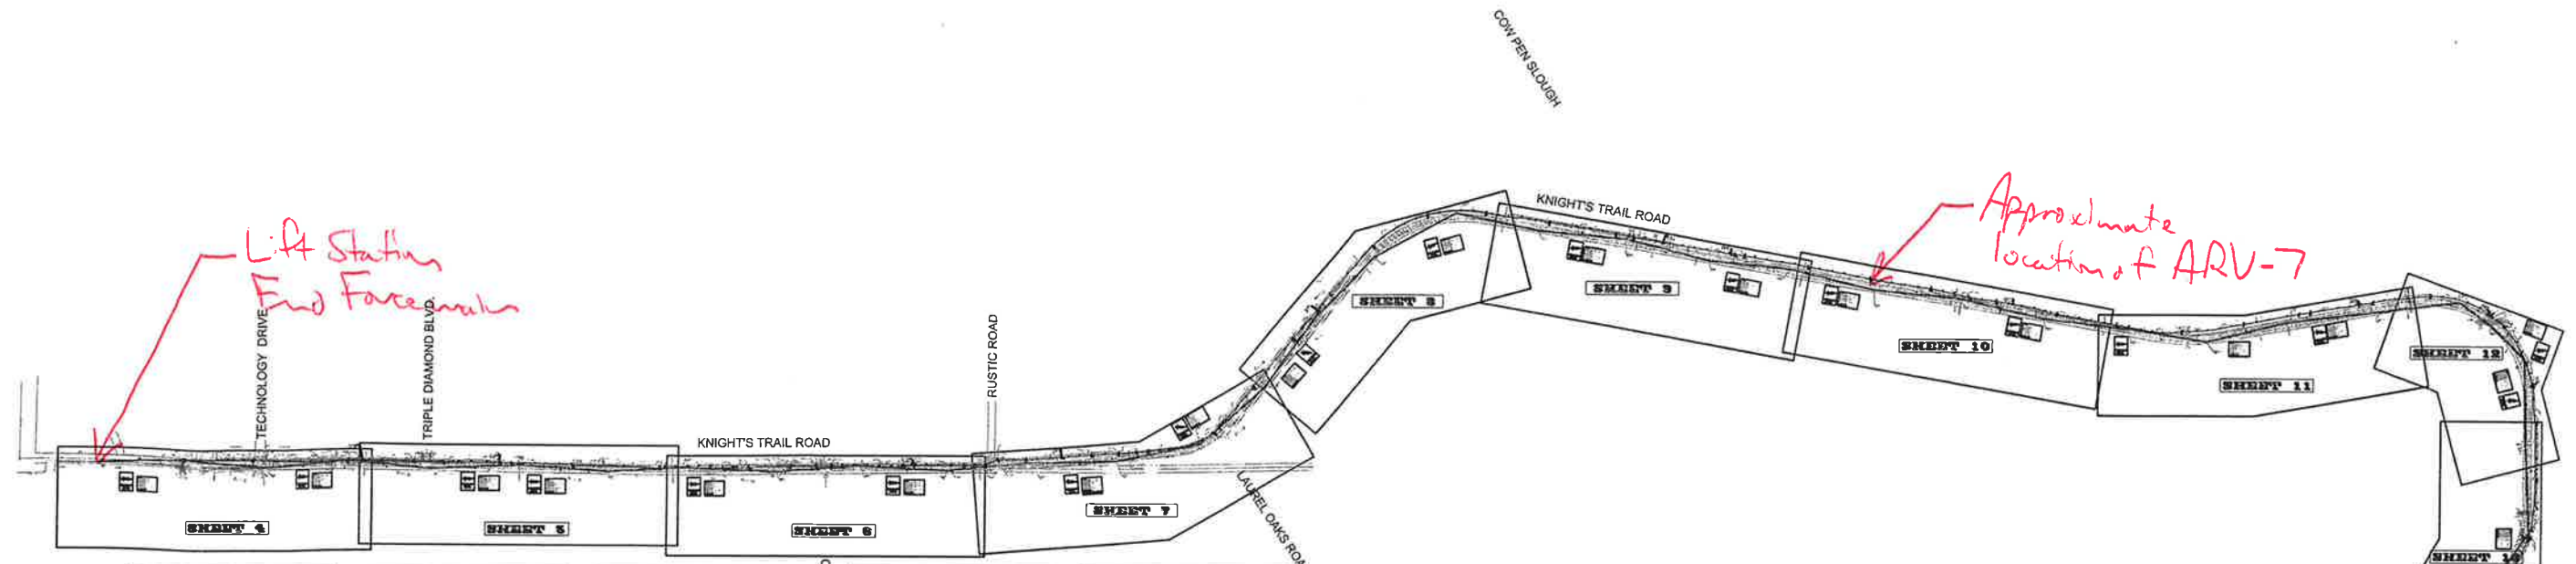

NO.	DESCRIPTION	DATE	STATUS	REVISION
1
2
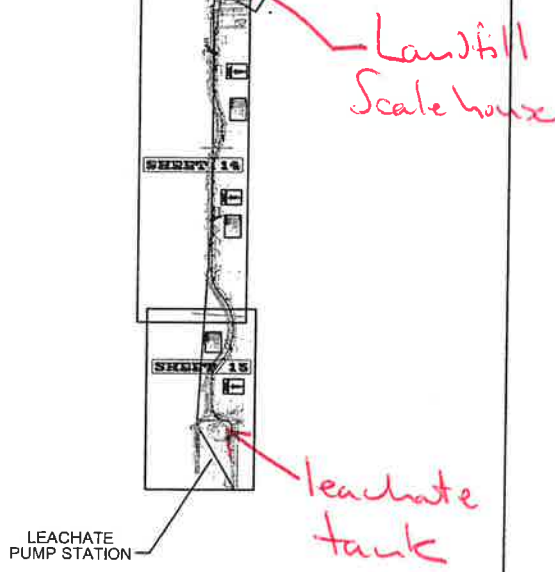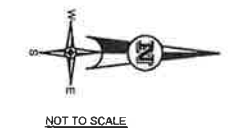

ATKINS

PRINCIPAL ADDRESS:
4030 W. BOY SCOUT BLVD.
SUITE 700
TAMPA, FL 33607-1712
FBPR CERT. OF AUTH. No. 24
PRODUCTION ADDRESS:
100 PARAMOUNT DR., SUITE 207
SARASOTA, FL 34232
941.378.0272
941.371.7297 (FAX)

Sarasota County
scgov.net | 941.861.5000 | TV

PROJECT: CENTRAL COUNTY SOLID WASTE DISPOSAL COMPLEX LEACHATE FORCE MAIN AND PUMP STATION IMPROVEMENTS



TASK: OVERALL FORCE MAIN SITE PLAN

ORIGINAL:	6
REVISIONS:	7
1	8
2	9
3	10
4	11
5	12

JOHN EASH, P.E.
FL. P.E. # 46235
NOT VALID FOR CONSTRUCTION UNLESS SIGNED IN THIS BLOCK

JOB NO. 100037132
DRAWN MV
DESIGNED JE
CHECKED JE
QC CS


SHEET 3

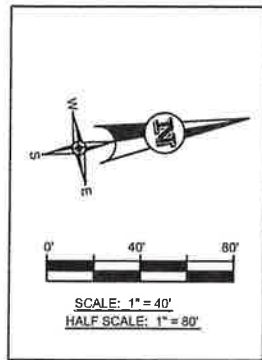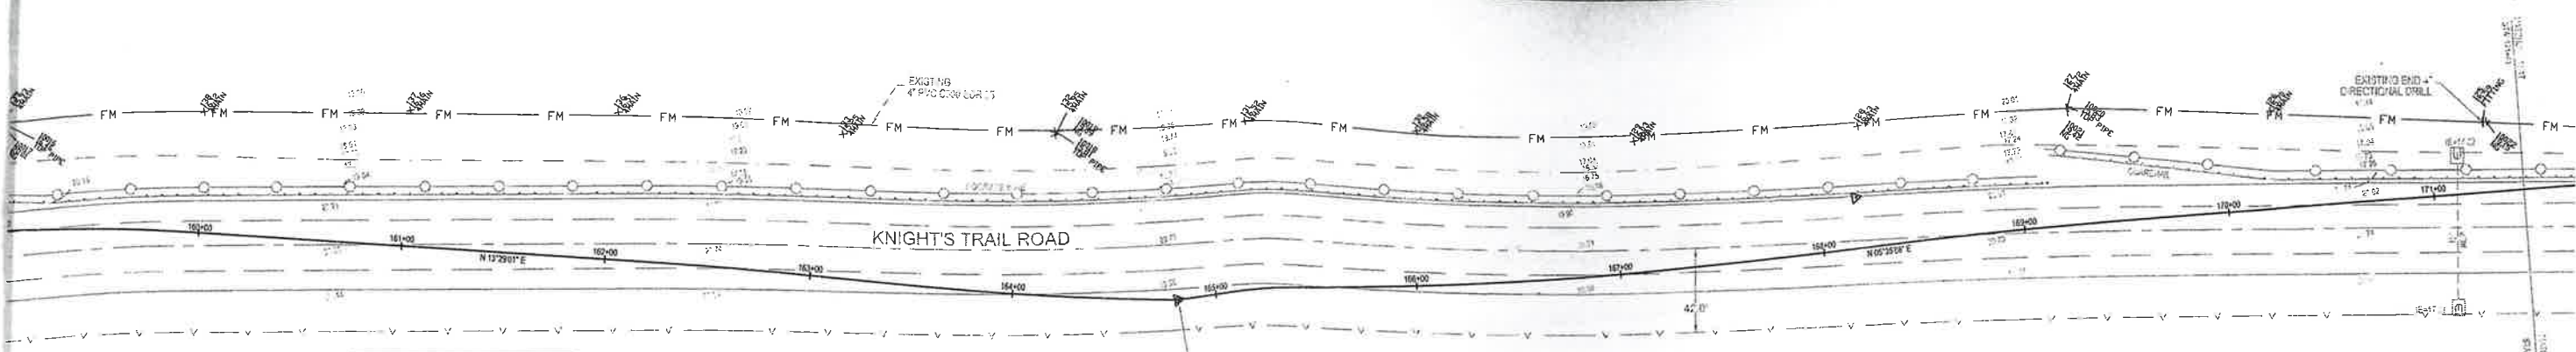

LEGEND:


	EXISTING FORCE MAIN
	PROPOSED FORCE MAIN
	EXISTING DIRECTIONAL DRILL
	PROPOSED DIRECTIONAL DRILL
	EXISTING UTILITY
	PROPOSED UTILITY
	TOP OF BANK
	EDGE OF PAVEMENT
	CENTERLINE OF ROAD
	RIGHT-OF-WAY
	STATIONING
	BARRIER
	FM

PI STA 158+01.52
 5' W. POINT FROM PT.
 N 13° 29' 11\"/>

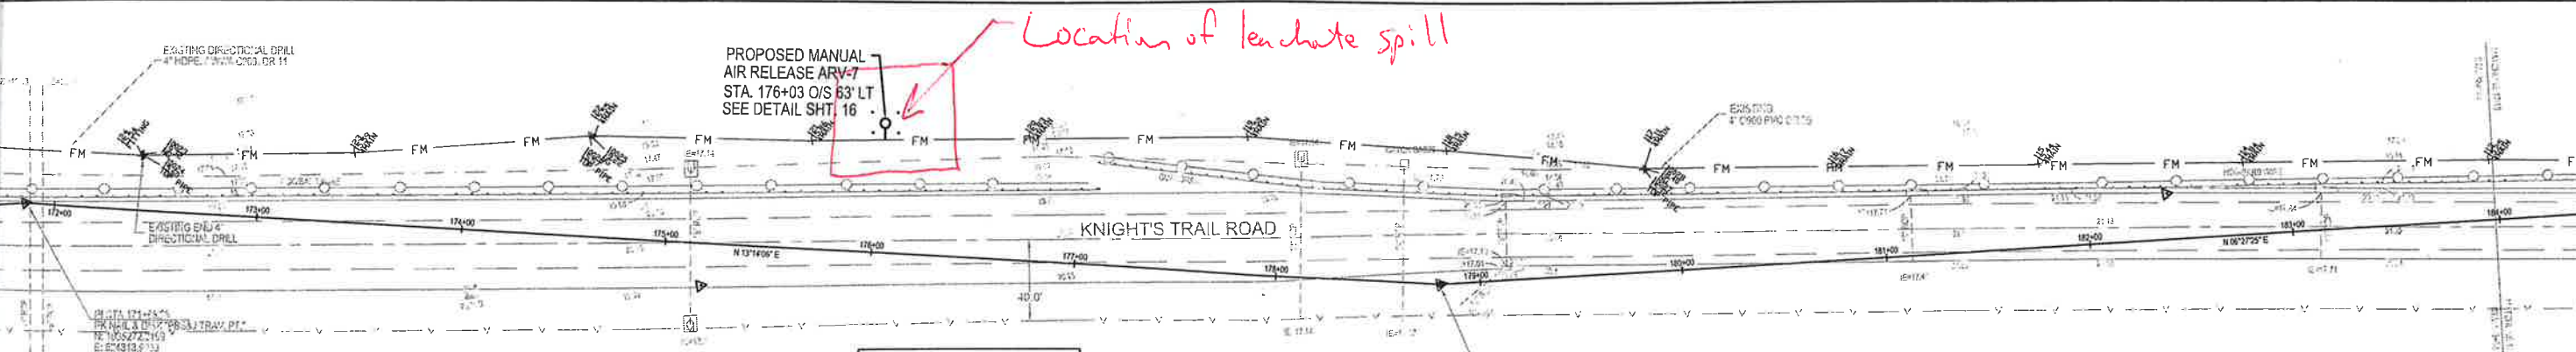

PROPOSED MANUAL AIR RELEASE ARV-7
 STA. 176+03 O/S 63' LT
 SEE DETAIL SHT. 16

Location of leachate spill

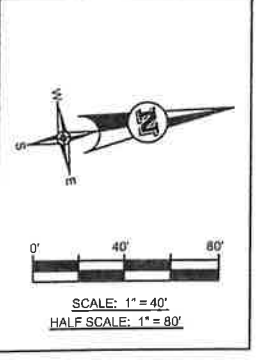

LEGEND:

	EXISTING FORCE MAIN
	PROPOSED FORCE MAIN
	EXISTING DIRECTIONAL DRILL
	PROPOSED DIRECTIONAL DRILL
	EXISTING UTILITY
	PROPOSED UTILITY
	TOP OF BANK
	EDGE OF PAVEMENT
	CENTERLINE OF ROAD
	RIGHT-OF-WAY
	STATIONING
	BARRIER
	FM

PI STA 176+01.77
 5' W. POINT FROM PT.
 N 13° 14' 09\"/>

ATKINS

PRINCIPAL ADDRESS:
 4030 W. BOY SCOUT BLVD.
 SUITE 700
 TAMPA, FL 33607-1712
 FBPR CERT. OF AUTH. No. 24

PRODUCTION ADDRESS:
 100 PARAMOUNT DR., SUITE 207
 SARASOTA, FL 34232
 941.378.0272
 941.371.7297 (FAX)

Sarasota County
 scgov.net | 941.861.5000 | TV

PROJECT:	CENTRAL COUNTY SOLID WASTE DISPOSAL COMPLEX LEACHATE FORCE MAIN AND PUMP STATION IMPROVEMENTS
TASK:	SITE PLAN STATION 158+79 TO STATION 183+98

ORIGINAL:	6
REVISIONS:	7
1	8
2	9
3	10
4	11
5	12

JOB NO.	100037132
DRAWN	MV
DESIGNED	JE
CHECKED	JE
QC	CS

JOHN EASH, P.E.
 FL. P.E. #: 46235
 NOT VALID FOR CONSTRUCTION UNLESS SIGNED IN THIS BLOCK