

December 1, 2015 ENV-15-139

Mr. F. Thomas Lubozynski Program Administrator Florida Department of Environmental Protection Central District Office 3319 Maguire Boulevard Suite 232 Orlando, FL 32803

Re: Quarterly Landfill Gas Monitoring Report – Fourth Quarter 2015

Volusia County's Tomoka Farms Road

Permit No. S064-0078767

Dear Mr. Lubozynski:

Enclosed please find a copy of the Fourth Quarter 2015 Landfill Gas Monitoring Report for Volusia County's Tomoka Farms Road Landfill.

If you have any comments or questions regarding this matter please contact me at (386)947-2952 or jstirk@co.volusia.fl.us.

Sincerely,

Jennifer R. Stirk Environmental Specialist III

Enclosure: Landfill Gas Monitoring Report


CC: file

Fourth Quarter 2015 Tomoka Farms Road Landfill 11/19/2015

Building	CH4 Percent	LEL Percent					
Scale House	0	0					
Maintenance Building	0	0					
Administration Building	0	0					
HHW Building	0	0					
GEL Corp Building	0	0					
WWTP Building	0	0					

Gas Monitoring Report Tomoka Farms Road Landfill

Gas	CH4	LEL						
Probes	Percent	Percent						
MW-1	0	0						
MW-2	0	0						
MW-3	0	0						
MW-4	0	0						
MW-5	0.1	3						
MW-7	0	0						
MW-8	0	0						

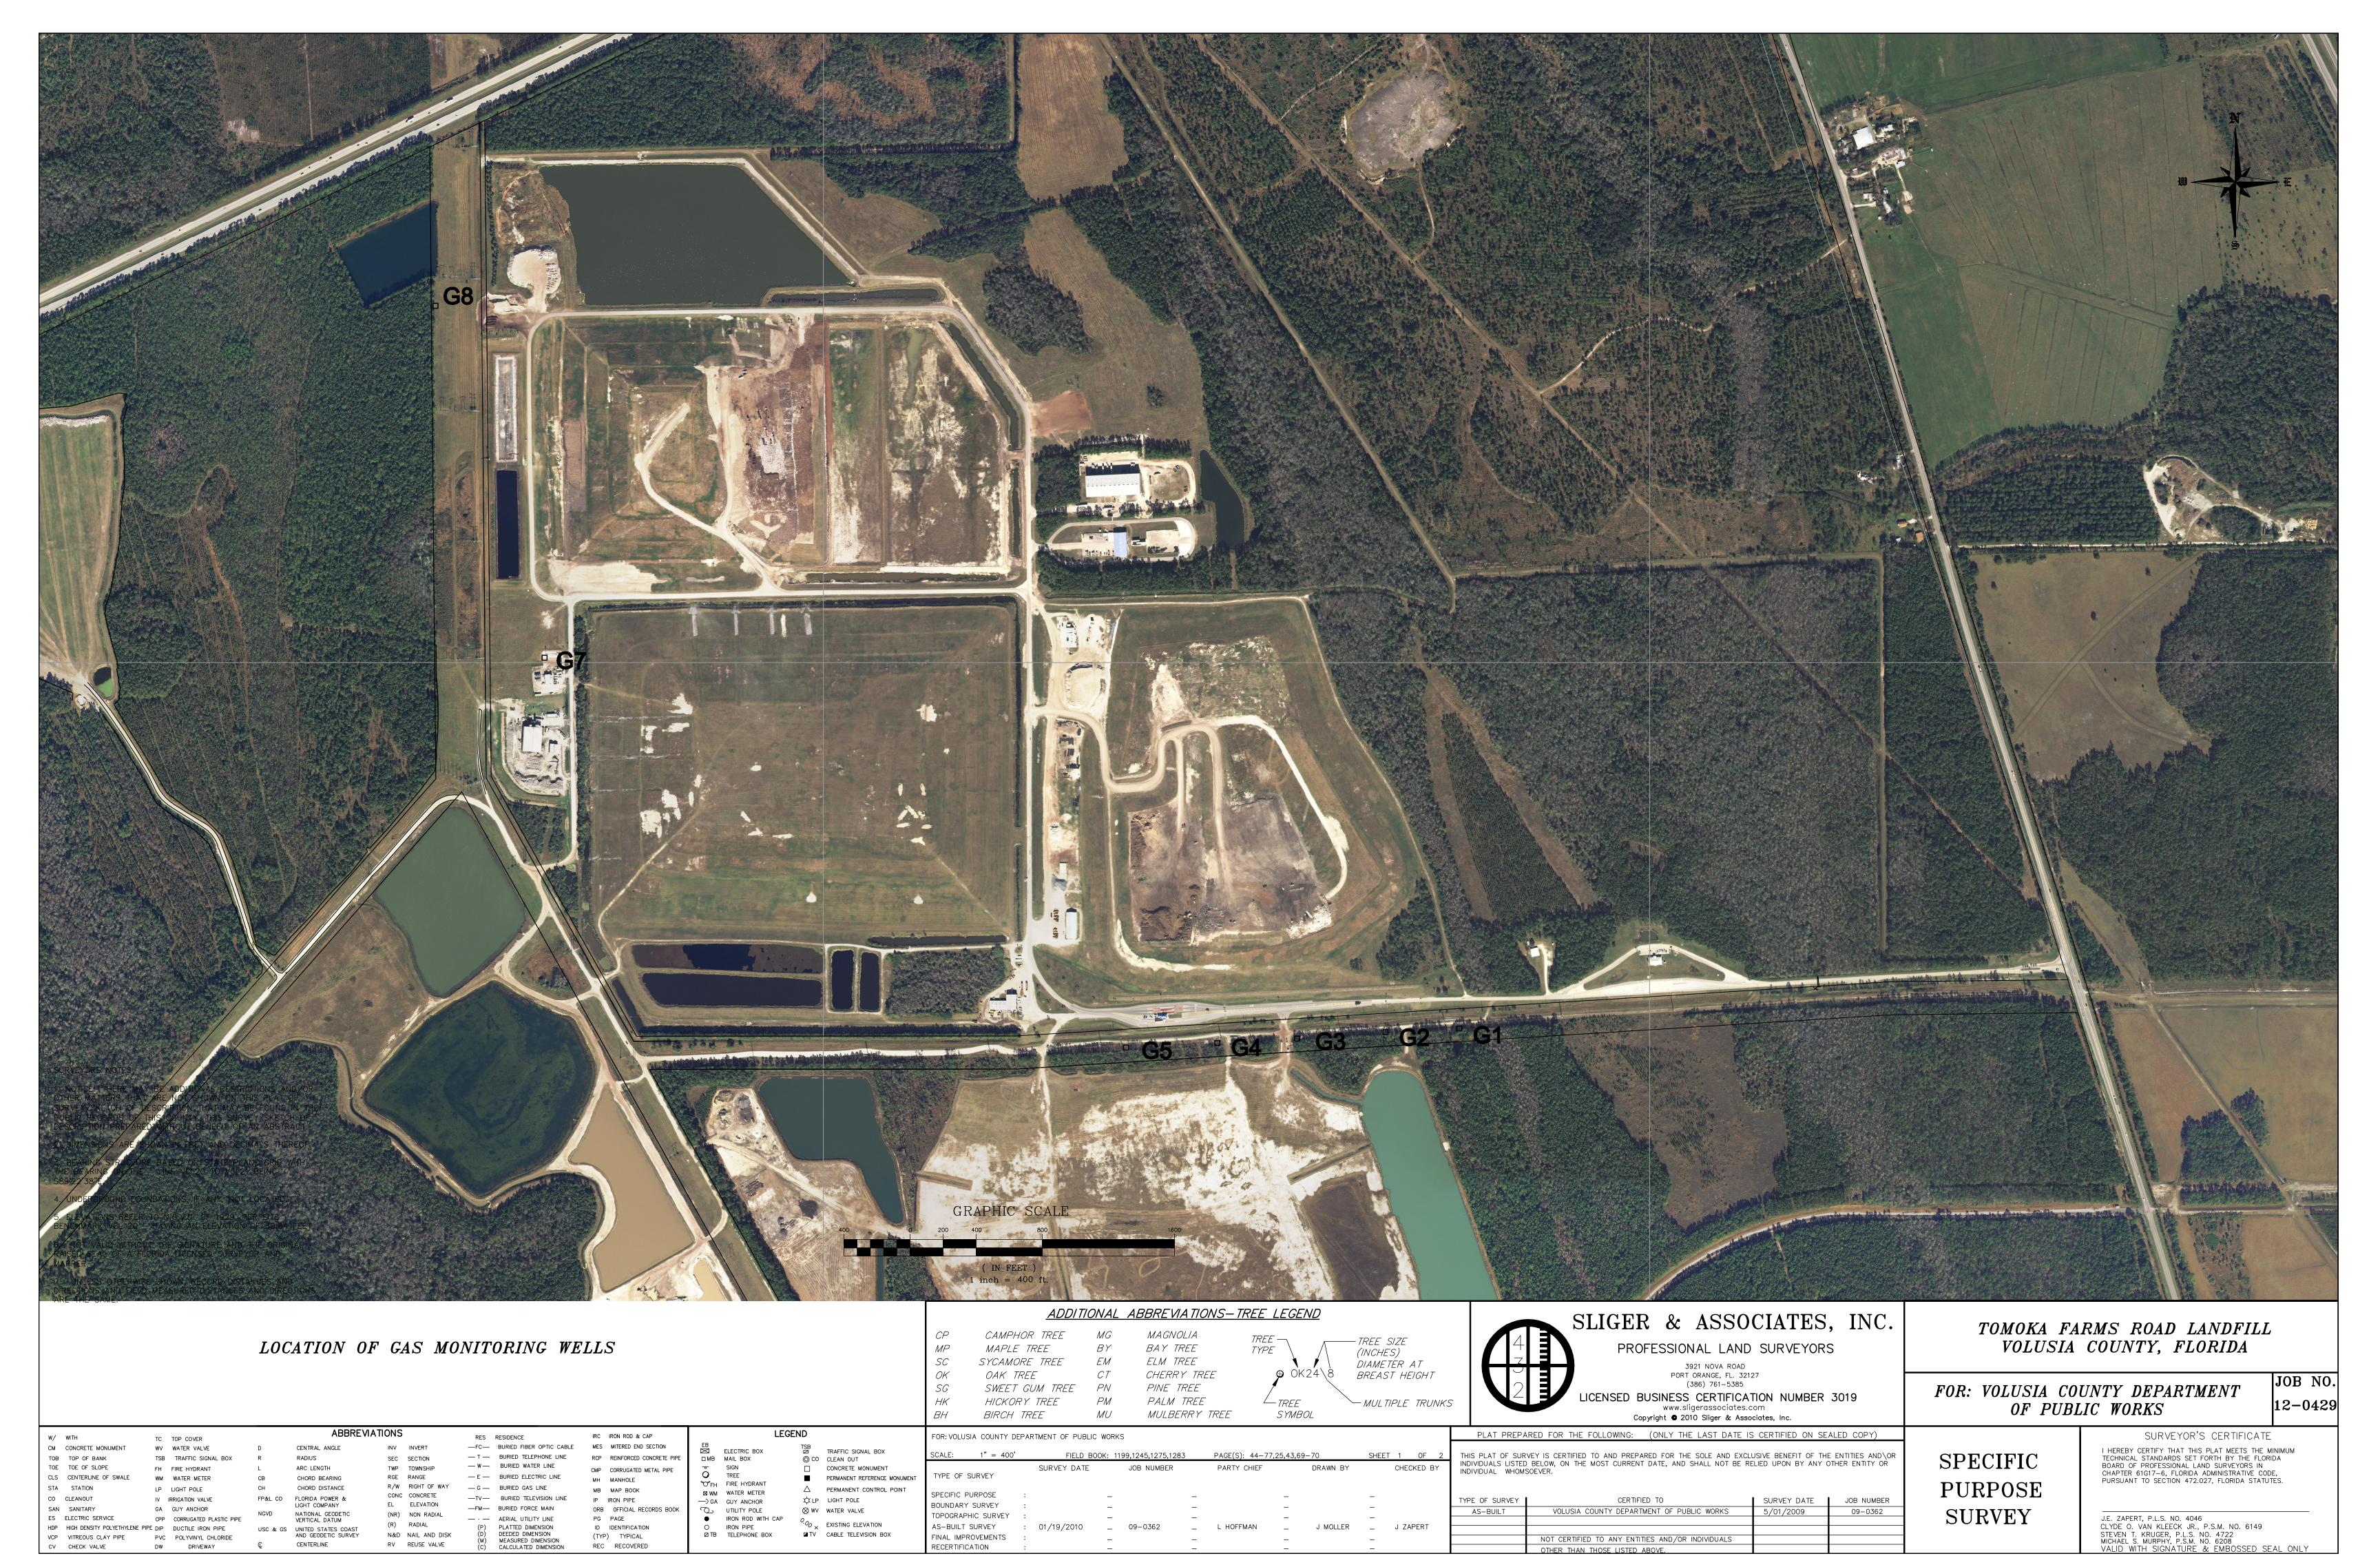

Field Calibration Documentation for the GEM2000

		!									12-01-15	11-28-15	11-19-15				Date	
,	 ,				•						7.04 m	7:20 pm	7:121.7				Time	
													Tomoka	performed	check is	Where	Location	
;											Curar	Vainn	Quinn	,	Check	Performing	Individual	Volusi
											502/35.1/4.0	49.9/34.8/4.0	49.6/35.1/4.0		, 		Results	Volusia County Solid Waste Division
										, ,	yes	re		(Yes or No)	Failed	o r	Passed	Waste
											N/A	N/A	N/A	failed check	with a	associated	Readings	Division
								,			N/A	1/1/	NIA	problem	taken to fix	actions	Corrective	
											Ves	X	Yes			(Yes or No)	Calibrated	
							i		1		é	/ (9			1,	Initials	