= Property Line

## SURVEYOR'S REPORT

## MAP OF RECORD SURVEY:

THE MAP AND REPORT ARE NOT FULL AND COMPLETE WITHOUT THE OTHER (SEE SHEET INDEX IN TITLE BLOCK)

## LEGAL DESCRIPTION:

NOT APPLICABLE. THIS IS NOT A BOUNDARY SURVEY.

### INTENT:

THE INTENT OF THIS RECORD SURVEY IS TO SHOW THE RELATIONSHIP OF FIELD MEASURED IMPROVEMENTS TO THE CONSTRUCTION PLANS REFERENCED IN DATA SOURCE 4.

## ACCURACY:

- I. THE ACCURACY STANDARD USED FOR THIS SURVEY, AS CLASSIFIED IN THE MINIMUM TECHNICAL STANDARDS (5J-17 FAC), IS "COMMERCIAL/HIGH RISK". THE MINIMUM RELATIVE DISTANCE ACCURACY FOR THIS TYPE OF SURVEY IS I FOOT IN 10,000 FEET. THE ACCURACY OBTAINED BY MEASUREMENT AND CALCULATION OF A CLOSED GEOMETRIC FIGURE WAS I FOOT IN 26,668 FEET.
- 2. PRIMARY CONTROL POINT POSITIONS FOR THIS SURVEY ARE CONTROL POINT #506 AND CONTROL POINT #507, AS SHOWN ON THE CONSTRUCTION PLANS REFERENCED IN DATA SOURCE 4, AND AS SHOWN ON THE MAP OF SURVEY. [SEE LIMITATION #11]
- 3. CONTROL ELEVATIONS FOR THIS SURVEY ARE BASED ON A LEVEL LOOP USING DIFFERENTIAL LEVELING TECHNIQUES. CLOSURES ACHIEVED IS 0.006' ERROR IN A 0.18 MILE LOOP LENGTH WHICH EXCEEDS THE MINIMUM ACCURACY REQUIREMENT CALCULATED AT A MAXIMUM MIS-CLOSURE OF 0.021 FEET. [SEE LIMITATION #12]
- 4. HORIZONTAL CONTROL MEASUREMENTS WERE MADE WITH A TRANSIT AND STEEL TAPE, OR DEVICES WITH EQUIVALENT OR HIGHER DEGREES OF ACCURACY.

## DATA SOURCES:

I. THE BASIS OF BEARINGS FOR THIS SURVEY IS THE CALCULATED BEARING BETWEEN CONTROL POINT #506 AND CONTROL POINT #507 [SEE LIMITATION #II], CALCULATED AS BEING S89°55'01"E, AS SHOWN ON THE MAP OF SURVEY.

- 2. HORIZONTAL COORDINATES (IN U.S. SURVEY FEET) FOR THIS SURVEY ARE BASED UPON THE SITE DATUM FOR THE CONSTRUCTION PLANS REFERENCED IN DATA SOURCE 4. CONTROL POINTS UTILIZED ARE SHOWN AS (a) CONTROL POINT #506, A FOUND 1/2" IRON ROD WITH AN ILLEGIBLE CAP (N=1,467,701.20', E=318,429.90'); and (b) CONTROL POINT #507, A FOUND 1/2" IRON ROD WITH AN ILLEGIBLE CAP (N=1,467,700.33', E=319,029.94'). [SEE LIMITATION #II]
- 3. ELEVATIONS ARE BASED ON SITE BENCHMARKS SHOWN ON THE CONSTRUCTION PLANS REFERENCED IN DATA SOURCE 4. SITE BENCHMARKS UTILIZED ARE SHOWN ON THE MAP OF SURVEY AS (a) "SITE TBM #I", A FOUND BOX CUT IN HEADWALL, ELEVATION 51.02'; and (b) "SITE TBM #2", A FOUND RAILROAD SPIKE SET IN A POWER POLE, ELEVATION 49.94'. [SEE LIMITATION #12]
- 4. THIS SURVEY WAS PREPARED WITH THE BENEFIT OF THAT CERTAIN SET OF CONSTRUCTION PLANS PREPARED BY CAMP, DRESSER & McKEE, INC. TITLED "WEST PASCO CLASS I LANDFILL CELL A-4", PROJECT NUMBER 6104-46136, LAST REVISED 6/29/2009, AND ELECTRONIC DRAWING FILE COPIES THEREOF. ALL SHADED BACK INFORMATION IS ACCORDING TO SAID ELECTRONIC DRAWING FILES AND HAS NOT BEEN MODIFIED BESIDES SHADING FOR UNDERLAY PURPOSES.
- 5. THIS SURVEY WAS PREPARED WITHOUT THE BENEFIT OF A TITLE COMMITMENT.
- 6. THIS SURVEY WAS PREPARED WITHTHE BENEFIT OF A RECORD SURVEY PREPARED BY FLORIDA DESIGN CONSULTANTS, INC. TITLED "PASCO COUNTY LANDFILL CELL A-4", JOB NUMBER 2009-70, LAST REVISED 12/21/2009.
- 7. EXISTING GROUND ELEVATIONS AT THE POINT OF EXISTING GAS LINE AND PROPOSED FORCEMAIN INTERSECTIONS AT THE SOUTHEAST AND SOUTHWEST CORNER OF THE SITE WERE PROVIDED BY THE CONTRACTOR ON 4/28/2010.

## LIMITATIONS:

- I. USE OF THIS SURVEY BY ANYONE OTHER THAN THOSE PREPARED FOR/CERTIFIED TO WILL BE THE RE-USERS SOLE RISK WITHOUT LIABILITY TO THE SURVEYOR.
- 2. THERE MAY BE ADDITIONAL EASEMENTS AND/OR RESTRICTIONS AFFECTING THIS PROPERTY THAT MAY OR MAY NOT BE FOUND IN THE PUBLIC RECORDS OF THIS COUNTY.
- 3. PRINTED DIMENSIONS SHOWN ON THE SURVEY SUPERSEDE SCALED DIMENSIONS. THERE MAY BE ITEMS DRAWN OUT OF SCALE TO GRAPHICALLY SHOW THEIR LOCATION.
- 4. CALCULATED (C) GEOMETRY SHOWN HEREON WAS CALCULATED USING FIELD LOCATED POINTS AND CERTAIN PUBLISHED DATA.
- 5. SHOWN ANYWHERE ON THIS SURVEY, THE WORD "CERTIFY" IS UNDERSTOOD TO BE AN EXPRESSION OF A PROFESSIONAL OPINION BASED UPON THE SURVEYOR'S BEST KNOWLEDGE, INFORMATION AND BELIEF, AND THAT IT THUS CONSTITUTES NEITHER A GUARANTEE NOR A WARRANTY.
- 6. THE SHADED BACK INFORMATION SHOWN ON THE MAP OF SURVEY [SEE DATA SOURCE 4] IS FOR INFORMATIONAL PURPOSES ONLY AND WAS NOT MODIFIED FROM IT'S ORIGINAL FORMAT BESIDES SHADING THE INFORMATION FOR UNDERLAY PURPOSES. ALL FEATURES SURVEYED BY FLORIDA DESIGN CONSULTANTS, INC. ARE SHOWN AS SOLID TEXT, LINES AND SYMBOLS WHICH IS NOT SHADED BACK.
- 7. THIS SURVEYOR CERTIFIES ONLY TO THE RECORD INFORMATION SHOWN ON THE MAP OF SURVEY. ALL SHADED BACK IMPROVEMENTS ARE PER THAT CERTAIN ELECTRONIC DRAWING FILE REFERENCED IN DATA SOURCE 4, AND WERE NOT FIELD VERIFIED EXCEPT AS SHOWN ON THE MAP OF SURVEY.
- 8. THE LOCATIONS OF THE UNDERGROUND UTILITIES AND/OR THEIR APPURTENANCES WERE PERFORMED BY A FIELD SURVEY AND ONLY LOCATED AS SHOWN ON THE MAP OF THE SURVEY. ONLY THE UNDERGROUND UTILITIES AND/OR THEIR APPURTENANCES WHICH WERE VISIBLE FROM GROUND LEVEL TO THE SURVEYOR ON THE ACTUAL DAY OF THE FIELD SURVEY WERE LOCATED AND MAPPED. NO EXCAVATIONS OR SUBSURFACE WORK EFFORTS OF ANY KIND WERE PERFORMED BY THE SURVEYOR TO VERIFY THE EXISTENCE OF ANY UNDERGROUND UTILITIES AND/OR THEIR APPURTENANCES. THE SURVEYOR MAKES NO GUARANTEE THAT THE UNDERGROUND UTILITIES AND/OR THEIR APPURTENANCES SHOWN COMPRISE ALL SUCH UTILITIES IN THE AREA, EITHER IN SERVICE OR ABANDONED. THE GAS LINE SHOWN HEREON WAS LOCATED UTILIZING ABOVE GROUND GAS LINE MARKERS.

9. ALL BOUNDARY AND EASEMENT INFORMATION SHOWN HEREON IS SOLELY BASED UPON THOSE CERTAIN MAPS AND ELECTRONIC DRAWING FILES REFERENCED IN DATA SOURCE 4. FLORIDA DESIGN CONSULTANTS, INC. AND THE SURVEYOR AND MAPPER IN RESPONSIBLE CHARGE DOES NOT GUARANTEE THE VALIDITY OF SAID BOUNDARY INFORMATION OTHER THAN CONFORMATION TO SAID MAPS AND ELECTRONIC DRAWING FILES.

10. ORIGINAL FIELD WORK WAS COMPLETED ON 1/19/2010 AND IS CONTAINED IN FIELD BOOK 1526. FIELD WORK FOR REVISION 2 WAS COMPLETED ON 3/3/2010 AND IS CONTAINED IN FIELD BOOK 1526. FIELD WORK FOR REVISION 3 WAS COMPLETED ON 3/15/2010, IS CONTAINED IN FIELD BOOK 1526 AND IS LIMITED TO THE LINER EDGE AND PROPOSED FORCEMAIN LOCATION AS MARKED BY THE CONTRACTOR. FIELD WORK FOR REVISION 4 WAS COMPLETED ON 3/31/2010, IS CONTAINED IN FIELD BOOK 1526 AND IS LIMITED TO THE SPOT GRADES ON THE PROPOSED POND. FIELD WORK FOR REVISION 5 WAS COMPLETED ON 4/7/2010, IS CONTAINED IN FIELD BOOK 1526 AND IS LIMITED TO THE SPOT GRADES ON THE PROPOSED POND BEFORE THE LEACHATE SYSTEM WAS INSTALLED. FIELD WORK FOR REVISION 6 WAS COMPLETED ON 4/13/2010, IS CONTAINED IN FIELD BOOK 1526 AND IS LIMITED TO THE SPOT GRADES ON THE WEST 1/3 OF THE PROPOSED POND. FIELD WORK FOR REVISION 7 WAS COMPLETED ON 4/26/2010, IS CONTAINED IN FIELD BOOK 1526 AND IS LIMITED TO THE EXISTING 12" GAS LINE LOCATIONS AND DIMENSIONS TO THE PLAN FORCEMAIN FROM THE FIELD LOCATED EDGE OF PAVEMENT. REVISION 7 ALSO REMOVED THE PROPOSED FORCEMAIN LOCATION AS MARKED BY THE CONTRACTOR ADDED DURING REVISION 3. REVISION 8 IS LIMITED TO ADDING TIES TO THE GAS LINE AND EXISTING GROUND ELEVATION AT CROSSINGS (NO FIELD WORK PERFORMED). REVISION 9 IS LIMITED TO ADDING CROSSING DETAILS AT EAST AND WEST GAS LINE CROSSINGS (NO FIELD WORK PERFORMED). FIELD WORK FOR REVISION 10 COMMENCED ON 6/10/2010 AND WAS COMPLETED ON 7/8/2010, IS CONTAINED IN FIELD BOOK 1526 PAGES 70-73 AND IS LIMITED TO ADDING FORCEMAIN, LEACHATE DETECTION SYSTEM, LEACHATE COLLECTION SYSTEM LOCATIONS AND GROUNG ELEVATIONS. FIELD WORK FOR REVISION II WAS PERFORMED ON 7/22/2010, IS CONTAINED IN FIELD BOOK 1526 PAGE 69 AND IS LIMITED TO ADDING LEACHATE SYSTEM AND STORM DRAIN PIPE LOCATIONS. FIELD WORK FOR REVISION 12 COMMENCED 8/26/2010 AND COMPLETED ON 10/19/2010, IS CONTAINED IN FIELD BOOK 1526 PAGES 68-61 AND IS LIMITED TO ADDING FORCEMAIN, WATER LINE, DRAINAGE STRUCTURES, LEACHATE SYSTEM, FINAL GROUND ELEVATIONS AND LIMITS OF SOD. FIELD WORK FOR REVISION 13 WAS PERFORMED ON 10/21/2010 AND IS LIMITED TO ADDING LIMITS OF SOD AT THE NORTHEAST CORNER. FIELD WORK FOR REVISION 14 WAS PERFORMED ON 11/5/2010 AND IS LIMITED TO ADDING SOD AREAS, LEACHATE SYSTEM, PARKING AND STORM DRAIN PIPE LOCATIONS. REVISION 15 IS LIMITED TO ADDING COORDINATES ON THE MONITORING WELLS AT THE CLIENTS REQUEST (NO FIELD WORK PERFORMED). REVISION 16 IS LIMITED TO ADDING LATITUDE AND LONGITUDE ON THE MONITORING WELLS (NO FIELD WORK PERFORMED). FIELD WORK FOR REVISION 17 WAS PERFORMED ON 2/23/2011, IS CONTAINED IN FIELD BOOK 1526 AND IS LIMITED TO ADDING LEACHATE SYSTEM LOCATIONS AND BORE DATA AT THE STORAGE TANK SHOWN ON SHEET 3. REVISE MONITOR WELL INFORMATION FROM PLAN CORDINATES TO STATE PLANE COORDINATES NORTH AMERICAN DATUM 1983/1990 ADJUSTMENT FLORIDA WEST ZONE (902).

II. THERE WERE TWO CONTROL POINT #506's ACCORDING TO THE CONSTRUCTION PLANS REFERENCED IN DATA SOURCE 4 [SEE SHEET G-2 "EXISTING CONDITIONS, CONSTRUCTION LIMITS, AND MONITORING WELLS" OF SAID CONSTRUCTION PLANS FOR EXAMPLE]. THE EASTERN MOST CONTROL POINT LABELED AS CONTROL POINT #506 ON SAID CONSTRUCTION PLANS WAS RENUMBERED BY THIS SURVEYOR TO CONTROL POINT #507 FOR IDENTIFICATION PURPOSES ONLY.

12. FLORIDA DESIGN CONSULTANTS, INC. PERFORMED A LEVEL BENCH RUN FROM SITE TBM #I, THROUGH CONTROL POINTS #506 AND #507 (SEE LIMITATION #II), TO SITE TBM #2. IT WAS DISCOVERED THAT THE ELEVATION SHOWN ON THE CONSTRUCTION PLANS [SEE DATA SOURCE #4] FOR CONTROL POINT #506 IS NOT CONSISTENT WITH THE ELEVATIONS SHOWN FOR THE SITE BENCHMARKS UTILIZED AND CONTROL POINT #507. THE ELEVATION SHOWN FOR SAID CONTROL POINT #506 IS 51.59'. BASED ON MEASUREMENTS BY THIS SURVEYOR THE ELEVATION OF SAID CONTROL POINT #506, UTILIZING THE BENCHMARKS AS PROVIDED, IS 50.38'. [SEE ACCURACY #3]

13. THE LOCATION OF AS-BUILT UNDERGROUND UTILITY LINES SHOWN HEREON IS BASED ON INFORMATION PROVIDED BY THE CONTRACTOR AND FIELD SURVEY EFFORTS. AS NOTED ABOVE THE UTILITY CONTRACTOR MARKED CONSTRUCTED UNDERGROUND UTILITY LINES WITH EITHER A P.V.C. STANDPIPE OR WOOD STAND WITH A DIMENSION MARKED TO THE TOP OF PIPE IN ORDER FOR THE SURVEYOR TO OBTAIN A HORIZONTAL AND VERTICAL LOCATION ON TOP OF THE CONSTRUCTED UTILITY LINE. THE PIPELINE WAS BACK FILLED PRIOR TO THE RECORD SURVEY EFFORT WITH NO VISIBLE EVIDENCE TO SUPPORT THE ACTUAL PIPELINE LOCATION. THE SURVEYOR MAKES NO GUARANTEE THAT THE STANDPIPE OR WOOD STAND PLACED BY THE CONTRACTOR WAS INSTALLED ACCURATELY ON TOP OF THE PIPE. THE UNDERSIGNED SURVEYOR MAKES NO GUARANTEE AS TO THE ACTUAL LOCATION OF ANY UNDERGROUND UTILITY LINES. TO AVOID DAMAGE TO EXISTING FACILITIES THE LOCATION OF EXISTING PIPELINES MUST BE VERIFIED PRIOR TO ANY EXCAVATION OR UNDERGROUND CONSTRUCTION ACTIVITIES BY USING GOOD CONSTRUCTION PRACTICES AND CONTACTING SUNSHINE STATE ONE CALL IN ACCORDANCE WITH FLORIDA STATUTES 553.851(1979).

## BOUNDARY INCONSISTENCIES:

NOT APPLICABLE. THIS IS NOT A BOUNDARY SURVEY.

## APPARENT PHYSICAL USE:

THE SUBJECT PROPERTY IS PART OF A SOLID WASTE LANDFILL, IS UNDER CONSTRUCTION AND CONTAINS IMPROVEMENTS NOT SHOWN ON THE MAP OF SURVEY.

## EASEMENTS/RIGHT-OF-WAY:

NOT APPLICABLE. THIS IS NOT A BOUNDARY SURVEY

## PREPARED FOR:

RIPA & ASSOCIATES, INC.

## CERTIFIED TO:

SUBJECT:

RIPA & ASSOCIATES, INC.

## SURVEYOR AND MAPPER IN RESPONSIBLE CHARGE:

DENNIS BOGGS PROFESSIONAL SURVEYOR AND MAPPER LICENSE NUMBER LS 6069 STATE OF FLORIDA

AC = Acres

AC	= Acres	1110011				
A/C	= Air Conditioner	FOP	= Found Open End Iron Pipe	PLS	= Professional Land Surveyor	
ADW	= Asphalt Driveway	FPB	= Electric Power Box	POB	= Point of Beginning	
ADS	= Advance Drainage Systems	FPC	= Electric Power Company	POC	= Point of Commencement	c En
ASPH	= Asphalt	FPP	= Found Pinched Iron Pipe	POL	= Point on Line	Dept. of Env
B/C	= Back of Curb	FRRS	= Found Railroad Spike	PRM	= Permanent Reference Monument	Dopte
BCCM	= Board of County Commissioners Minutes Book	FT	= Feet	PSM	= Professional Surveyor and Mapper	Flore
BFPD	= Back Flow Prevention Device	F/T	= Fence Tie	PT	= Point of Tangency \ Point	
BLDG	= Building	FXC	= Found X-cut	PVC	= Polyvinyl Chloride Pipe	MAY (
BNDY	= Boundary	G/A	= Guy Wire Anchor	(R)	= Recorded Data	•
ВО	= Blow Off Valve	GE	= Grate Elevation	RCP	= Reinforced Concrete Pipe	
(C)	= Calculated Data	GI	= Grate Inlet	RLS	= Registered Land Surveyor	~ +hw/
C/C	= Covered Concrete	GV	= Gas Valve	RNG	= Range	Southwe
CCCL	= Coastal Construction Control Line	ΙE	= Invert Elevation	R/W	= Right of Way	
CCR	= Certified Corner Record	INV	= Invert	S	= South	
CDW	= Concrete Driveway	LB	= Corporate Certification Number	(S)	= Survey Data (See Data Source 5)	
CI	= Curb Inlet	LCS	= Leachate Collection System	SCM	= Set Concrete Monument, 4"x4", PRM LB	6707
Q.	= Center Line	LDS	= Leachate Detection System	SCM(W)	= Set Concrete Monument, 4"x4", FDC LB	6707 WITNESS PT
CLF	= Chain Link Fence	LF	= Linear Feet	SEC	= Section	
CM	= Concrete Monument	LP	= Light Pole	SHW	= Seasonal High Water Elevation	
CMP	= Corrugated Metal Pipe	LS	= Licensed Surveyor	SIR	= Set 5/8"Iron Rod and Cap, FDC LB 670	
CO	= Clean out	MAS	= Masonry	SIR(W)	= Set 5/8"Iron Rod and Cap, FDC LB 670	7 WITNESS PT
CONC	= Concrete	MES	= Mitered End Section	SMH	= Sanitary Manhole	
COR	= Corner	МН	= Manhole	SN&D	= Set Nail and Disk, FDC LB 6707	
CPB	= Condo Plat Book	MHW	= Mean High Water	SN&D(W)	= Set Nail and Disk, FDC LB 6707 WITNES	S PT
C/S	= Concrete Slab	MOL	= More or Less	SQ	= Square	
C/T	= Curb Tie	N	= North	SR	= State Road	
DB	= Deed Book	N/C	= No Cap	STY	= Story	
DCVA	= Double Check Valve Assembly	N/F	= Not Found	SWFWMD	= Southwest Florida Water Management Dis	strict
DNR	= Department of Natural Resources	N/S	= Not Set	S/W	= Sidewalk	
DEPT	= Department	N/A	= Not Accessible/Not Complete	TBM	= Temporary Benchmark	
DIA	= Diameter	NAD	= North American Datum	TBO	= Temporary Blow-off	
DIP	= Ductile Iron Pipe	NAVD	= North American Vertical Datum	TOB	= Top of Bank	
DMH	= Drainage Manhole	NGS	= National Geodetic Survey	TRAV	= Traverse	
Е	= East	NGVD	= National Geodetic Vertical Datum	(TYP)	= Typical	
ECMP	= Elliptical Corrugated Metal Pipe	NP	= Normal Pool Elevation	TWP	= Township	
EL	= Elevation	(NR)	= Non Radial	U/P	= Utility Pole	
EOW	= Edge of Water	O/A	= Overall	VCP	= Vitrified Clay Pipe	
E/P	= Edge of Pavement	OHW	= Overhead Wire	W	= West	
EOP	= End of Pipe	ORB	= Official Record Book	W/	= With	
ESMT	= Easement	(PA)	= Property Appraisers Map Data	W/F	= Wood Fence	
(F)	= Field Data	PB	= Plat Book	WL	= Water Line	
FCM	= Found Concrete Monument	PC	= Point of Curvature	WUP	= Wood Utility Pole	
FDOT	= Florida Department of Transportation	PCED	= Pinellas County Engineering Department	W/T	= Wall Tie	
FH	= Fire Hydrant	PACED	= Pasco County Engineering Department	WV	= Water Valve	
FIR	= Found Iron Rod and Cap	PCSD	= Pinellas County Survey Department	xx*	= Degrees	
FL	= Fire Line			xx'	= Minutes (Bearings)	
FND	= Found	PACSD	= Pasco County Survey Department	xx"	= Seconds (Bearing)	
FN&D	= Found Nail and Disk	PCP	= Permanent Control Point	xx'	= Feet (Distances)	
FFE	= Finished Floor Elevation	PG(S)	= Pages	^^	, oct (Diotalioos)	
112	- I maned Floor Elevation	PI	= Point of Intersection			
		PID	= Permanent Identification Number			

FN&TT = Found Nail and Tin Tab

## INETYPE LEGEND

		— = Boundary Line
		— = Center Line
		— = Easement Line
		— = Edge of Water
- 121 (		— = Jurisdictional Line
		— = Right-Of-Way Line
		— = Section Line
	^ ^	— = Top Bank or Top of Berm
		·· = Toe of Slope or Grade Break
GAS	GAS	— = Gas Line (See Limitation 8)
		= Proposed Forcemain
FM	FM	— = Forcemain
ST	ST	— = Storm Sewer Line (See Limitation 12)

## DOCUMENT LEGEND

(C) = CALCULATED DATA (F) = FIELD DATA(P) = PLAN DATA (SEE DATA SOURCE 4)

## SYMBOLS LEGEND

⊠ = Water Service (one whip)

Water Service (two whips)



SEE LIMITATIONS 10

LAST DATE OF ORIGINAL FIELD WORK SEE LIMITATIONS 10

NONE

SOUTHWEST DISTRICT

QUALITY CONTROL

# FLORIDA DESIGN CONSULTANTS, INC.

ENGINEERS, ENVIRONMENTALISTS, SURVEYORS & PLANNERS 3030 Starkey Blvd. New Port Richey FL, 34655 Tel: (727) 849-7588 - Fax: (727) 848-3648

> Certificate of Authorization: LB 6707 State of Florida

PASCO COUNTY LANDFILL

SHEET DESCRIPTION:

REC

ORD	SURVEY	
REPORT AND	LEGENDS	


	18	4-19-2011	REVISE LATITUDE AND LONGITUDE ON MONITOR WELLS (NO FIELD WORK PERFORMED)	DB	DB	SHEET INDEX
	17	3-1-2011	ADD LEACHATE SYSTEM BORE LOCATION	LCS	DB	1. SURVEYOR'S REPORT
1	16	2-18-2011	ADD LATITUDE AND LONGITUDE ON MONITORING WELLS (NO FIELD WORK PERFORMED)	DB	DB	2-3. MAP OF SURVEY - UTILITIES
	15	11-11-2010	ADD LEACHATE SYSTEM ELEVATION	LCS	DB	4. MAP OF SURVEY - CELL ELEVATIONS
	14	11-8-2010	ADD SOD AREAS, LEACHATE SYSTEM, PARKING AND STORM DRAIN PIPE LOCATIONS	LCS	DB	5. MAP OF SURVEY - MONITOR WELLS
	1-13	VARIOUS	SEE LIMITATIONS 10	JEB	DB	ADDITIONS OR DELETIONS TO SURVEY MAPS
	NO.	DATE	REVISIONS	BY	QUALITY	OR REPORTS BY OTHER THAN THE SIGNING PARTY OR PARTIES IS PROHIBITED.

THE MAP AND REPORT ARE NOT FULL AND COMPLETE WITHOUT THE OTHER 2009-70 EPN. N/A PROJECT DATA BASE. 2009-70-CON FIELD BOOK NUMBER & PAGES.

 $\frac{25.2'}{1}$  = Calculated Dimension from Structure

to Boundary / Right-of-Way Line

SURVEY MAP AND REPORT OR THE COPIES THEREOF ARE NOT VALID WITHOUT THE SIGNATURE AND THE ORIGINAL RAISED SEAL OF A FLORIDA LICENSED SURVEYOR AND MAPPER. PROFESSIONAL SURVEYOR AND MAPPER LICENSE NUMBER LS 6069 STATE OF FLORIDA

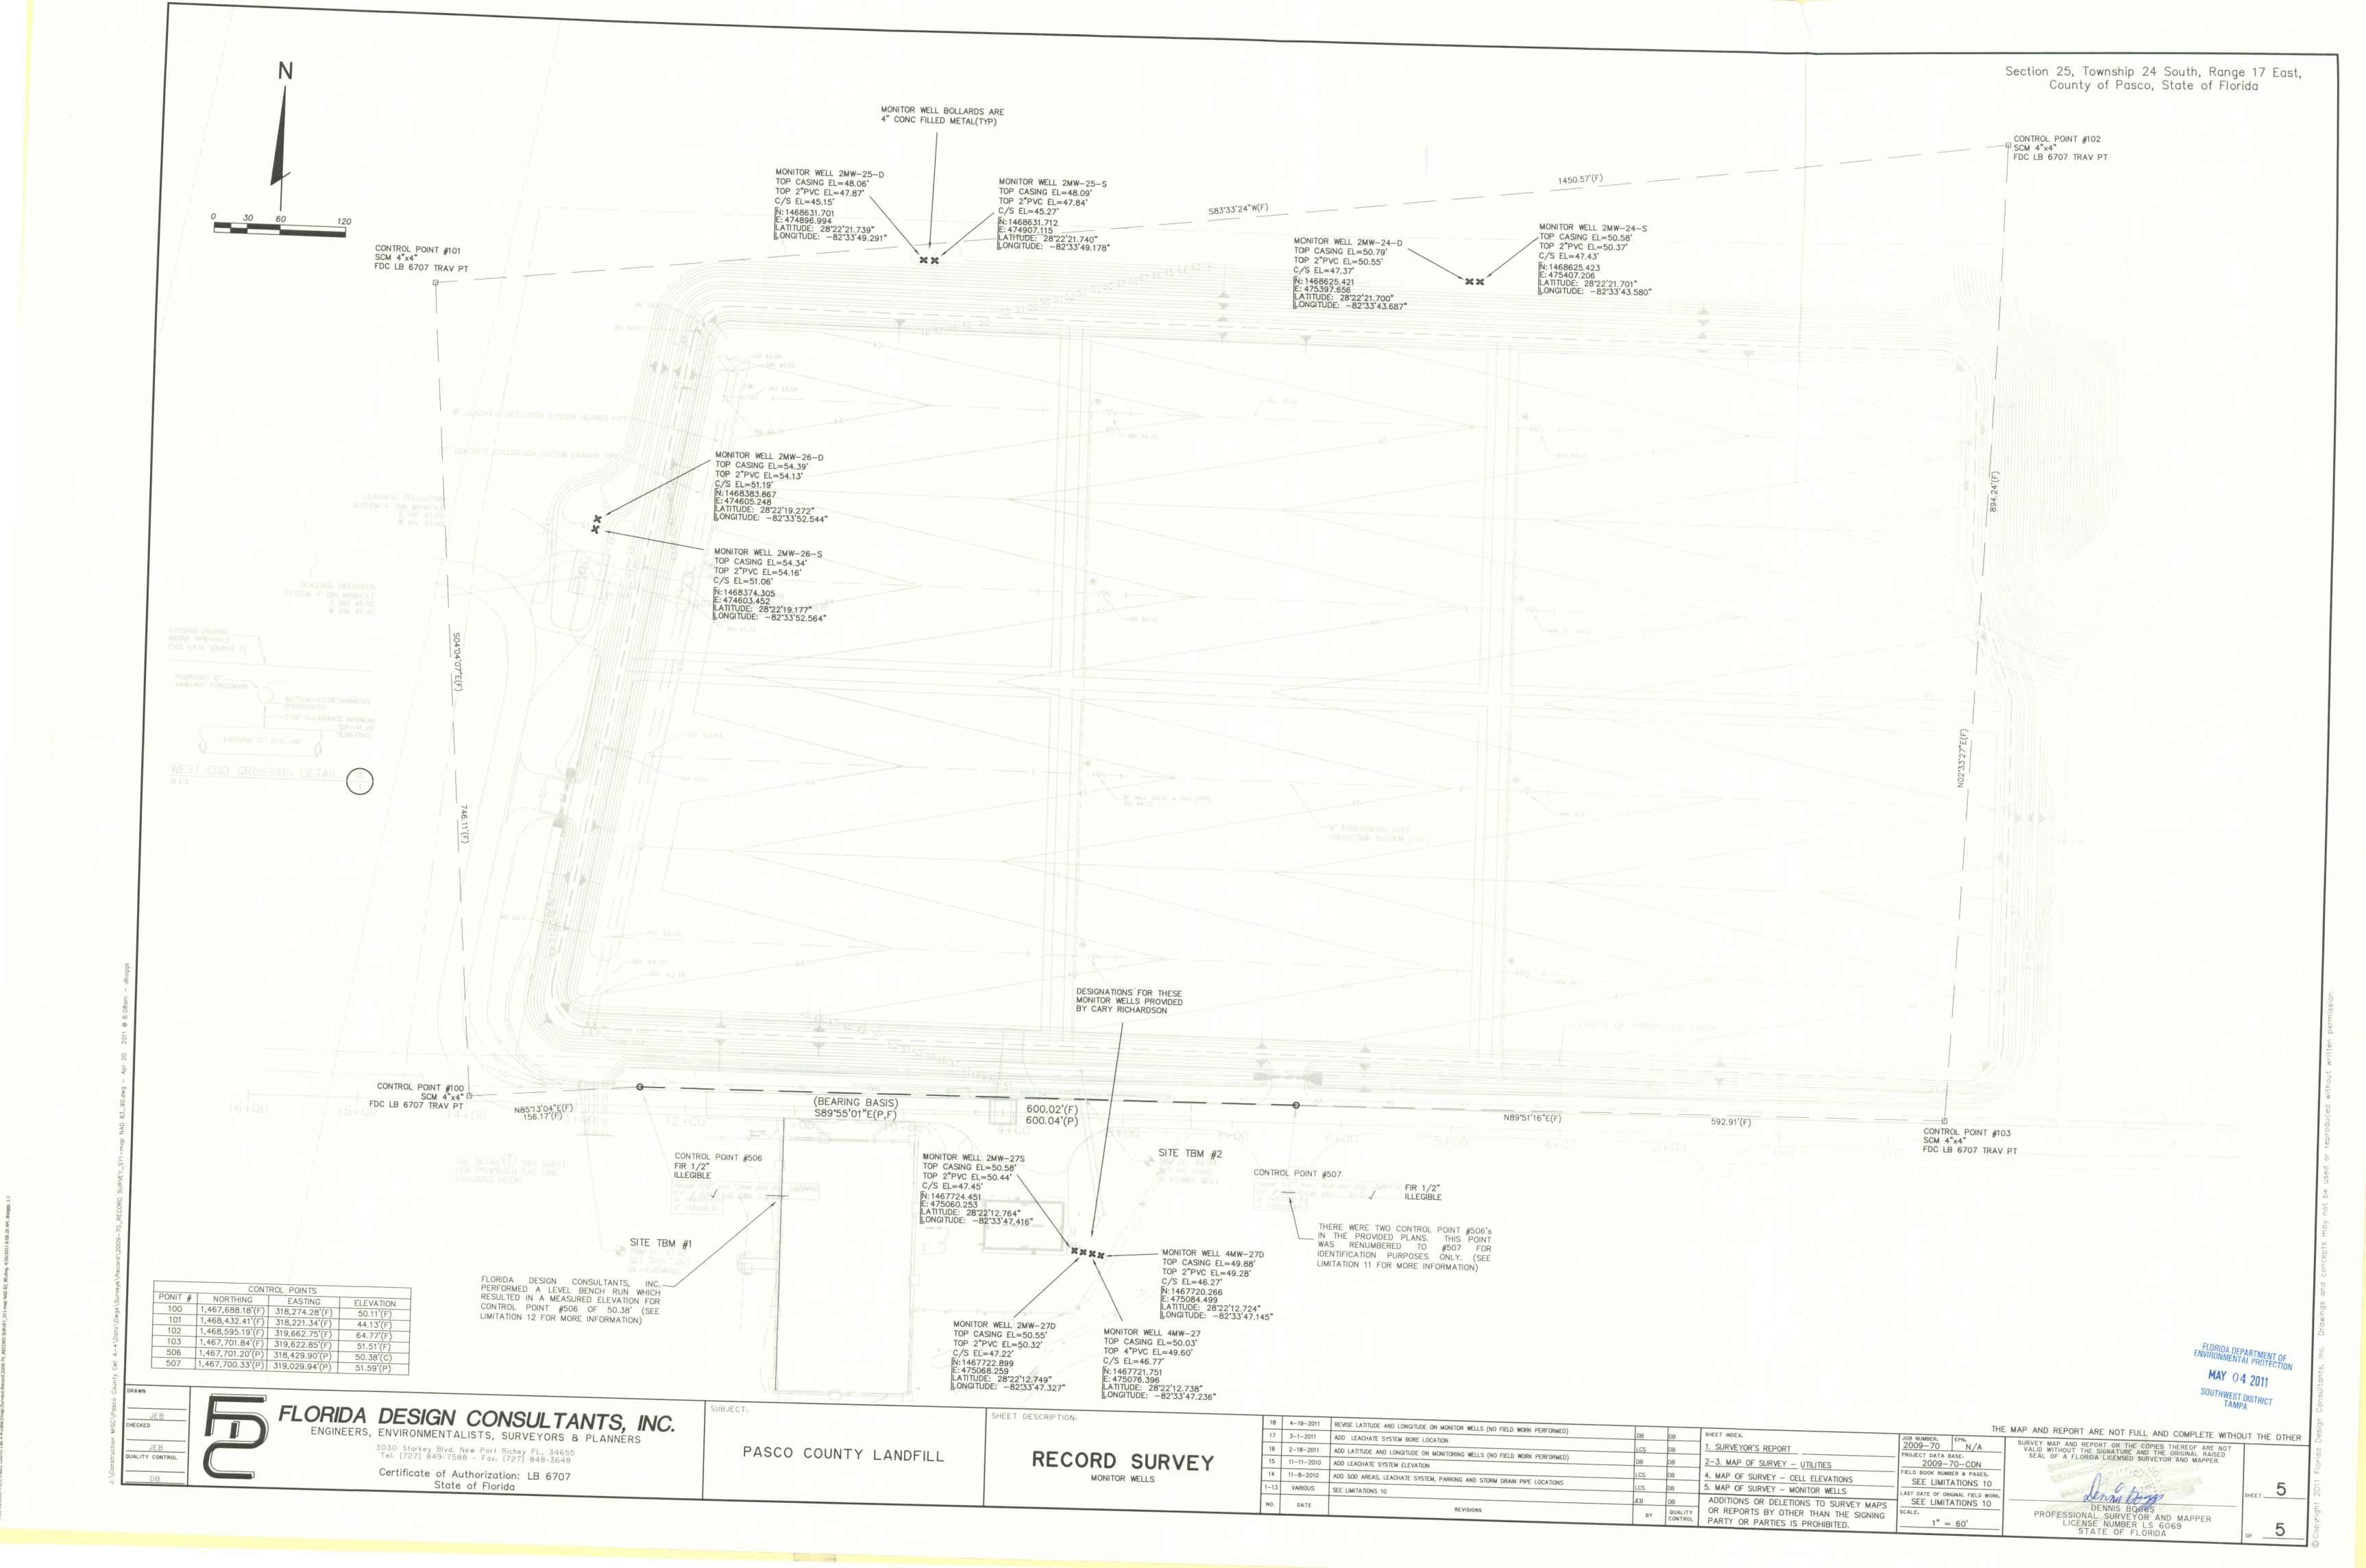

# LEGAL DESCRIPTION:

IN TITLE BLOCK)

NOT APPLICABLE. THIS IS NOT A BOUNDARY SURVEY.

### INTENT:

THE INTENT OF THIS RECORD SURVEY IS TO SHOW THE RELATIONSHIP OF FIFID MEASURED IMPROVEMENTS TO THE CONSTRUCTION PLANS REFERENCED IN DATA SOURCE 4.

## ACCURACY:

- I. THE ACCURACY STANDARD USED FOR THIS SURVEY, AS CLASSIFIED IN THE MINIMUM TECHNICAL STANDARDS (5J-17 FAC), IS "COMMERCIAL/HIGH RISK". THE MINIMUM RELATIVE DISTANCE ACCURACY FOR THIS TYPE OF SURVEY IS I FOOT IN 10,000 FEET. THE ACCURACY OBTAINED BY MEASUREMENT AND CALCULATION OF A CLOSED GEOMETRIC FIGURE WAS I FOOT IN 26,668 FEET.
- 2. PRIMARY CONTROL POINT POSITIONS FOR THIS SURVEY ARE CONTROL POINT #506 AND CONTROL POINT #507, AS SHOWN ON THE CONSTRUCTION PLANS REFERENCED IN DATA SOURCE 4, AND AS SHOWN ON THE MAP OF SURVEY. [SEE LIMITATION #11]
- 3. CONTROL ELEVATIONS FOR THIS SURVEY ARE BASED ON A LEVEL LOOP USING DIFFERENTIAL LEVELING TECHNIQUES. CLOSURES ACHIEVED IS 0.006' ERROR IN A 0.18 MILE LOOP LENGTH WHICH EXCEEDS THE MINIMUM ACCURACY REQUIREMENT CALCULATED AT A MAXIMUM MIS-CLOSURE OF 0.021 FEET. [SEE LIMITATION #12]
- 4. HORIZONTAL CONTROL MEASUREMENTS WERE MADE WITH A TRANSIT AND STEEL TAPE, OR DEVICES WITH EQUIVALENT OR HIGHER DEGREES OF ACCURACY.

## DATA SOURCES:

- I. THE BASIS OF BEARINGS FOR THIS SURVEY IS THE CALCULATED BEARING BETWEEN CONTROL POINT #506 AND CONTROL POINT #507 [SEE LIMITATION #11], CALCULATED AS BEING S89°55'01"E, AS SHOWN ON THE MAP OF SURVEY.
- 2. HORIZONTAL COORDINATES (IN U.S. SURVEY FEET) FOR THIS SURVEY ARE BASED UPON THE SITE DATUM FOR THE CONSTRUCTION PLANS REFERENCED IN DATA SOURCE 4. CONTROL POINTS UTILIZED ARE SHOWN AS (a) CONTROL POINT #506, A FOUND 1/2" IRON ROD WITH AN ILLEGIBLE CAP (N=1,467,701.20', E=318,429.90'); and (b) CONTROL POINT #507, A FOUND 1/2" IRON ROD WITH AN ILLEGIBLE CAP (N=1,467,700.33', E=319,029.94'). [SEE LIMITATION #11]
- 3. ELEVATIONS ARE BASED ON SITE BENCHMARKS SHOWN ON THE CONSTRUCTION PLANS REFERENCED IN DATA SOURCE 4. SITE BENCHMARKS UTILIZED ARE SHOWN ON THE MAP OF SURVEY AS (a) "SITE TBM #I", A FOUND BOX CUT IN HEADWALL, ELEVATION 51.02'; and (b) "SITE TBM #2", A FOUND RAILROAD SPIKE SET IN A POWER POLE, ELEVATION 49.94'. [SEE LIMITATION #12]
- 4. THIS SURVEY WAS PREPARED WITH THE BENEFIT OF THAT CERTAIN SET OF CONSTRUCTION PLANS PREPARED BY CAMP, DRESSER & McKEE, INC. TITLED "WEST PASCO CLASS I LANDFILL CELL A-4". PROJECT NUMBER 6104-46136, LAST REVISED 6/29/2009. AND ELECTRONIC DRAWING FILE COPIES THEREOF. ALL SHADED BACK INFORMATION IS ACCORDING TO SAID ELECTRONIC DRAWING FILES AND HAS NOT BEEN MODIFIED BESIDES SHADING FOR UNDERLAY PURPOSES.
- 5. THIS SURVEY WAS PREPARED WITHOUT THE BENEFIT OF A TITLE COMMITMENT.
- 6. THIS SURVEY WAS PREPARED WITHTHE BENEFIT OF A RECORD SURVEY PREPARED BY FLORIDA DESIGN CONSULTANTS, INC. TITLED "PASCO COUNTY LANDFILL CELL A-4", JOB NUMBER 2009-70, LAST REVISED 12/21/2009.
- 7. EXISTING GROUND ELEVATIONS AT THE POINT OF EXISTING GAS LINE AND PROPOSED FORCEMAIN INTERSECTIONS AT THE SOUTHEAST AND SOUTHWEST CORNER OF THE SITE WERE PROVIDED BY THE CONTRACTOR ON 4/28/2010.

# LIMITATIONS:

- I. USE OF THIS SURVEY BY ANYONE OTHER THAN THOSE PREPARED FOR/CERTIFIED TO WILL BE THE RE-USERS SOLE RISK WITHOUT LIABILITY TO THE SURVEYOR.
- 2. THERE MAY BE ADDITIONAL EASEMENTS AND/OR RESTRICTIONS AFFECTING THIS PROPERTY THAT MAY OR MAY NOT BE FOUND IN THE PUBLIC RECORDS OF THIS COUNTY.
- 3. PRINTED DIMENSIONS SHOWN ON THE SURVEY SUPERSEDE SCALED DIMENSIONS. THERE MAY BE ITEMS DRAWN OUT OF SCALE TO GRAPHICALLY SHOW THEIR LOCATION.
- 4. CALCULATED (C) GEOMETRY SHOWN HEREON WAS CALCULATED USING FIELD LOCATED POINTS AND CERTAIN PUBLISHED DATA.
- 5. SHOWN ANYWHERE ON THIS SURVEY, THE WORD "CERTIFY" IS UNDERSTOOD TO BE AN EXPRESSION OF A PROFESSIONAL OPINION BASED UPON THE SURVEYOR'S BEST KNOWLEDGE. INFORMATION AND BELIEF, AND THAT IT THUS CONSTITUTES NEITHER A GUARANTEE NOR A
- 6. THE SHADED BACK INFORMATION SHOWN ON THE MAP OF SURVEY [SEE DATA SOURCE 4] IS FOR INFORMATIONAL PURPOSES ONLY AND WAS NOT MODIFIED FROM IT'S ORIGINAL FORMAT BESIDES SHADING THE INFORMATION FOR UNDERLAY PURPOSES. ALL FEATURES SURVEYED BY FLORIDA DESIGN CONSULTANTS, INC. ARE SHOWN AS SOLID TEXT, LINES AND SYMBOLS WHICH IS NOT SHADED BACK.
- 7. THIS SURVEYOR CERTIFIES ONLY TO THE RECORD INFORMATION SHOWN ON THE MAP OF SURVEY. ALL SHADED BACK IMPROVEMENTS ARE PER THAT CERTAIN ELECTRONIC DRAWING FILE REFERENCED IN DATA SOURCE 4, AND WERE NOT FIELD VERIFIED EXCEPT AS SHOWN ON THE MAP OF SURVEY.
- 8. THE LOCATIONS OF THE UNDERGROUND UTILITIES AND/OR THEIR APPURTENANCES WERE PERFORMED BY A FIELD SURVEY AND ONLY LOCATED AS SHOWN ON THE MAP OF THE SURVEY. ONLY THE UNDERGROUND UTILITIES AND/OR THEIR APPURTENANCES WHICH WERE VISIBLE FROM GROUND LEVEL TO THE SURVEYOR ON THE ACTUAL DAY OF THE FIELD SURVEY WERE LOCATED AND MAPPED. NO EXCAVATIONS OR SUBSURFACE WORK EFFORTS OF ANY KIND WERE PERFORMED BY THE SURVEYOR TO VERIFY THE EXISTENCE OF ANY UNDERGROUND UTILITIES AND/OR THEIR APPURTENANCES. THE SURVEYOR MAKES NO GUARANTEE THAT THE UNDERGROUND UTILITIES AND/OR THEIR APPURTENANCES SHOWN COMPRISE ALL SUCH UTILITIES IN THE AREA, EITHER IN SERVICE OR ABANDONED. THE GAS LINE SHOWN HEREON WAS LOCATED UTILIZING ABOVE GROUND GAS LINE MARKERS.

- 9. ALL BOUNDARY AND EASEMENT INFORMATION SHOWN HEREON IS SOLELY BASED UPON THOSE CERTAIN MAPS AND ELECTRONIC DRAWING FILES REFERENCED IN DATA SOURCE 4. FLORIDA DESIGN CONSULTANTS, INC. AND THE SURVEYOR AND MAPPER IN RESPONSIBLE CHARGE DOES NOT GUARANTEE THE VALIDITY OF SAID BOUNDARY INFORMATION OTHER THAN CONFORMATION TO SAID MAPS AND ELECTRONIC DRAWING FILES.
- 10. ORIGINAL FIELD WORK WAS COMPLETED ON 1/19/2010 AND IS CONTAINED IN FIELD BOOK 1526. FIELD WORK FOR REVISION 2 WAS COMPLETED ON 3/3/2010 AND IS CONTAINED IN FIELD BOOK 1526. FIELD WORK FOR REVISION 3 WAS COMPLETED ON 3/15/2010, IS CONTAINED IN FIELD BOOK 1526 AND IS LIMITED TO THE LINER EDGE AND PROPOSED FORCEMAIN LOCATION AS MARKED BY THE CONTRACTOR. FIELD WORK FOR REVISION 4 WAS COMPLETED ON 3/31/2010, IS CONTAINED IN FIELD BOOK 1526 AND IS LIMITED TO THE SPOT GRADES ON THE PROPOSED POND. FIELD WORK FOR REVISION 5 WAS COMPLETED ON 4/7/2010, IS CONTAINED IN FIELD BOOK 1526 AND IS LIMITED TO THE SPOT GRADES ON THE PROPOSED POND BEFORE THE LEACHATE SYSTEM WAS INSTALLED. FIELD WORK FOR REVISION 6 WAS COMPLETED ON 4/13/2010, IS CONTAINED IN FIELD BOOK 1526 AND IS LIMITED TO THE SPOT GRADES ON THE WEST 1/3 OF THE PROPOSED POND. FIELD WORK FOR REVISION 7 WAS COMPLETED ON 4/26/2010, IS CONTAINED IN FIELD BOOK 1526 AND IS LIMITED TO THE EXISTING 12" GAS LINE LOCATIONS AND DIMENSIONS TO THE PLAN FORCEMAIN FROM THE FIELD LOCATED EDGE OF PAVEMENT. REVISION 7 ALSO REMOVED THE PROPOSED FORCEMAIN LOCATION AS MARKED BY THE CONTRACTOR ADDED DURING REVISION 3. REVISION 8 IS LIMITED TO ADDING TIES TO THE GAS LINE AND EXISTING GROUND ELEVATION AT CROSSINGS (NO FIELD WORK PERFORMED). REVISION 9 IS LIMITED TO ADDING CROSSING DETAILS AT EAST AND WEST GAS LINE CROSSINGS (NO FIELD WORK PERFORMED). FIELD WORK FOR REVISION 10 COMMENCED ON 6/10/2010 AND WAS COMPLETED ON 7/8/2010, IS CONTAINED IN FIELD BOOK 1526 PAGES 70-73 AND IS LIMITED TO ADDING FORCEMAIN, LEACHATE DETECTION SYSTEM, LEACHATE COLLECTION SYSTEM LOCATIONS AND GROUNG ELEVATIONS. FIELD WORK FOR REVISION II WAS PERFORMED ON 7/22/2010, IS CONTAINED IN FIELD BOOK 1526 PAGE 69 AND IS LIMITED TO ADDING LEACHATE SYSTEM AND STORM DRAIN PIPE LOCATIONS. FIELD WORK FOR REVISION 12 COMMENCED 8/26/2010 AND COMPLETED ON 10/19/2010, IS CONTAINED IN FIELD BOOK 1526 PAGES 68-61 AND IS LIMITED TO ADDING FORCEMAIN, WATER LINE, DRAINAGE STRUCTURES, LEACHATE SYSTEM, FINAL GROUND ELEVATIONS AND LIMITS OF SOD. FIELD WORK FOR REVISION 13 WAS PERFORMED ON 10/21/2010 AND IS LIMITED TO ADDING LIMITS OF SOD AT THE NORTHEAST CORNER. FIELD WORK FOR REVISION 14 WAS PERFORMED ON 11/5/2010 AND IS LIMITED TO ADDING SOD AREAS, LEACHATE SYSTEM, PARKING AND STORM DRAIN PIPE LOCATIONS. REVISION 15 IS LIMITED TO ADDING COORDINATES ON THE MONITORING WELLS AT THE CLIENTS REQUEST (NO FIELD WORK PERFORMED). REVISION 16 IS LIMITED TO ADDING LATITUDE AND LONGITUDE ON THE MONITORING WELLS (NO FIELD WORK PERFORMED). FIELD WORK FOR REVISION 17 WAS PERFORMED ON 2/23/2011, IS CONTAINED IN FIELD BOOK 1526 AND IS LIMITED TO ADDING LEACHATE SYSTEM LOCATIONS AND BORE DATA AT THE STORAGE TANK SHOWN ON SHEET 3. REVISE MONITOR WELL INFORMATION FROM PLAN CORDINATES TO STATE PLANE COORDINATES NORTH AMERICAN DATUM 1983/1990 ADJUSTMENT FLORIDA WEST ZONE (902).
- II. THERE WERE TWO CONTROL POINT #506's ACCORDING TO THE CONSTRUCTION PLANS REFERENCED IN DATA SOURCE 4 [SEE SHEET G-2 "EXISTING CONDITIONS, CONSTRUCTION LIMITS, AND MONITORING WELLS" OF SAID CONSTRUCTION PLANS FOR EXAMPLE]. THE EASTERN MOST CONTROL POINT LABELED AS CONTROL POINT #506 ON SAID CONSTRUCTION PLANS WAS RENUMBERED BY THIS SURVEYOR TO CONTROL POINT #507 FOR IDENTIFICATION PURPOSES ONLY.
- 12. FLORIDA DESIGN CONSULTANTS, INC. PERFORMED A LEVEL BENCH RUN FROM SITE TBM #I, THROUGH CONTROL POINTS #506 AND #507 (SEE LIMITATION #II), TO SITE TBM #2. IT WAS DISCOVERED THAT THE ELEVATION SHOWN ON THE CONSTRUCTION PLANS [SEE DATA SOURCE #4] FOR CONTROL POINT #506 IS NOT CONSISTENT WITH THE ELEVATIONS SHOWN FOR THE SITE BENCHMARKS UTILIZED AND CONTROL POINT #507. THE ELEVATION SHOWN FOR SAID CONTROL POINT #506 IS 51.59'. BASED ON MEASUREMENTS BY THIS SURVEYOR THE ELEVATION OF SAID CONTROL POINT #506, UTILIZING THE BENCHMARKS AS PROVIDED, IS 50.38'. [SEE ACCURACY #3]

13. THE LOCATION OF AS-BUILT UNDERGROUND UTILITY LINES SHOWN HEREON IS BASED ON INFORMATION PROVIDED BY THE CONTRACTOR AND FIELD SURVEY EFFORTS. AS NOTED ABOVE THE UTILITY CONTRACTOR MARKED CONSTRUCTED UNDERGROUND UTILITY LINES WITH EITHER A P.V.C. STANDPIPE OR WOOD STAND WITH A DIMENSION MARKED TO THE TOP OF PIPE IN ORDER FOR THE SURVEYOR TO OBTAIN A HORIZONTAL AND VERTICAL LOCATION ON TOP OF THE CONSTRUCTED UTILITY LINE. THE PIPELINE WAS BACK FILLED PRIOR TO THE RECORD SURVEY EFFORT WITH NO VISIBLE EVIDENCE TO SUPPORT THE ACTUAL PIPELINE LOCATION. THE SURVEYOR MAKES NO GUARANTEE THAT THE STANDPIPE OR WOOD STAND PLACED BY THE CONTRACTOR WAS INSTALLED ACCURATELY ON TOP OF THE PIPE. THE UNDERSIGNED SURVEYOR MAKES NO GUARANTEE AS TO THE ACTUAL LOCATION OF ANY UNDERGROUND UTILITY LINES. TO AVOID DAMAGE TO EXISTING FACILITIES THE LOCATION OF EXISTING PIPELINES MUST BE VERIFIED PRIOR TO ANY EXCAVATION OR UNDERGROUND CONSTRUCTION ACTIVITIES BY USING GOOD CONSTRUCTION PRACTICES AND CONTACTING SUNSHINE STATE ONE CALL IN ACCORDANCE WITH FLORIDA STATUTES 553.851(1979).

## **BOUNDARY INCONSISTENCIES:**

NOT APPLICABLE. THIS IS NOT A BOUNDARY SURVEY.

## APPARENT PHYSICAL USE:

THE SUBJECT PROPERTY IS PART OF A SOLID WASTE LANDFILL, IS UNDER CONSTRUCTION AND CONTAINS IMPROVEMENTS NOT SHOWN ON THE MAP OF SURVEY

# EASEMENTS/RIGHT-OF-WAY:

NOT APPLICABLE. THIS IS NOT A BOUNDARY SURVEY.

# PREPARED FOR:

RIPA & ASSOCIATES, INC.

## CERTIFIED TO:

SUBJECT:

RIPA & ASSOCIATES, INC.

## SURVEYOR AND MAPPER IN RESPONSIBLE CHARGE:

DENNIS BOGGS PROFESSIONAL SURVEYOR AND MAPPER LICENSE NUMBER LS 6069 STATE OF FLORIDA

# ABBREVIATIONS LEGEND

AC .	= Acres	FN&TT	= Found Nail and Tin Tab	P	= Property Line	
A/C	= Air Conditioner	FOP	= Found Open End Iron Pipe	PLS	= Professional Land Surveyor	
ADW	= Asphalt Driveway	FPB	= Electric Power Box	POB	= Point of Beginning	
ADS	= Advance Drainage Systems	FPC	= Electric Power Company	POC	= Point of Commencement	
ASPH	= Asphalt	FPP	= Found Pinched Iron Pipe	POL	= Point on Line	
3/C	= Back of Curb	FRRS	= Found Railroad Spike	PRM	= Permanent Reference Monument	
ВССМ	= Board of County Commissioners Minutes Book	FT	= Feet	PSM	= Professional Surveyor and Mapper	
BFPD	= Back Flow Prevention Device	F/T	= Fence Tie	PT	= Point of Tangency \ Point	
BLDG	= Building	FXC	= Found X-cut	PVC	= Polyvinyl Chloride Pipe	
NDY	= Boundary	G/A	= Guy Wire Anchor	(R)	= Recorded Data	
0	= Blow Off Valve	GE	= Grate Elevation	RCP	= Reinforced Concrete Pipe	
C)	= Calculated Data	GI	= Grate Inlet	RLS	= Registered Land Surveyor	
/C	= Covered Concrete	GV	= Gas Valve	RNG	= Range	
CCCL	= Coastal Construction Control Line	IE	= Invert Elevation	R/W	= Right of Way	
CCR	= Certified Corner Record	INV	= Invert	S	= South	
DW	= Concrete Driveway	LB	= Corporate Certification Number	(S)	= Survey Data (See Data Source 5)	
	= Curb Inlet	LCS	= Leachate Collection System	SCM	= Set Concrete Monument, 4"x4", PRM L	B 6707
<u> </u>	= Center Line	LDS	= Leachate Detection System	SCM(W)	= Set Concrete Monument, 4"x4", FDC LE	B 6707 WITNESS PT
LF	= Chain Link Fence	LF	= Linear Feet	SEC	= Section	
M	= Concrete Monument	LP	= Light Pole	SHW	= Seasonal High Water Elevation	
MP	= Corrugated Metal Pipe	LS	= Licensed Surveyor	SIR	= Set 5/8"Iron Rod and Cap, FDC LB 67	707
0	= Clean out	MAS	= Masonry	SIR(W)	= Set 5/8"Iron Rod and Cap, FDC LB 67	707 WITNESS PT
ONC	= Concrete	MES	= Mitered End Section	SMH	= Sanitary Manhole	
OR	= Corner	МН	= Manhole	SN&D	= Set Nail and Disk, FDC LB 6707	
PB	= Condo Plat Book	MHW	= Mean High Water	SN&D(W)	= Set Nail and Disk, FDC LB 6707 WITNE	SS PT
C/S	= Concrete Slab	MOL	= More or Less	SQ	= Square	
T/C	= Curb Tie	N	= North	SR	= State Road	
)B	= Deed Book	N/C	= No Cap	STY	= Story	
CVA	= Double Check Valve Assembly	N/F	= Not Found	SWFWMD	= Southwest Florida Water Management D	District
NR	= Department of Natural Resources	N/S	= Not Set	S/W	= Sidewalk	
DEPT	= Department	N/A	= Not Accessible/Not Complete	ТВМ	= Temporary Benchmark	
AIC	= Diameter	NAD	= North American Datum	TBO	= Temporary Blow-off	
)IP	= Ductile Iron Pipe	NAVD	= North American Vertical Datum	TOB	= Top of Bank	
НМ	= Drainage Manhole	NGS	= National Geodetic Survey	TRAV	= Traverse	
	= East	NGVD	= National Geodetic Vertical Datum	(TYP)	= Typical	
CMP	= Elliptical Corrugated Metal Pipe	NP	= Normal Pool Elevation	TWP	= Township	
L	= Elevation	(NR)	= Non Radial	U/P	= Utility Pole	s renvironments
OW	= Edge of Water	0/A	= Overall	VCP	= Vitrified Clay Pipe	Dept. of Environments
/P	= Edge of Pavement	OHW	= Overhead Wire	W	= West	Protection
OP	= End of Pipe	ORB	= Official Record Book	w/	= With	LIGIOOM
SMT	= Easement	(PA)	= Property Appraisers Map Data	W/F	= Wood Fence	
F)	= Field Data	PB	= Plat Book	WL	= Water Line	MAY 0 4 2011
СМ	= Found Concrete Monument	PC	= Point of Curvature	WUP	= Wood Utility Pole	
DOT	= Florida Department of Transportation	PCED	= Pinellas County Engineering Department	W/T	= Wall Tie	
Н	= Fire Hydrant	PACED	= Pasco County Engineering Department	WV	= Water Valve	Southwest District
IR	= Found Iron Rod and Cap	PCSD				Southwest
L	= Fire Line	PACSD	= Pinellas County Survey Department	××*	= Degrees = Minutes (Regrings)	
ND	= Found	PCP	= Pasco County Survey Department		= Minutes (Bearings)	
N&D	= Found Nail and Disk		= Permanent Control Point	XX.	= Seconds (Bearing)	
	= Finished Floor Elevation	PG(S)	= Pages = Point of Intersection	xx	= Feet (Distances)	
FE		-	= FOIDT OF INTERSECTION			

# LINETYPE LEGEND

			-	Bouridary Line
			=	Center Line
-			=	Easement Line
			=	Edge of Water
			=	Jurisdictional Line
		_	=	Right-Of-Way Line
			=	Section Line
			=	Top Bank or Top of Berm
			=	Toe of Slope or Grade Break
	GAS	- GAS	=	Gas Line (See Limitation 8)
			=	Proposed Forcemain
-	FM	- FM	=	Forcemain
	ST	ST	=	Storm Sewer Line (See Limitation 12)

## DOCUMENT LEGEND

(C) = CALCULATED DATA = FIELD DATA

(P) = PLAN DATA (SEE DATA SOURCE 4)

## SYMBOLS LEGEND

211	IDOLS LLGLIND			
+ =	Aerial Target	$\oplus$		Metal Post
	Bench Mark	8	=	Monitoring Well
CPS =	Cable TV Paint Stripe Cable TV Box Communications Manhole	RW	=	Parking Meter Reclaimed Water Paint Stripe Reclaimed Water Box
<b>*</b> =	Concrete Light Pole	×		Sanitary Forcemain Valve
=	Concrete Post	S		Sanitary Sewer Manhole
<b>1</b> =	Concrete Utility Pole	(A)		Sanitary Cleanout/Drainage Cleanout
(D) =	Drainage Manhole	SANPS	=	Sanitary Sewer Paint Stripe
	Electric Box	1	=	Section Corner
(E) =	Electric Manhole	à	=	Siamese Connection
$\underline{FPCPS} =$	Electric Power Paint Stripe	-0	=	Sign
Q =	Electric Power Pedestal	SCB	=	Sprinkler Control Box
<b>X</b> =	Fire Hydrant	4	=	Sprinkler Head
F) =	Flag Pole	STMPS	=	Storm Water Paint Stripe
GASI =	Gas Line Marker	SB	=	Traffic Signal Box
Q, =	Gas Filler Cap	TP	=	Traffic Signal Pole
S <sub>Q</sub> =	Gas Valve	VPS	=	Verizon Paint Stripe
GM =	Gas Meter Box			Water Line Paint Stripe
GLPS =	Gas Line Paint Stripe	W	=	Water Meter
CCCC	Grate Inlet	$\bowtie$	=	Water Valve

= Grate Inlet © = Telephone Manhole A = Telephone Pedestal GTE = Telephone Marker -> = Guy Anchor

MB = Mail Box ⊠ = Water Service (one whip) ■ = Water Service (two whips)

+ = Point of Elevation 25.2' = Calculated Dimension from Structure to Boundary / Right-of-Way Line

1 = Wood Utility Pole

Wood Light Pole

Wood Post

√ = Per Plan

FLORIDA DEPARTMENT OF ENVIRONMENTAL PROTECTION MAY 04 2011 SOUTHWEST DISTRICT

THE MAP AND REPORT ARE NOT FULL AND COMPLETE WITHOUT THE OTHER

UALITY CONTROL

## FLORIDA DESIGN CONSULTANTS, INC. ENGINEERS, ENVIRONMENTALISTS, SURVEYORS & PLANNERS

3030 Starkey Blvd. New Port Richey FL, 34655 Tel: (727) 849-7588 - Fax: (727) 848-3648 Certificate of Authorization: LB 6707

State of Florida

PASCO COUNTY LANDFILL

RECORD SURVEY

SHEET DESCRIPTION:

REPORT AND LEGENDS

17	3-1-2011	ADD I
16	2-18-2011	ADD LA
15	11-11-2010	ADD LE
14	11-8-2010	ADD S
1-13	VARIOUS	SEE LIN
NO.	DATE	

18 4-19-2011 REVISE LATITUDE AND LONGITUDE ON MONITOR WELLS (NO FIELD WORK PERFORMED) LEACHATE SYSTEM BORE LOCATION LATITUDE AND LONGITUDE ON MONITORING WELLS (NO FIELD WORK PERFORMED) LEACHATE SYSTEM ELEVATION SOD AREAS, LEACHATE SYSTEM, PARKING AND STORM DRAIN PIPE LOCATIONS LIMITATIONS 10 REVISIONS

SURVEYOR'S REPORT 2-3. MAP OF SURVEY - UTILITIES . MAP OF SURVEY - CELL ELEVATIONS 5. MAP OF SURVEY - MONITOR WELLS ADDITIONS OR DELETIONS TO SURVEY MAPS OR REPORTS BY OTHER THAN THE SIGNING BY CONTROL PARTY OR PARTIES IS PROHIBITED.

2009-70 N/A PROJECT DATA BASE 2009-70-CON ELD BOOK NUMBER & PAGES. SEE LIMITATIONS 10 LAST DATE OF ORIGINAL FIELD WOR SEE LIMITATIONS 10 SURVEY MAP AND REPORT OR THE COPIES THEREOF ARE NOT VALID WITHOUT THE SIGNATURE AND THE ORIGINAL RAISED SEAL OF A FLORIDA LICENSED SURVEYOR AND MAPPER. DENNIS BOGGS PROFESSIONAL SURVEYOR AND MAPPER LICENSE NUMBER LS 6069

STATE OF FLORIDA

