1565493 (1)



FLORIDA DEPARTMENT OF ENVIRONMENTAL PROTECTION
JUN 08 2006
SOUTHWEST DISTRICT
TAMPA

SURVEYOR'S NOTES:

1.) North, the grid, and the coordinates shown hereon are referenced to the West Zone of the Florida State Plane Coordinate System, NAD 83, 1990 adjustment.

2.) Elevations are to National Geodetic Vertical Datum of 1929.

3.) This topographic survey was prepared by photogrammetric methods. See the attached report for map accuracy and surveyor's signature and seal. This map is limited to those features visible on aerial photography.

(THESE FEATURES ARE REPRESENTED BY SYMBOLS NOT TO SCALE)

- CONTROL
- UTILITY POLE
- LIGHT POLE
- TRAFFIC LIGHT
- SIGN
- POST
- FLAG
- MAIL BOX
- MANHOLE
- HYDRANT
- CATCH BASIN
- VALVE
- ELECTRICAL
- AC
- MISC SYMBOL
- CULVERT
- SWAMP/MARSH
- TREE
- PALM
- SHRUB

LEGEND:

(THESE FEATURES ARE TO SCALE)

- CURB
- PAVED ROAD
- CONCRETE SURFACE
- UNPAVED ROAD
- FENCE
- GUARDRAIL
- WALL
- RAILROAD
- STRUCTURE
- TREE LINE
- SHRUB LINE
- PIPELINE
- RECREATION
- EDGE OF GROVE
- EDGE OF WATER
- SWAMPLINE
- OBSCURED CONTOUR
- DEPRESSION CONTOUR

(THESE INFORMATIVE LABELS ARE NOT SCALE DEPENDENT)

- W.E. 74.4 WATER ELEVATION
- TYPICAL SPOT ELEVATION
- × 120.0 OBSCURED SPOT ELEVATION

7	4	1
8	5	2
	6	3

NORTH

GRAPHIC SCALE

100 0 50 100 200 400

(IN FEET)
1 inch = 100 ft.

TOPOGRAPHIC SURVEY

SOUTH EAST LANDFILL–SEMI ANNUAL

PREPARED FOR: WASTE MANAGEMENT INC.

PROJECT No.	11994–4
DRAWING No.	LD 3032
No.	1 OF 8

475 SOUTH FIRST AVENUE
BARTOW, FLORIDA 33830
PHONE: (863)-533-8095
FAX: (863)-534-1464

PICKETT
SURVEYING & PHOTOGRAMMETRY
PICKETT & ASSOCIATES, INC. LICENSED BUSINESS No. LB364

502 WEST MAIN STREET
WAUCHULA, FLORIDA 33873
PHONE: (863)-773-3900
FAX: (863)-773-3922

Horiz. Scale: 1" = 100'	Edited by: JC	Compiled by: BF	Flight Date: 7/5/05
Contour Interval: 1'			Drawing Name: 11994–4.DWG

THIS MAP AND ATTACHED REPORT ARE NOT FULL AND COMPLETE WITHOUT THE OTHER AND ARE NOT VALID WITHOUT THE SIGNATURE AND THE ORIGINAL RAISED SEAL OF A FLORIDA LICENSED SURVEYOR AND MAPPER

No.	DATE	APPROVED	REVISION
O.R.	8/5/05		ORIGINAL RELEASE



SURVEYOR's NOTES:

1.) North, the grid, and the coordinates shown hereon are referenced to the West Zone of the Florida State Plane Coordinate System, NAD 83, 1990 adjustment.

2.) Elevations are to National Geodetic Vertical Datum of 1929.

3.) This topographic survey was prepared by photogrammetric methods. See the attached report for map accuracy and surveyor's signature and seal. This map is limited to those features visible on aerial photography.

(THESE FEATURES ARE REPRESENTED BY SYMBOLS NOT TO SCALE)

- CONTROL
- UTILITY POLE
- LIGHT POLE
- TRAFFIC LIGHT
- SIGN
- POST
- FLAG
- MAIL BOX
- MANHOLE
- HYDRANT
- CATCH BASIN
- VALVE
- ELECTRICAL
- AC
- MISC SYMBOL
- CULVERT
- SWAMP/MARSH
- TREE
- PALM
- SHRUB

LEGEND:

(THESE FEATURES ARE TO SCALE)

- CURB
- PAVED ROAD
- CONCRETE SURFACE
- UNPAVED ROAD
- FENCE
- GUARDRAIL
- WALL
- RAILROAD
- STRUCTURE
- TREE LINE
- SHRUB LINE
- PIPELINE
- RECREATION
- EDGE OF GROVE
- EDGE OF WATER
- SWAMPLINE
- OBSCURED CONTOUR
- DEPRESSION CONTOUR

(THESE INFORMATIVE LABELS ARE NOT SCALE DEPENDENT)

- W.E. 74.4 WATER ELEVATION
- TYPICAL SPOT ELEVATION
- 130.0 OBSCURED SPOT ELEVATION

7	4	1
8	5	2
	6	3

NORTH

GRAPHIC SCALE

100 0 50 100 200 400

(IN FEET)
1 inch = 100 ft.

TOPOGRAPHIC SURVEY

SOUTH EAST LANDFILL-SEMI ANNUAL

PREPARED FOR: WASTE MANAGEMENT INC.

PROJECT No. 11994-4

DRAWING No. LD 3032

No. 2 of 8

PICKETT
SURVEYING & PHOTOGRAMMETRY
PICKETT & ASSOCIATES, INC. LICENSED BUSINESS No. LB364


475 SOUTH FIRST AVENUE
MARTOW, FLORIDA 33830
PHONE: (863)-533-0005
FAX: (863)-534-1464

502 WEST MAIN STREET
WAUCHULA, FLORIDA 33873
PHONE: (863)-773-3500
FAX: (863)-773-3502

Horiz Scale: 1" = 100'	Edited by: JC	Compiled by: BF	Flight Date: 7/5/05
Contour Interval: 1'			Drawing Name: 11994-4.DWG

THIS MAP AND ATTACHED REPORT ARE NOT FULL AND COMPLETE WITHOUT THE OTHER AND ARE NOT VALID WITHOUT THE SIGNATURE AND THE ORIGINAL RAISED SEAL OF A FLORIDA LICENSED SURVEYOR AND MAPPER

No.	DATE	APPROVED	REVISION
O.R.	8/5/05		ORIGINAL RELEASE

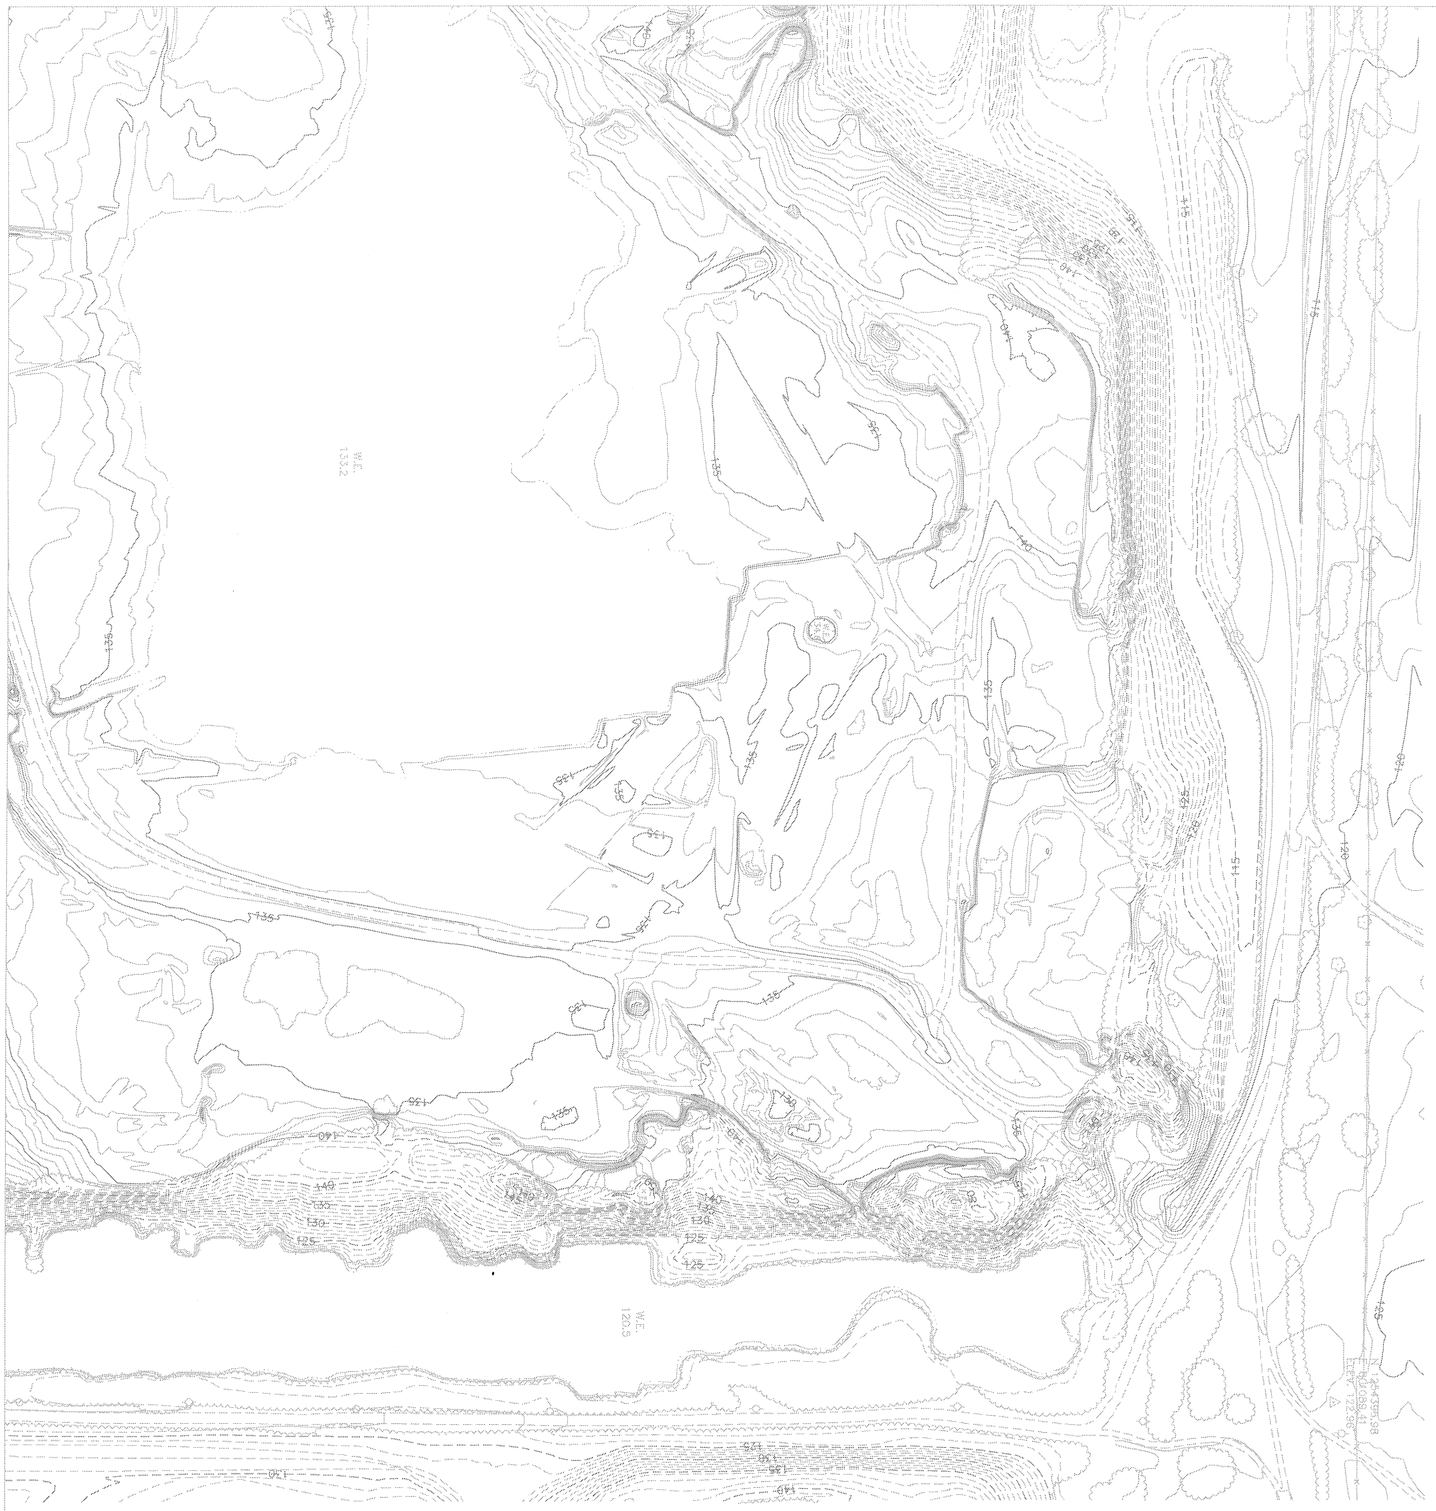

SURVEYOR's NOTES:

1.) North, the grid, and the coordinates shown hereon are referenced to the West Zone of the Florida State Plane Coordinate System, NAD 83, 1990 adjustment.

2.) Elevations are to National Geodetic Vertical Datum of 1929.

3.) This topographic survey was prepared by photogrammetric methods. See the attached report for map accuracy and surveyor's signature and seal. This map is limited to those features visible on aerial photography.

(THESE FEATURES ARE REPRESENTED BY SYMBOLS NOT TO SCALE)

- CONTROL
- UTILITY POLE
- LIGHT POLE
- TRAFFIC LIGHT
- SIGN
- POST
- FLAG
- MAIL BOX
- MANHOLE
- HYDRANT
- CATCH BASIN
- VALVE
- E.ECTRICAL
- AC
- MISC SYMBOL
- CULVERT
- SWAMP/MARSH
- TREE
- PALM
- SHRUB

LEGEND:

(THESE FEATURES ARE TO SCALE)

- CURB
- PAVED ROAD
- CONCRETE SURFACE
- UNPAVED ROAD
- FENCE
- GUARDRAIL
- WALL
- RAILROAD
- STRUCTURE
- TREE LINE
- SHRUB LINE
- PIPELINE
- RECREATION
- EDGE OF GROVE
- EDGE OF WATER
- SWAMPLINE
- OBSCURED CONTOUR
- DEPRESSION CONTOUR

(THESE INFORMATIVE LABELS ARE NOT SCALE DEPENDENT)

- W.E. 74.4 WATER ELEVATION
- TYPICAL SPOT ELEVATION
- +120.0 OBSCURED SPOT ELEVATION

7	4	1
8	5	2
	6	3

NORTH

GRAPHIC SCALE

100 0 50 100 200 400

(IN FEET)
1 inch = 100 ft.

PROJECT No. 11994-4
DRAWING No. 3 OF 8
No. LD 3022

TOPOGRAPHIC SURVEY

SOUTH EAST LANDFILL-SEMI ANNUAL

PREPARED FOR: WASTE MANAGEMENT INC.

475 SOUTH FIRST AVENUE
BARTOW, FLORIDA 33830
PHONE: (863)-533-8095
FAX: (863)-534-1464

PICKETT
SURVEYING & PHOTOGRAMMETRY
PICKETT & ASSOCIATES, INC.
LICENSED BUSINESS No. LB3994

502 WEST MAIN STREET
WAUCHULA, FLORIDA 33873
PHONE: (863)-773-3800
FAX: (863)-773-3822

Hiriz. Scale: 1" = 100'	Edited by: JC	Compiled by: BF	Flight Date: 7/5/05
Contour Interval: 1'			Drawing Name: 11994-4.DWG

THIS MAP AND ATTACHED REPORT ARE NOT FULL AND COMPLETE WITHOUT THE OTHER AND ARE NOT VALID WITHOUT THE SIGNATURE AND THE ORIGINAL RAISED SEAL OF A FLORIDA LICENSED SURVEYOR AND MAPPER

No.	DATE	APPROVED	REVISION
O.R.	8/5/05		ORIGINAL RELEASE



SURVEYOR's NOTES:

1.) North, the grid, and the coordinates shown hereon are referenced to the West Zone of the Florida State Plane Coordinate System, NAD 83, 1990 adjustment.

2.) Elevations are to National Geodetic Vertical Datum of 1929.

3.) This topographic survey was prepared by photogrammetric methods. See the attached report for map accuracy and surveyor's signature and seal. This map is limited to those features visible on aerial photography.

(THESE FEATURES ARE REPRESENTED BY SYMBOLS NOT TO SCALE)

- CONTROL
- UTILITY POLE
- LIGHT POLE
- TRAFFIC LIGHT
- SIGN
- POST
- FLAG
- MAIL BOX
- MANHOLE
- HYDRANT
- CATCH BASIN
- VALVE
- ELECTRICAL
- A/C
- MISC. SYMBOL
- CULVERT
- SWAMP/MARSH
- TREE
- PALM
- SHRUB

LEGEND:

(THESE FEATURES ARE TO SCALE)

- CURB
- PAVED ROAD
- CONCRETE SURFACE
- UNPAVED ROAD
- FENCE
- GUARDRAIL
- WALL
- RAILROAD
- STRUCTURE
- TREE LINE
- SHRUB LINE
- PIPELINE
- RECREATION
- EDGE OF GROVE
- EDGE OF WATER
- SWAMPLINE
- OBSCURED CONTOUR
- DEPRESSION CONTOUR

(THESE INFORMATIVE LABELS ARE NOT SCALE DEPENDENT)

- W.E. 74.4 WATER ELEVATION
- TYPICAL SPOT ELEVATION
- +1120.0 OBSCURED SPOT ELEVATION

7	A	1
8	5	2
	6	3

NORTH

GRAPHIC SCALE

100 0 50 100 200 400

(IN FEET)
1 inch = 100 ft.

TOPOGRAPHIC SURVEY

SOUTH EAST LANDFILL–SEMI ANNUAL

PREPARED FOR: WASTE MANAGEMENT INC.

PROJECT No. 11994-4
DRAWING No. 4
No. OF 8
LD 3032

475 SOUTH FIRST AVENUE
BARTOW, FLORIDA 33830
PHONE: (863)-533-0335
FAX: (863)-534-1464

PICKETT
SURVEYING & PHOTOGRAMMETRY
PICKETT & ASSOCIATES, INC.
LICENSED BUSINESS No. LB364

502 WEST MAIN STREET
WAUCHULA, FLORIDA 33873
PHONE: (863)-773-3060
FAX: (863)-773-3622

Horiz. Scale: 1" = 100'	Edited by: JC	Compiled by: BF	Flight Date: 7/5/05
Contour Interval: 1'			Drawing Name: 11994-4.DWG

THIS MAP AND ATTACHED REPORT ARE NOT FULL AND COMPLETE WITHOUT THE OTHER AND ARE NOT VALID WITHOUT THE SIGNATURE AND THE ORIGINAL RAISED SEAL OF A FLORIDA LICENSED SURVEYOR AND MAPPER

No.	DATE	APPROVED	REVISION
O.R.	8/5/05		ORIGINAL RELEASE



SURVEYOR's NOTES:

1.) North, the grid, and the coordinates shown hereon are referenced to the West Zone of the Florida State Plane Coordinate System, NAD 83, 1990 adjustment.

2.) Elevations are to National Geodetic Vertical Datum of 1929.

3.) This topographic survey was prepared by photogrammetric methods. See the attached report for map accuracy and surveyor's signature and seal. This map is limited to those features visible on aerial photography.

(THESE FEATURES ARE REPRESENTED BY SYMBOLS NOT TO SCALE)

- CONTROL
- UTILITY POLE
- LIGHT POLE
- TRAFFIC LIGHT
- SIGN
- POST
- FLAG
- MAIL BOX
- MANHOLE
- HYDRANT
- CATCH BASIN
- VALVE
- ELECTRICAL
- AC
- MISC SYMBOL
- CULVERT
- SWAMP/MARSH
- TREE
- PALM
- SHRUB

LEGEND:

(THESE FEATURES ARE TO SCALE)

- CURB
- PAVED ROAD
- CONCRETE SURFACE
- UNPAVED ROAD
- FENCE
- GUARDRAIL
- WALL
- RAILROAD
- STRUCTURE
- TREE LINE
- SHRUB LINE
- PIPELINE
- RECREATION
- EDGE OF GROVE
- EDGE OF WATER
- SWAMPLINE
- OBSCURED CONTOUR
- DEPRESSION CONTOUR

(THESE INFORMATIVE LABELS ARE NOT SCALE DEPENDENT)

- W.E. 74.4 WATER ELEVATION
- TYPICAL SPOT ELEVATION
- 130.0 OBSCURED SPOT ELEVATION

1	2	3
4	5	6
7	8	

NORTH

GRAPHIC SCALE

100 0 50 100 200 400

(IN FEET)
1 inch = 100 ft.

PROJECT No. 11994-4
DRAWING No. LD 3032
No. 5 OF 8

TOPOGRAPHIC SURVEY

SOUTH EAST LANDFILL-SEMI ANNUAL

PREPARED FOR: WASTE MANAGEMENT INC.

475 SOUTH FIRST AVENUE
PHONE: (863)-533-8035
FAX: (863)-534-1404


PICKETT
SURVEYING & PHOTOGRAMMETRY
PICKETT & ASSOCIATES, INC.

502 WEST MAIN STREET
WAUCHULA, FLORIDA 33873
PHONE: (863)-773-3800
FAX: (863)-773-3622
LICENSED BUSINESS No. LB004

Horiz. Scale: 1" = 100'	Edited by: JC	Compiled by: BF	Flight Date: 7/5/05
Contour Interval: 1'			Drawing Name: 11994-4.DWG

THIS MAP AND ATTACHED REPORT ARE NOT FULL AND COMPLETE WITHOUT THE OTHER AND ARE NOT VALID WITHOUT THE SIGNATURE AND THE ORIGINAL RAISED SEAL OF A FLORIDA LICENSED SURVEYOR AND MAPPER

No.	DATE	APPROVED	REVISION
O.R.	8/3/05		ORIGINAL RELEASE

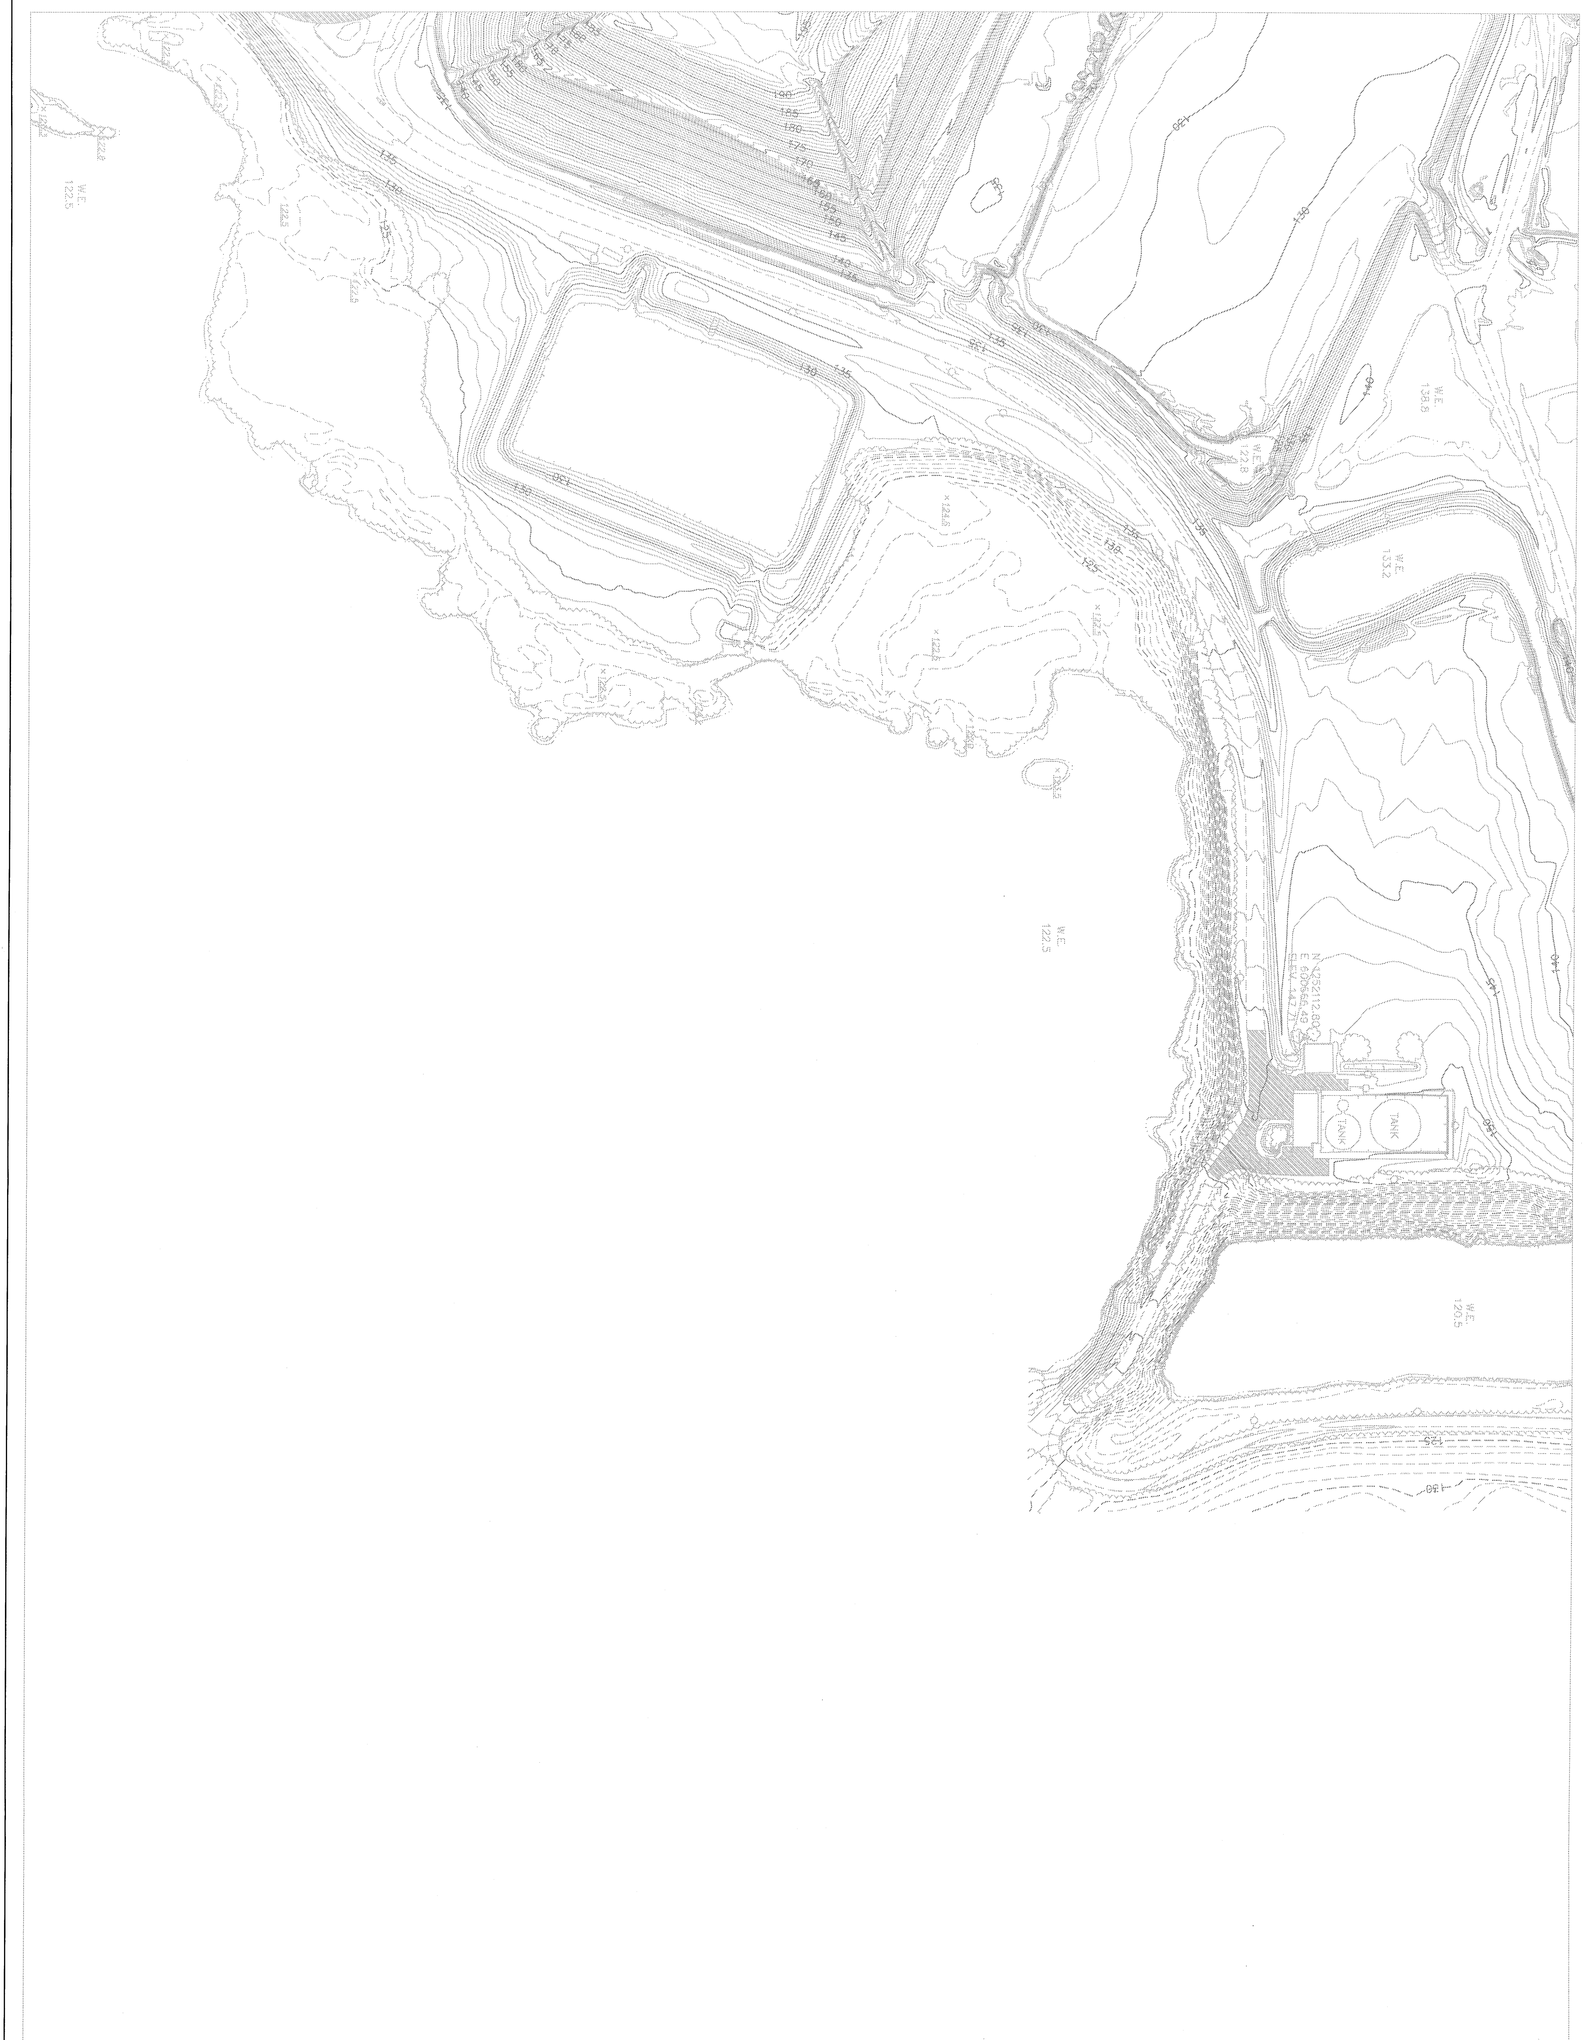

SURVEYOR's NOTES:

1.) North, the grid, and the coordinates shown hereon are referenced to the West Zone of the Florida State Plane Coordinate System, NAD 83, 1990 adjustment.

2.) Elevations are to National Geodetic Vertical Datum of 1929.

3.) This topographic survey was prepared by photogrammetric methods. See the attached report for map accuracy and surveyor's signature and seal. This map is limited to those features visible on aerial photography.

(THESE FEATURES ARE REPRESENTED BY SYMBOLS NOT TO SCALE)

- CONTROL
- UTILITY POLE
- LIGHT POLE
- TRAFFIC LIGHT
- SIGN
- POST
- FLAG
- MAIL BOX
- MANHOLE
- HYDRANT
- CATCH BASIN
- VALVE
- ELECTRICAL
- AC
- MISC. SYMBOL
- CWLVERT
- SWAMP/MARSH
- TREE
- PALM
- SHRUB

LEGEND:

(THESE FEATURES ARE TO SCALE)

- CURB
- PAVED ROAD
- CONCRETE SURFACE
- UNPAVED ROAD
- FENCE
- GUARDRAIL
- WALL
- RAILROAD
- STRUCTURE
- TREE LINE
- SHRUB LINE
- PIPELINE
- RECREATION
- EDGE OF GROVE
- EDGE OF WATER
- SWAMPLINE
- OBSCURED CONTOUR
- DEPRESSION CONTOUR

(THESE INFORMATIVE LABELS ARE NOT SCALE DEPENDENT)

- W.E. 74.4 WATER ELEVATION
- TYPICAL SPOT ELEVATION
- ×120.0 OBSCURED SPOT ELEVATION

7	4	1
8	5	2
	6	3

NORTH

GRAPHIC SCALE

100 0 50 100 200 400

(IN FEET)
1 inch = 100 ft.

TOPOGRAPHIC SURVEY

SOUTH EAST LANDFILL-SEMI ANNUAL

PREPARED FOR: WASTE MANAGEMENT INC.

PROJECT No. 11994-4
DRAWING No. LD 3032
No. 6 OF 8

475 SOUTH FIRST AVENUE
BARTOW, FLORIDA 33830
PHONE: (863)-533-0095
FAX: (863)-534-1464

PICKETT
SURVEYING & PHOTOGRAMMETRY
PICKETT & ASSOCIATES, INC.
LICENSED BUSINESS No. LB3064

502 WEST MAIN STREET
WAUCHULA, FLORIDA 33873
PHONE: (863)-773-3880
FAX: (863)-773-3922

Horiz. Scale: 1" = 100'	Edited by: JC	Compiled by: BF	Flight Date: 7/5/05
Contour Interval: 1'			Drawing Name: 11994-4.DWG

THIS MAP AND ATTACHED REPORT ARE NOT FULL AND COMPLETE WITHOUT THE OTHER AND ARE NOT VALID WITHOUT THE SIGNATURE AND THE ORIGINAL RAISED SEAL OF A FLORIDA LICENSED SURVEYOR AND MAPPER

No.	DATE	APPROVED	REVISION
O.R.	8/5/05		ORIGINAL RELEASE



SURVEYOR's NOTES:

1.) North, the grid, and the coordinates shown hereon are referenced to the West Zone of the Florida State Plane Coordinate System, NAD 83, 1990 adjustment.

2.) Elevations are to National Geodetic Vertical Datum of 1929.

3.) This topographic survey was prepared by photogrammetric methods. See the attached report for map accuracy and surveyor's signature and seal. This map is limited to those features visible on aerial photography.

(THESE FEATURES ARE REPRESENTED BY SYMBOLS NOT TO SCALE)

- CONTROL
- UTILITY POLE
- LIGHT POLE
- TRAFFIC LIGHT
- SIGN
- POST
- FLAG
- MAIL BOX
- MANHOLE
- HYDRANT
- CATCH BASIN
- VALVE
- ELECTRICAL
- AC
- MISC SYMBOL
- CVILVERT
- SWAMP/MARSH
- TREE
- PALM
- SHRUB


LEGEND:

(THESE FEATURES ARE TO SCALE)

- CURB
- PAVED ROAD
- CONCRETE SURFACE
- UNPAVED ROAD
- FENCE
- GUARDRAIL
- WALL
- RAILROAD
- STRUCTURE
- TREE LINE
- SHRUB LINE
- PIPELINE
- RECREATION
- EDGE OF GROVE
- EDGE OF WATER
- SWAMPLINE
- OBSCURED CONTOUR
- DEPRESSION CONTOUR

(THESE INFORMATIVE LABELS ARE NOT SCALE DEPENDENT)

- W.E. 74.4 WATER ELEVATION
- TYPICAL SPOT ELEVATION
- x 130.0 OBSCURED SPOT ELEVATION

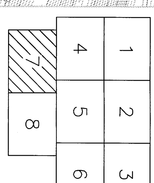

NORTH

GRAPHIC SCALE

100 0 50 100 200 400

(IN FEET)
1 inch = 100 ft.

TOPOGRAPHIC SURVEY

SOUTH EAST LANDFILL–SEMI ANNUAL

PREPARED FOR: WASTE MANAGEMENT INC.

PROJECT No. 11994-4
DRAWING No. LD 3032
No. 7 OF 8

475 SOUTH FIRST AVENUE
BARTOW, FLORIDA 33830
PHONE: (863)-533-0326
FAX: (863)-534-1464


PICKETT
SURVEYING & PHOTOGRAMMETRY
PICKETT & ASSOCIATES, INC. LICENSED BUSINESS No. LB364

502 WEST MAIN STREET
WAUCHULA, FLORIDA 33873
PHONE: (863)-773-3900
FAX: (863)-773-3922

Horiz. Scale: 1" = 100'	Edited by: JC	Compiled by: BF	Flight Date: 7/5/05
Contour Interval: 1'			Drawing Name: 11994-4.DWG

THIS MAP AND ATTACHED REPORT ARE NOT FULL AND COMPLETE WITHOUT THE OTHER AND ARE NOT VALID WITHOUT THE SIGNATURE AND THE ORIGINAL RAISED SEAL OF A FLORIDA LICENSED SURVEYOR AND MAPPER

No.	DATE	APPROVED	REVISION
O.R.	8/5/05		ORIGINAL RELEASE

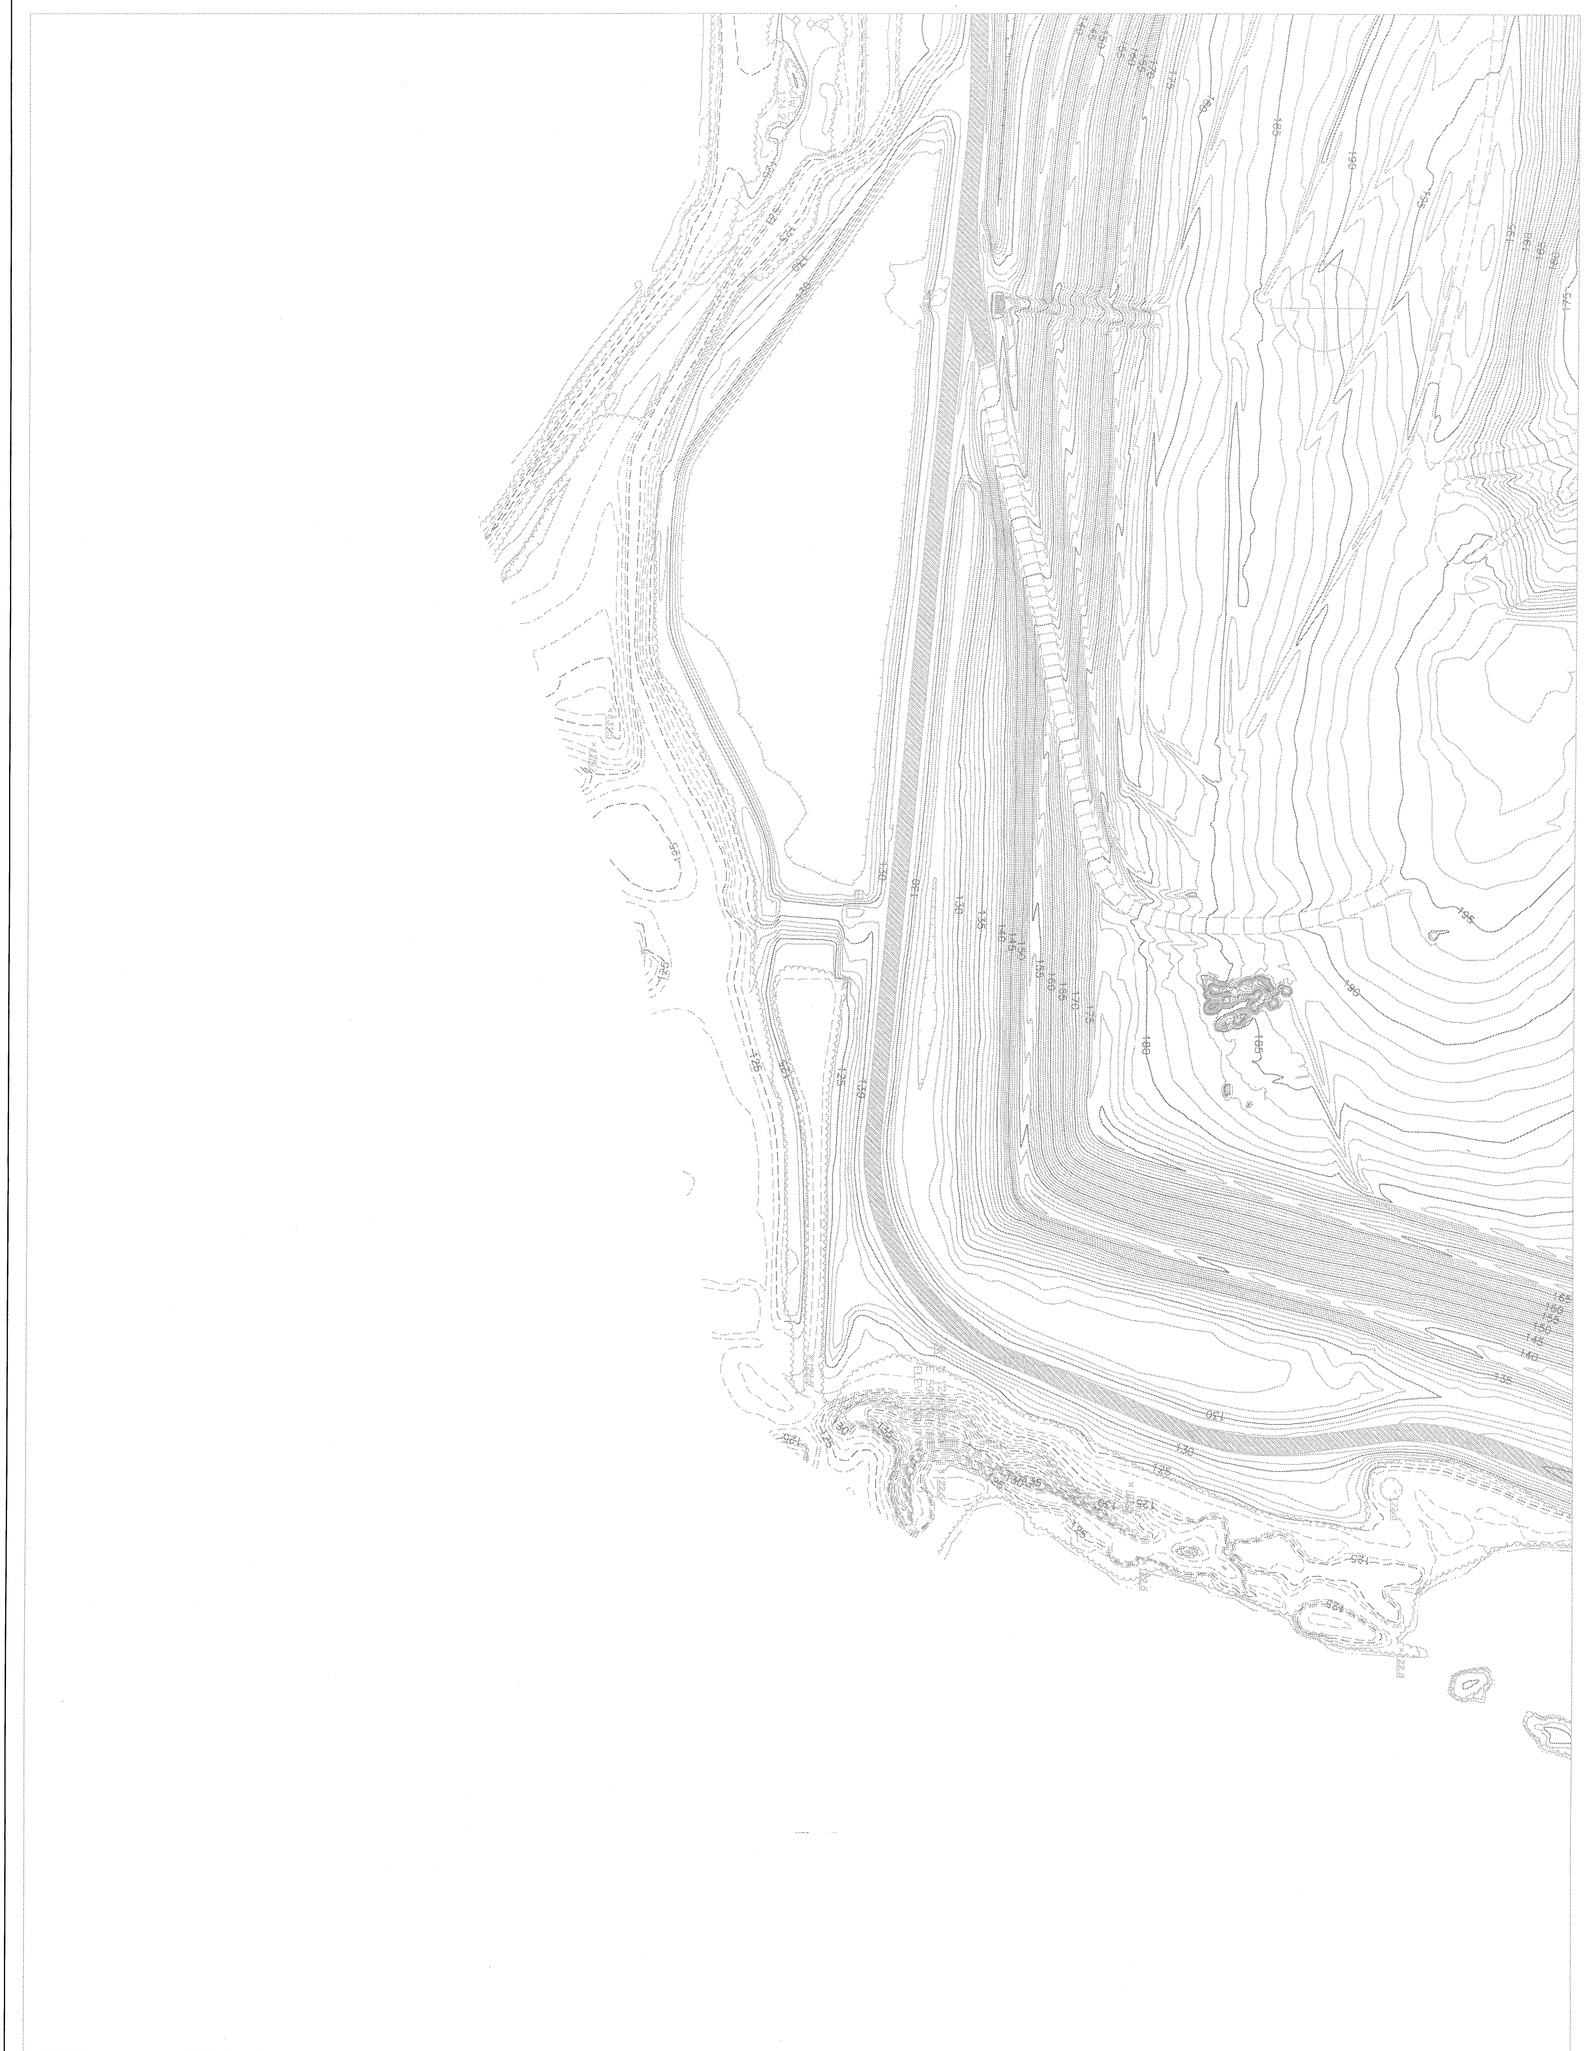

SURVEYOR's NOTES:

1.) North, the grid, and the coordinates shown hereon are referenced to the West Zone of the Florida State Plane Coordinate System, NAD 83, 1990 adjustment.

2.) Elevations are to National Geodetic Vertical Datum of 1929.

3.) This topographic survey was prepared by photogrammetric methods. See the attached report for map accuracy and surveyor's signature and seal. This map is limited to those features visible on aerial photography.

(THESE FEATURES ARE REPRESENTED BY SYMBOLS NOT TO SCALE)

- CONTROL
- UTILITY POLE
- LIGHT POLE
- TRAFFIC LIGHT
- SIGN
- POST
- FLAG
- MAIL BOX
- MANHOLE
- HYDRANT
- CATCH BASIN
- VALVE
- ELECTRICAL
- AC
- MISC SYMBOL
- CULVERT
- SWAMP/MARSH
- TREE
- PALM
- SHRUB

LEGEND:

(THESE FEATURES ARE TO SCALE)

- CURB
- PAVED ROAD
- CONCRETE SURFACE
- UNPAVED ROAD
- FENCE
- GUARDRAIL
- WALL
- RAILROAD
- STRUCTURE
- TREE LINE
- SHRUB LINE
- PIPELINE
- RECREATION
- EDGE OF GROVE
- EDGE OF WATER
- SWAMPLINE
- OBSCURED CONTOUR
- DEPRESSION CONTOUR

(THESE INFORMATIVE LABELS ARE NOT SCALE DEPENDENT)

- W.E. 74.4 WATER ELEVATION
- + 130.0 TYPICAL SPOT ELEVATION
- × 130.0 OBSCURED SPOT ELEVATION

7	4	1
8	5	2
	6	3

NORTH

GRAPHIC SCALE

100 0 50 100 200 400

(IN FEET)
1 inch = 100 ft.

PROJECT No. 11994-4
DRAWING No. 8 OF 8
No. LD 3032

TOPOGRAPHIC SURVEY

SOUTH EAST LANDFILL-SEMI ANNUAL

PREPARED FOR: WASTE MANAGEMENT INC.

475 SOUTH FIRST AVENUE
BARTOW, FLORIDA 33830
PHONE: (863)-533-0005
FAX: (863)-534-1464

PICKETT
SURVEYING & PHOTOGRAMMETRY
PICKETT & ASSOCIATES, INC.
LICENSED BUSINESS No. LB364

502 WEST MAIN STREET
WAUCHULA, FLORIDA 33873
PHONE: (863)-773-3000
FAX: (863)-773-3022

Horiz. Scale: 1" = 100'	Edited by: JC	Compiled by: BF	Flight Date: 7/5/05
Contour Interval: 1'			Drawing Name: 11994-4.DWG

THIS MAP AND ATTACHED REPORT ARE NOT FULL AND COMPLETE WITHOUT THE OTHER AND ARE NOT VALID WITHOUT THE SIGNATURE AND THE ORIGINAL RAISED SEAL OF A FLORIDA LICENSED SURVEYOR AND MAPPER

No.	DATE	APPROVED	REVISION
O.R.	8/5/05		ORIGINAL RELEASE