Brantley, Anna

From: Brantley, Anna
Sent: Monday, September 12, 2011 2:26 PM
To: 'JOHN.PHILLIP.ARNOLD@GMAIL.COM'; 'cjolly@pascocountyfl.net'; Wick, Fred; Hornbrook, Frank; Pelz, Susan
Cc: Gaskin, Nancy
Subject: Certification of Construction Completion {WACS 87895]
Attachments: Enterprise WTPF.303741-001-WT-02. COC. - 9-12-2011.pdf

Attached please find Certification of Construction Completion for the subject Solid Waste Facility. You will only receive this electronic copy of the document.

NOTE: If you have questions concerning the content of the document, please contact the DEP permit processor nancy.gaskin@dep.state.fl.us

Acrobat Reader 6.0 or greater is required to read this document. It is available for downloading at: http://www.adobe.com/products/acrobat/readstep.html

If I may be of assistance, please contact me.

Anna

Anna Brantley
Administrative Assistant II
FL DEP / SWD / Waste Management
13051 North Telecom Parkway
Temple Terrace FL 33637-0629
Tel: 813/632-7600, Ext. 377
Fax: 813/632-7664
anna.brantley@dep.state.fl.us

The Department of Environmental Protection values your feedback as a customer. DEP Secretary Hershel T. Vinyard Jr is committed to continuously assessing and improving the level and quality of services provided to you. Please take a few minutes to comment on the quality of service you received. Simply click on this link to the DEP Customer Survey. Thank you in advance for completing the survey.

Florida Department of Environmental Protection

Southwest District
13051 North Telecom Parkway
Temple Terrace, Florida 33637-0926
Telephone: 813-632-7600

Rick Scott
Governor

Jennifer Carroll
Lt. Governor

Herschel T. Vinyard Jr.
Secretary

Mr. Dominic Iafrate, VP
Angelo's Aggregate Materials, LTD
41111 Enterprise Road
Dade City, Florida 33525

September 12, 2011

RE: Enterprise Road Recycling and Disposal Facility WTPF
Certification of Construction Completion, WTPF
Operation Permit No.: 303741-001-WT/02, Pasco County

Dear Mr. Iafrate:

The Department has completed a review of the Certification of Construction Completion dated August 08, 2011 (received August 11 , 2011), and a subsequent submittal in support of this Certification dated August 24, 2011 (received August 24, 2011), prepared by John Arnold, P.E. , for the construction of the above-referenced Waste Tire Processing facility (WTPF).

Based on the information submitted, and the photographs provided, the Department **approves** the construction of the WTPF listed above. Operations in the WTPF are authorized in accordance with Operation Permit #303741-001-WT/02.

If you have any questions, please contact me at (813) 632-7600 ext. 375 or at nancy.gaskin@DEP.state.fl.us .

Sincerely,

Nancy D. Gaskin
Solid Waste Program
Southwest District

ndg
cc (via email only):
John Arnold, P.E., john.phillip.arnold@gmail.com
Cindy Jolly, P.E., Pasco County cjolly@pascocountyfl.net
Fred Wick/Frank Hornbrook, FDEP Tallahassee (email)
Susan Pelz, P.E., FDEP Tampa (email)

ANGELO'S RECYCLED MATERIALS

41111 Enterprise Road
Dade City, FL 33525

APOPKA	407.290.8010	407.290.8115 (FAX)	TAMPA	813.903.0588	813.632.9157 (FAX)
DADE CITY	352.567.7676	352.567.9448 (FAX)	LARGO	727.581.1544	727.586.5676 (FAX)

August 24, 2011

Ms. Nancy Gaskin
Solid Waste Section
Florida Department of Environmental Protection - Southwest District
13051 North Telecom Parkway
Temple Terrace, FL 33637-0926

Dept. Of Environmental Protection
AUG 24 2011
Southwest District

RE: Angelo's Aggregate Materials, LTD
Permit No.: 303741-001-WT/02
WACS Id.: 87895

Dear Ms. Gaskin:

I received your email dated August 16, 2011 that was in response to the Certification of Construction Completion (FDEP Form No. 62-701.900(2)) dated August 8, 2011. You requested that we provide the Department with photographs of the finished construction and an "as-built" site plan.

Attached, please find photographs showing the various corner posts, soil stockpile, and the earthen embankments. I have enclosed two signed/sealed "as-built" drawings. Since there are no additions, deletions, or revisions to the approved site plan, this correspondence serves as the narrative to document such.

Please let me know if you have any questions or need any additional information.

Sincerely,

John Arnold, P.E.

attachments
xc: Dominic A. Iafrate
Jake Varn, Fowler White Boggs

INSERTED INTO OCULUS
616524
AUG 26 2011
INITIAL

Dept. Of Environmental Protection

AUG 2 4 2011

Southwest District

Dept. Of Environmental Protection

AUG 2 4 2011

Southwest District

Dept. Of Environmental Protection

AUG 2 4 2011

Southwest District

Dept. Of Environmental Protection

AUG 24 2011

Southwest District

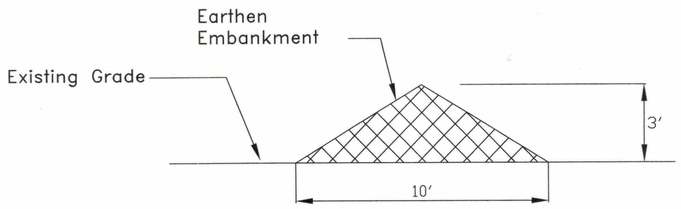

Section A–A
not to scale

Note: Mulch exterior surface of earthen embankment to provide erosion protection

Coordinate Layout Table		
Name	N	E
A	1000+00	1000+00
B	1505+00	1000+00
C	1505+00	1423+05
D	1475+81	1463+71
E	1000+00	1455+00

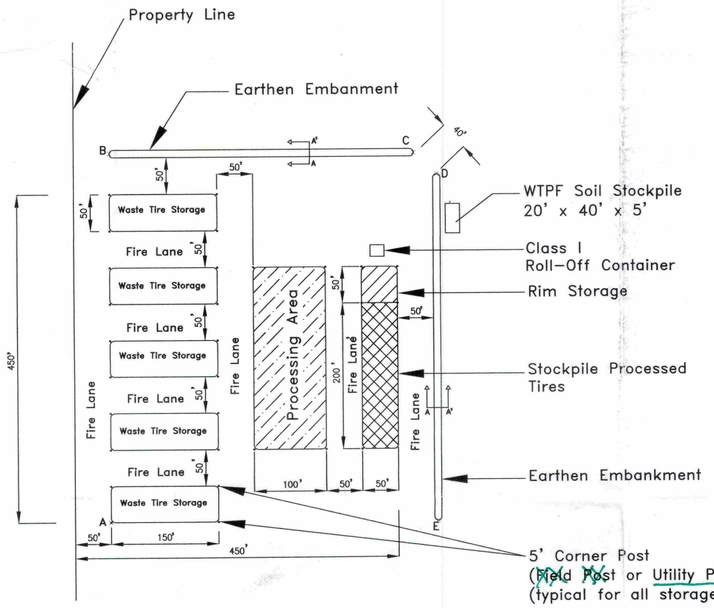

1 Waste Tire Processing Facility Site Plan

AS-BUILT 8/24/11

As Built Certification in General Accordance with approved Plans.

John Arnold 8/24/11
34924 Williamson Creek Rd
Dade City, FL 33525
PE 47164
Ph 352.539.1408

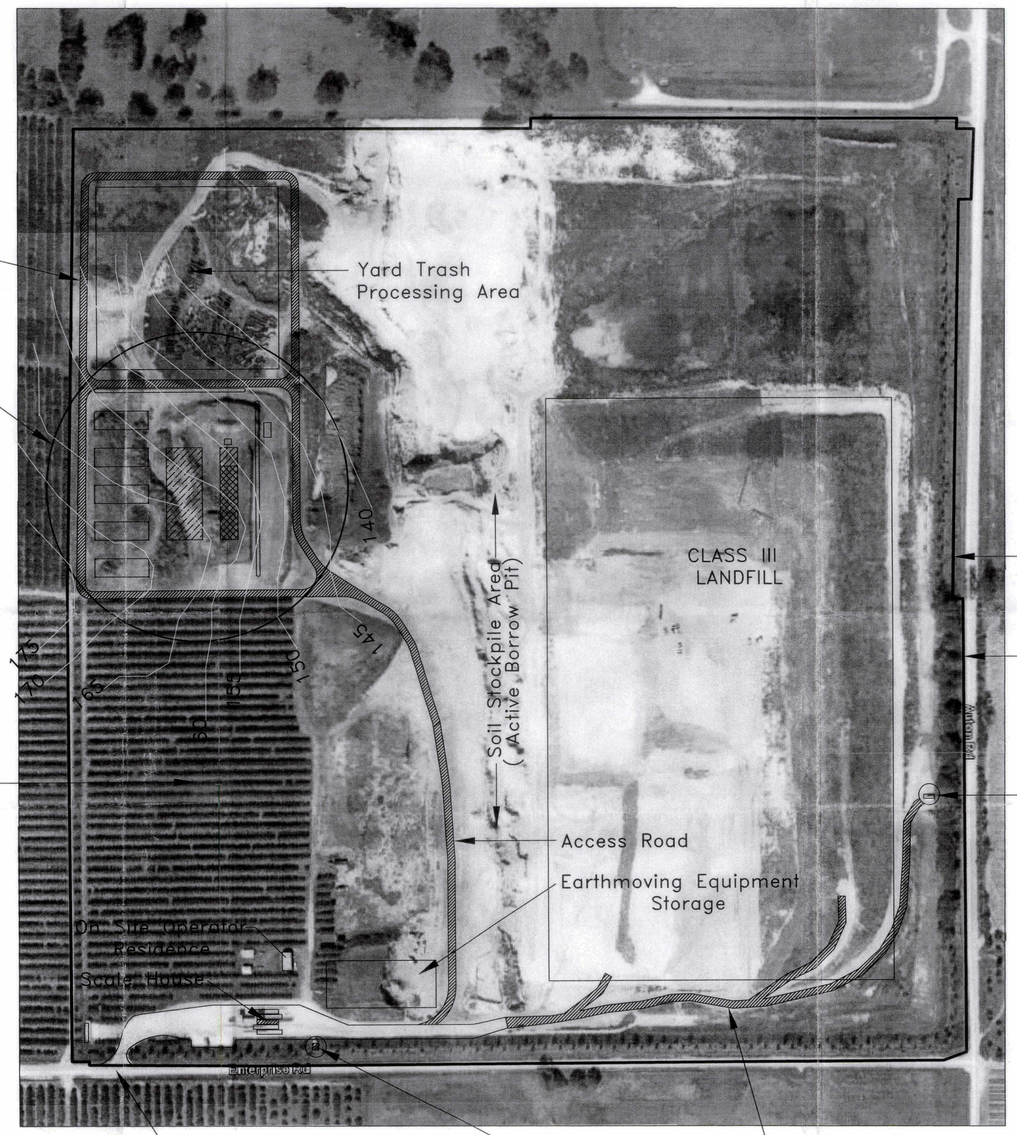

Notes:
1. Topographic Contour lines show at the waste processing facility represent information from the USGS Dade City, Florida Quadrangle, photo, revised 1988.
2.Aerial photograph from Google Earth Maps, Imagery Date: Dec. 2010.

Enterprise Class III Facility Site Plan

SCALE – 1" = 200'

INSERTED INTO OCULUS
AUG 30 2011
INITIAL MH

1574839 (1)

Dept. Of Environmental Protection
AUG 24 2011
Southwest District

As-Built 8/24/11 JPA

Rev. #1	2.8.11
Revisions	

AS-BUILT

Drawn By: NDR	Job No. 01.B.08:
Date: 10.15.10	CAD File Name:-
Scale: as noted	Plot Scale:
Approved By: JPA	Plot Date: 2.8.11

ANGELO'S RECYCLED MATERIALS
41111 Enterprise Rd.
Dade City, FL 33525
Email: John.Phillip.Arnold@gmail.com
Phone (352) 576-7676 Fax (352) 567-9448

Owner: ANGELOS RECYCLED MATERIALS
Project Name: Dade City Tire Processing
Address: 41111 Enterprise Rd.
(352) 567-7676

DWG. NO. C–1

Department of Environmental Protection

Bob Martinez Center
2600 Blair Stone Road
Tallahassee, Florida 32399-2400

DEP Form # 62-701.900(2)
Form Title Certification of Construction Completion of a Solid Waste Management Facility
Effective Date May 19, 1994

Certification of Construction Completion of a Solid Waste Management Facility

DEP Construction Permit No: 303741-001-WT/02 County: Pasco

Name of Project: Enterprise Road Recycling & Disposal Waste Tire Facility

Name of Owner: Angelo's Aggregate Materials, LTD

Name of Engineer: John Arnold

Type of Project: Waste Tire Processing Facility

Cost: Estimate $ 1,000 est. Actual $ 1,000 est.

Site Design Quantity: 2,066 tons max. ~~ton/day~~ Site Acreage: 6 Acres

Deviations from Plans and Application Approved by DEP (attach additional pages as needed):

Construction is in substantial accordance with the authorized plans without deviations.

Address and Telephone No. of Site: (352) 567-7676 Scale House

Incorted into OCULUS
AUG 15 2011
Initials:

Name(s) of Site Supervisor: Alfredo (Fred) Martinez

Date Site inspection is requested: 08/19/2011

This is to certify that, with the exception of any deviation noted above, the construction of the project has been completed in substantial accordance with the plans authorized by Construction

Permit No.: 303741-001-WT/02 Dated: 07/14/2011

Dept. Of Environmental Protection
AUG 11 2011
Southwest District

Date: 8/8/11

8/8/11
Signature of Professional Engineer (352)339-1408
John Arnold
PE 47644 STATE OF FLORIDA
349 Jt. Williams Gem. Rd
Dade City, FL 33525

SENDER: *COMPLETE THIS SECTION*

- Complete items 1, 2, and 3. Also complete item 4 if Restricted Delivery is desired.
- Print your name and address on the reverse so that we can return the card to you.
- Attach this card to the back of the mailpiece, or on the front if space permits.

1. Article Addressed to:

Mr. Dominic Iafrate, President
Angelo's Aggregate Materials, LTD
41111 Enterprise Road
Dade City, FL 33525-1359

NOP # 303741-001-WT/02
Enterprise Recycling WTPF

COMPLETE THIS SECTION ON DELIVERY

A. Signature
X Donel M Cross ☐ Agent ☐ Addressee

B. Received by (Printed Name) Donel M Cross
C. Date of Delivery 7-15-11

D. Is delivery address different from item 1? ☐ Yes
If YES, enter delivery address below: ☐ No

FLORIDA DEPARTMENT OF ENVIRONMENTAL PROTECTION
JUL 18 2011
SOUTHWEST DISTRICT TAMPA

3. Service Type
☑ Certified Mail ☐ Express Mail
☐ Registered ☑ Return Receipt for Merchandise
☐ Insured Mail ☐ C.O.D.

4. Restricted Delivery? *(Extra Fee)* ☐ Yes

2. Article Number *(Transfer from service label)* 7009 1410 0001 0092 0970

PS Form 3811, February 2004 Domestic Return Receipt 102595-02-M-1540

UNITED STATES POSTAL SERVICE

First Class Mail
Postage & Fees Paid
USPS
Permit No. G-10

• Sender: Please print your name, address, and ZIP+4 in this box •

Florida Department of Environmental Protection
Southwest District
c/o Nancy Gaskin – Solid Waste
13051 North Telecom Parkway
Temple Terrace, FL 33637-0926

Dept. Of Environmental Protection

JUL 18 2011

Southwest District

NOTICE OF PERMIT

ENTERPRISE RECYCLING WTPF

PERMIT NO.: 303741-001-WT/02
WACS Facility #SWD/51/87895
Pasco County

Mailed July 14, 2011

7009 1410 0001 0092 0970

U.S. Postal Service™
CERTIFIED MAIL™ RECEIPT
(Domestic Mail Only; No Insurance Coverage Provided)

For delivery information visit our website at www.usps.com®

OFFICIAL USE

Postage	$
Certified Fee	
Return Receipt Fee (Endorsement Required)	
Restricted Delivery Fee (Endorsement Required)	
Total Postage	

Postmark Here

Sent To
Street, Apt. No.; or PO Box No.
City, State, ZIP+

Mr. Dominic Iafrate, President
Angelo's Aggregate Materials, LTD
41111 Enterprise Road
Dade City, FL 33525-1359

PS Form 3800, August 2006 See Reverse for Instructions