



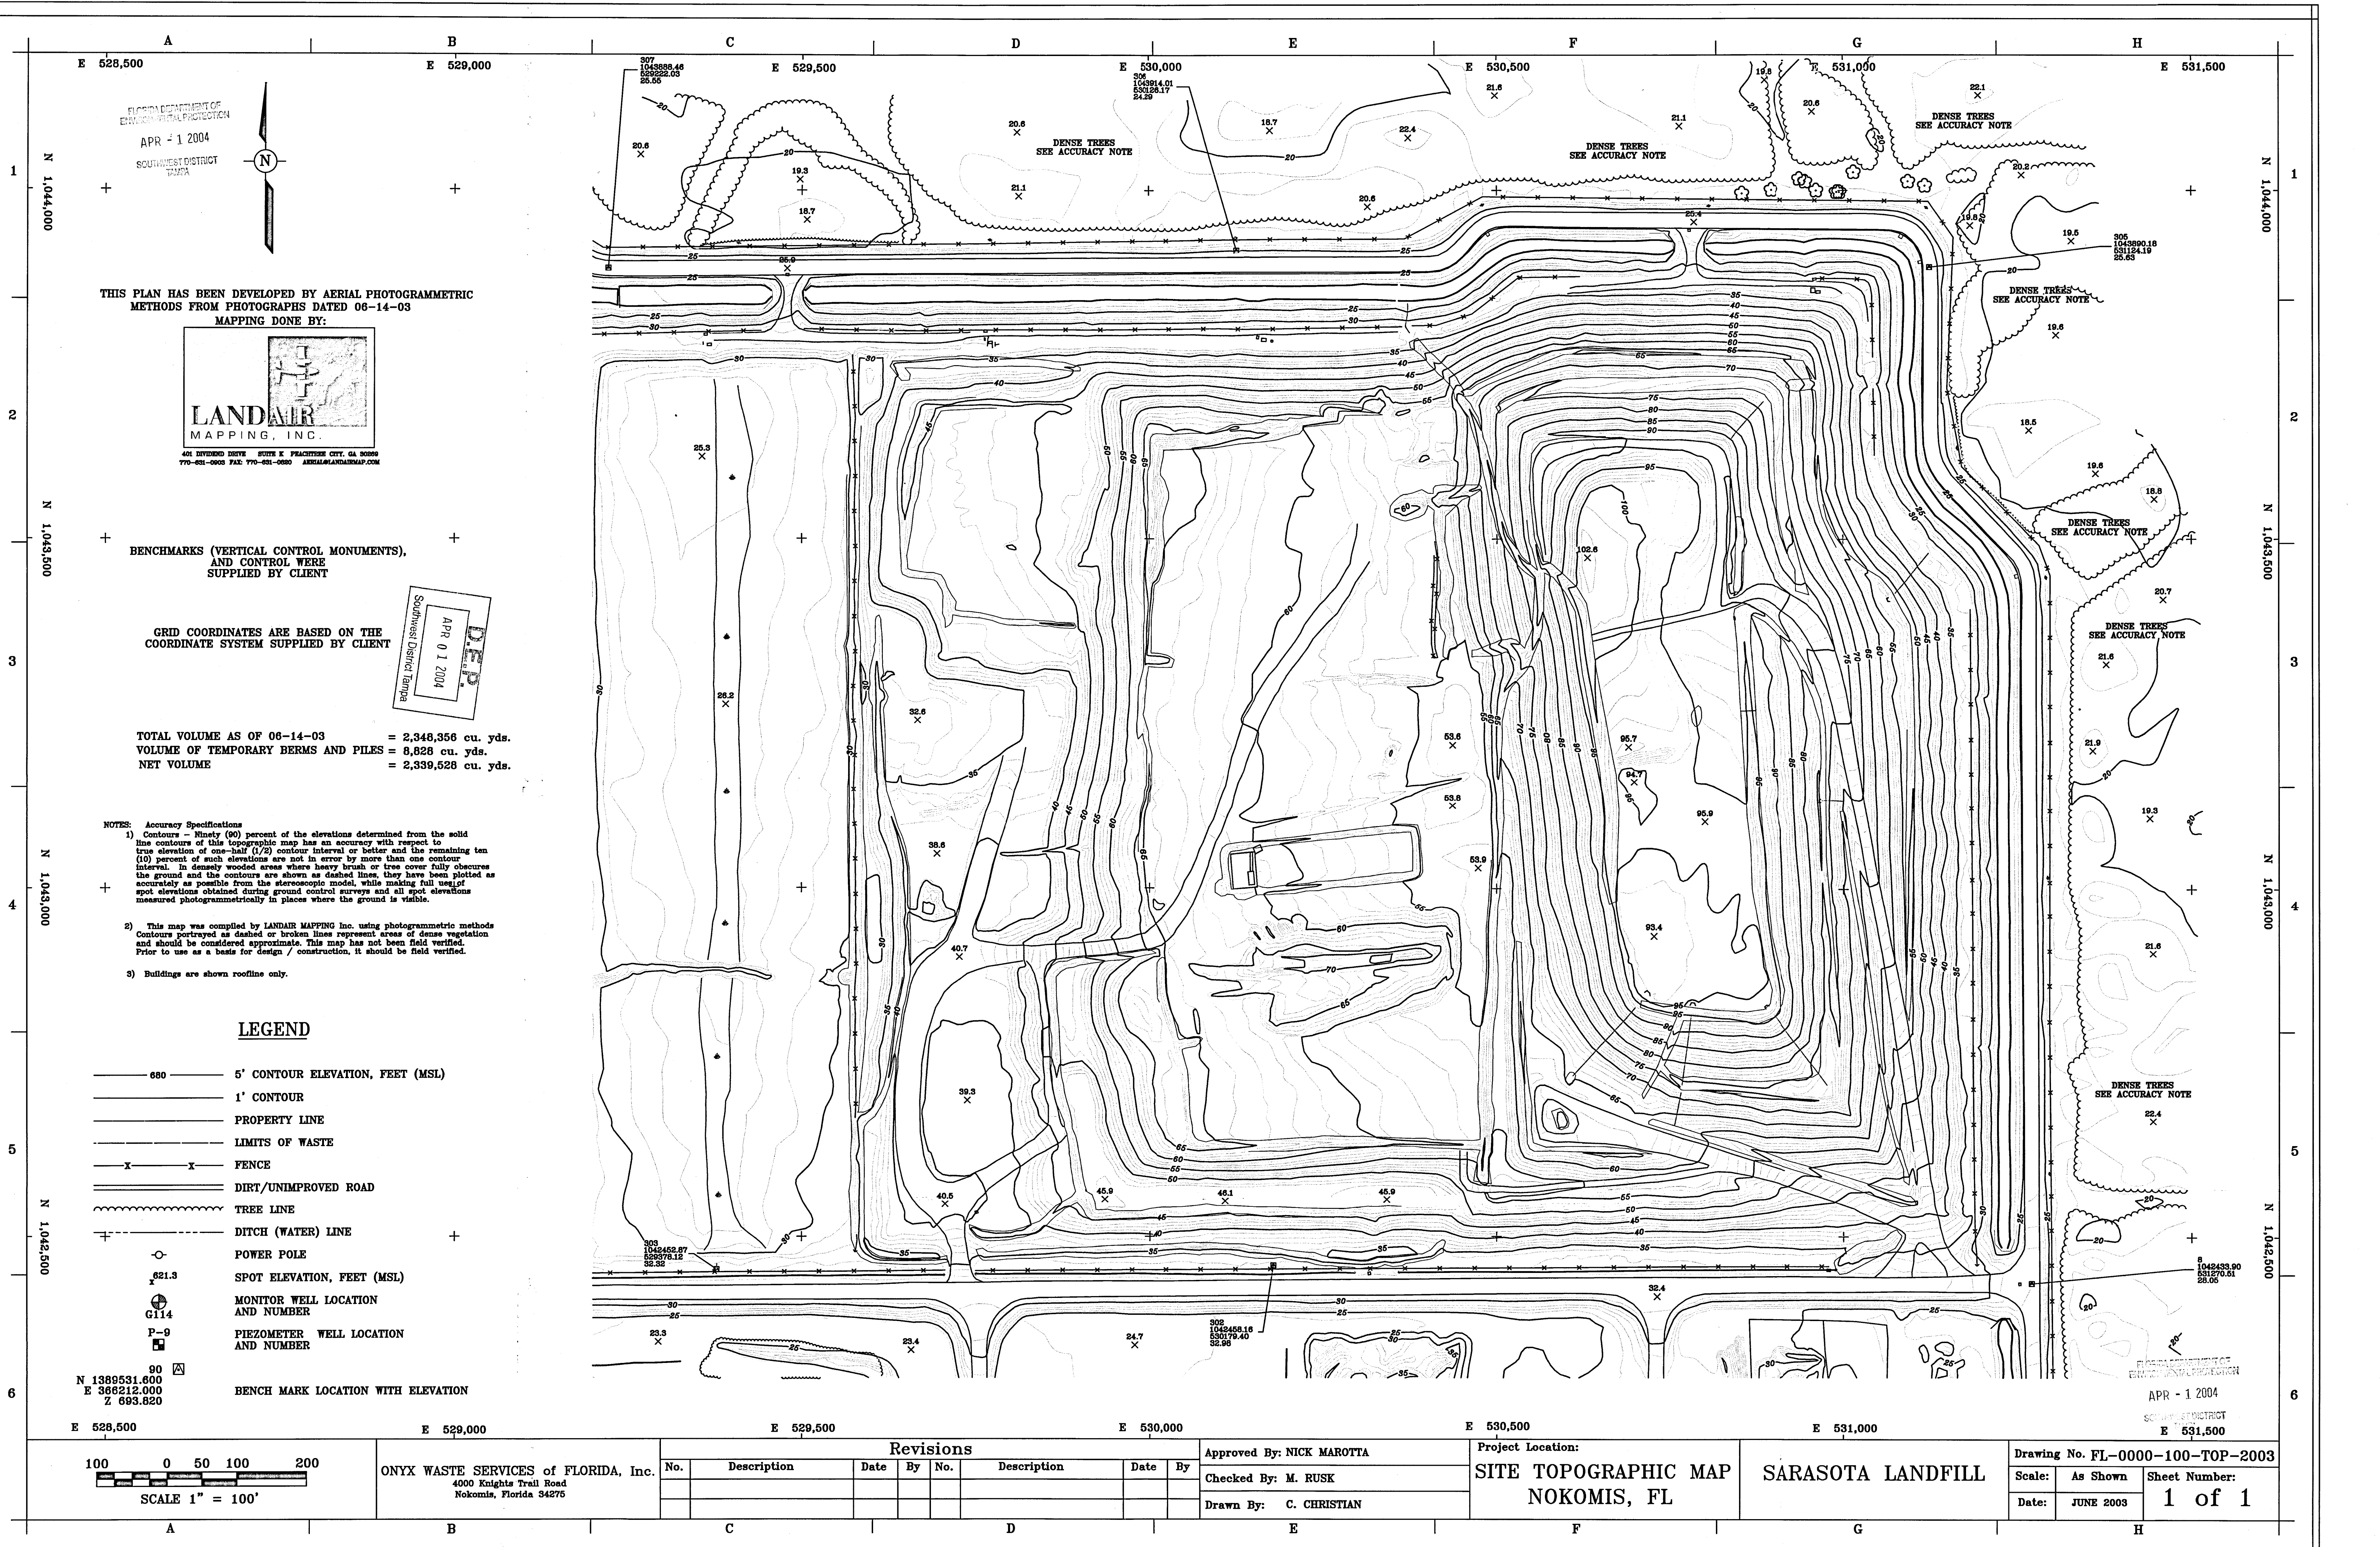

FLORIDA DEPARTMENT OF
ENVIRONMENTAL PROTECTION
APR - 1 2004
SOUTHWEST DISTRICT
TAMPA

THIS PLAN HAS BEEN DEVELOPED BY AERIAL PHOTOGRAMMETRIC
METHODS FROM PHOTOGRAPHS DATED 06-14-03
MAPPING DONE BY:

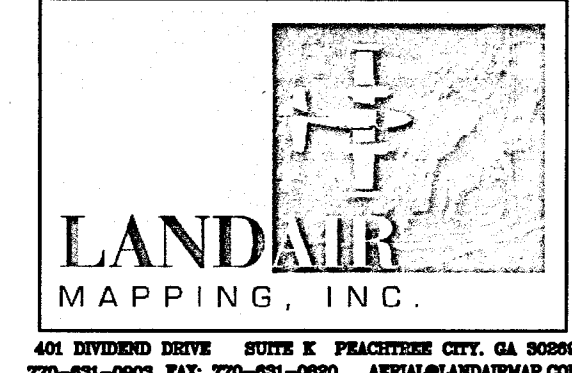

BENCHMARKS (VERTICAL CONTROL MONUMENTS),
AND CONTROL WERE
SUPPLIED BY CLIENT


GRID COORDINATES ARE BASED ON THE
COORDINATE SYSTEM SUPPLIED BY CLIENT

TOTAL VOLUME AS OF 06-14-03 = 2,346,356 cu. yds.
VOLUME OF TEMPORARY BERMS AND PILES = 8,828 cu. yds.
NET VOLUME = 2,339,528 cu. yds.

- NOTES:
- Accuracy Specifications
1) Contours - Ninety (90) percent of the elevations determined from the solid line contours of this topographic map has an accuracy with respect to true elevation of one-half (1/2) contour interval or better and the remaining ten (10) percent of such elevations are not in error by more than one contour interval. In densely wooded areas where heavy brush or tree cover fully obscures the ground and the contours are shown as dashed lines, they have been plotted as accurately as possible from the stereoscopic model, while making full use of spot elevations obtained during ground control surveys and all spot elevations measured photogrammetrically in places where the ground is visible.
 - This map was compiled by LANDAIR MAPPING Inc. using photogrammetric methods. Contours portrayed as dashed or broken lines represent areas of dense vegetation and should be considered approximate. This map has not been field verified. Prior to use as a basis for design / construction, it should be field verified.
 - Buildings are shown rooftop only.

LEGEND

- 680 5' CONTOUR ELEVATION, FEET (MSL)
- 1' CONTOUR
- PROPERTY LINE
- LIMITS OF WASTE
- FENCE
- DIRT/UNIMPROVED ROAD
- TREE LINE
- DITCH (WATER) LINE
- POWER POLE
- SPOT ELEVATION, FEET (MSL)
- MONITOR WELL LOCATION AND NUMBER
- PIEZOMETER WELL LOCATION AND NUMBER
- BENCH MARK LOCATION WITH ELEVATION

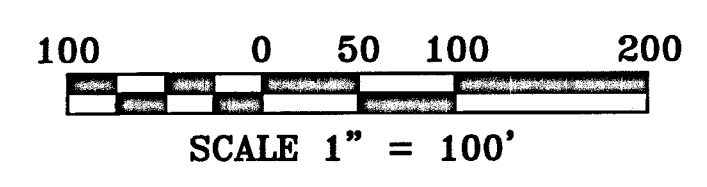

ONYX WASTE SERVICES OF FLORIDA, Inc.
4000 Knights Trail Road
Nokomis, Florida 34275


Revisions					
No.	Description	Date	By	No.	Description

Approved By: NICK MAROTTA
Checked By: M. RUSK
Drawn By: C. CHRISTIAN


Project Location:
SITE TOPOGRAPHIC MAP
NOKOMIS, FL

SARASOTA LANDFILL

Drawing No. FL-0000-100-TOP-2003
Scale: As Shown
Date: JUNE 2003
Sheet Number: 1 of 1

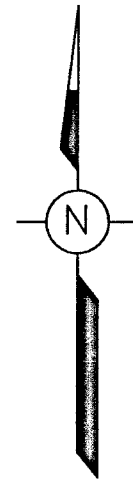

THIS PLAN HAS BEEN DEVELOPED BY AERIAL PHOTOGRAMMETRIC METHODS FROM PHOTOGRAPHS DATED 12-19-01
MAPPING DONE BY:

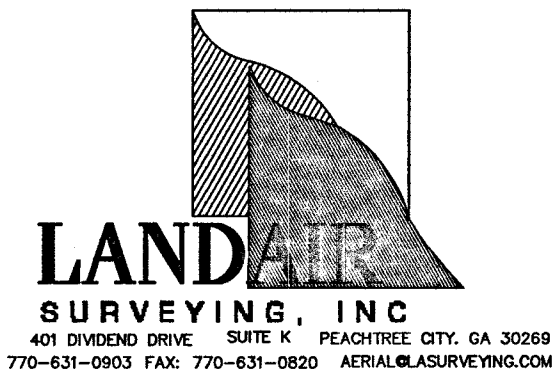

AND
GROUND SURVEY INFORMATION
WAS SUPPLIED BY CLIENT

BENCHMARKS (VERTICAL CONTROL MONUMENTS),
AND CONTROL WERE
SUPPLIED BY CLIENT

GRID COORDINATES ARE BASED ON THE
COORDINATE SYSTEM SUPPLIED BY CLIENT


SHEET INDEX

1	2
3	4


NOTES: ACCURACY SPECIFICATIONS
1) CONTOURS - NINETY (90) PERCENT OF THE ELEVATIONS DETERMINED FROM THE SOLID LINE CONTOURS OF THIS TOPOGRAPHIC MAP, HAS AN ACCURACY WITH RESPECT TO TRUE ELEVATION OF ONE-HALF (1/2) CONTOUR INTERVAL OR BETTER AND THE REMAINING TEN (10) PERCENT OF SUCH ELEVATIONS ARE NOT IN ERROR BY MORE THAN ONE CONTOUR INTERVAL. IN DENSELY WOODED AREAS WHERE HEAVY BRUSH OR TREE COVER FULLY OBSCURES THE GROUND AND THE CONTOURS ARE SHOWN AS DASHED LINES, THEY HAVE BEEN PLOTTED AS ACCURATELY AS POSSIBLE FROM THE STEREOSCOPIC MODEL, WHILE MAKING FULL USE OF SPOT ELEVATIONS OBTAINED DURING GROUND CONTROL SURVEYS AND ALL SPOT ELEVATIONS MEASURED PHOTOGRAMMETRICALLY IN PLACES WHERE THE GROUND IS VISIBLE.
2) THIS MAP WAS COMPILED BY LANDAIR SURVEYING, INC. USING PHOTOGRAMMETRIC METHODS. CONTOURS PORTRAYED AS DASHED OR BROKEN LINES REPRESENT AREAS OF DENSE VEGETATION AND SHOULD BE CONSIDERED APPROXIMATE. THIS MAP HAS NOT BEEN FIELD VERIFIED. PRIOR TO USE AS A BASIS FOR DESIGN / CONSTRUCTION, IT SHOULD BE FIELD VERIFIED.
3) BUILDINGS ARE SHOWN AS ROOFLINE ONLY

LEGEND

- 680 5' CONTOUR ELEVATION, FEET (MSL)
- 1' CONTOUR
- PROPERTY LINE
- LIMITS OF WASTE
- FENCE
- DIRT/UNIMPROVED ROAD
- TREE LINE
- DITCH (WATER) LINE
- POWER POLE
- SPOT ELEVATION, FEET (MSL)
- MONITOR WELL LOCATION AND NUMBER
- PIEZOMETER WELL LOCATION AND NUMBER
- BENCH MARK LOCATION WITH ELEVATION

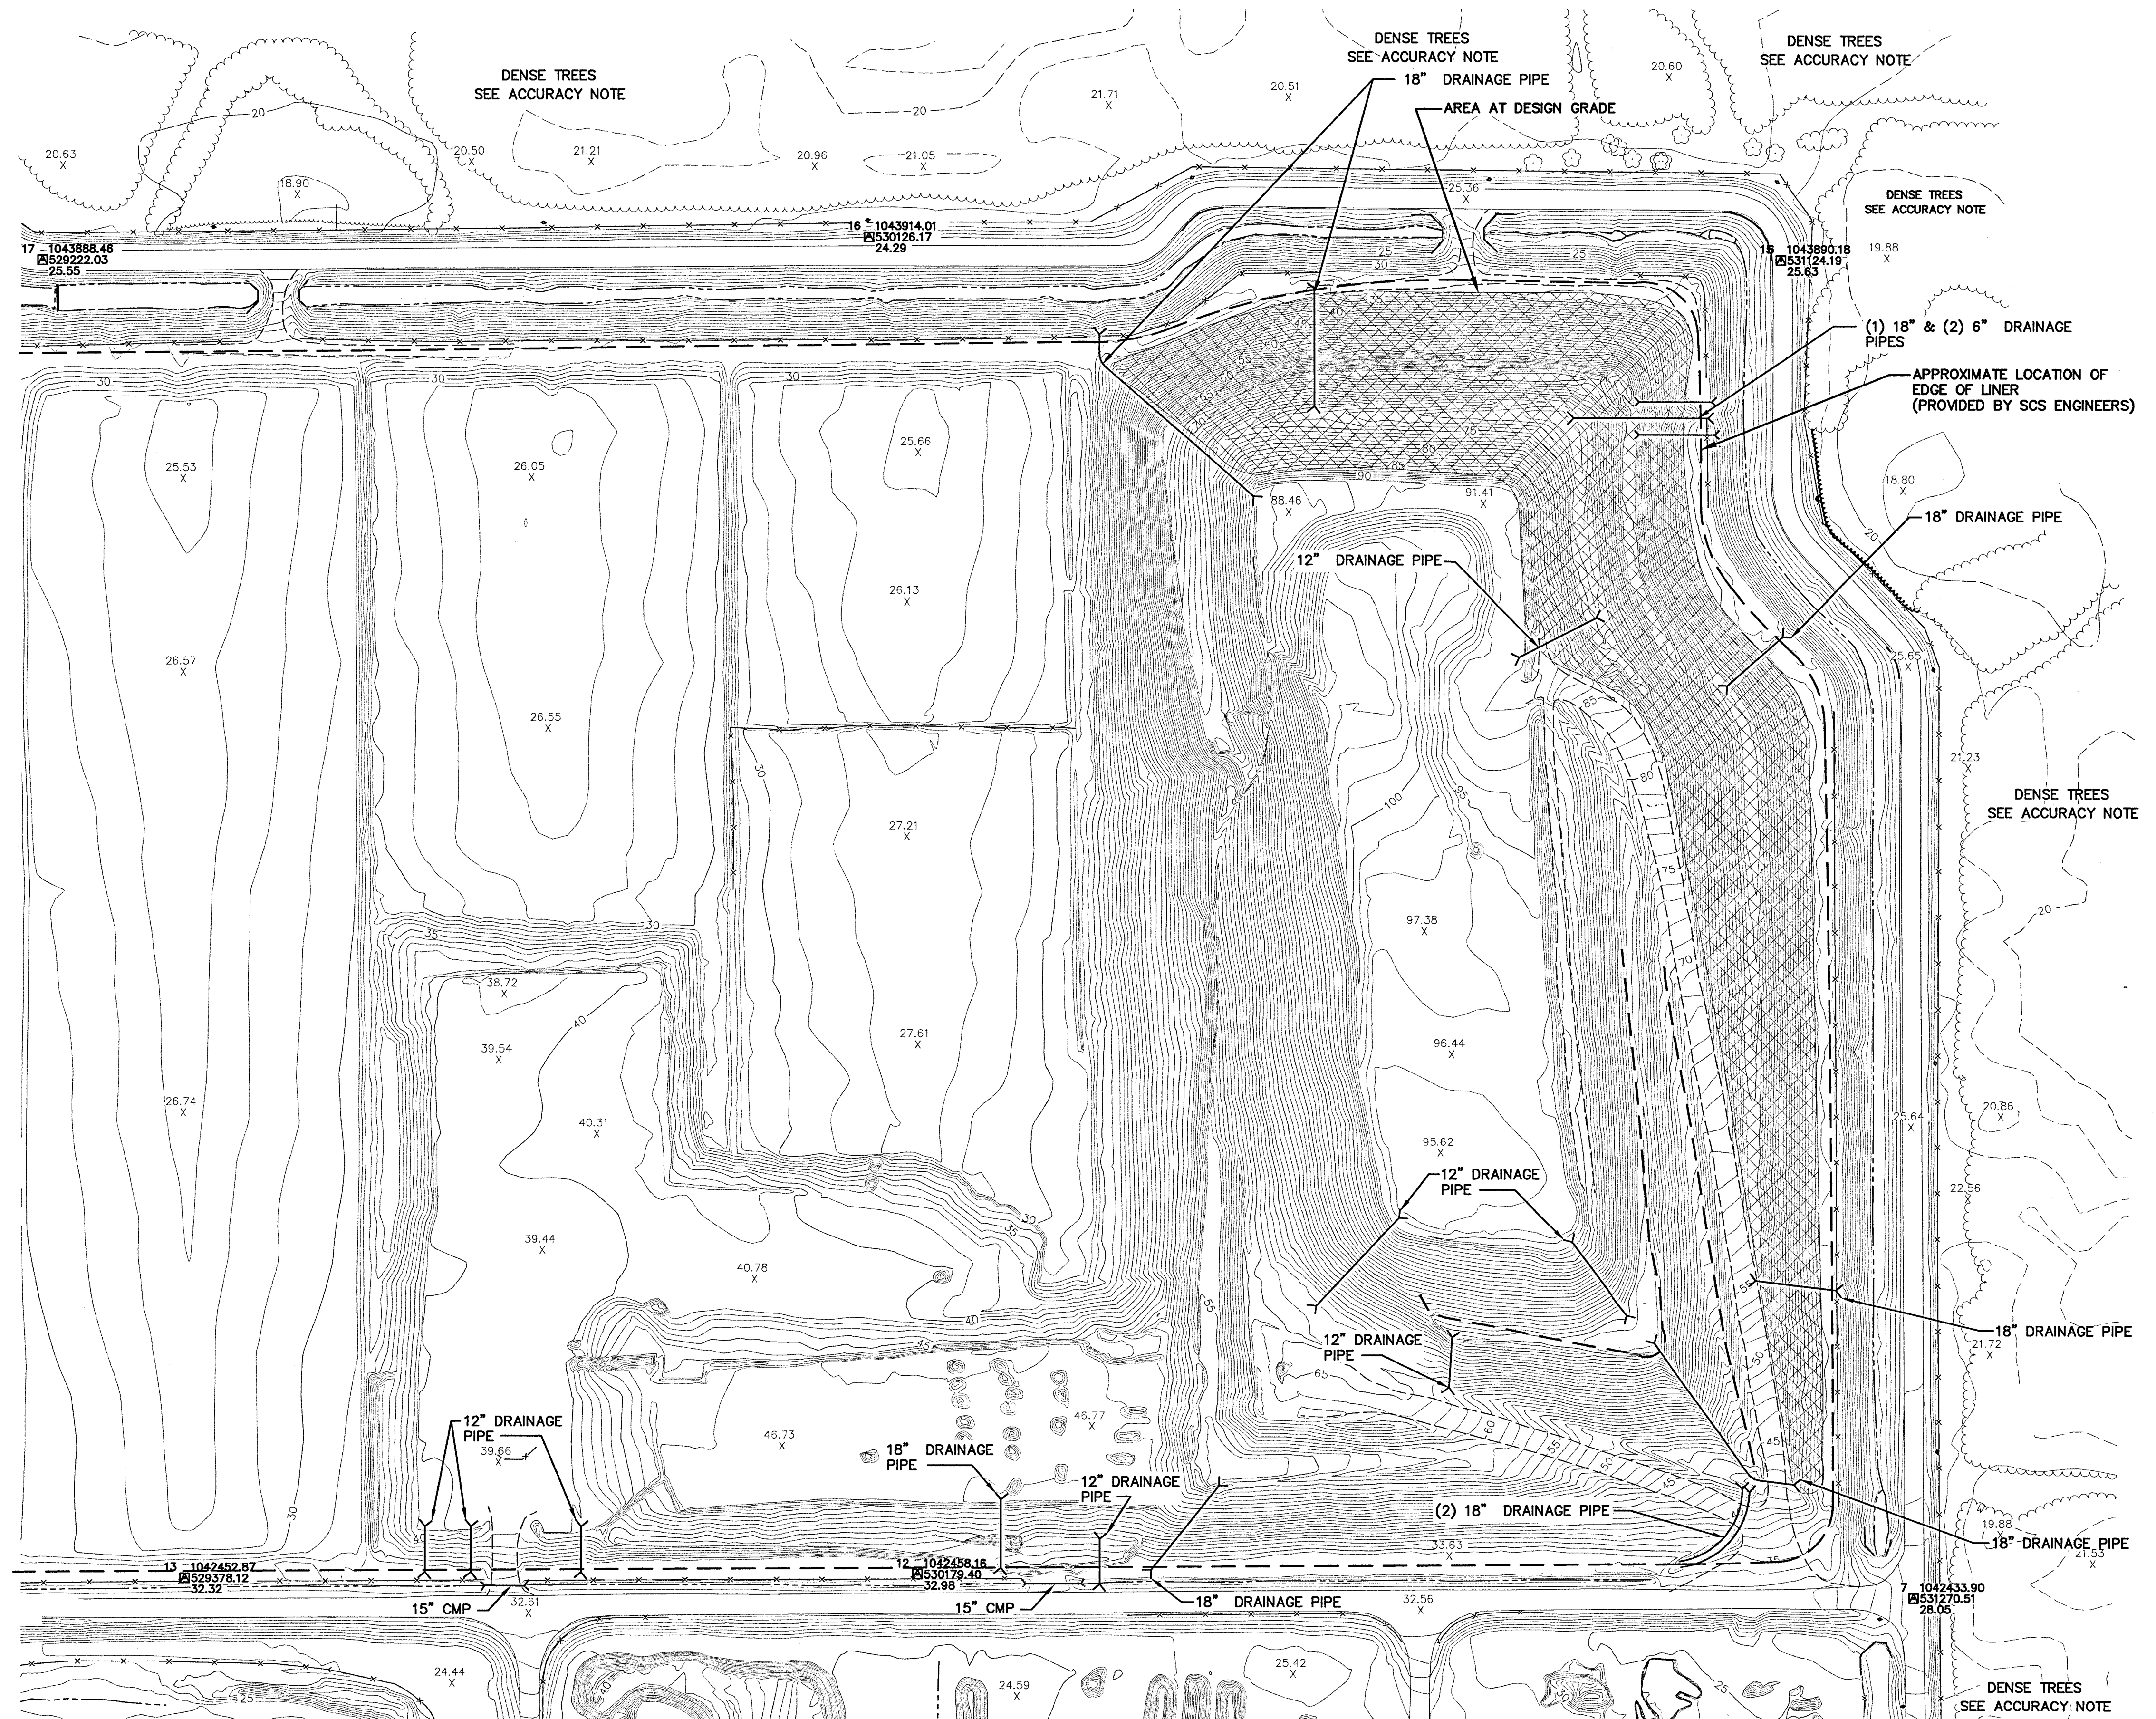

NOTE: DRAINAGE PIPE INFORMATION PROVIDED
BY ONYX WASTE SYSTEMS

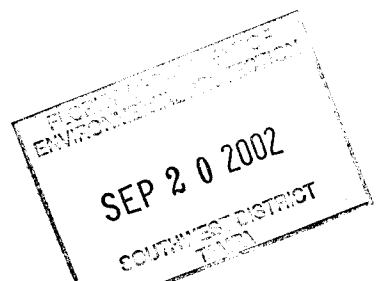

SCS ENGINEERS		STEARNES, CONRAD AND SCHMIDT		CONSULTING ENGINEERS		3012 U.S. HWY. 301 NORTH, SUITE 700, TAMPA, FL 33619		PH (813) 967-0080 FAX (813) 624-8757		PROJECT NO. 09201010.01		DWN. BY: CHK. BY: APP. BY:		Q/A R/W BY:		USN. BY:		DATE: SEPT. 20, 2002		SCALE: 1"=100'		DRAWING NO.	
TOPOGRAPHIC SURVEY		SARASOTA COUNTY		ENVIRONMENTAL SERVICES		SOLID WASTE OPERATIONS		PROJECT TITLE		CCSWDC OPERATIONS		PERMIT APPLICATION		REV		DATE		DESCRIPTION		BY			



DESCRIPTION
CENTRAL COUNTY SOLID WASTE COMPLEX
(PROPOSED SPECIAL EXCEPTION AREA #1248)

THOSE PORTIONS OF SECTIONS 2, 3, 10, AND 11, TOWNSHIP 38 SOUTH, RANGE 19 EAST, SARASOTA COUNTY, FLORIDA, DESCRIBED AS FOLLOWS:

COMMENCE AT THE NORTHEAST CORNER OF SAID SECTION 3; THENCE ALONG THE EAST LINE OF SAID SECTION, S.00°14'54"E, 1992.01 FEET TO THE POINT OF BEGINNING; THENCE LEAVING SAID EAST LINE, S.89°30'28"E, 258.81 FEET; THENCE S.00°17'54"E, 1848.62 FEET; THENCE S.89°33'45"E, 1064.89 FEET; THENCE S.00°16'24"E, 160.53 FEET; THENCE S.89°40'23"E, 2435.49 FEET; THENCE S.00°50'49"E, 1100.23 FEET; THENCE N.89°40'23"W, 3567.03 FEET; THENCE S.00°26'15"W, 900.00 FEET; THENCE N.89°40'23"W, 300.00 FEET; THENCE S.00°26'15"W, 708.76 FEET; THENCE S.89°33'45"E, 1262.00 FEET; THENCE S.00°26'15"W, 300.00 FEET; THENCE S.33°24'33"W, 492.26 FEET; S.00°17'54"E, 295.00 FEET; THENCE S.89°42'06"W, 1267.00 FEET; THENCE N.00°17'54"W, 771.00 FEET; THENCE S.89°42'06"W, 3364.00 FEET; THENCE N.00°17'54"W, 517.00 FEET; THENCE N.89°42'06"E, 541.00 FEET; THENCE N.00°17'54"W, 1530.00 FEET; THENCE N.44°44'05"W, 591.33 FEET; THENCE N.00°17'54"W, 360.00 FEET; THENCE S.89°58'47"W, 253.00 FEET; THENCE N.00°00'57"W, 1100.00 FEET; THENCE N.89°59'03"E, 247.57 FEET; THENCE N.00°17'54"W, 891.01 FEET; THENCE N.17°02'21"E, 205.12 FEET; THENCE S.89°42'35"E, 1748.97 FEET; THENCE S.00°17'54"E, 73.97 FEET; THENCE N.89°42'06"E, 1206.00 FEET; THENCE N.00°17'54"W, 61.58 FEET; THENCE S.89°42'35"E, 621.25 FEET TO THE POINT OF BEGINNING, CONTAINING 549.4 ACRES, MORE OR LESS.

NOTES

1. THIS SURVEY WAS PREPARED WITHOUT BENEFIT OF A CURRENT TITLE REPORT AND THEREFORE MAY NOT NECESSARILY INDICATE ALL ENCUMBRANCES AFFECTING SUBJECT PROPERTY.
2. THERE ARE NO VISIBLE ENCROACHMENTS EXCEPT AS SHOWN.
3. THE LOCATION AND EXISTENCE OF UNDERGROUND UTILITIES AND UNDERGROUND FOUNDATIONS OR ANY OTHER PERTINENT ATTRIBUTES TO SUBJECT PROPERTY (IF ANY) NOT ABSTRACTED AS PART OF THIS SURVEY, EXCEPT AS SHOWN.
4. BEARINGS BASED ON GRID NORTH OF THE STATE PLANE COORDINATE SYSTEM FOR THE FLORIDA WEST ZONE, NAD 1983, AS ESTABLISHED BY G.P.S. SURVEY.
5. ALL DISTANCES ARE MEASURED IN FEET AND TENTHS OF A FOOT.
6. SUBJECT TO ALL RESTRICTIONS, RIGHTS-OF-WAY AND EASEMENTS OF RECORD.
7. REUSE OF DOCUMENTS: THIS DOCUMENT IS AN INSTRUMENT OF SERVICE IN RESPECT OF THE PROJECT TO WHICH IT APPLIES AND ANY REUSE WITHOUT WRITTEN VERIFICATION OR ADAPTATION BY BISHOP & ASSOCIATES (B&A) FOR THE SPECIFIC PURPOSES INTENDED WILL BE AT THE USER'S SOLE RISK AND WITHOUT LIABILITY OR LEGAL EXPOSURE TO B&A AND USER SHALL INDEMNIFY AND HOLD HARMLESS B&A FROM ALL CLAIMS, DAMAGES, LOSSES AND EXPENSES INCLUDING ATTORNEYS FEES ARISING OUT OF OR RESULTING THEREFROM. ANY SUCH VERIFICATION OR ADAPTATION WILL ENTITLE B&A TO FURTHER COMPENSATION AT RATES TO BE AGREED UPON BY USER AND B&A.
8. THE LIMITS OF THE O.U.C. AREAS WERE TAKEN FROM INFORMATION PROVIDED TO THIS FIRM BY CAMP, DRESSER AND MCKEE, INC.
9. THIS SURVEY PERFORMED BY BISHOP & ASSOCIATES, 78 SARASOTA CENTER BOULEVARD, SARASOTA, FLORIDA 34240, PHONE NO. (813) 371-6362.

LEGEND

- 4" x 4" CONCRETE MONUMENT SET (NUMBERED AS SHOWN)
(C) DENOTES CALCULATED DISTANCE, ALL OTHER DISTANCES SHOWN ARE MEASURED
25 DENOTES AERIAL TARGET

I HEREBY CERTIFY:

THAT THIS PLAT OF LAND SURVEY REPRESENTS A FIELD SURVEY PERFORMED ON NOVEMBER 27, 1991 UNDER MY DIRECTION AND THAT IT MEETS THE MINIMUM TECHNICAL STANDARDS FOR SURVEYING IN THE STATE OF FLORIDA AS SET FORTH BY THE FLORIDA BOARD OF LAND SURVEYORS, PURSUANT TO CHAPTER 472 OF THE FLORIDA STATUTES AND CHAPTER 21HH-6 OF THE FLORIDA ADMINISTRATIVE CODE.

BISHOP & ASSOCIATES
(LICENSED BUSINESS #128)
78 SARASOTA CENTER BLVD.
SARASOTA, FLORIDA 34240

DENNIS R. HOOVER
PROFESSIONAL LAND SURVEYOR
FLORIDA CERTIFICATE #4419

* THIS SURVEY NOT VALID UNLESS IMPRINTED WITH AN EMBOSSED SEAL AND SIGNED IN INK.

DISC NO 232

CONCRETE MONUMENT	NORTHING	EASTING	ELEVATION
S.E. 1	1041954.613	524005.663	21.07'
S.E. 2	1041957.467	524005.651	21.20'
S.E. 3	1041960.321	523905.639	21.42'
S.E. 4	1041963.175	523805.628	21.42'
S.E. 5	1041966.029	523805.616	20.99'
S.E. 6	1041968.814	523705.216	
S.E. 7	1042129.044	523269.451	21.40'
S.E. 8	1042133.109	521836.876	20.83'
S.E. 9	1042137.175	521304.593	21.03'
S.E. 10	1042137.166	521201.355	21.38'
S.E. 11	1042137.158	521098.136	21.48'
S.E. 12	1042136.722	521094.967	21.32'
S.E. 13	1042137.352	521036.162	
S.E. 14	1042139.143	520414.928	21.41'
S.E. 15	1042139.567	520415.248	21.17'
S.E. 16	1042139.416	520810.257	20.91'
S.E. 17	1042139.286	520709.265	20.60'
S.E. 18	1042139.253	520208.880	
S.E. 19	1042139.208	520205.917	20.54'

PROPOSED
SPECIAL EXCEPTION AREA
#1248
549.4± ACRES

EAST LINE OF
SECTION 3

POINT OF
COMMENCEMENT

NORTHEAST CORNER OF SECTION 3,
TOWNSHIP 38 SOUTH, RANGE 19 EAST

BEARING BASIS
S.00°14'54"E

POINT OF
BEGINNING

WALTON TRACT
BOUNDARY

SECTION LINES

O.U.C.
AREA

FLORIDA POWER AND LIGHT EASEMENT

10

11

DESIGNED BY: _____ DRAWN BY: _____ SHEET CHK'D BY: _____ CROSS CHK'D BY: _____ APPROVED BY: _____ DATE: MARCH 1994				CAMP DRESSER & McKEE INC.		SARASOTA COUNTY, FLORIDA		SPECIAL EXCEPTION BOUNDARY		PROJECT NO. 9250-58	
REV. NO. DATE DRWN CHKD REMARKS				environmental engineers, scientists, planners, & management consultants		CENTRAL COUNTY SOLID WASTE DISPOSAL COMPLEX				SHEET NO. G-5	