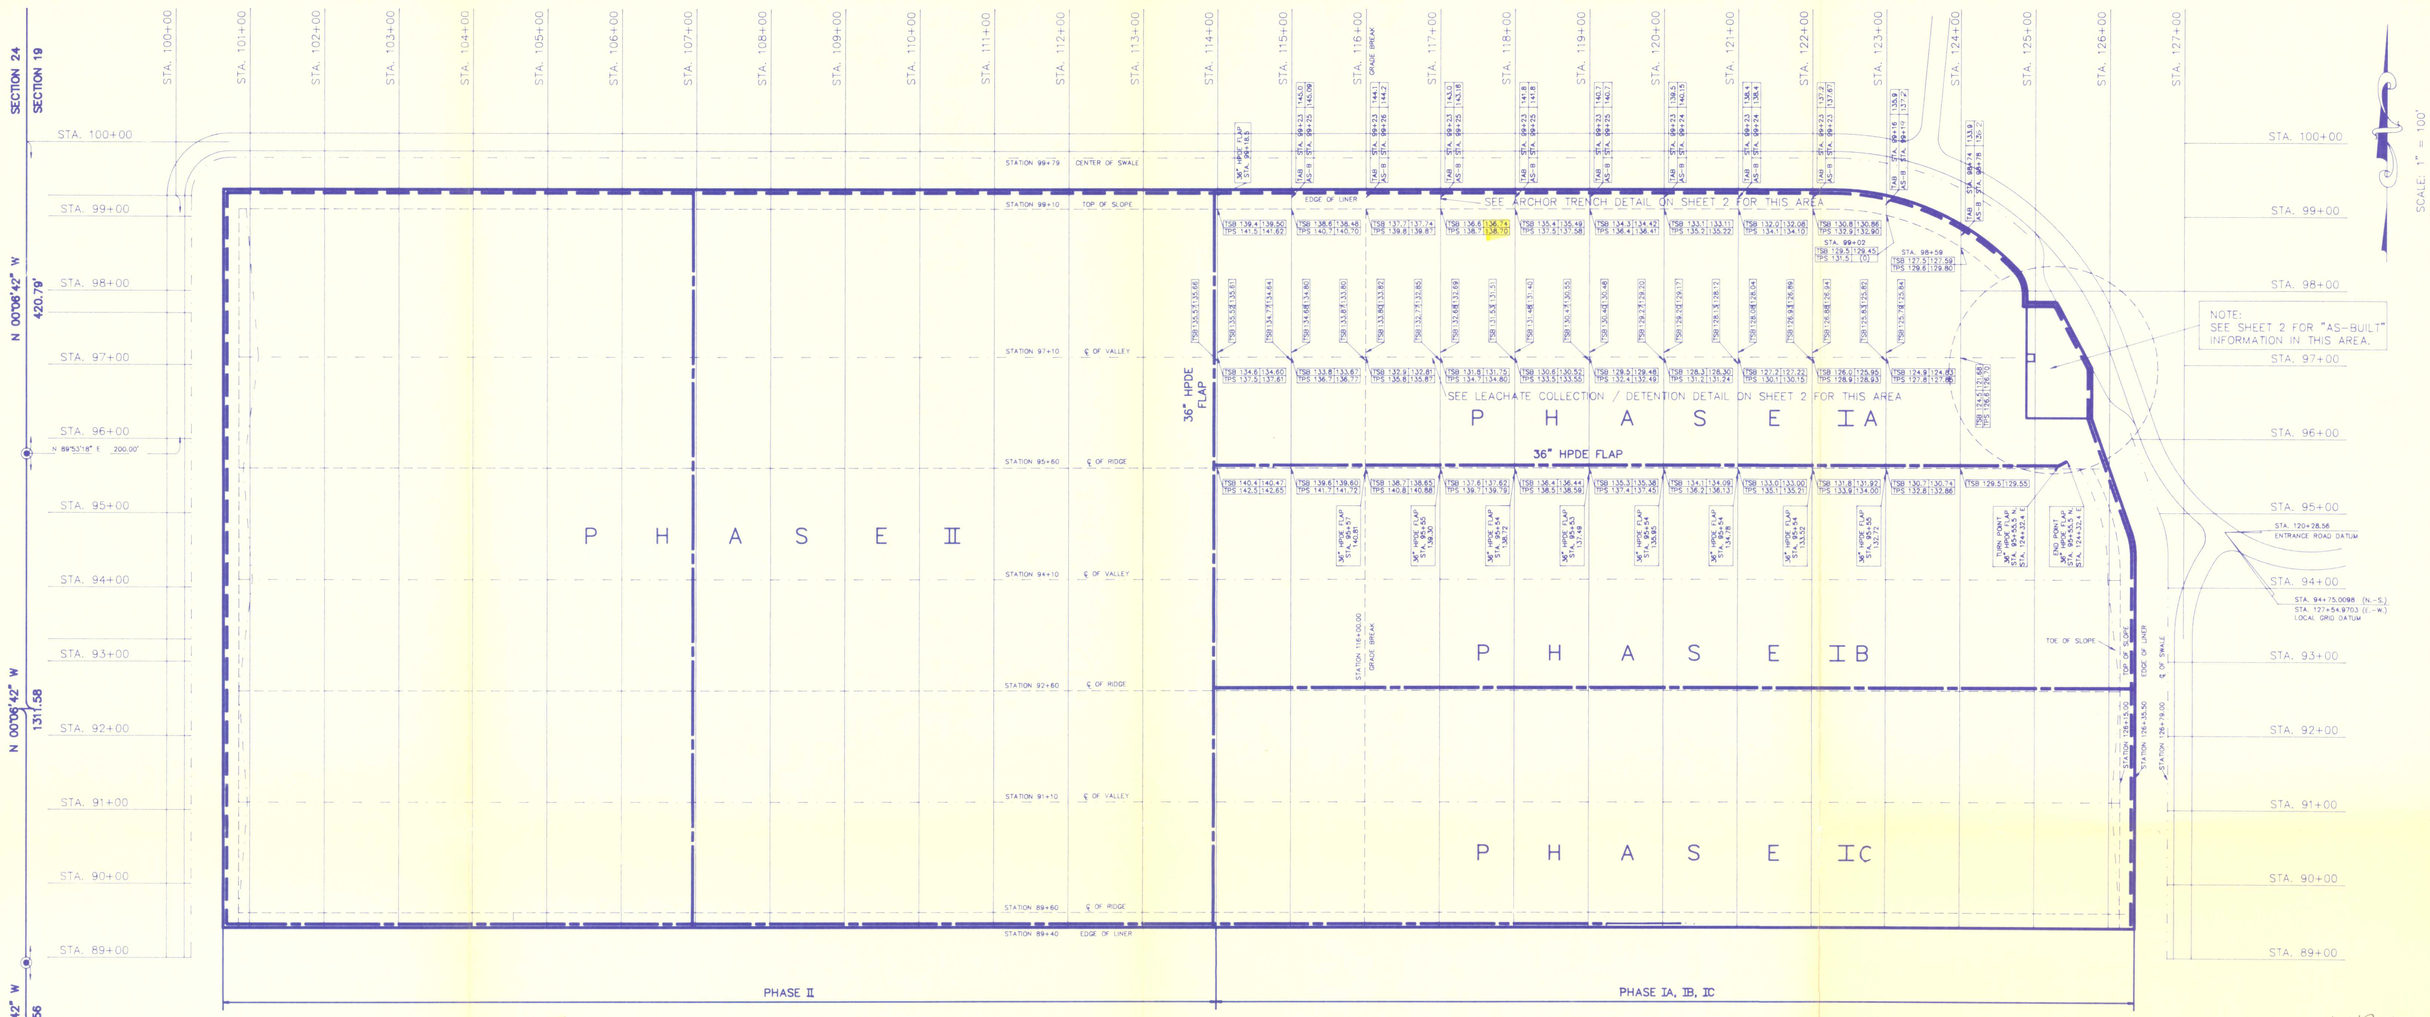


"AS-BUILT" BY SUNSHINE STATE SURVEYORS INC.

PHASE	DATE:	LOCATION:	
I A	3-9-92 3-9-92	STA. 95+60.00 TO STA. 97+86.00 (NORTH) STA. 124+17.60 TO STA. 125+76.00 (EAST)	(CONTAINMENT AREA)
I A	3-14-92 3-14-92	STA. 95+60.00 TO STA. 99+10.00 (NORTH) STA. 114+00.00 TO STA. 117+00.00 (EAST)	
I A	3-18-92 3-18-92	STA. 97+06.00 TO STA. 99+10.00 (NORTH) STA. 114+00.00 TO 118+00.00 (EAST)	
I A	3-20-92 3-20-92	STA. 97+05.00 TO STA. 99+10.00 (NORTH) STA. 119+00.00 (EAST)	
I A	3-20-92 3-20-92	STA. 97+05.00 TO STA. 97+15.00 (NORTH) STA. 13+80.00 TO STA. 14+00.00 (EAST)	
I A	3-21-92 3-21-92	STA. 97+05.00 TO STA. 99+10.00 (NORTH) STA. 120.00 (EAST)	
I A	3-25-92 3-25-92	STA. 95+60.00 TO STA. 99+10.00 (NORTH) STA. 121+00.00 TO STA. 122+00.00 (EAST)	
I A	3-25-92 3-25-92	STA. 96+95.00 TO SAT. 97+25.00 (NORTH) STA. 125+00.00 TO STA. 125+50.00 (EAST)	(CONTAINMENT AREA)
I A	3-31-92 3-31-92	STA. 95+60.00 TO STA. 99+01.68 (NORTH) STA. 122+20.00 TO STA. 123+00.00 (EAST)	
I A	4-1-92 4-1-92	STA. 95+60.00 TO STA. 98+59.00 (NORTH) STA. 123+20.00 TO STA. 124+00.00 (EAST)	
I B	4-6-92 4-6-92	STA. 92+60.00 TO STA. 95+45.00 (NORTH) STA. 114+00.00 TO STA. 117+00.00 (EAST)	
I B	4-10-92 4-10-92	STA. 92+60.00 TO STA. 95+45.00 (NORTH) STA. 118+00.00 TO STA. 122+00.00 (EAST)	
I A & I B	4-23-92 4-23-92	STA. 92+60.00 TO STA. 98+00.00 (NORTH) STA. 124+00.00 TO STA. 126+15.00 (EAST)	
I C	5-6-92 5-6-92	STA. 89+40.00 TO STA. 92+35.00 (NORTH) STA. 122+00.00 TO STA. 123+00.00 (EAST)	
I C	5-8-92 5-8-92	STA. 89+40.00 TO STA. 92+35.00 (NORTH) STA. 124+00.00 TO STA. 125+85.00 (EAST)	
I A	5-8-92 5-8-92	STA. 95+53.00 TO STA. 99+31.00 (NORTH) STA. 114+00.00 TO STA. 124+00.00 (EAST)	
I A	5-11-92 5-11-92	STA. 95+60.00 TO STA. 99+08.00 (NORTH) STA. 114+00.00 TO STA. 123+00.00 (EAST)	
I C	5-11-92 5-11-92	STA. 89+40.00 TO STA. 92+35.00 (NORTH) STA. 125+90.00 TO STA. 126+15.00 (EAST)	

NOTE:
FOR DETAILS SEE SHEET NO. 2

LOCAL GRID DATUM
NORTHERLY LINE OF GRID: N. 89° 53' 18" E.
WESTERLY LINE OF GRID: N. 00° 06' 42" W.
REFERENCE STATIONS: 100+00.00 (N.-S.)
100+00.00 (E.-W.) AT THE POINT OF
INTERSECTIONS (P.I.) FOR CURVE NUMBER 2

LEGEND
- PHASE LINE
- 36" HPDE FLAP
- LINER
- ℄ OF VALLEY
- ℄ OF RIDGE
- ℄ OF DITCH
- FLOW ARROWS
- TOP OF SUBBASE ELEV.: (DESIGN) (AS-BUILT) TSB 149.2 TPS 151.3
- TOP OF PROTECTIVE SOIL ELEV.
- TOP OF ANCHOR BERM: (DESIGN) TAB STA. 99+23 145.0; AS-B STA. 99+25 145.09 ("AS-BUILT")

WAPS # 33628

1649457

"AS-BUILT"

NORTHEAST DISTRICT
RECEIVED
JUL 13 1992
DER-JACKSONVILLE

SHEET 1 OF 2


DATE	PHASE
5-12-92	IA

I HEREBY CERTIFY THAT THE CLAY SUB-BASE, PROTECTIVE SAND, 36" HPDE FLAP, AND THE TOP OF CLAY BERM SHOWN HEREON ARE AT THE HORIZONTAL AND/OR VERTICAL LOCATION AS DEPICTED ON THIS "AS-BUILT" AND MEETS THE MINIMUM TECHNICAL STANDARDS AS SET FORTH BY CHAPTER 472.027 OF THE FLORIDA STATUTES.

ROBERT S. CORSATI FLA. REG. SURVEYOR NO. 4341

LINER SYSTEM AS-BUILT FOR TRAIL RIDGE LANDFILL JACKSONVILLE, DUVAL COUNTY, FLORIDA

SUNSHINE STATE SURVEYORS, INC.
SURVEYORS & LAND PLANNERS 3131 ST. JOHNS BLUFF RD. SOUTH, JACKSONVILLE, FLORIDA 32216
(904) 642-8550

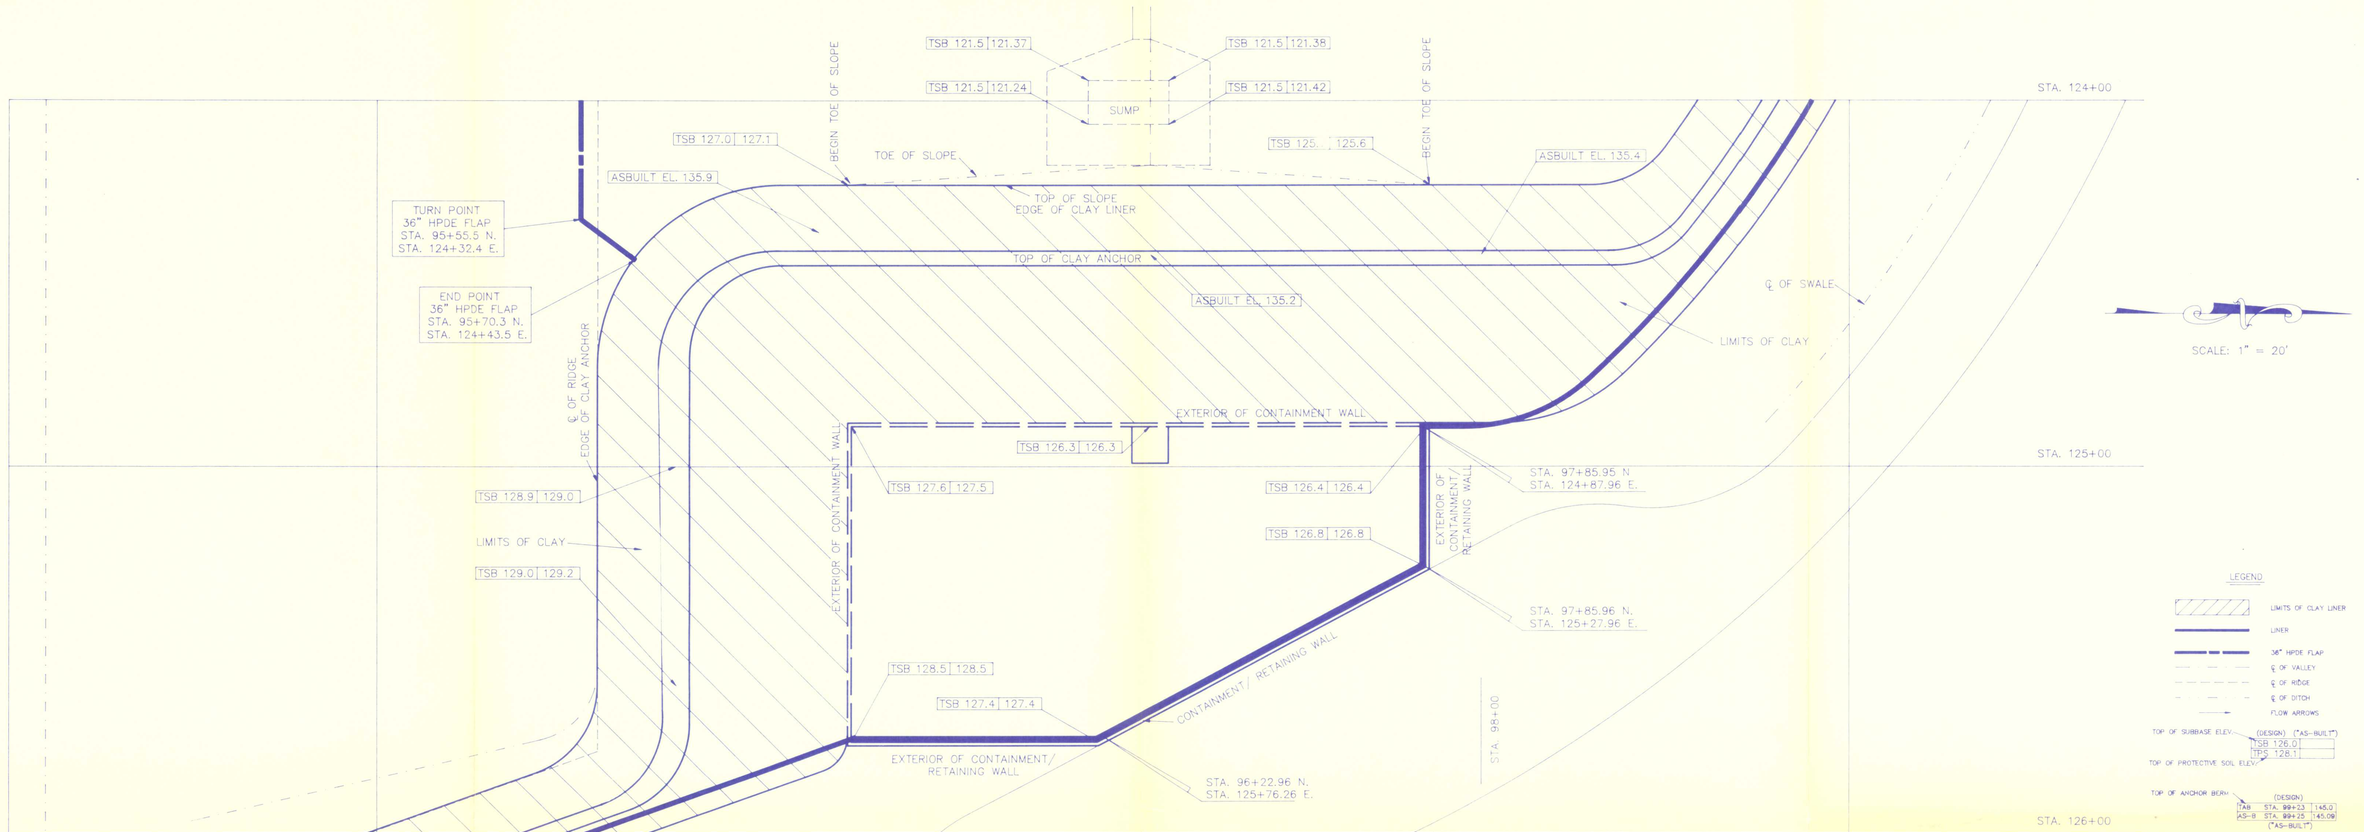

SCALE: 1" = 20'

LEGEND

- LIMITS OF CLAY LINER
- LINER
- 36" HPDE FLAP
- ℄ OF VALLEY
- ℄ OF RIDGE
- ℄ OF DITCH
- FLOW ARROWS


TOP OF SUBBASE ELEV.	(DESIGN)	("AS-BUILT")
	TSB	126.0
	TPS	128.1

TOP OF PROTECTIVE SOIL ELEV.


TOP OF ANCHOR BERM

		(DESIGN)
TAB	STA. 99+23	145.0
AS-B	STA. 99+25	145.09

("AS-BUILT")

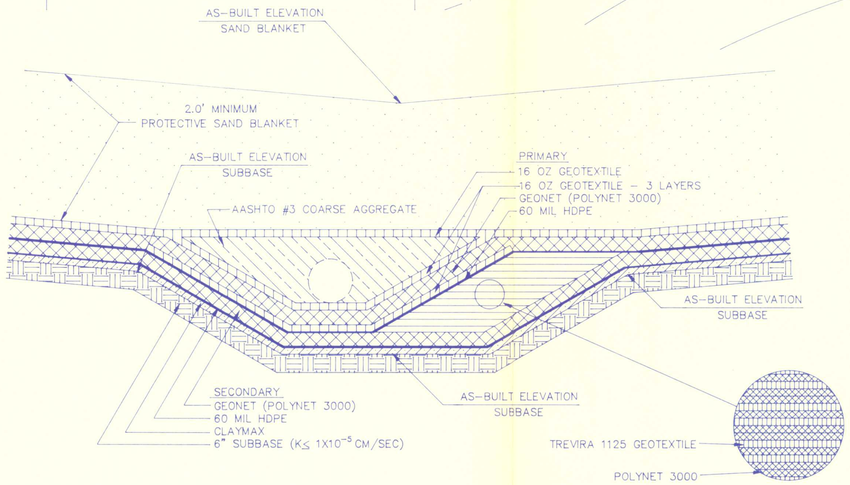

LEACHATE COLLECTION / DETECTION TRENCH DETAIL

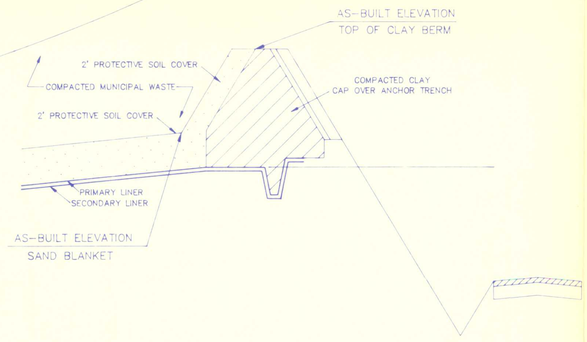

NORTH ANCH DETAILOR TRENCH DETAIL

SCALE: 1" = 20' HORIZONTAL
1" = 4' VERTICAL

SHEET 2 OF 2

DATE	PHASE
5-12-92	IA

I HEREBY CERTIFY THAT THE CLAY SUB-BASE, PROTECTIVE SAND, 36" HPDE FLAP, AND THE TOP OF CLAY BERM SHOWN HEREON ARE AT THE HORIZONTAL AND/OR VERTICAL LOCATION AS DEPICTED ON THIS "AS-BUILT" AND MEETS THE MINIMUM TECHNICAL STANDARDS AS SET FORTH BY CHAPTER 472.027 OF THE FLORIDA STATUTES.

ROBERT S. CORSAT FLA. P.S.M. SURVEYOR NO. 4341

"AS-BUILT"

LINER SYSTEM AS-BUILT FOR TRAIL RIDGE LANDFILL JACKSONVILLE, DUVAL COUNTY, FLORIDA

SUNSHINE STATE SURVEYORS, INC.

SURVEYORS & LAND PLANNERS 3131 ST. JOHNS BLUFF RD. SOUTH, JACKSONVILLE, FLORIDA 32216

(904) 642-8550