
GRAPHIC SCALE

400 0 200 400

(IN FEET)

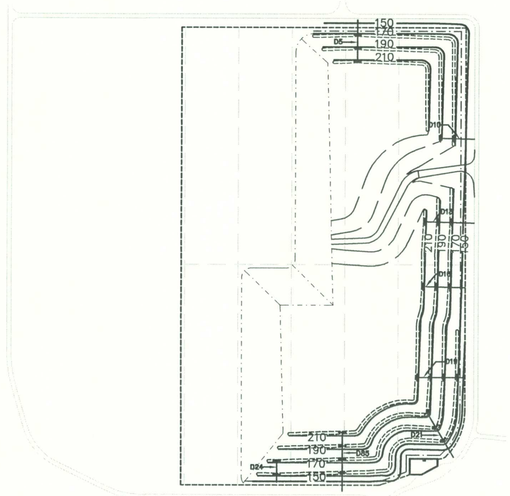


FILL PHASE 1

GRAPHIC SCALE

400 0 200 400

(IN FEET)

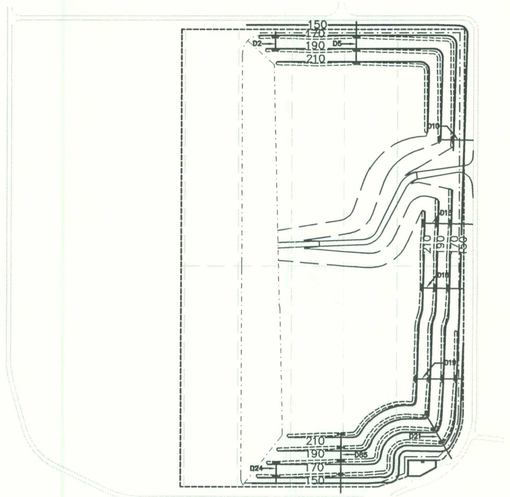


FILL PHASE 2

GRAPHIC SCALE

400 0 200 400

(IN FEET)

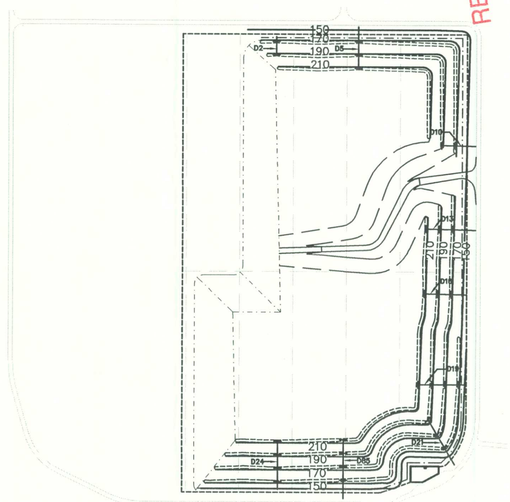


FILL PHASE 3

GRAPHIC SCALE

400 0 200 400

(IN FEET)

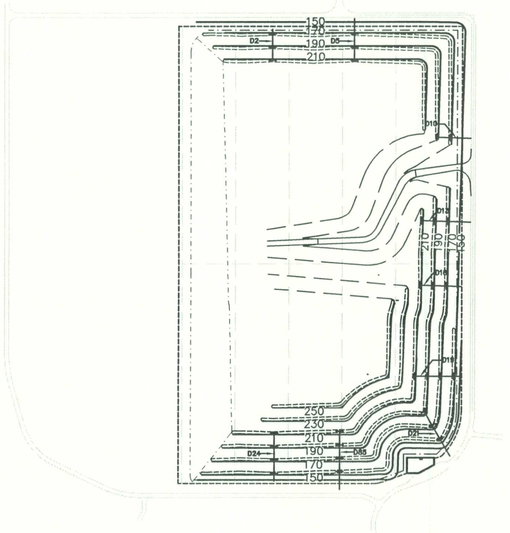


FILL PHASE 4

GRAPHIC SCALE

400 0 200 400

(IN FEET)

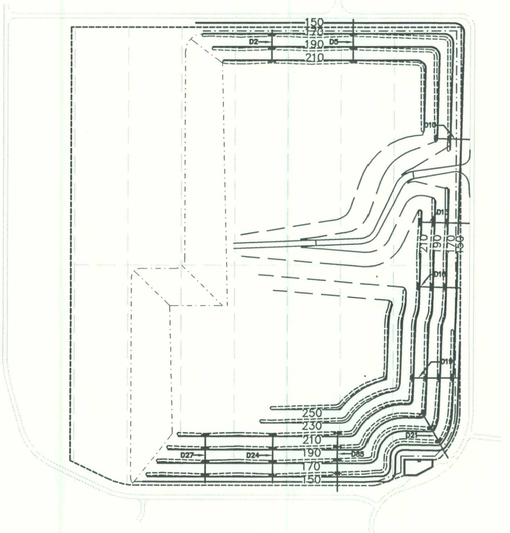


FILL PHASE 5

GRAPHIC SCALE

400 0 200 400

(IN FEET)

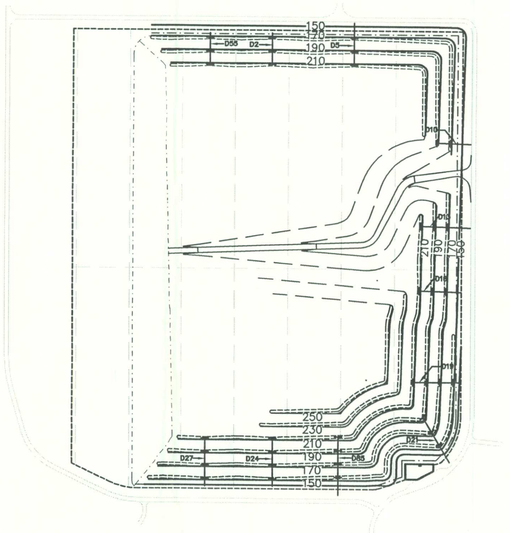

FILL PHASE 6

LEGEND

—150—	FINAL CONTOUR
- - - - -	LIMITS OF LINER
	LINER PHASE LINE
- · - · -	LIMITS OF FILL
	ACCESS ROAD
	ROADWAY
= = = = =	TERRACE
+ + + +	DOWNCOMER PIPE
▨	10' BERM

NOTE:
FILL PHASES MAY BE CHANGED DUE TO OPERATIONAL NEEDS.

RECEIVED
JAN 04 2001
STATE OF FLORIDA
DEPT. OF ENV. PROTECTION
NORTHEAST DISTRICT

SUBMITTED TO DEP: 10-28-96

REVISIONS:
2-25-00 REVISED FILL PHASES 4, 5 & 6 TO INCLUDE EL. 230 & 250
11-6-00 REVISED FILL PHASES 4, 5 & 6 TO REMOVE WESTERN HIGH RISE (EL. 230 & 250)

ETM. NO. E 96 - 49
DRAWN BY: J.B.C.
DESIGNED BY: J.B.C.
CHECKED BY: D.C.M.
DATE: OCTOBER 28, 1996

PERMIT DOCUMENT

FILL PHASING PLAN

TRAIL RIDGE LANDFILL PERMIT RENEWAL
FOR
TRAIL RIDGE LANDFILL, INC.


England-Thims & Miller, Inc.
Consulting & Design Engineers
3131 ST. JOHNS BLUFF ROAD SOUTH
JACKSONVILLE, FLORIDA 32246
PHONE NUMBER (904) 642-8990 FAX NUMBER (904) 646-9485

DRAWING NO.
11

GRAPHIC SCALE

400 0 200 400

(IN FEET)

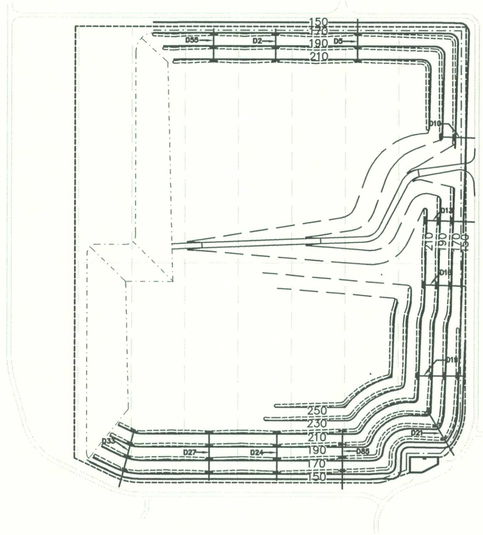


FILL PHASE 7

GRAPHIC SCALE

400 0 200 400

(IN FEET)

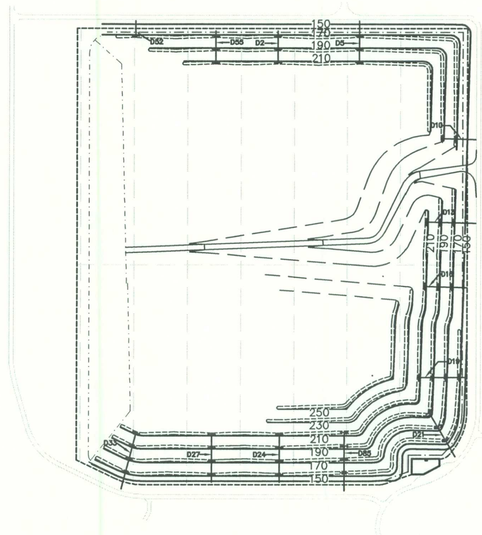


FILL PHASE 8

GRAPHIC SCALE

400 0 200 400

(IN FEET)

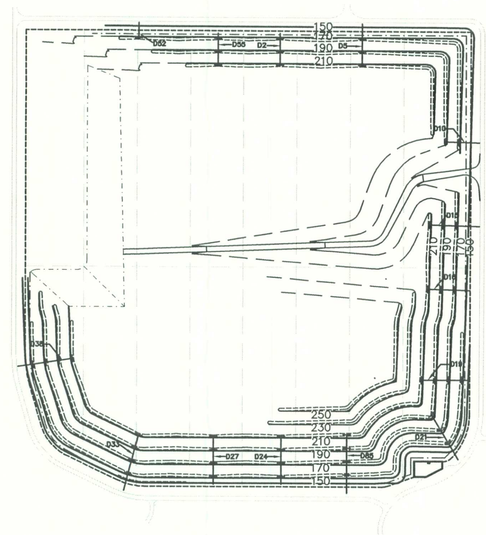


FILL PHASE 9

GRAPHIC SCALE

400 0 200 400

(IN FEET)

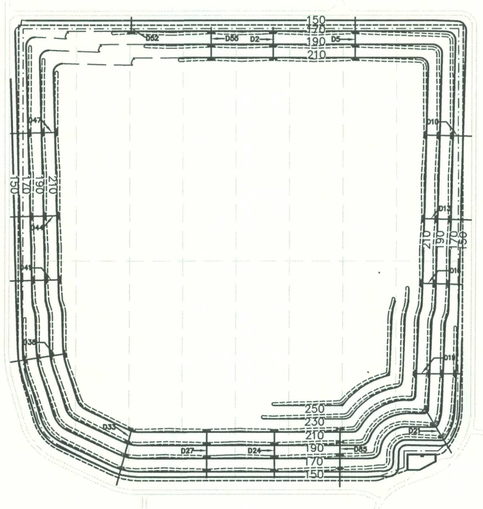


FILL PHASE 10

GRAPHIC SCALE

400 0 200 400

(IN FEET)

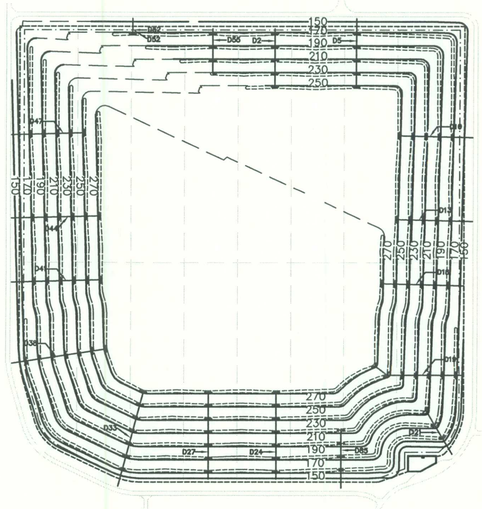


FILL PHASE 11

GRAPHIC SCALE

400 0 200 400

(IN FEET)

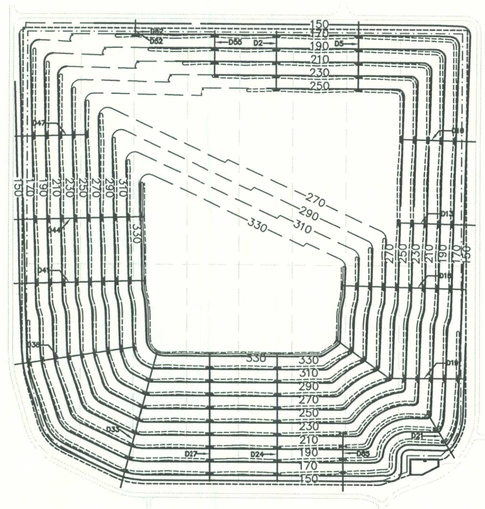

FILL PHASE 12

LEGEND

—150—	FINAL CONTOUR
- - - - -	LIMITS OF LINER
	LINER PHASE LINE
-·-·-·-	LIMITS OF FILL
	ACCESS ROAD
	ROADWAY
=========	TERRACE
++++	DOWNCOMER PIPE
ZZZZZZZ	10' BERM

NOTE:
FILL PHASES MAY BE CHANGED DUE TO OPERATIONAL NEEDS.

PERMIT DOCUMENT

FILL PHASING PLAN

TRAIL RIDGE LANDFILL PERMIT RENEWAL FOR TRAIL RIDGE LANDFILL, INC.

SUBMITTED TO DEP: 10-28-96

REVISIONS:
2-25-00 REVISED FILL PHASES 7 - 12

ETM. NO. E 96 - 49
DRAWN BY: J.B.C.
DESIGNED BY: J.B.C.
CHECKED BY: D.C.M.
DATE: OCTOBER 28, 1996

England-Thims & Miller, Inc.
Consulting & Design Engineers
3131 ST. JOHNS BLUFF ROAD SOUTH
JACKSONVILLE, FLORIDA 32246
PHONE NUMBER (904) 642-8990 FAX NUMBER (904) 646-9485

DRAWING NO.

12