


Johnson, Sabrina O

From: Kobzar, Daniel <Daniel.Kobzar@terracon.com>
Sent: Tuesday, April 14, 2020 2:16 PM
To: Chamberlain, Justin
Cc: Morgan, Steve; Madden, Melissa; SWD_Waste; Tom Funcheon; Nick Makris; Cline, Donna L; Bennett, Keith D; SSmith; jschilling@ddadevelopment.com
Subject: City of Tarpon Springs - Permit No. 69711-004-SF/14, WACS #47035 - Meres Blvd Extension - Notification of Additional Dropout
Attachments: IMG_2073.JPG; IMG_2072.JPG; imagejpeg_1.jpg

Dear Mr. Chamberlain:

Pursuant to Section 2-C.3 of the reference Permit, Terracon, on behalf of the City of Tarpon Springs and Meres Crossing LLC would like to notify you of a dropout that occurred at the reference site during the process of Compaction Grouting. The initial size of the dropout was approximately 5 feet in diameter and 3 feet deep when first observed. The final size of the dropout was approximately 7 ft wide and 10 ft deep after stabilization. The new dropout DO-11 occurred in the vicinity of previous dropouts in the area of the proposed Pond 3 (next to the point 36 on the attached image) this morning at 10 AM. This area is currently in the process of being grouted. It was noted in our geotechnical report that additional ground movement was possible during grouting. The dropout had been backfilled, and is being monitored. Measures have been taken to keep all on-site personal alert and aware of the hazard. This dropout will be added to our current grouting plan. That plan will be updated when the originally planned grouting in this area is completed.

Please do not hesitate to contact us with any questions.

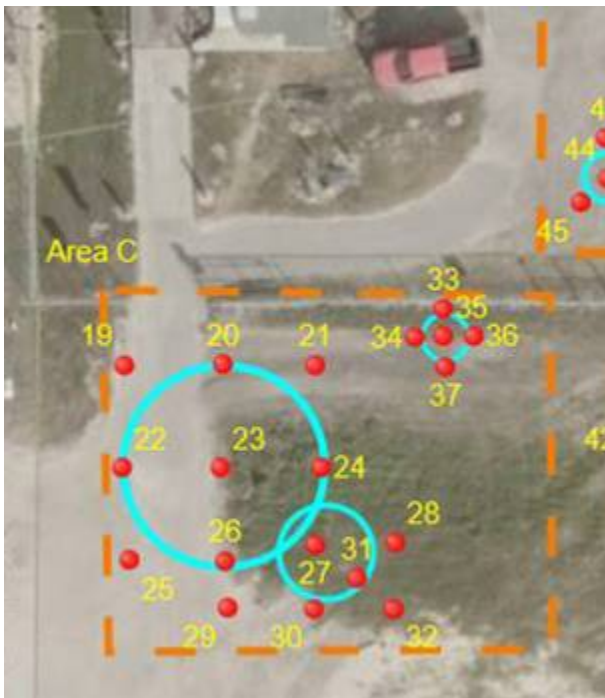

Daniel Kobzar, P.E.
Staff Engineer



5463 W. Waters Ave., Suite 830 | Tampa, Florida 33634

Phone [813] 947-7349 | Cell [413] 777-8719

daniel.kobzar@terracon.com | terracon.com

Terracon provides environmental, facilities, geotechnical, and materials consulting engineering services delivered with responsiveness, resourcefulness, and reliability.

Private and confidential as detailed here

(<https://clicktime.symantec.com/38myTSNPuNwqn9Pu7HS4mEq7Vc?u=www.terracon.com%2Fdisclaimer>). If you cannot access the hyperlink, please e-mail sender.





