SCS ENGINEERS

February 3, 2022 File No. 09217088.24

Ms. Elizabeth Kromhout, PG, Environmental Administrator Florida Department of Environmental Protection - Division of Waste Management Permitting & Compliance Assistance Program - Solid Waste Permitting 2600 Blair Stone Road, MS 4565 Tallahassee, FL 32399

Manatee County Lena Road Landfill Subject:

> Certification of Construction Completion Report Subsequence 4A Expansion Construction Project

Dear Mr. Tafuni:

On behalf of the Manatee County Solid Waste Division (County), SCS Engineers, Inc. (SCS) has prepared this Certification of Construction Completion Report for the Lena Road Class I Landfill, Subsequence 4A Expansion Construction Project (Project) in accordance with the Florida Department of Environmental Protection (FDEP) Operation Permit No. 39884-021-SO-01 Part B.2.

Excavation of the Project commenced in October 2021 and was completed in January 2022. The Project was constructed in compliance with the Operation Permit and drawings, which include the following:

 Sheet 5 of the Operation Permit Drawings entitled Sequence 3, Lena Road Landfill, Stage II Fill Sequence, signed and sealed by SCS dated March 22, 2021.

An as-built survey of the Project was conducted by Hyatt Survey Services, Inc. (Hyatt) and is provided in Attachment A.

As indicated on Drawings 3 and 4 provided in Attachment B, base grades for Subsequence 4A are similar to the FDEP approved base grades based on the Hyatt as-built survey. SCS has confirmed there is at least 5 feet of elevation difference between the existing Leachate Collection and Removal System pipes and the top of the drainage layer within Subsequence 4A.

Representative photographs of the Project collected by SCS are also provided in Attachment C of this Report.

Based on the above information, the Project was completed in substantial conformance with the FDEP Operation Permit. The County wishes to receive FDEP approval of this Project in order to begin disposing of solid waste in this area. Therefore, your prompt review of this submittal is appreciated.

Please do not hesitate to contact us should you have any questions or require additional information.

Ms. Elizabeth Kromhout, PG February 3, 2022 Page 2

Sincerely,

Shane R. Fischer, P.E. Vice President

SCS Engineers

Carlo Lebron, P.E. **Business Unit Director** SCS Engineers

SRF/cfl

Robert Shankle, Manatee County cc:

Bryan White, Manatee County Anthony Detweiler, Manatee County Bob Bennett, Manatee County

Steve Morgan, FDEP Southwest District Steven Tafuni, FDEP Southwest District

Enclosures

This item has been digitally signed and sealed by

Printed copies of this document are not considered signed and sealed and the signature must be verified on any electronic copies.



ATTACHMENT A HYATT ASBUILT SURVEY

SURVEYOR NOTES

- 1. THIS SURVEY IS REFERENCED TO A PROJECTION OF THE STATE PLANE COORDINATE SYSTEM OF FLORIDA WEST ZONE (NAD 83/11).
- 2. THE ELEVATIONS DEPICTED HEREON WERE DERIVED FROM THE CONTROL PROVIDED WITHIN A SURVEYOR'S REPORT PREPARED BY PICKETT SURVEYING AND ENGINEERING PROJECT NUMBER 18600-1 DATED 2/14/19.
- 3. THE HORIZONTAL AND VERTICAL COORDINATES OF THE SITE BENCH MARKS WERE DERIVED FROM REDUNDANT RTK GPS OBSERVATIONS AND DIFFERENTIAL LEVELING METHODS.
- 4. THIS IS NOT A BOUNDARY SURVEY.
- 5. THIS SURVEY IS SUBJECT TO PERTINENT EASEMENTS, RIGHTS OF WAY AND RESTRICTIONS OF RECORD, IF ANY.
- 6. THE LOCATION OF UTILITIES, FOUNDATIONS OR STRUCTURES, IF ANY, BENEATH THE
- CERTIFIED TO BELOW FOR THE EXPRESS PURPOSE STATED HEREON AND/OR CONTAINED IN THE CONTRACT BETWEEN HYATT SURVEY SERVICES, INC. AND THE CLIENT FOR THIS PROJECT. COPYING, DISTRIBUTING AND/OR USING THIS DRAWING, IN WHOLE OR IN PART FOR ANY PURPOSE OTHER THAN ORIGINALLY INTENDED WITHOUT WRITTEN CONSENT FROM HYATT SURVEY SERVICES, INC. IS STRICTLY PROHIBITED AND RENDERS THE SURVEYOR'S CERTIFICATION, SIGNATURE AND SEAL NULL AND VOID. ANY QUESTIONS CONCERNING THE CONTENT OR PURPOSE OF THIS DRAWING SHOULD BE DIRECTED TO HYATT SURVEY SERVICES, INC.

TURE FA ned by Russell P 02.03 11:54:03

Services,

Survey

Hyatt

TRONIC SIGNATURE OF A
COR AND MAPPER.

Digitally signed by Ru
Hyatt
Date: 2022.02.03 11:5
-05'00'

Russell P
Hyatt

ANATEE COUNTY, FLORI



PROJECT #		12-1697-17	
SURVEY #			
SECTION TWN RNG	1-35S-18E 6-35S-19E 31-34S-19E		
SCALE		1" = 60	
SURVEYED		HYATT	01/2022
DESIGNED	Τ		
DRAWN		DAR	01/2022
CHECKED		RPH	01/2022

SHEET 1 OF 1

LEGEND

BENCH MARK (SEE CONTROL TABLE)

STAINLESS STEEL ROD SET NAIL AND DISK

FS SET FENO SPIKE

MKG MARKER

OP TOP OF PIPE

TOP TOP OF P
INV INVERT

ATTACHMENT D
ATTACHMENT B
ATTACHMENT B SCS CERTIFICATION OF CONSTRUCITON COMPLETION DRAWINGS

MANATEE COUNTY UTILITIES DEPARTMENT LENA ROAD LANDFILL

CERTIFICATION OF CONSTRUCTION COMPLETION SUBSEQUENCE 4A


MANATEE COUNTY, FLORIDA

JANUARY 2022



MANATEE COUNTY BOARD OF COUNTY COMMISSIONERS

DISTRICT 1 JAMES SATCHER DISTRICT 2 REGGIE BELLAMY KEVIN VAN OSTENBRIDGE DISTRICT 3 **DISTRICT 4 MISTY SERVIA** VANESSA BAUGH DISTRICT 5 **CAROL WHITMORE AT LARGE AT LARGE GEORGE KRUSE**

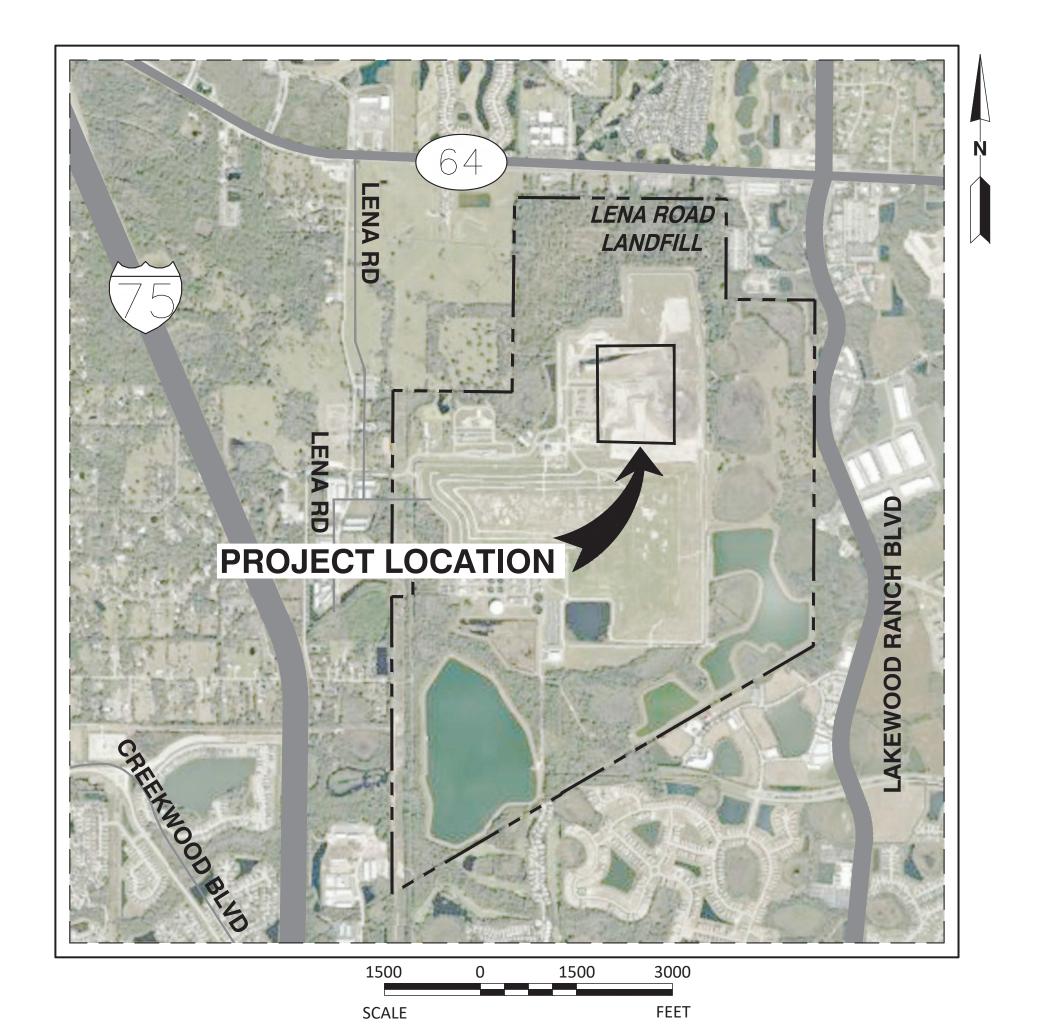

SCS ENGINEERS

LOCATION MAP

STEARNS, CONRAD AND SCHMIDT **CONSULTING ENGINEERS, INC.** 3922 COCONUT PALM DRIVE, SUITE 102 **TAMPA, FL 33619** PH. (813) 621-0080 FAX. (813) 623-6757 **FIRM REGISTRATION RY 4892** WWW.SCSENGINEERS.COM

SCS PROJECT NO. 09217088.24



THIS ITEM HAS BEEN DIGITALLY SIGNED AND SEALED BY SHANE R. FISCHER, P.E. ON THE DATE ADJACENT TO THE

Sheet List Table


Sheet Title

SUBSEQUENCE 4A EXPANSION

PRINTED COPIES OF THIS DOCUMENT ARE NOT CONSIDERED SIGNED AND SEALED AND THE SIGNATURE MUST BE VERIFIED ON ANY ELECTRONIC COPIES.



WHEN DRAWINGS ARE REDUCED IN SIZE FROM ORIGINAL 24" X 36", SCALING WILL NOT BE ACCURATE.

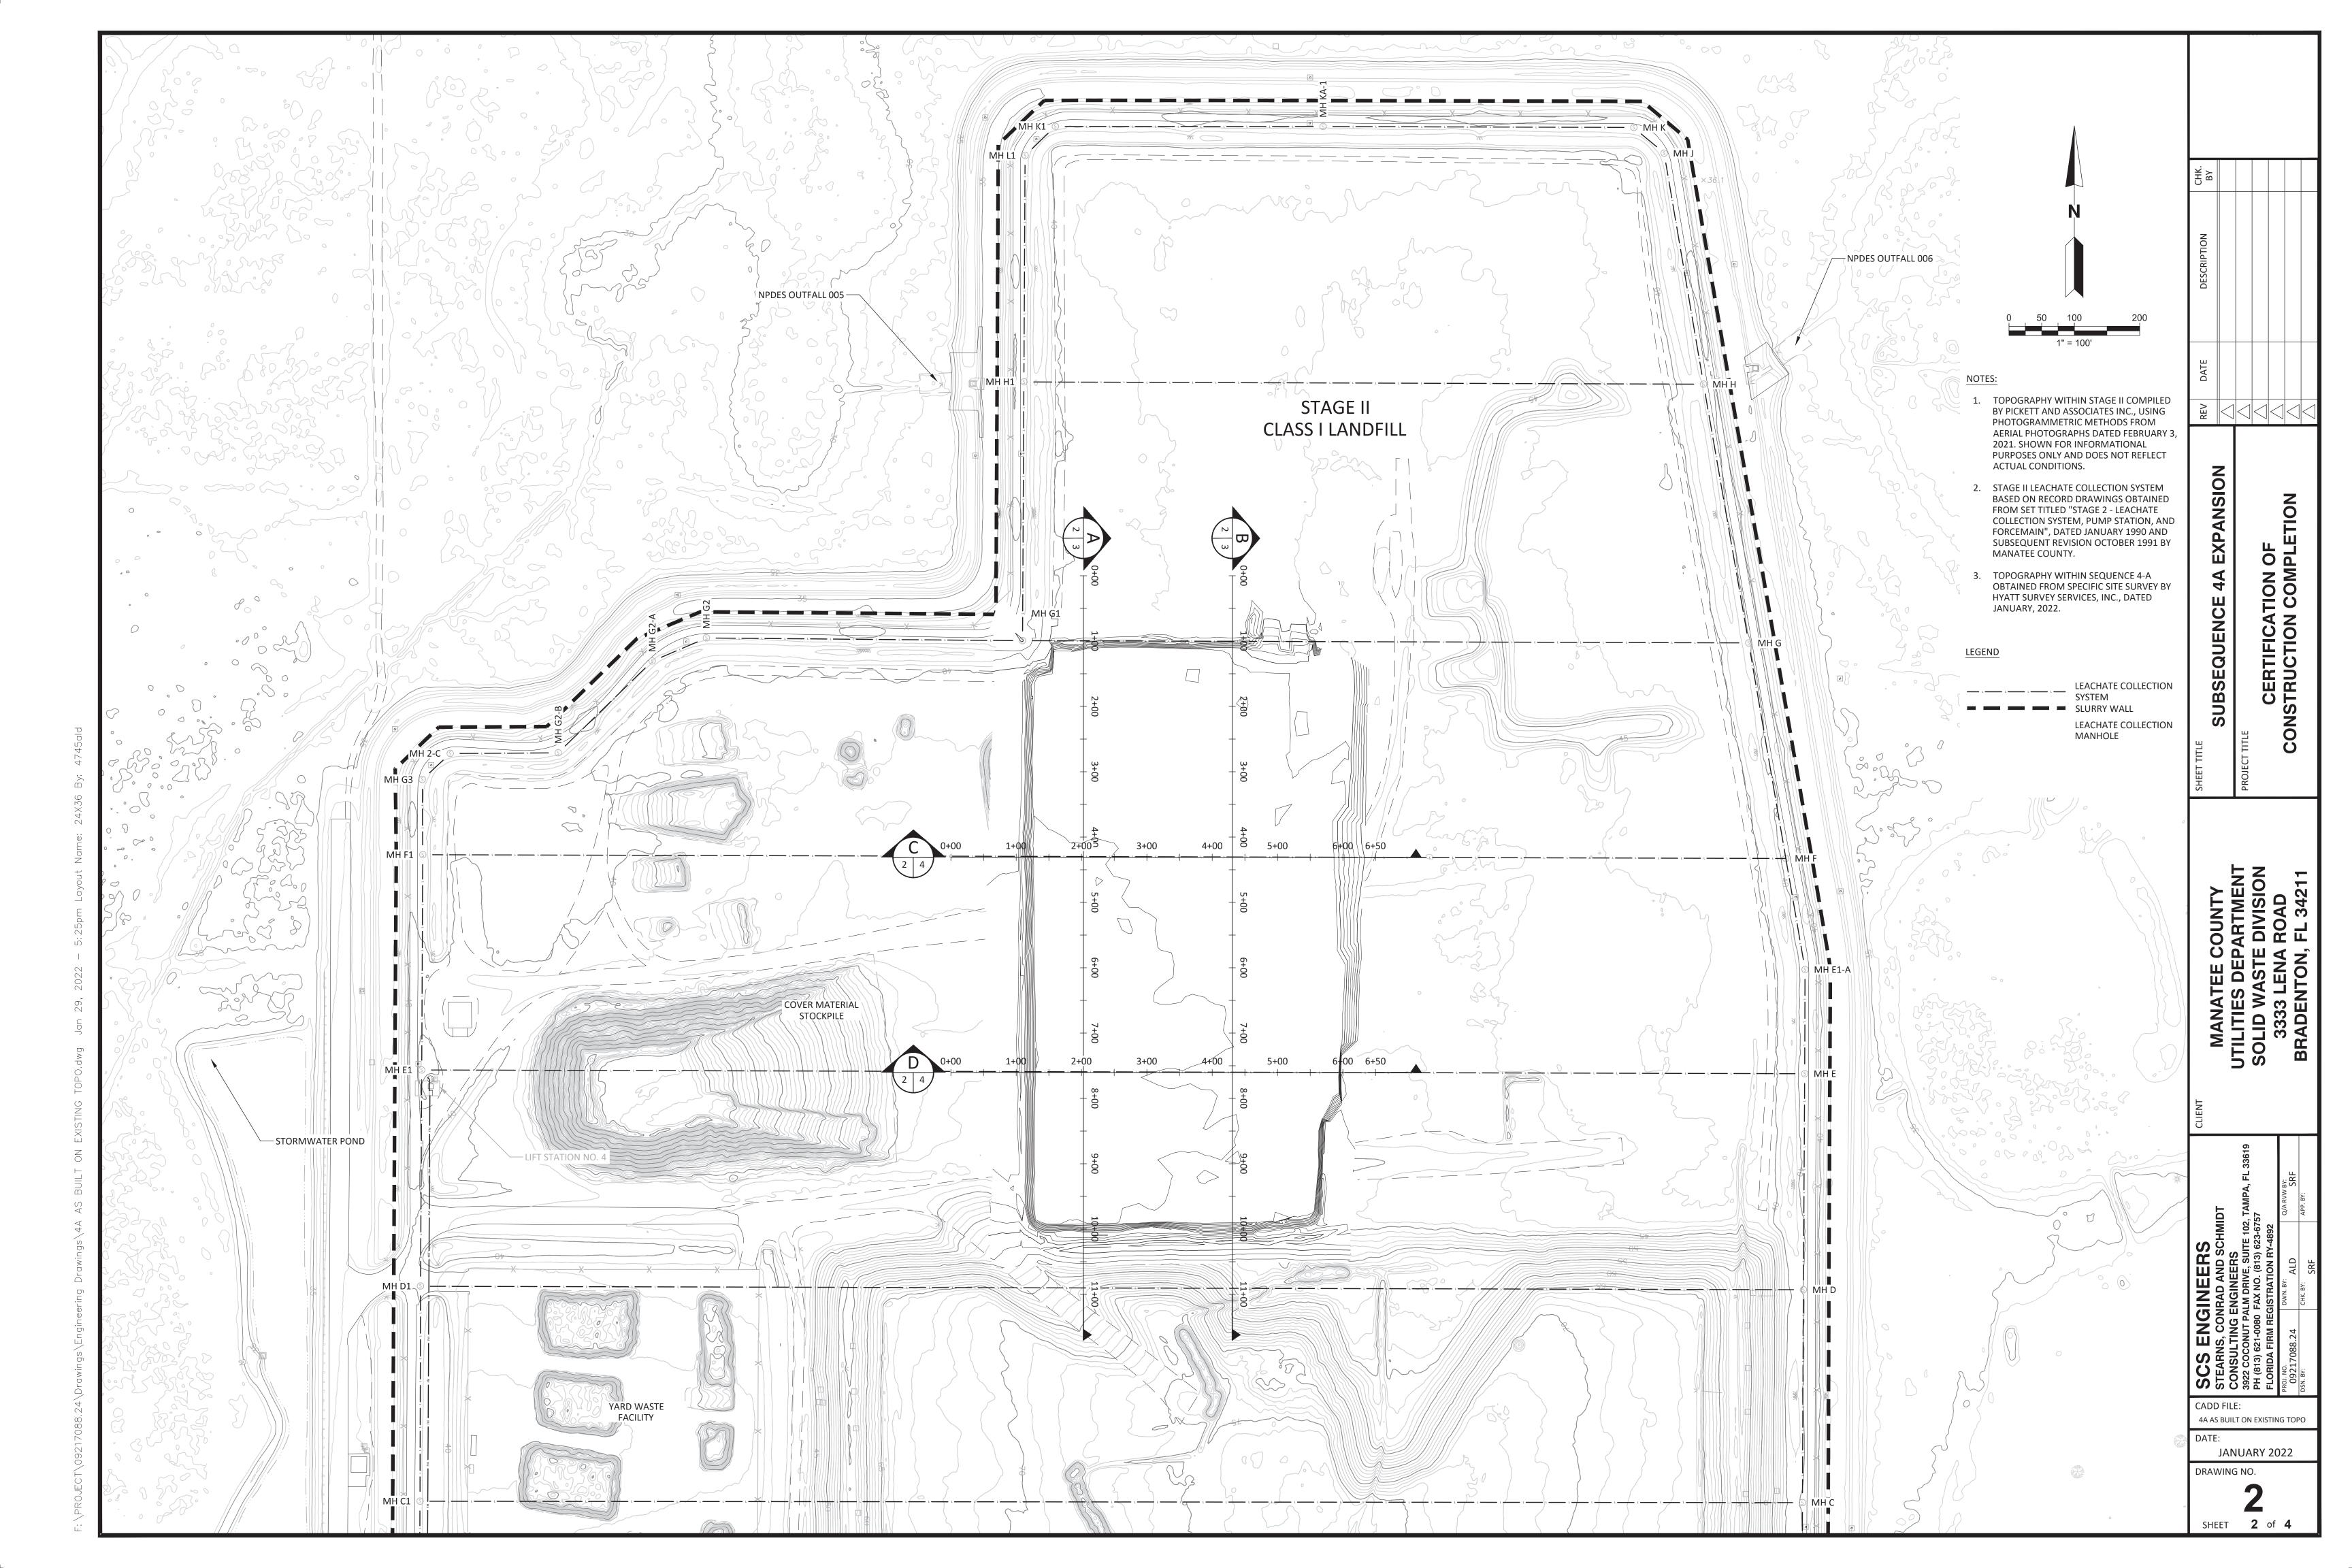

ELEVATION (FT) CELL 4-A SUBGRADE EXPANSION (JANUARY 2022) LEACHATE LINE MH-E TO MH-E1 8"Ø PERFORATED POLYETHYLENE PIPE — LEACHATE LINE MH-F TO MH-F1 8"Ø______
PERFORATED POLYETHYLENE PIPE — CELL 4-A SUBGRADE DESIGN DISTANCE ALONG BASELINE (FT) CELL 4-A SUBGRADE EXPANSION______(JANUARY 2022) LEACHATE LINE MH-F TO MH-F1 8"Ø
PERFORATED POLYETHYLENE PIPE -CELL 4-A SUBGRADE DESIGN-DISTANCE ALONG BASELINE (FT) SECTION

1"=50' HORIZONTAL

2 3

1"=10' VERTICAL

CONSTRUCTION COMPLETION MANATEE COUNTY
UTILITIES DEPARTMENT
SOLID WASTE DIVISION
3333 LENA ROAD
BRADENTON, FL 34211 4A AS BUILT ON EXISTING TOPO JANUARY 2022

DRAWING NO.

CELL 4-A SUBGRADE EXPANSION (JANUARY 2022) — CELL 4-A SUBGRADE DESIGN — LEACHATE LINE MH-F TO MH-F1 8"Ø PERFORATED POLYETHYLENE PIPE DISTANCE ALONG BASELINE (FT) SECTION
1"=50' HORIZONTAL
1"=10' VERTICAL
2 CELL 4-A SUBGRADE EXPANSION
(JANUARY 2022) – CELL 4-A SUBGRADE DESIGN — LEACHATE LINE MH-E TO
MH-E1 8"Ø PERFORATED
POLYETHYLENE PIPE DISTANCE ALONG BASELINE (FT) SECTION

1"=50' HORIZONTAL

2 4

1"=10' VERTICAL

CONSTRUCTION COMPLETION SECTIONS

CADD FILE:

4A AS BUILT ON EXISTING TOPO

DATE:

JANUARY 2022

DRAWING NO.

ATTACHMENT C PHOTOGRAPHS

Photo: 1
Description:
Subsequence 4A
looking northwest.



Photo: 2
Description:
Subsequence 4A
looking southeast.



Photo: 3

Description: Subsequence 4A looking south.



Photo: 4
Description: Subsequence
4A looking south.

