


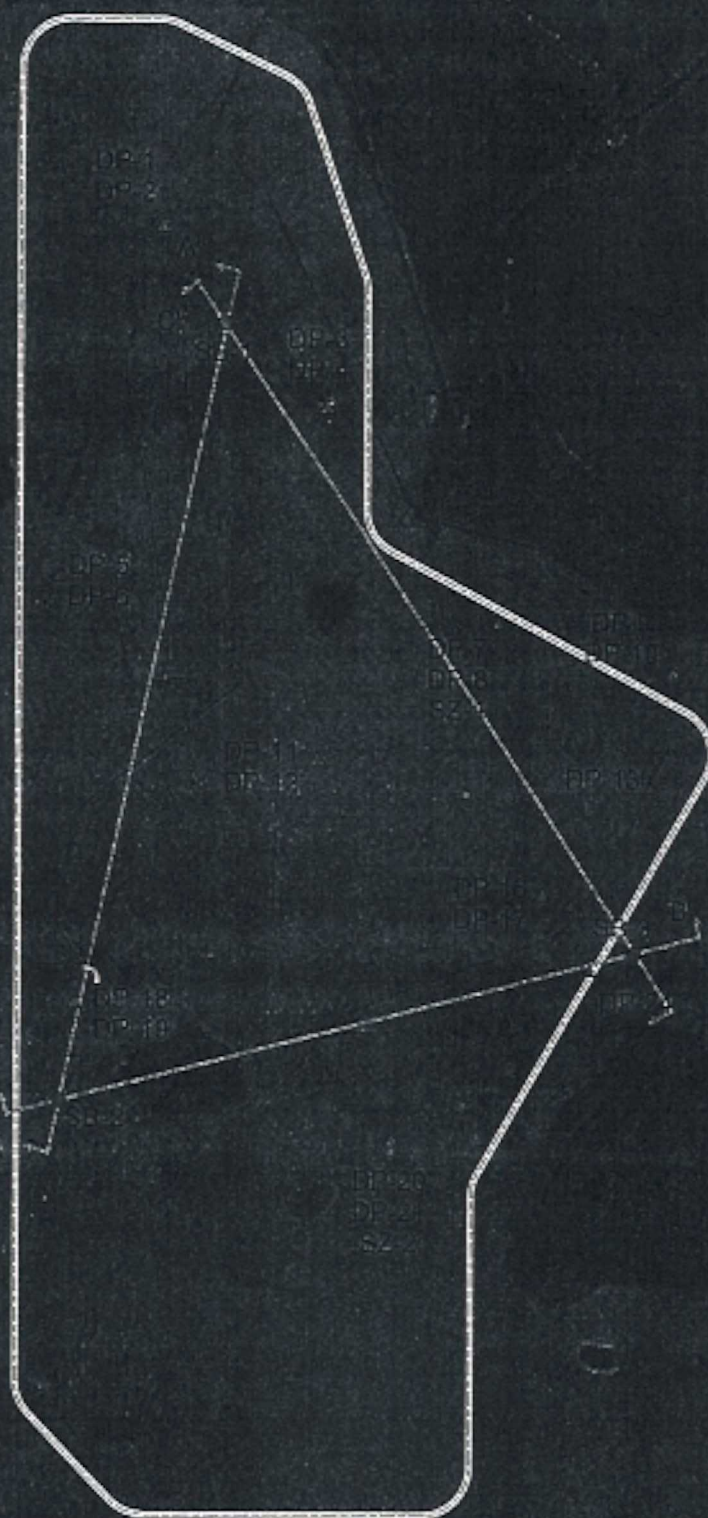

Legend

Piezometer

▲ DP-1

Sonic Boring Location

● SB-1

— Cross Section Location

Limit of Waste

Property Line

Location Approx. Depth
(ft. bsl)

DP-1	50
DP-2	15
DP-3	50
DP-4	15
DP-5	50
DP-6	15
DP-7*	15
DP-8*	50
DP-9	50
DP-10	15
DP-11	50
DP-12	15
DP-13	15
DP-14	15
DP-15	50
DP-16	15
DP-17	50
DP-18	50
DP-19	15
DP-20	15
DP-21	50
DP-22	15
DP-23	50
DP-24	15
SZ-1*	78.3
SZ-2	72
SZ-3	75.9
SB-1	177
SB-2	147
SB-3	157

*Note: Piezometer
instrumented with
transducer / data logger.

Kubal-Furr & Associates
-Environmental Consultants-

0 350 700 1,400
Feet

Figure 2. Site Plan
OMNI Waste of Osceola County, LLC
Oak Hammock Disposal
Osceola County, Florida