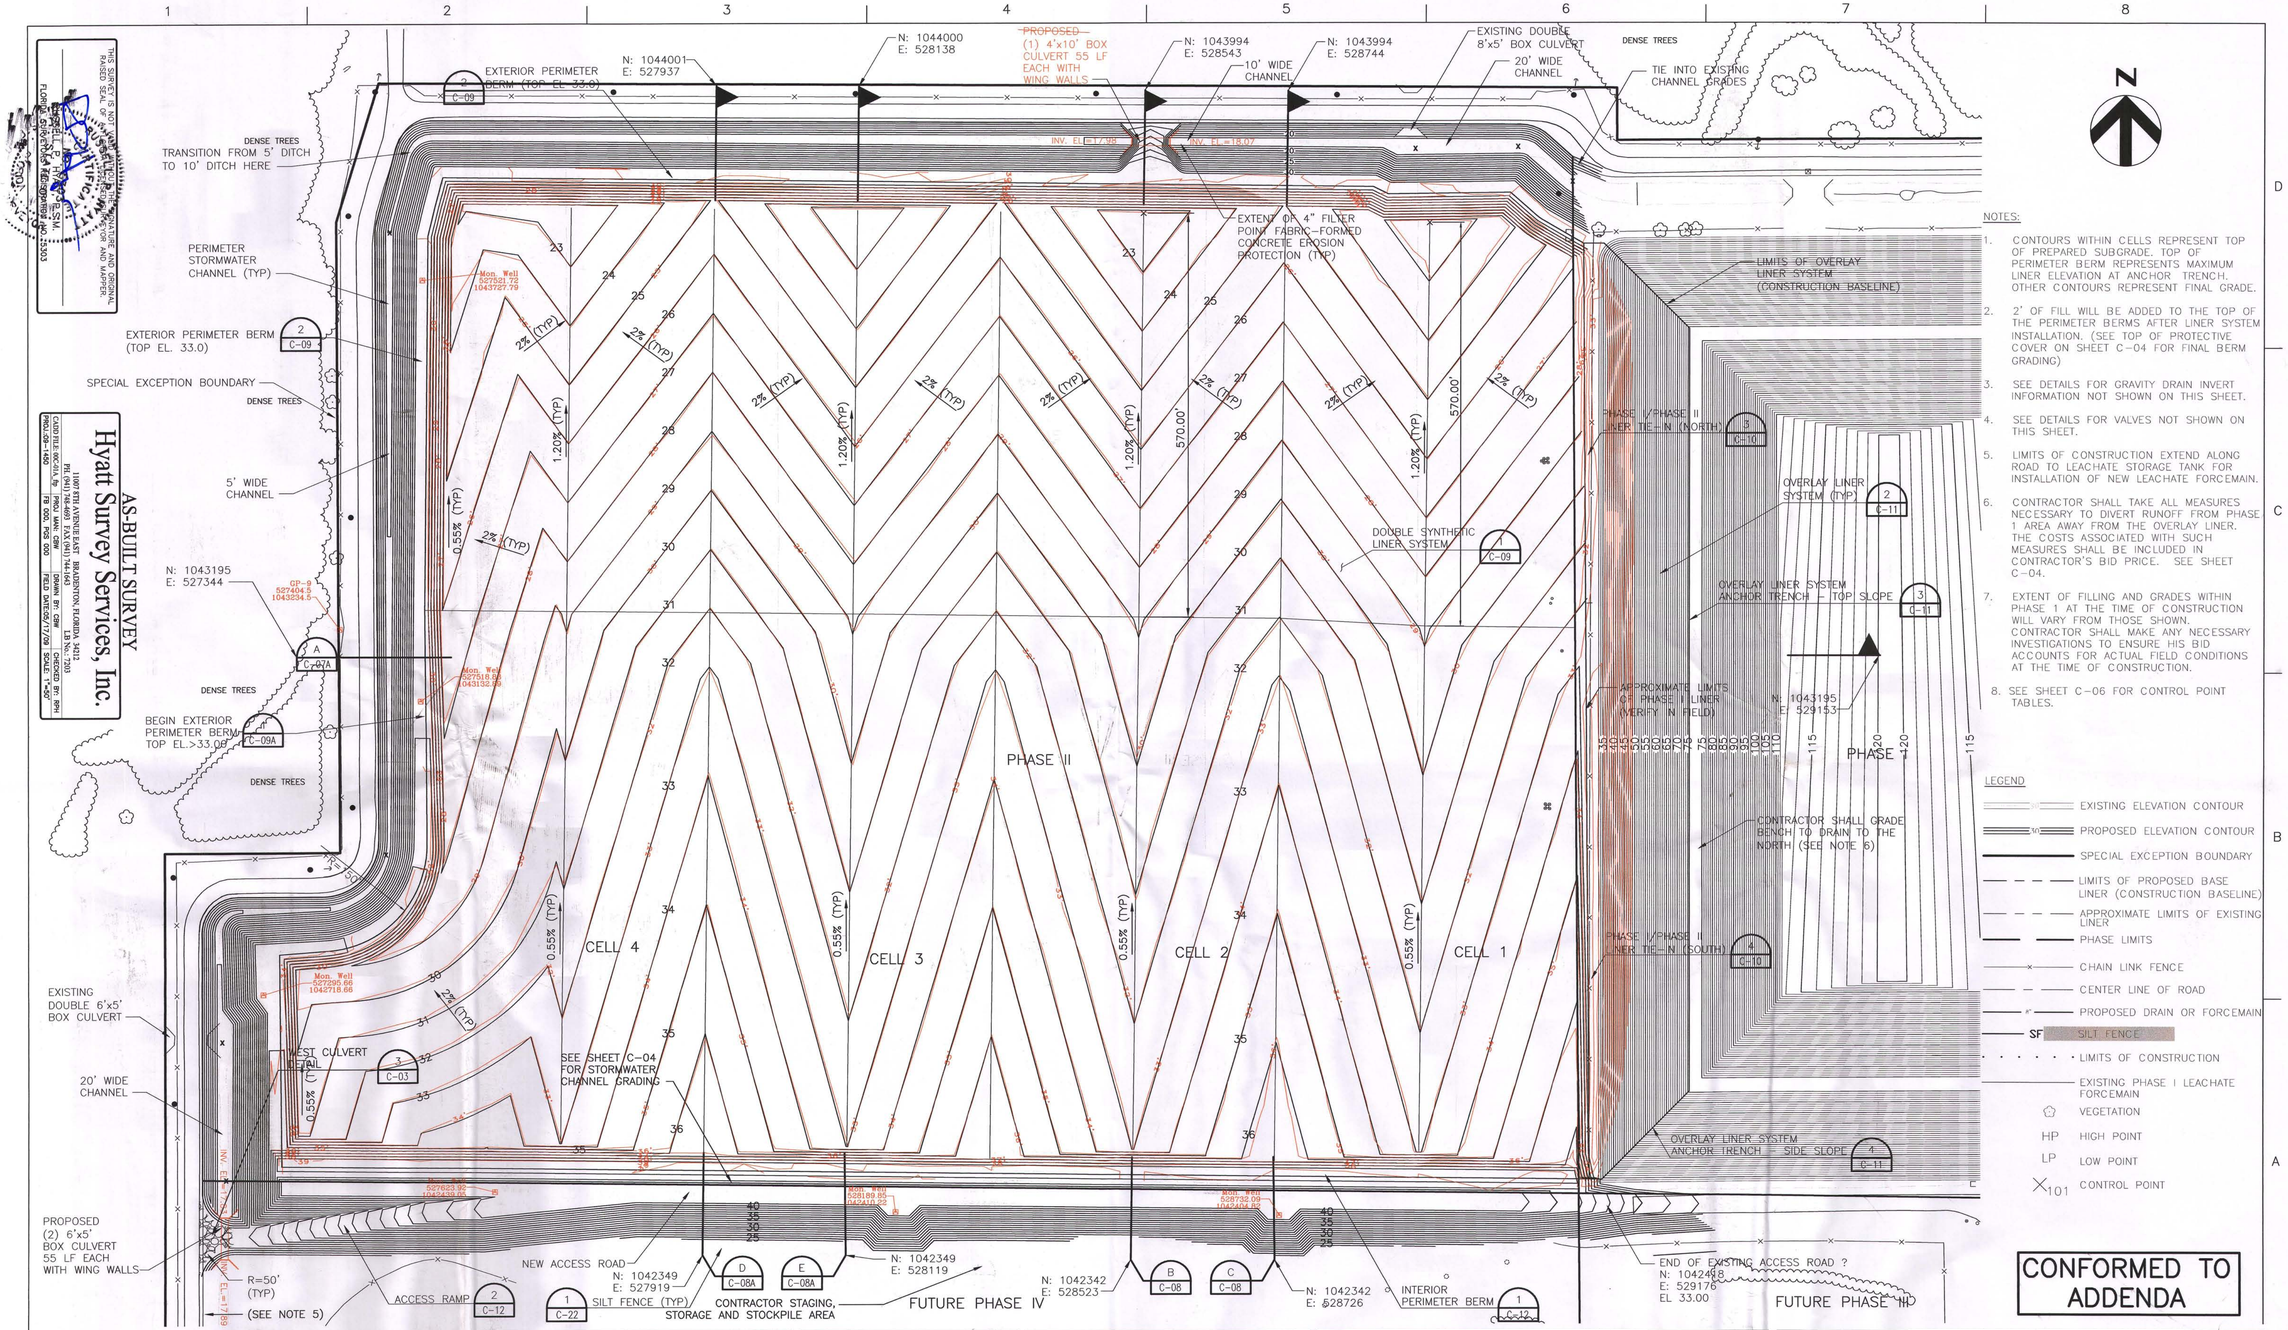


THIS SURVEY IS NOT VALID UNLESS EMBOSSED WITH THE SURVEYOR AND MAPPER'S RAISED SEAL OF A FLORIDA REGISTERED SURVEYOR AND MAPPER.
RUSSELL P. HYATT, P.S.M.
FLORIDA CERTIFICATE OF AUTHORIZATION NO. LB 2303

Hyatt Survey Services, Inc.
AS-BUILT SURVEY
11907 TH AVENUE E. PALMETTO, FLORIDA 34221
PH: (941) 746-4693 FAX: (941) 744-1945

CADD FILE: 00C-01A.dgn | PROJ. NO.: 08-1450 | TB: 000 | PKS: 000 | DRAWN BY: GBM | PROJ. MAN: GBM | FIELD DATE: 06/17/09 | CHECKED BY: RPH | SCALE: 1"=50'

HDR
HDR Engineering, Inc.
5426 Bay Center Drive, Suite 400
Tampa, FL 33609-3444
(813) 282-2300
Florida Certificate of Authorization
No. 00004213

ISSUE	DATE	DESCRIPTION
A	02/2009	ISSUED FOR CONSTRUCTION, CONFORMED TO ADDENDA

PROJECT MANAGER	T.M. YANOSCHAK
REVIEWED BY	J.C. READLING
DRAWN BY	G.J. BLUE
PROJECT NUMBER	001916-43485-018

Thomas M. Yanoschak, P.E.
Certificate No. 44200

SARASOTA COUNTY

Central County Solid Waste Disposal Complex

PHASE II CLASS I LANDFILL EXPANSION CONSTRUCTION DRAWINGS

SARASOTA COUNTY FLORIDA

BASEGRADE PLAN CELLS 1 THROUGH 4 (BID ALTERNATE 1)

FLORIDA DEPARTMENT OF ENVIRONMENTAL PROTECTION
FEB 12 2010
SOUTHWEST DISTRICT TAMPA

0 1" 2"

FILENAME	00C-01A.dwg
SCALE	1"=100'

SHEET C-01A