

1 2 3 4 5 6 7 8



**NOTES:**

1. CONTOURS WITHIN CELLS REPRESENT TOP OF PREPARED SUBGRADE. TOP OF PERIMETER BERM REPRESENTS MAXIMUM LINER ELEVATION AT ANCHOR TRENCH. OTHER CONTOURS REPRESENT FINAL GRADE.
2. 2' OF FILL WILL BE ADDED TO THE TOP OF THE PERIMETER BERMS AFTER LINER SYSTEM INSTALLATION. (SEE TOP OF PROTECTIVE COVER ON SHEET C-04 FOR FINAL BERM GRADING)
3. SEE DETAILS FOR GRAVITY DRAIN INVERT INFORMATION NOT SHOWN IN THIS SHEET
4. SEE DETAILS FOR VALVES NOT SHOWN ON THIS SHEET.
5. LIMITS OF CONSTRUCTION EXTEND ALONG ROAD TO LEACHATE STORAGE TANK FOR INSTALLATION OF NEW LEACHATE FORCEMAIN.
6. CONTRACTOR SHALL TAKE ALL MEASURES NECESSARY TO DIVERT RUNOFF FROM PHASE I AREA AWAY FROM THE OVERLAY LINER. THE COSTS ASSOCIATED WITH SUCH MEASURES SHALL BE INCLUDED IN CONTRACTOR'S BID PRICE. SEE SHEET C-04.
7. EXTENT OF FILLING AND GRADES WITHIN PHASE I AT THE TIME OF CONSTRUCTION WILL VARY FROM THOSE SHOWN. CONTRACTOR SHALL MAKE ANY NECESSARY INVESTIGATIONS TO ENSURE HIS BID ACCOUNTS FOR ACTUAL FIELD CONDITIONS AT THE TIME OF CONSTRUCTION.

**LEGEND**

- EXISTING ELEVATION CONTOUR
- PROPOSED ELEVATION CONTOUR
- SPECIAL EXCEPTION BOUNDARY
- LIMITS OF PROPOSED BASE LINER (CONSTRUCTION BASELINE)
- APPROXIMATE LIMITS OF EXISTING LINER
- PHASE LIMITS
- CHAIN LINK FENCE
- CENTER LINE OF ROAD
- PROPOSED DRAIN OR FORCEMAIN
- SILT FENCE
- LIMITS OF CONSTRUCTION
- EXISTING PHASE I LEACHATE FORCEMAIN
- VEGETATION
- HP HIGH POINT
- LP LOW POINT

**CONFORMED TO  
ADDENDA**

**AS-BUILT SURVEY**  
**Hyatt Survey Services, Inc.**  
11077 PITA AVENUE EAST, RADETTON, FLORIDA 34112  
PH: (888) 784-0001 FAX: (888) 784-0002  
FIELD DESIGNS: 7/2010 SCALE: 1"=50'


THIS SURVEY IS NOT VALID WITHOUT THE SIGNATURE AND ORIGINAL RAISED SEAL OF A FLORIDA LICENSED SURVEYOR AND MAPPER.  
RUSSELL J. YANOSCHAK, P.E.  
FLORIDA LICENSE NO. 53303  
STATE OF FLORIDA

**HDR**  
HDR Engineering, Inc.  
5426 Bay Center Drive, Suite 400  
Tampa, FL 33609-3444  
(813) 282-2300  
Florida Certificate of Authorization  
No. 00004213

ISSUE	DATE	DESCRIPTION
A	02/2009	ISSUED FOR CONSTRUCTION, CONFORMED TO ADDENDA

PROJECT MANAGER	T.M. YANOSCHAK
REVIEWED BY	J.C. READING
DRAWN BY	G.J. BLUE
PROJECT NUMBER	001916-43485-018

Thomas M. Yanoschak, P.E.  
Certificate No. 44200

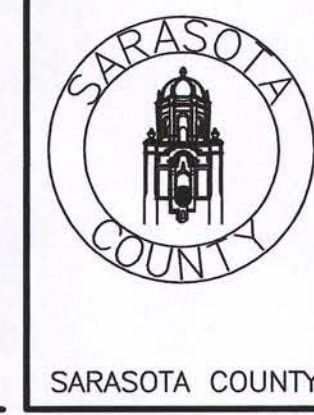

**Central County Solid Waste  
Disposal Complex**  
**PHASE II CLASS I LANDFILL  
EXPANSION**  
**CONSTRUCTION DRAWINGS**

**LEACHATE COLLECTION SYSTEM  
CELLS 1 THROUGH 4  
(BID ALTERNATE 1)**  
**8" LEACHATE COLLECTION**

FILENAME	00C-02A.dwg	SHEET	C-02A
SCALE	1"=100'		

